


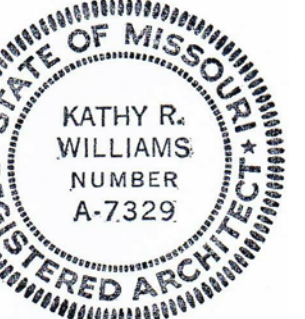

Kathy R. Williams
3.16.16

CONFORMED SET 01 JUL 2016


2	ADDENDUM 1-7	16 MAR 2016
1	ADDENDUM 1-1	29 JAN 2016
-	ISSUED FOR CONSTRUCTION (BP1)	15 JAN 2016
No.	Description	Date

Drawing Title:


EXTERIOR PLAN DETAILS

Project No.: 04561.01 Checked by:


A0423

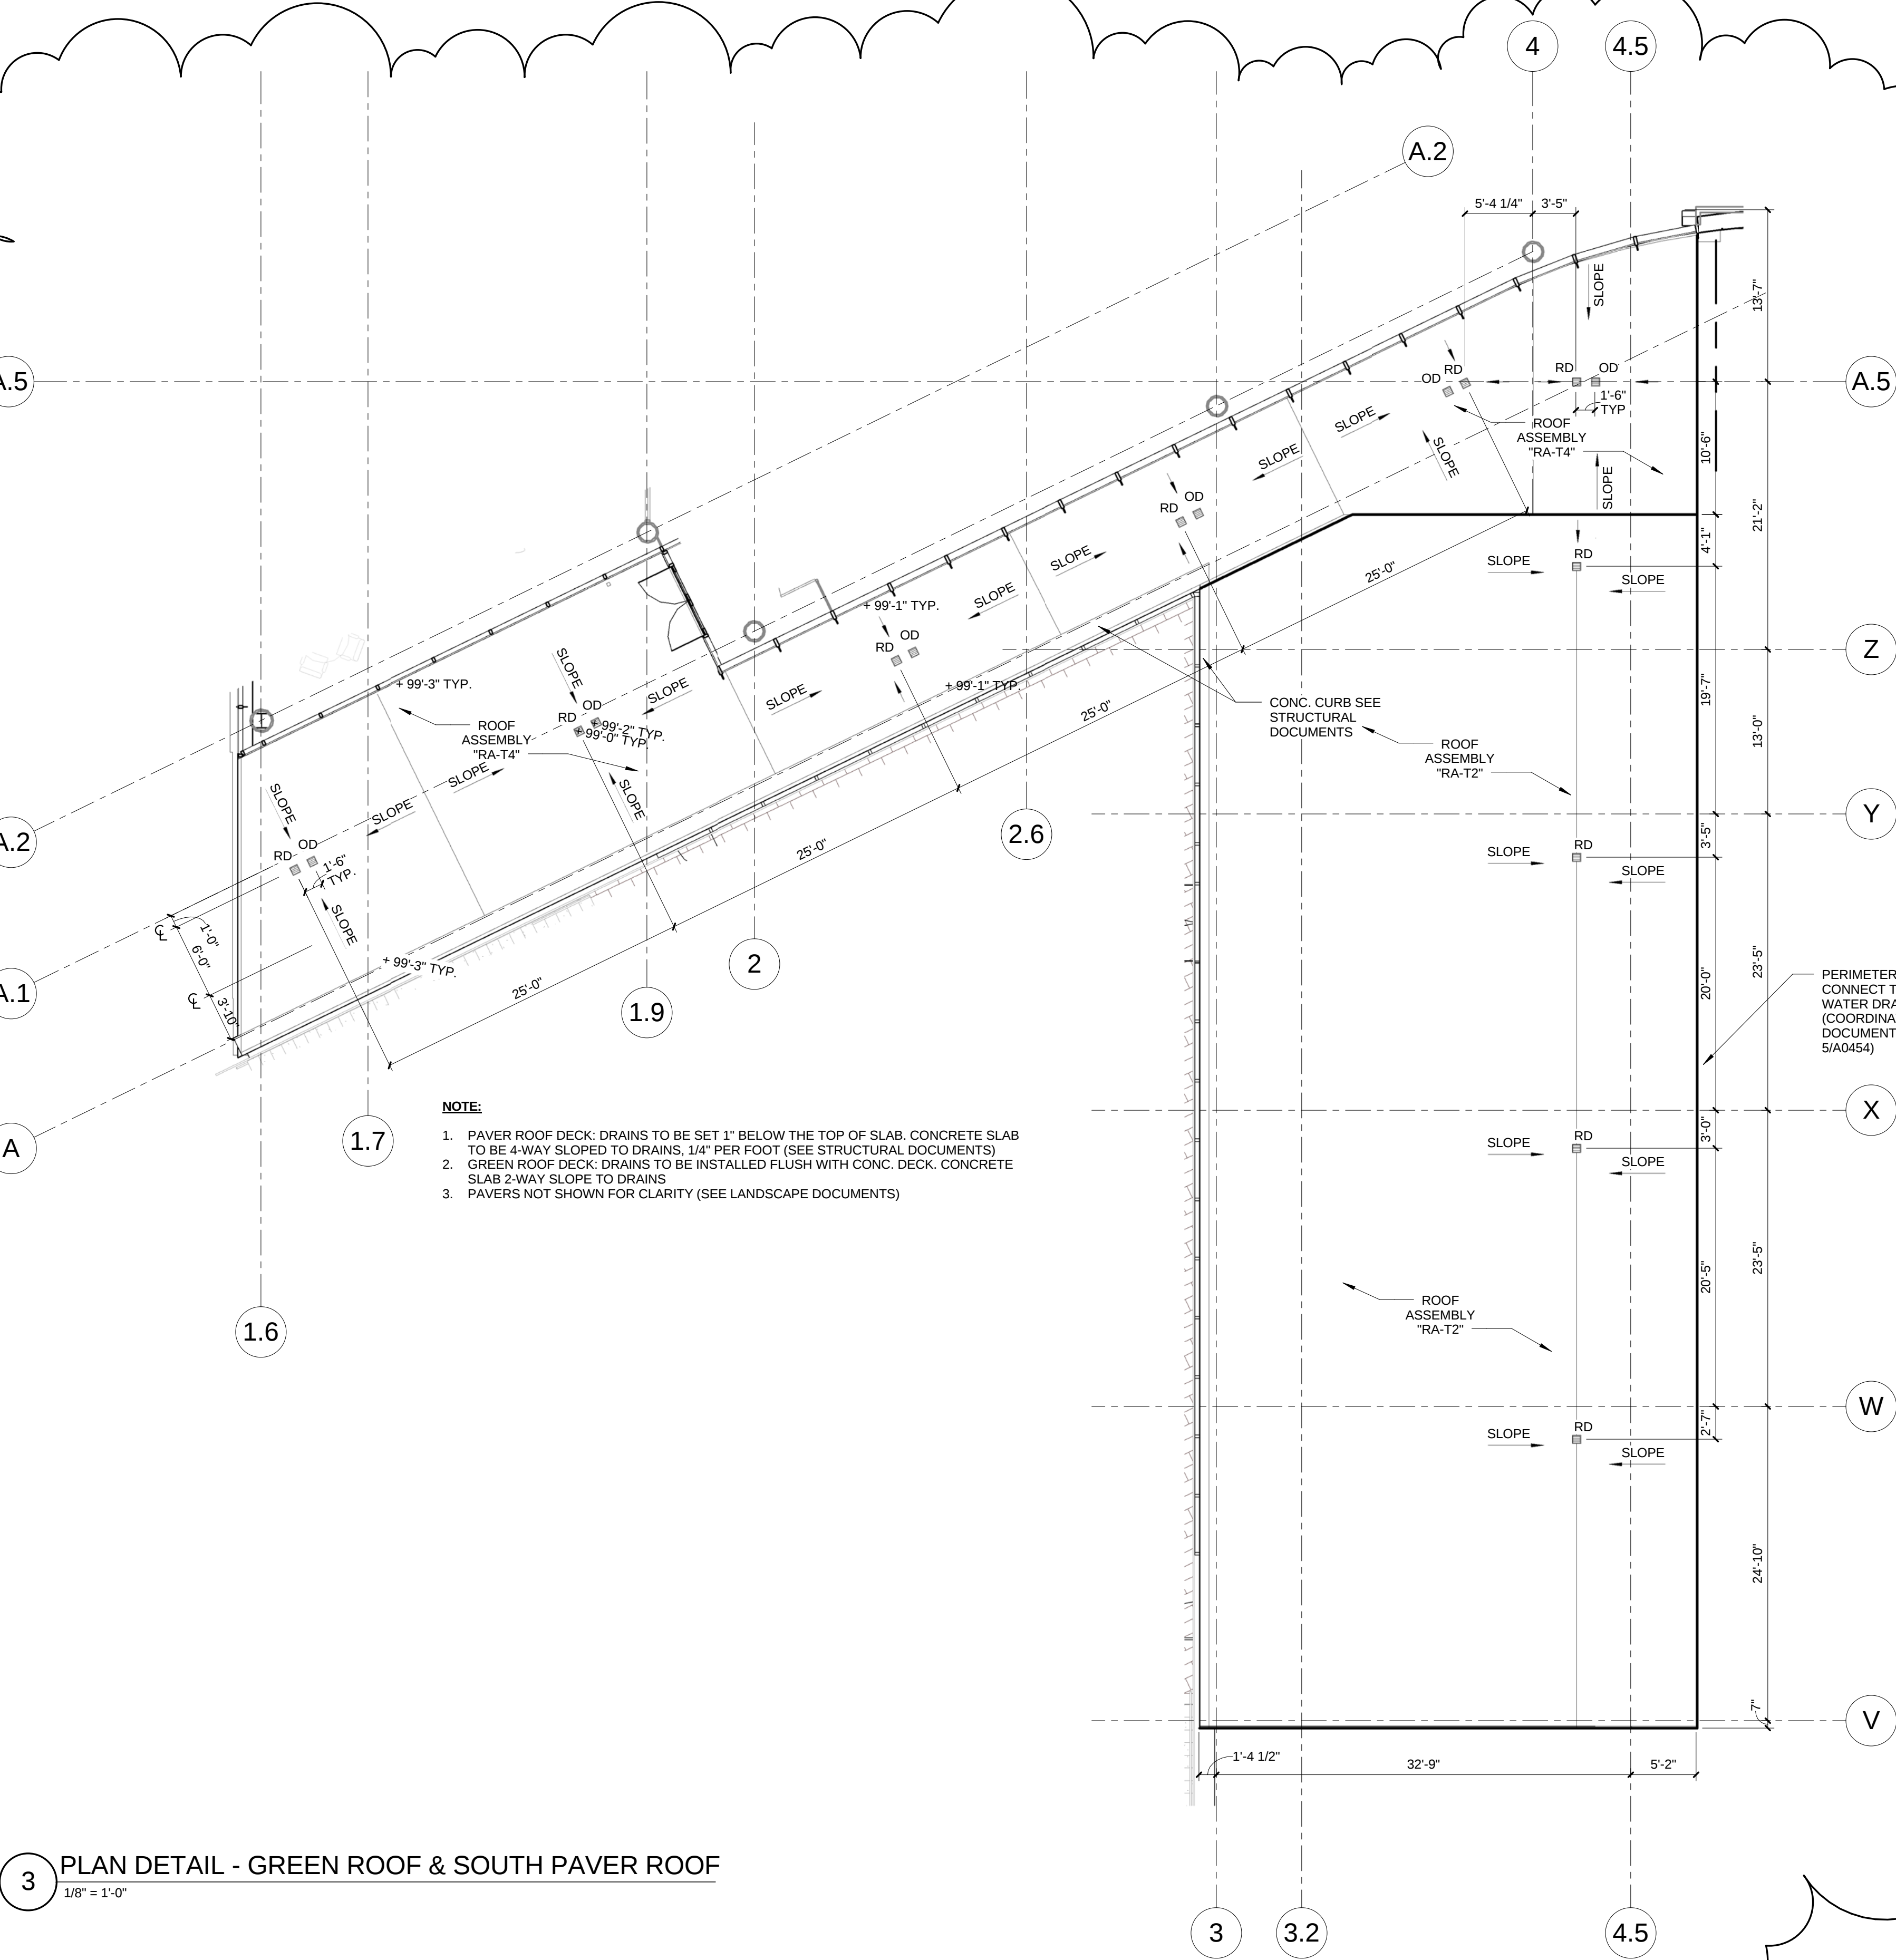


3 PLAN DETAIL - GREEN ROOF & SOUTH PAVER ROOF
1/8" = 1'-0"

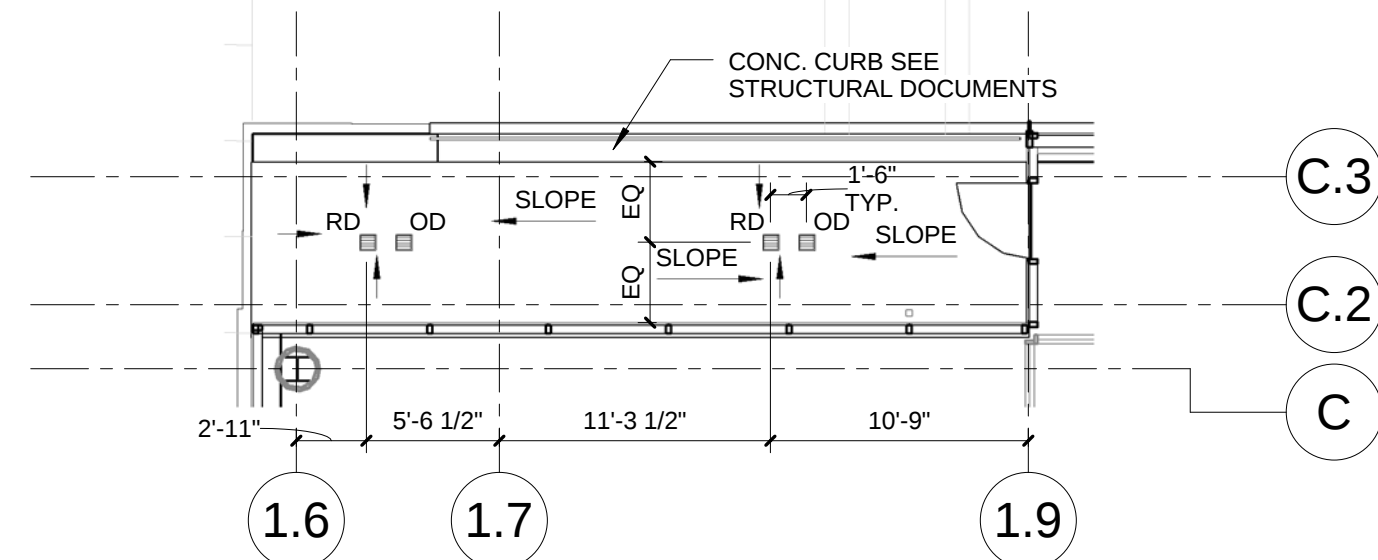

4 PLAN DETAIL - NORTH PAVER ROOF PLAN
1/8" = 1'-0"

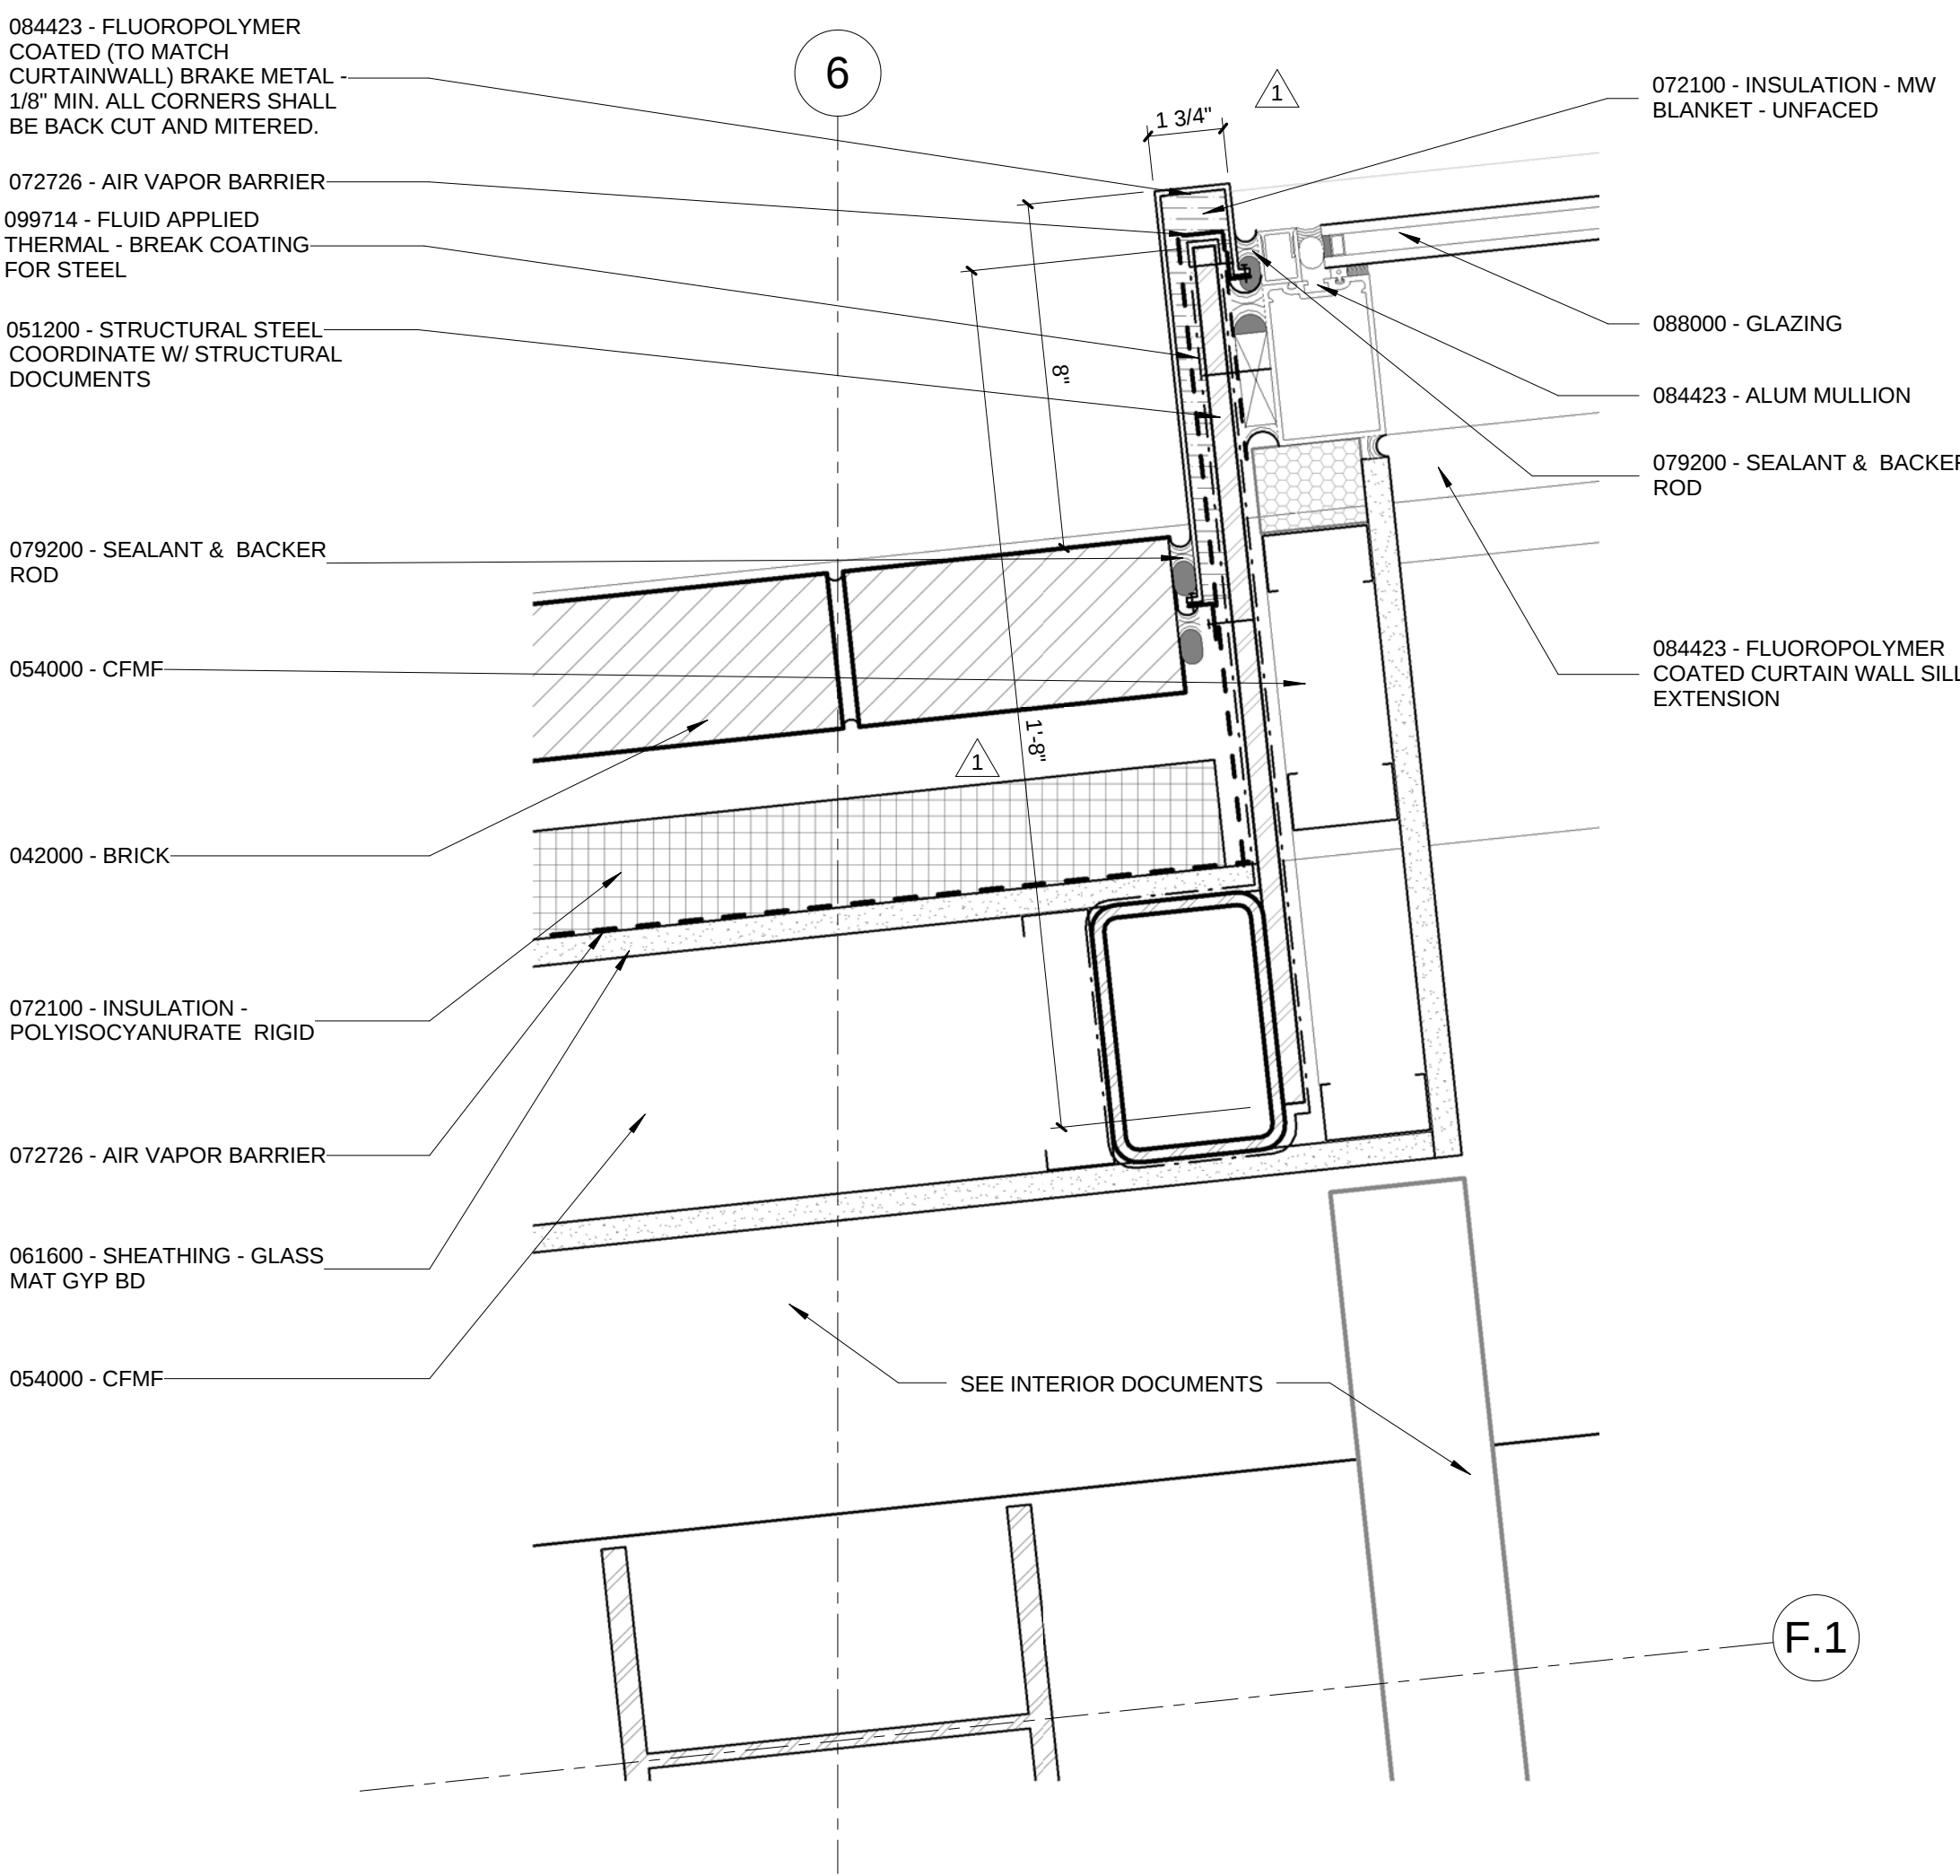

1 PLAN DETAIL - NORTH PROJECTED CURTAINWALL
3" = 1'-0"

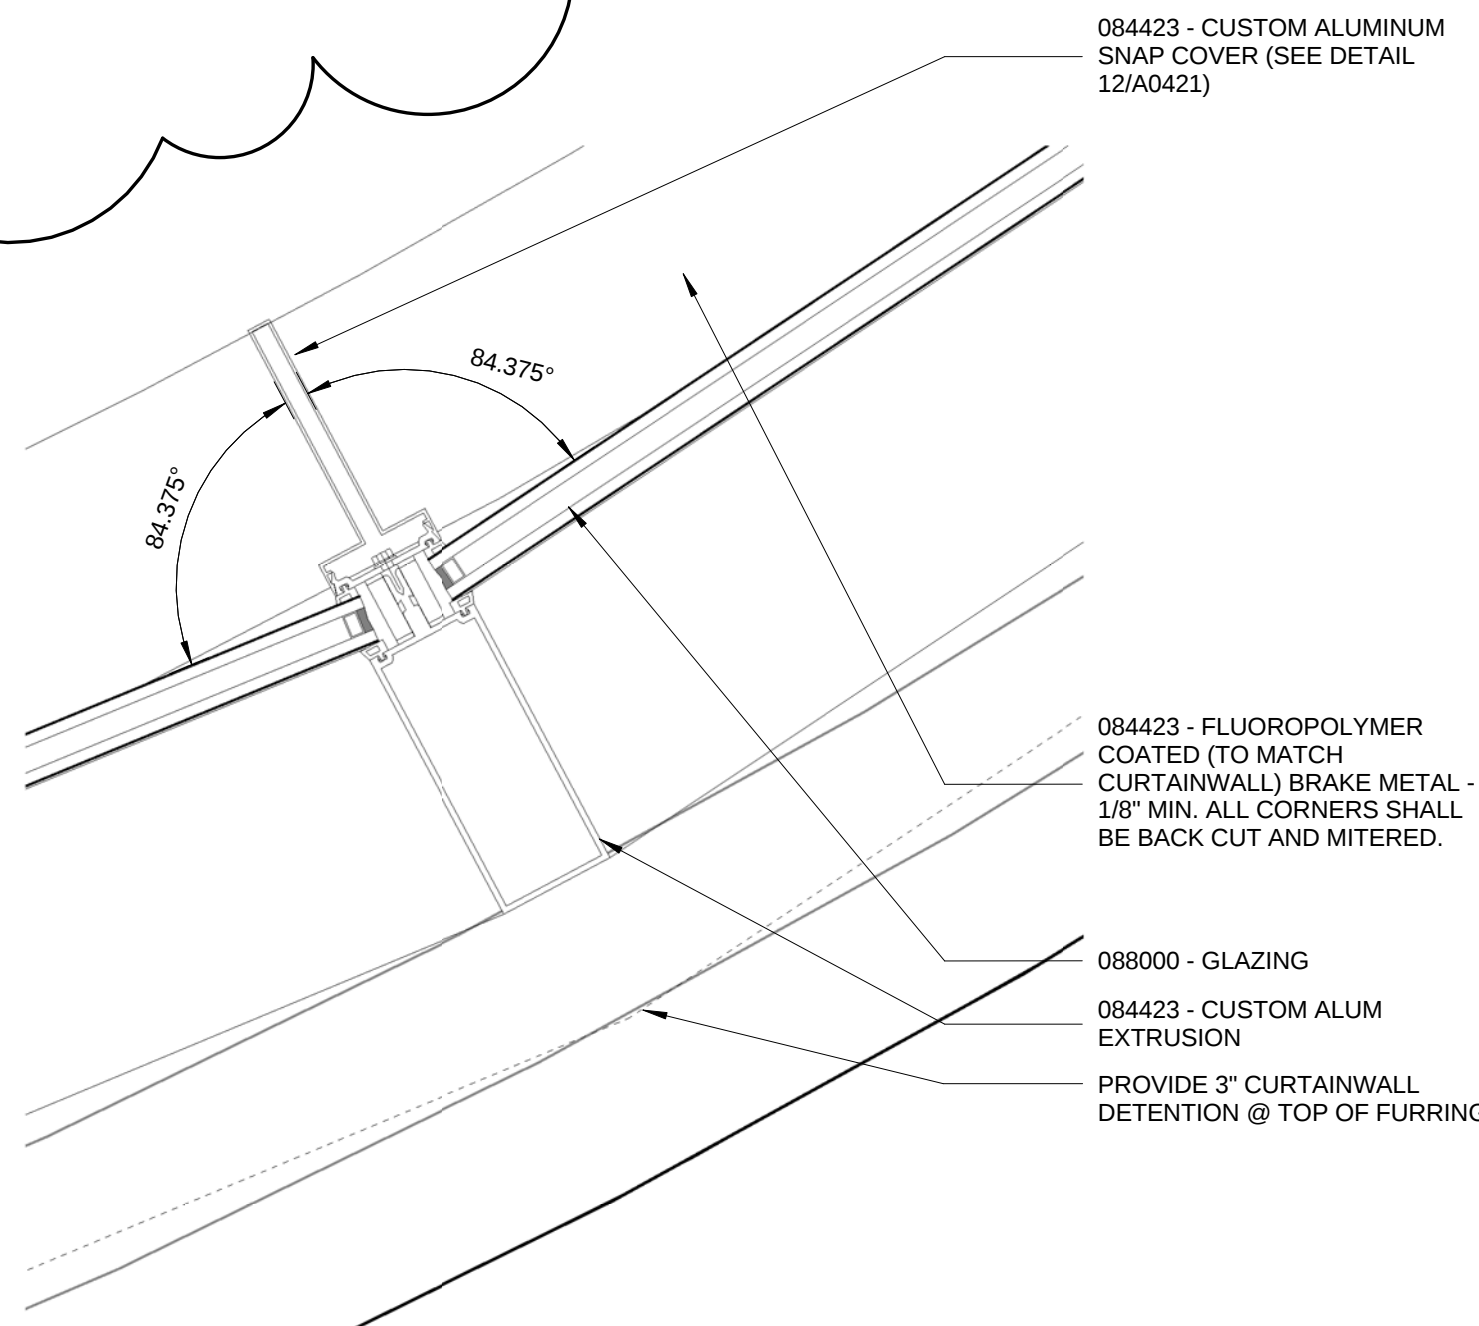

2 PLAN DETAIL - CUSTOM MULLION @ CURVED CURTAINWALL
3" = 1'-0"