



Kathy R. Williams
3.16.16

CONFORMED SET 01 JUL 2016


2	ADDENDUM 1-7	16 MAR 2016
1	ADDENDUM 1-1	29 JAN 2016
1	ISSUED FOR CONSTRUCTION (BP1)	15 JAN 2016
No.	Description	Date

Drawing Title:


EXTERIOR SECTION
DETAILS

Project No.: 04561.01 Checked by:


A0455

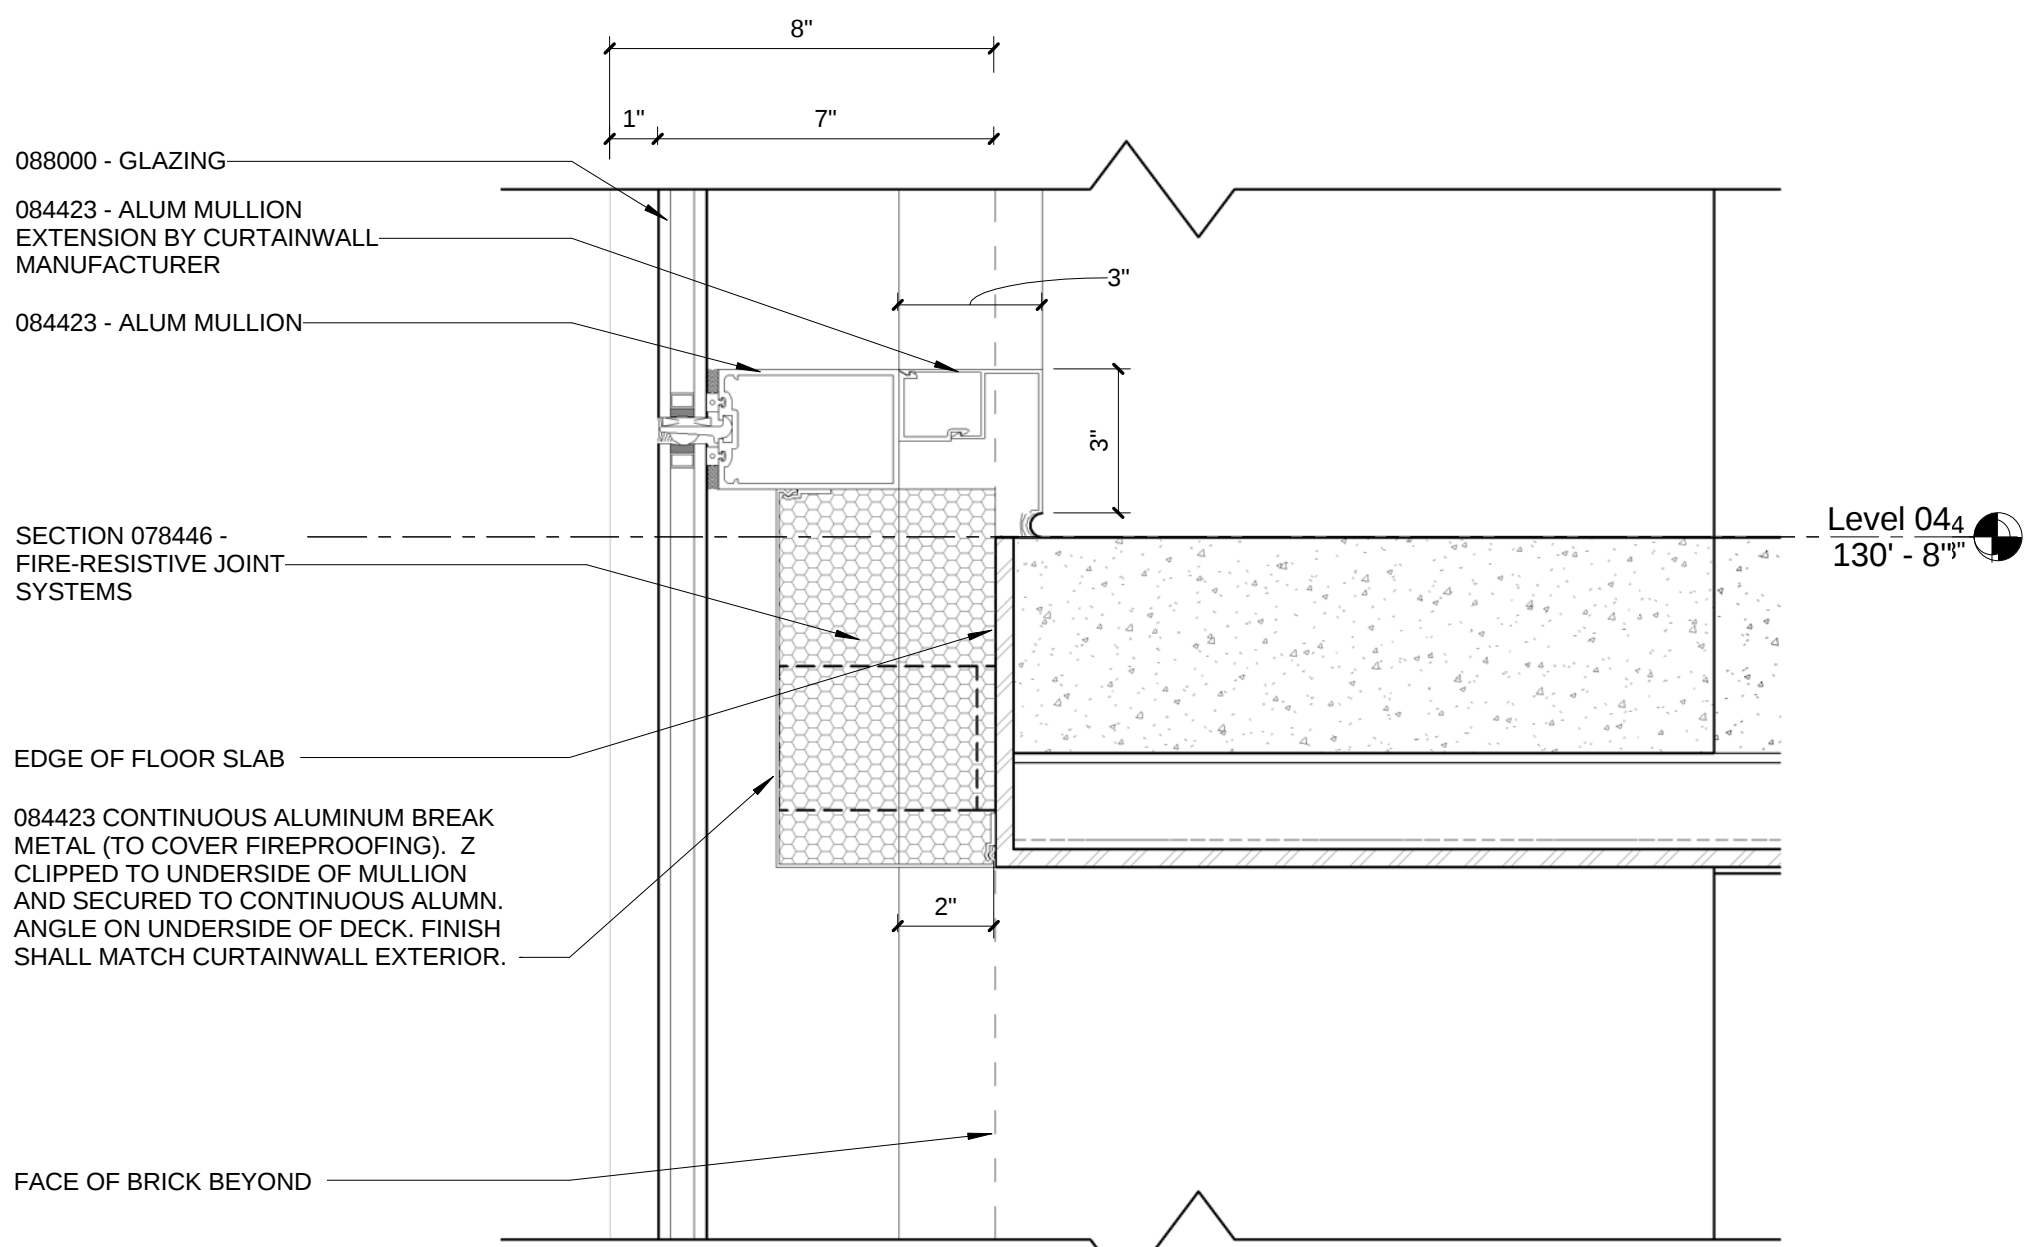


ENLARGED DETAIL - FLOOR CONNECTION @ PROJECTED CURTAINWALL

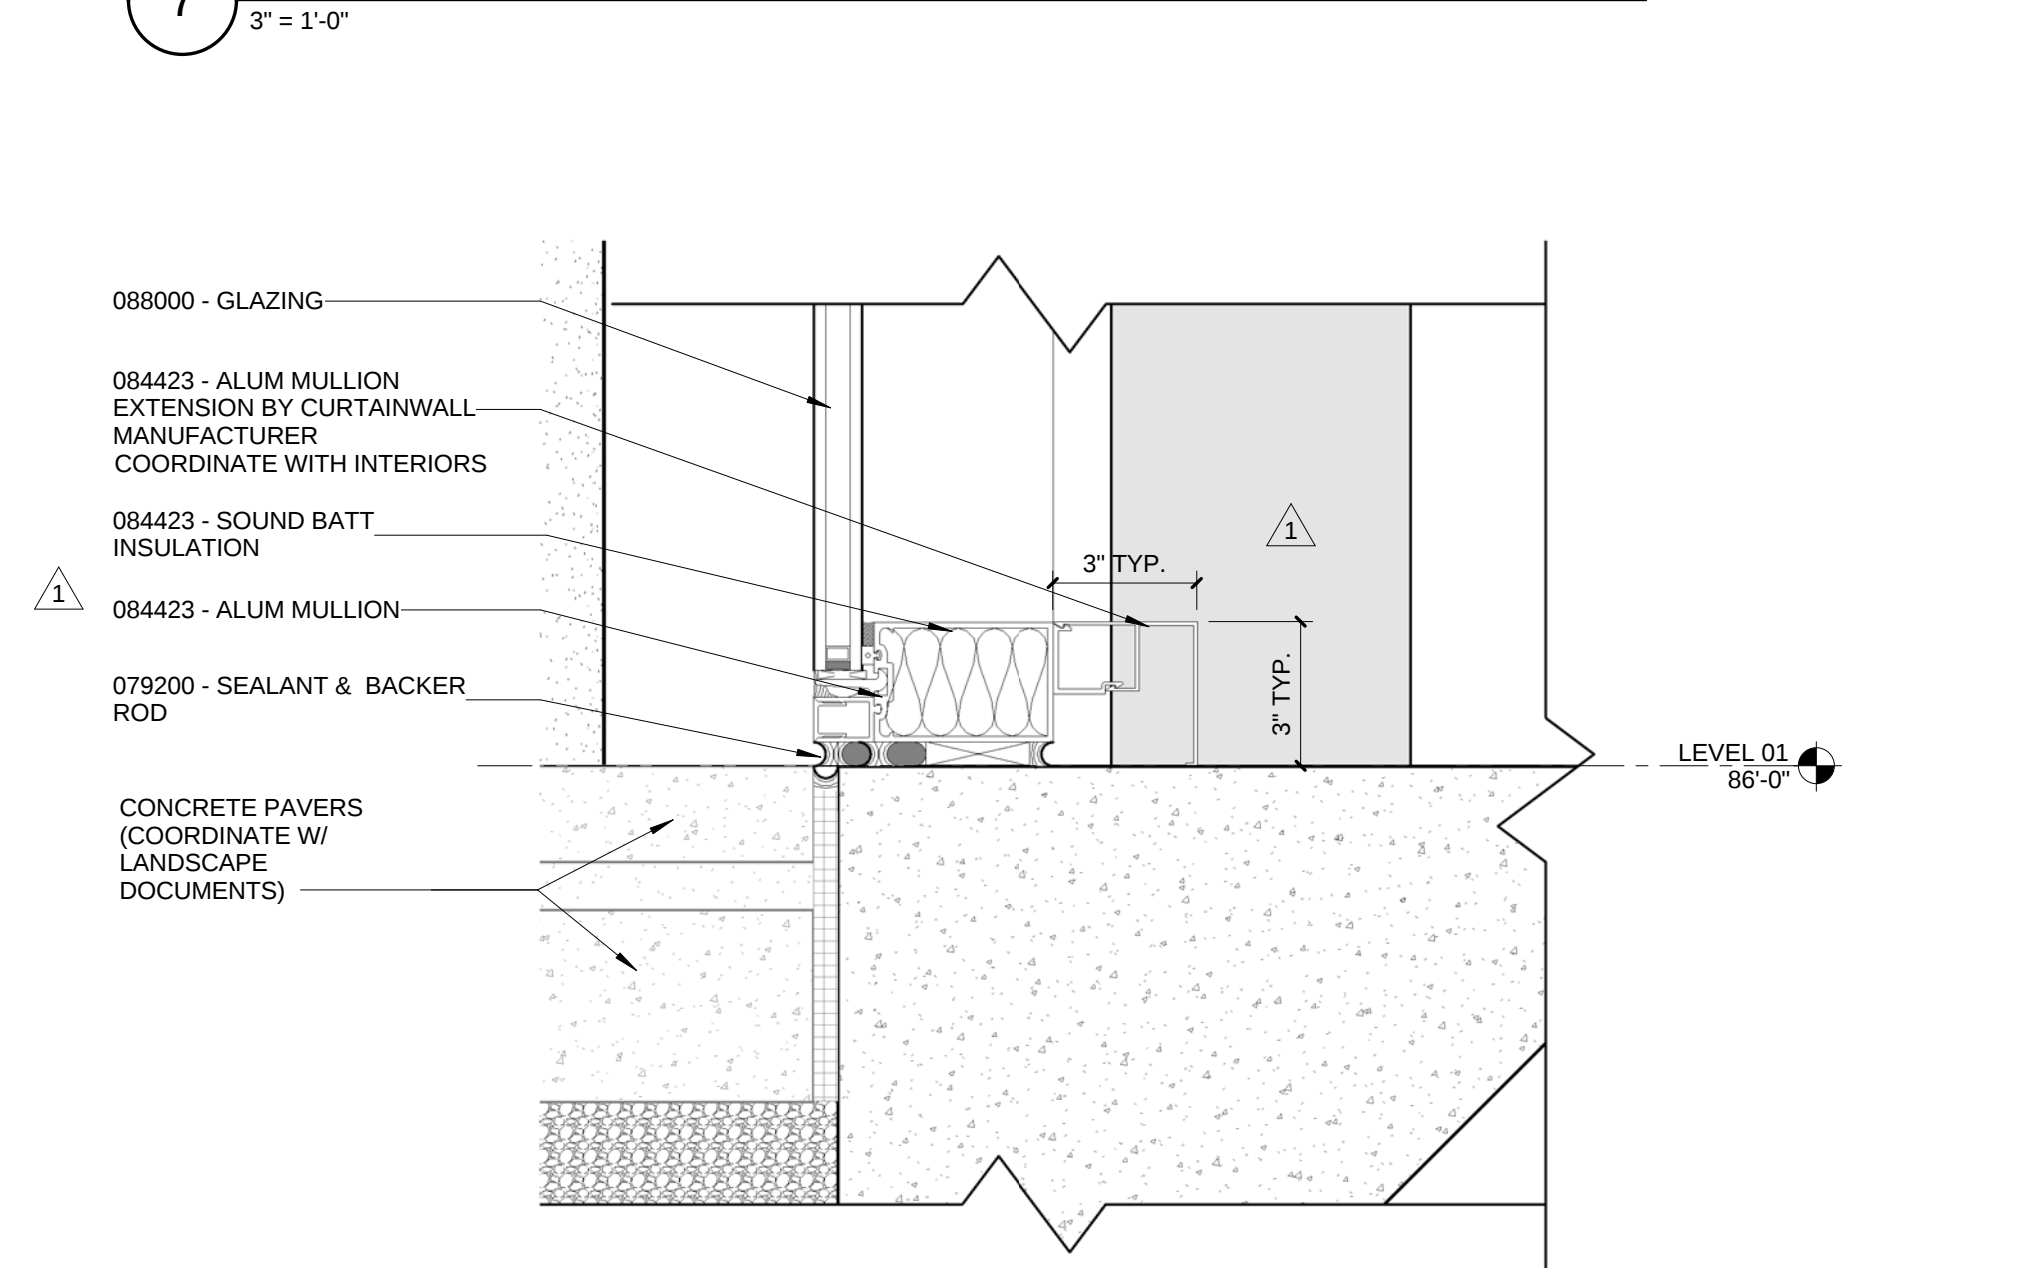


ENLARGED DETAIL - CURTAINWALL SILL @ COURTYARD

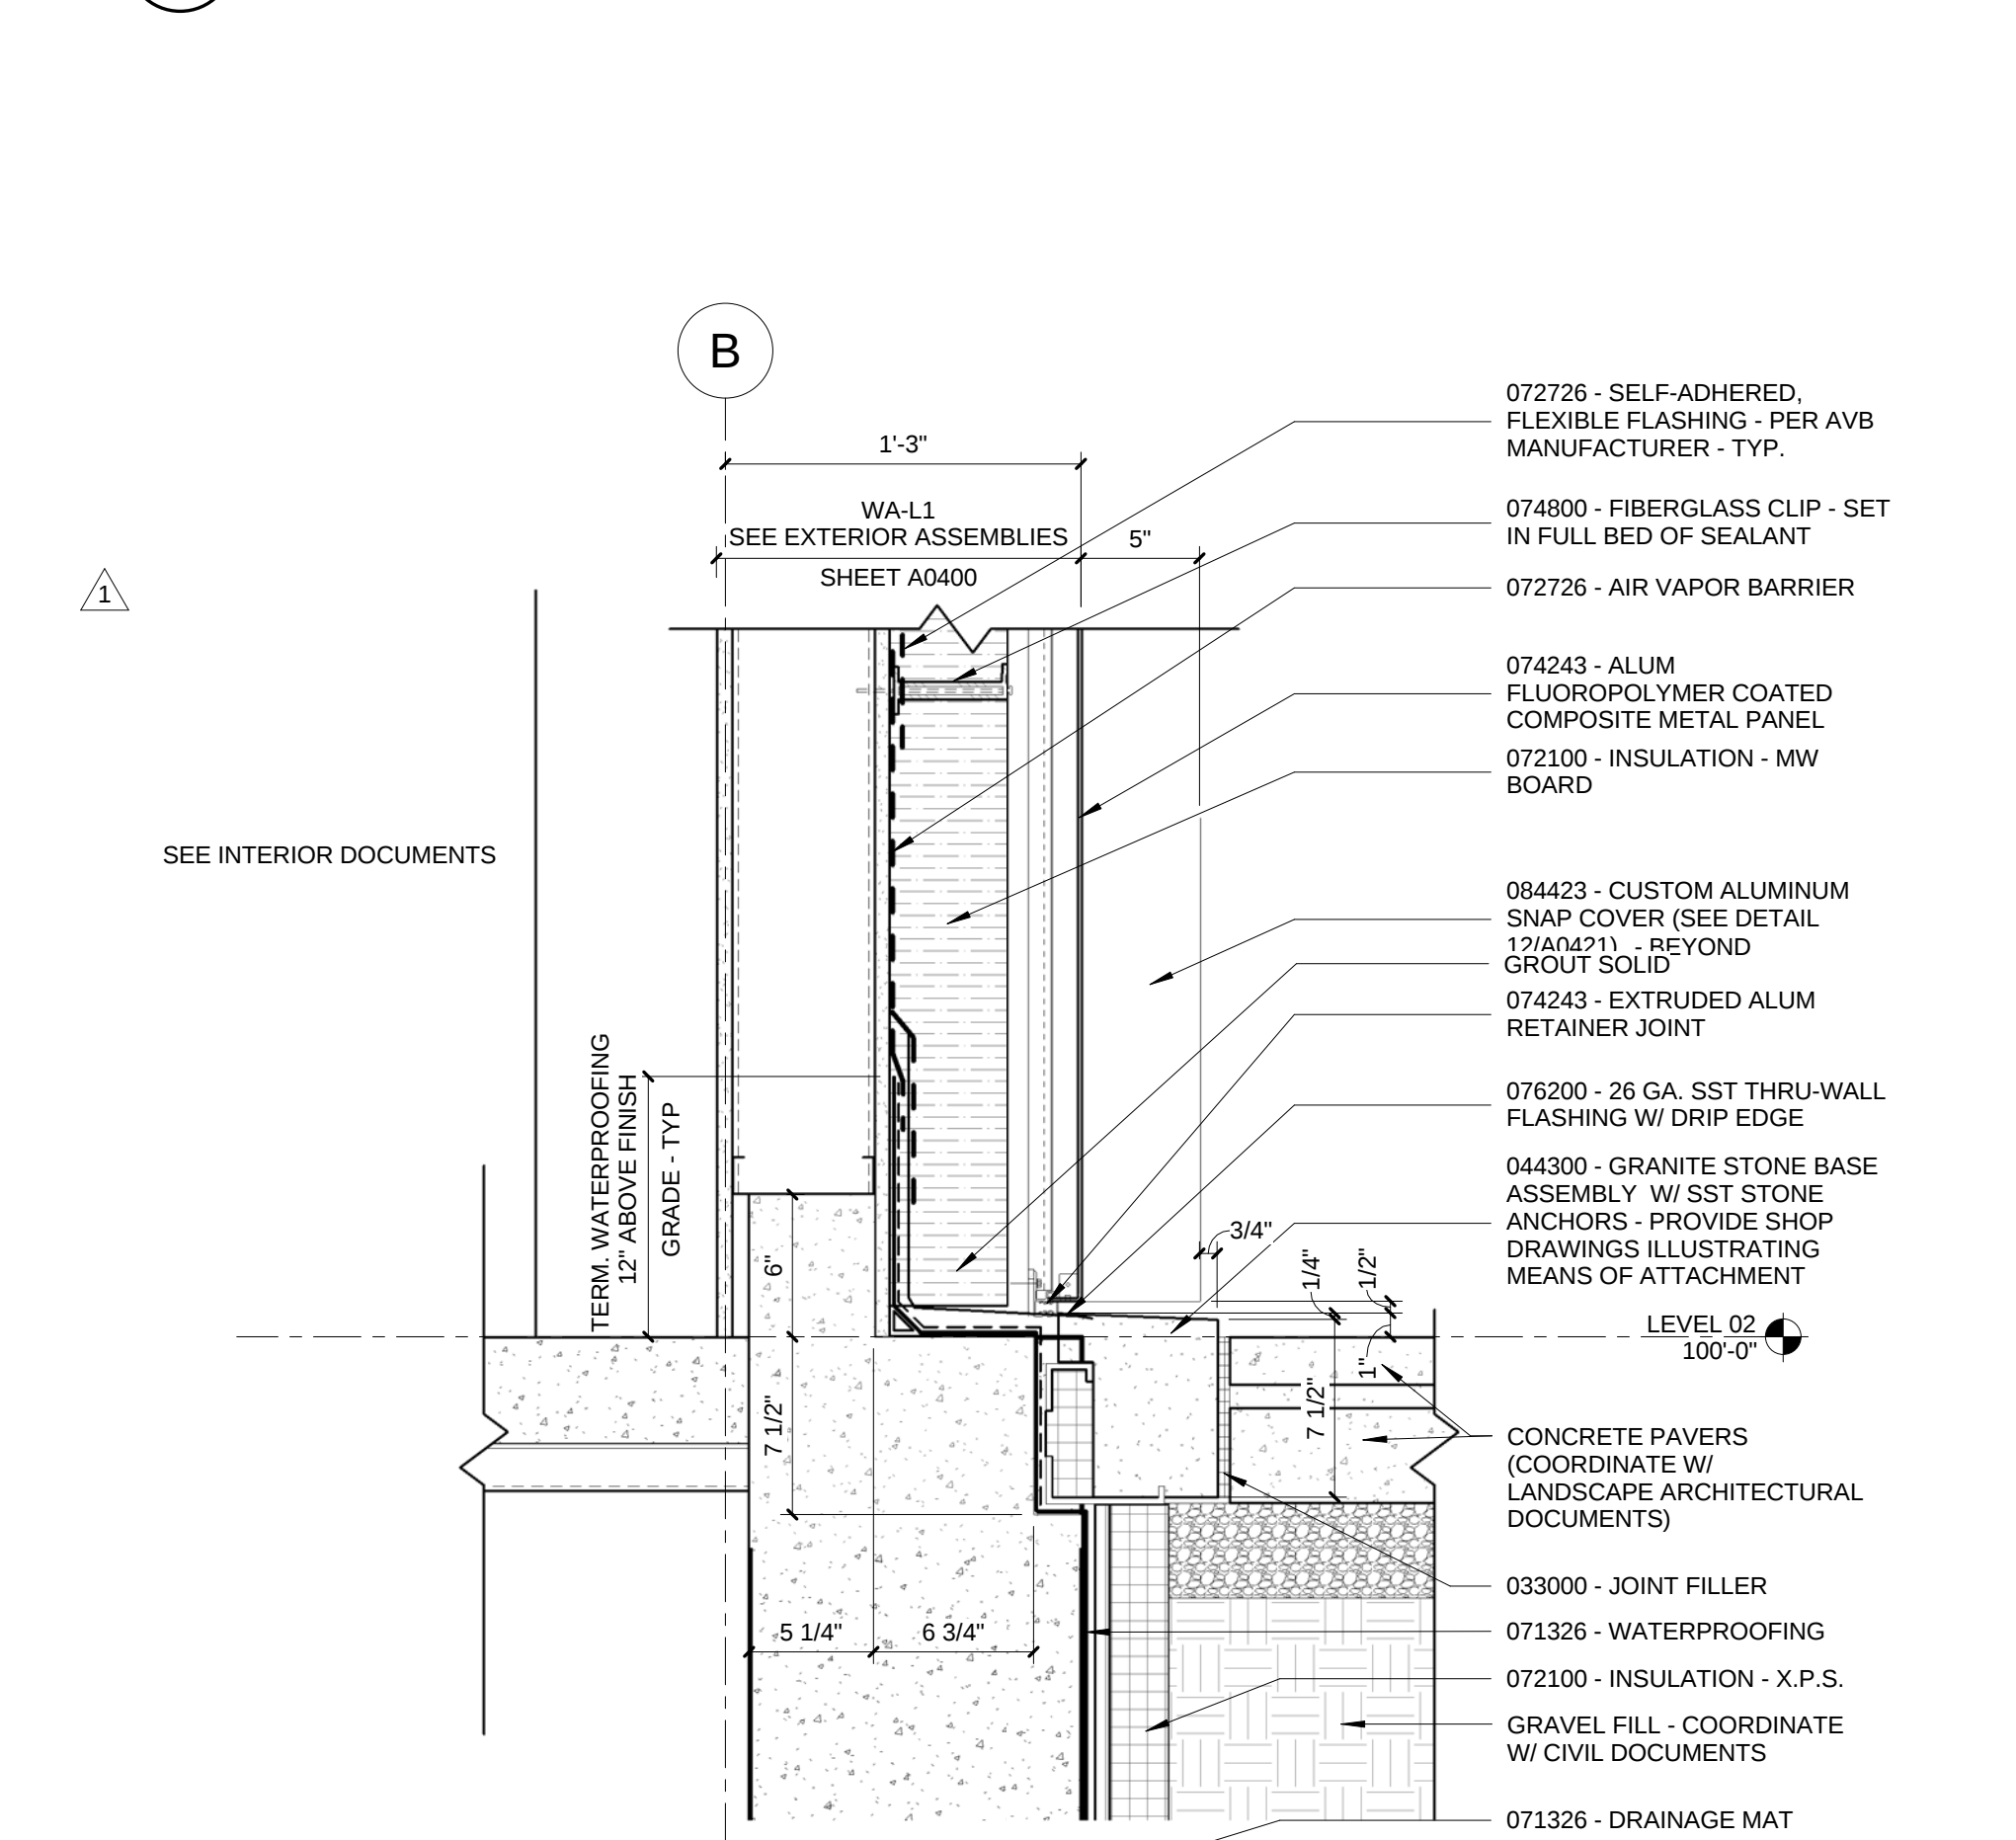


ENLARGED DETAIL - WA-L1 AT SOUTH ELEVATION

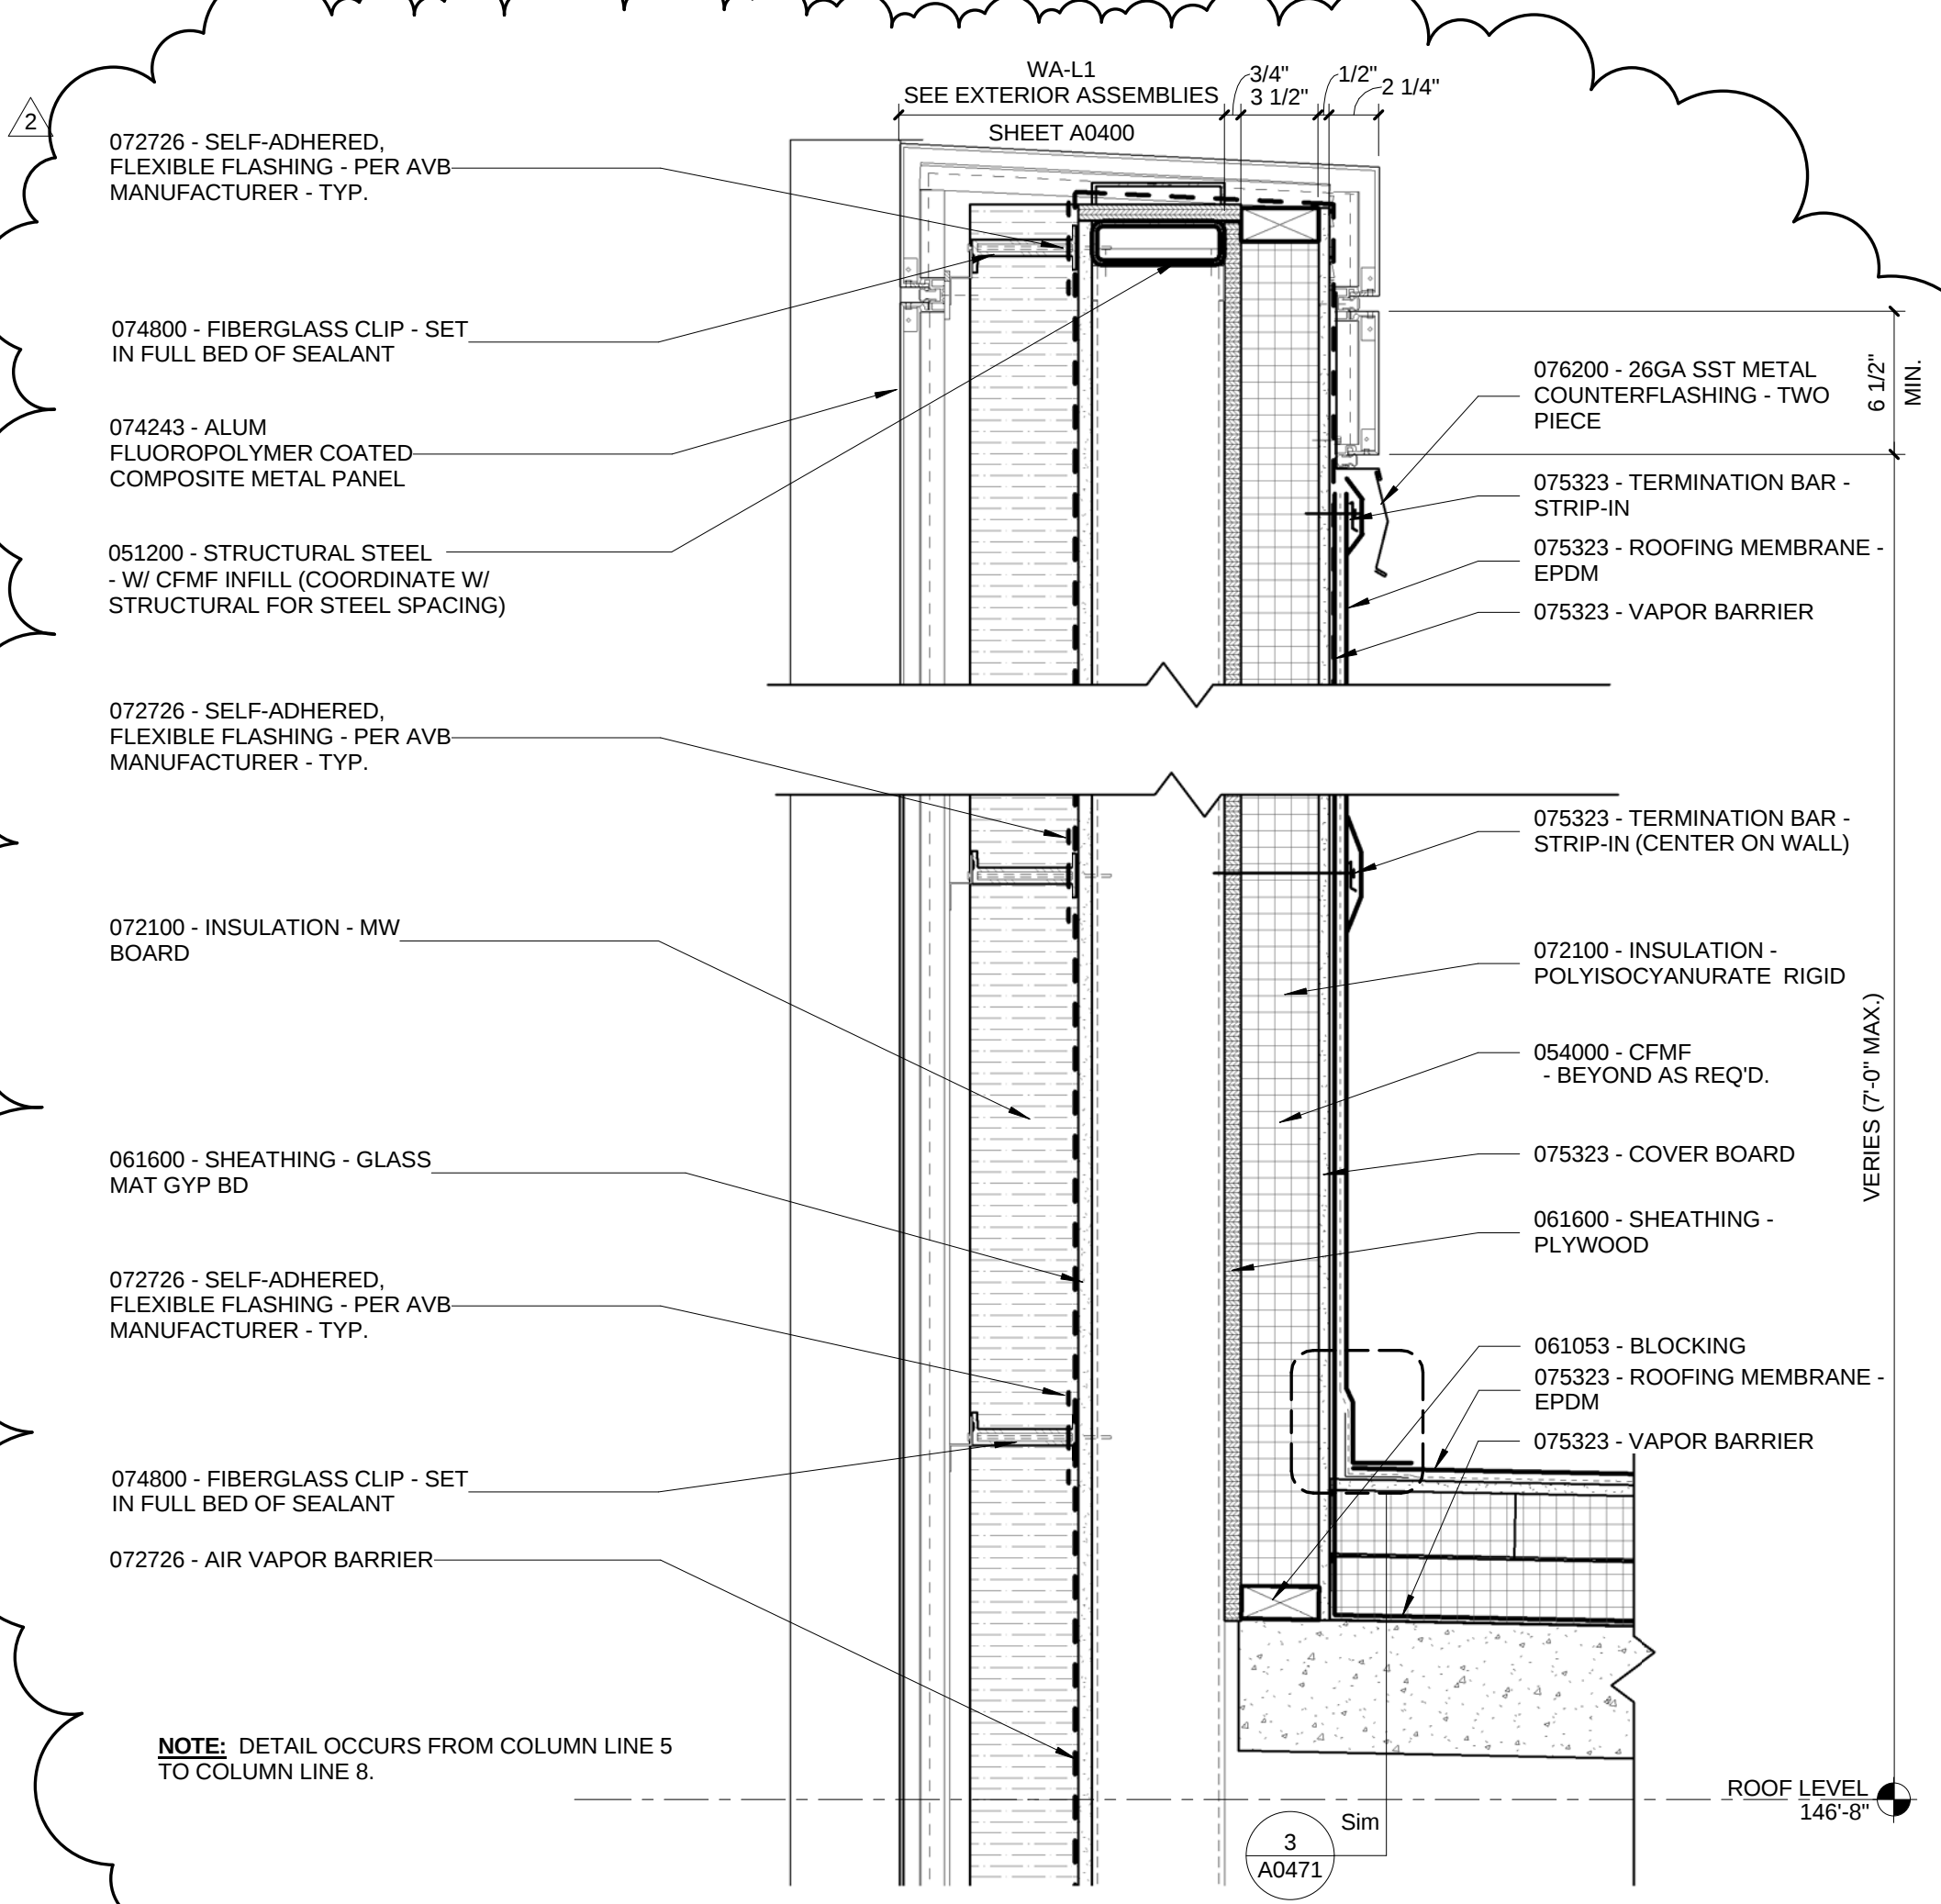


ENLARGED DETAIL - WA-L1 PARAPET @ MECHANICAL SCREEN

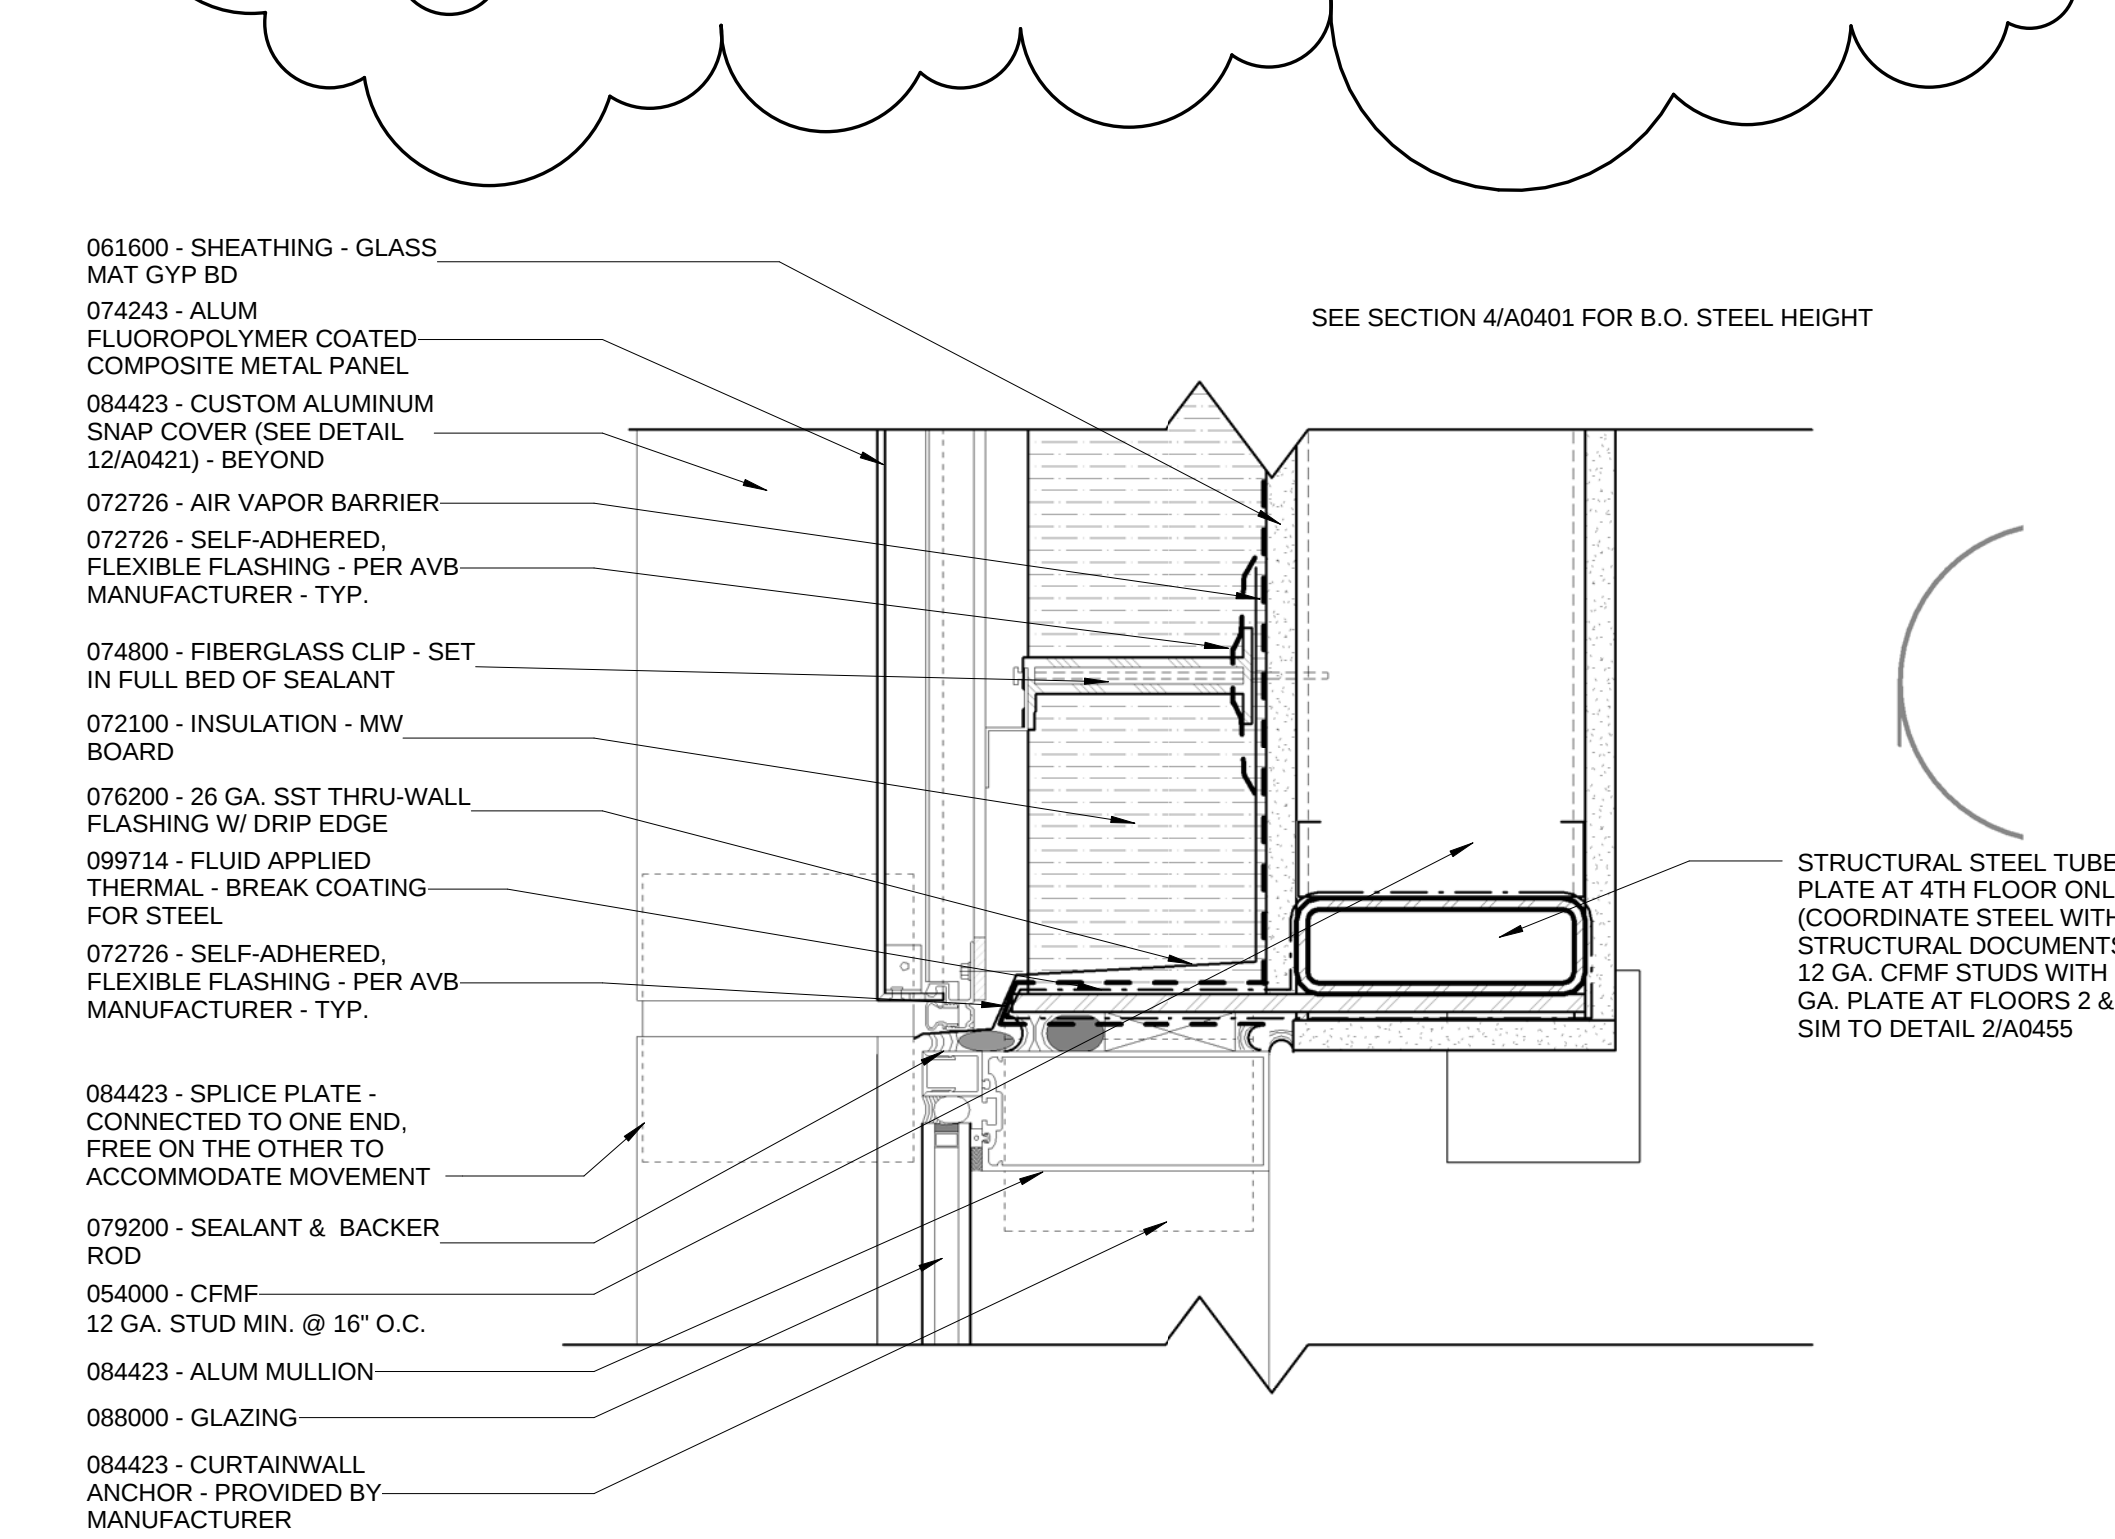


ENLARGED DETAIL - CURTAINWALL HEAD @ WA-L1

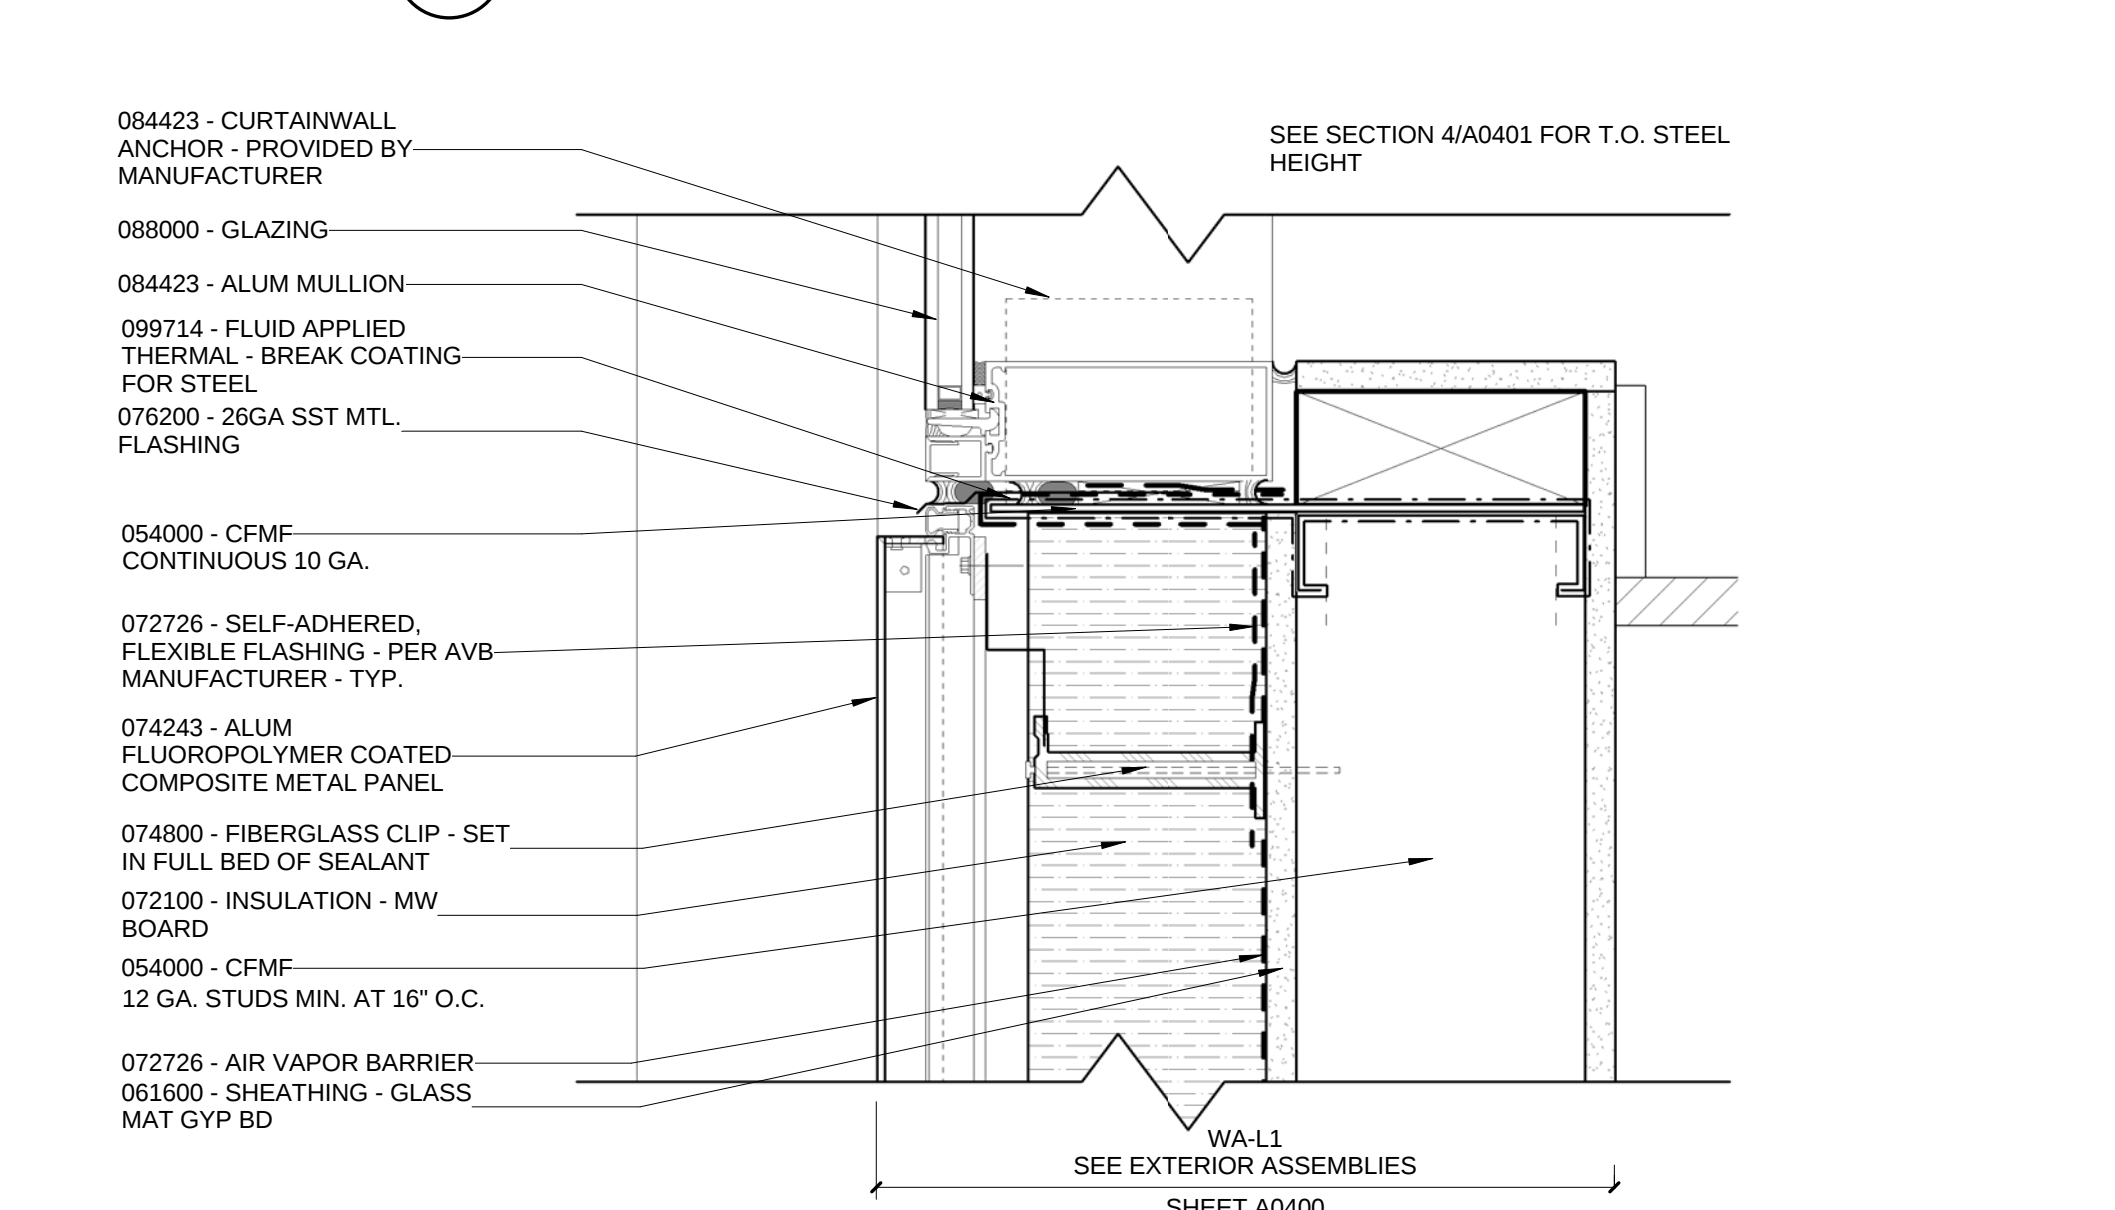


ENLARGED DETAIL - CURTAINWALL SILL @ WA-L1

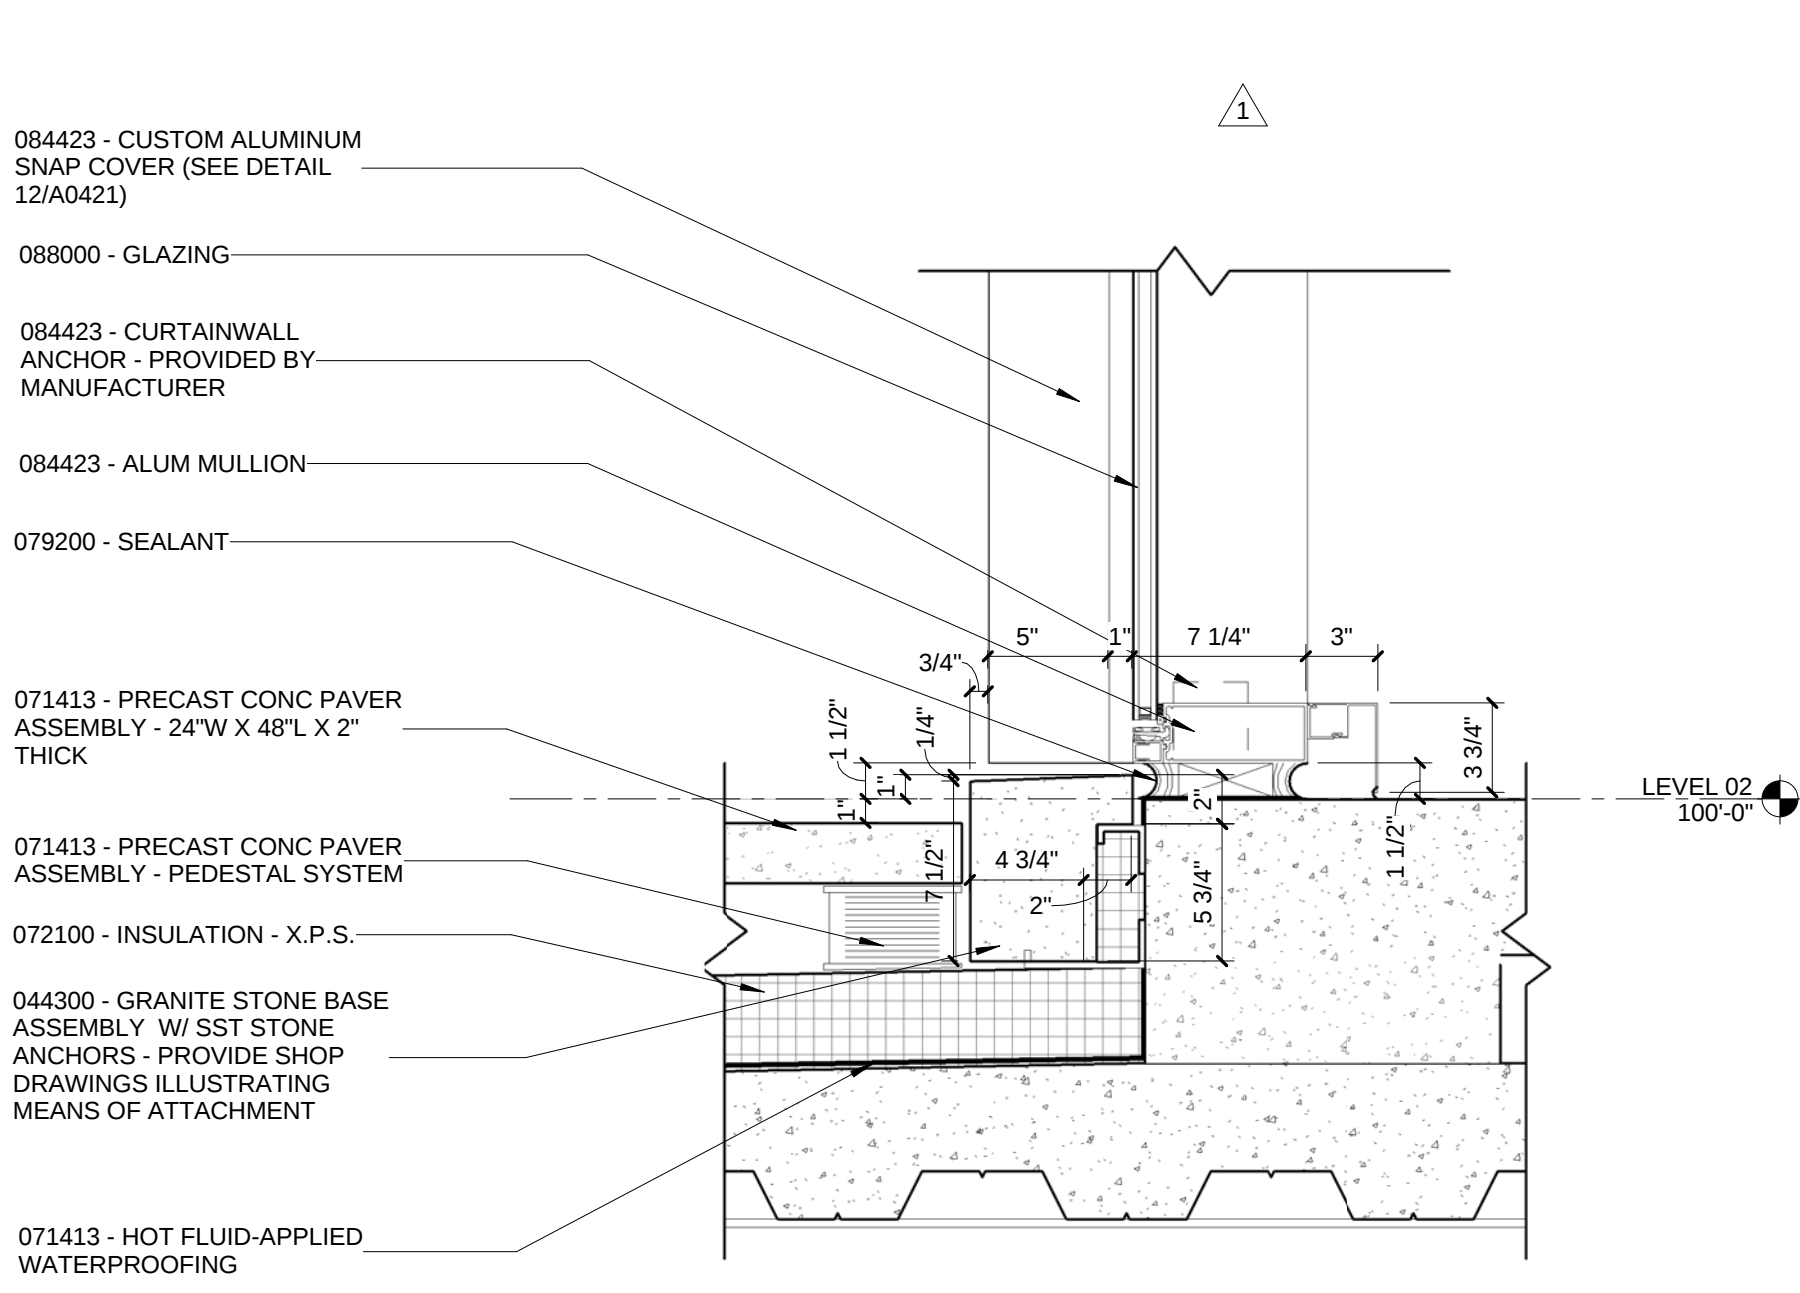

ENLARGED DETAIL - CURTAINWALL SILL @ WALKING SURFACE/GRANITE

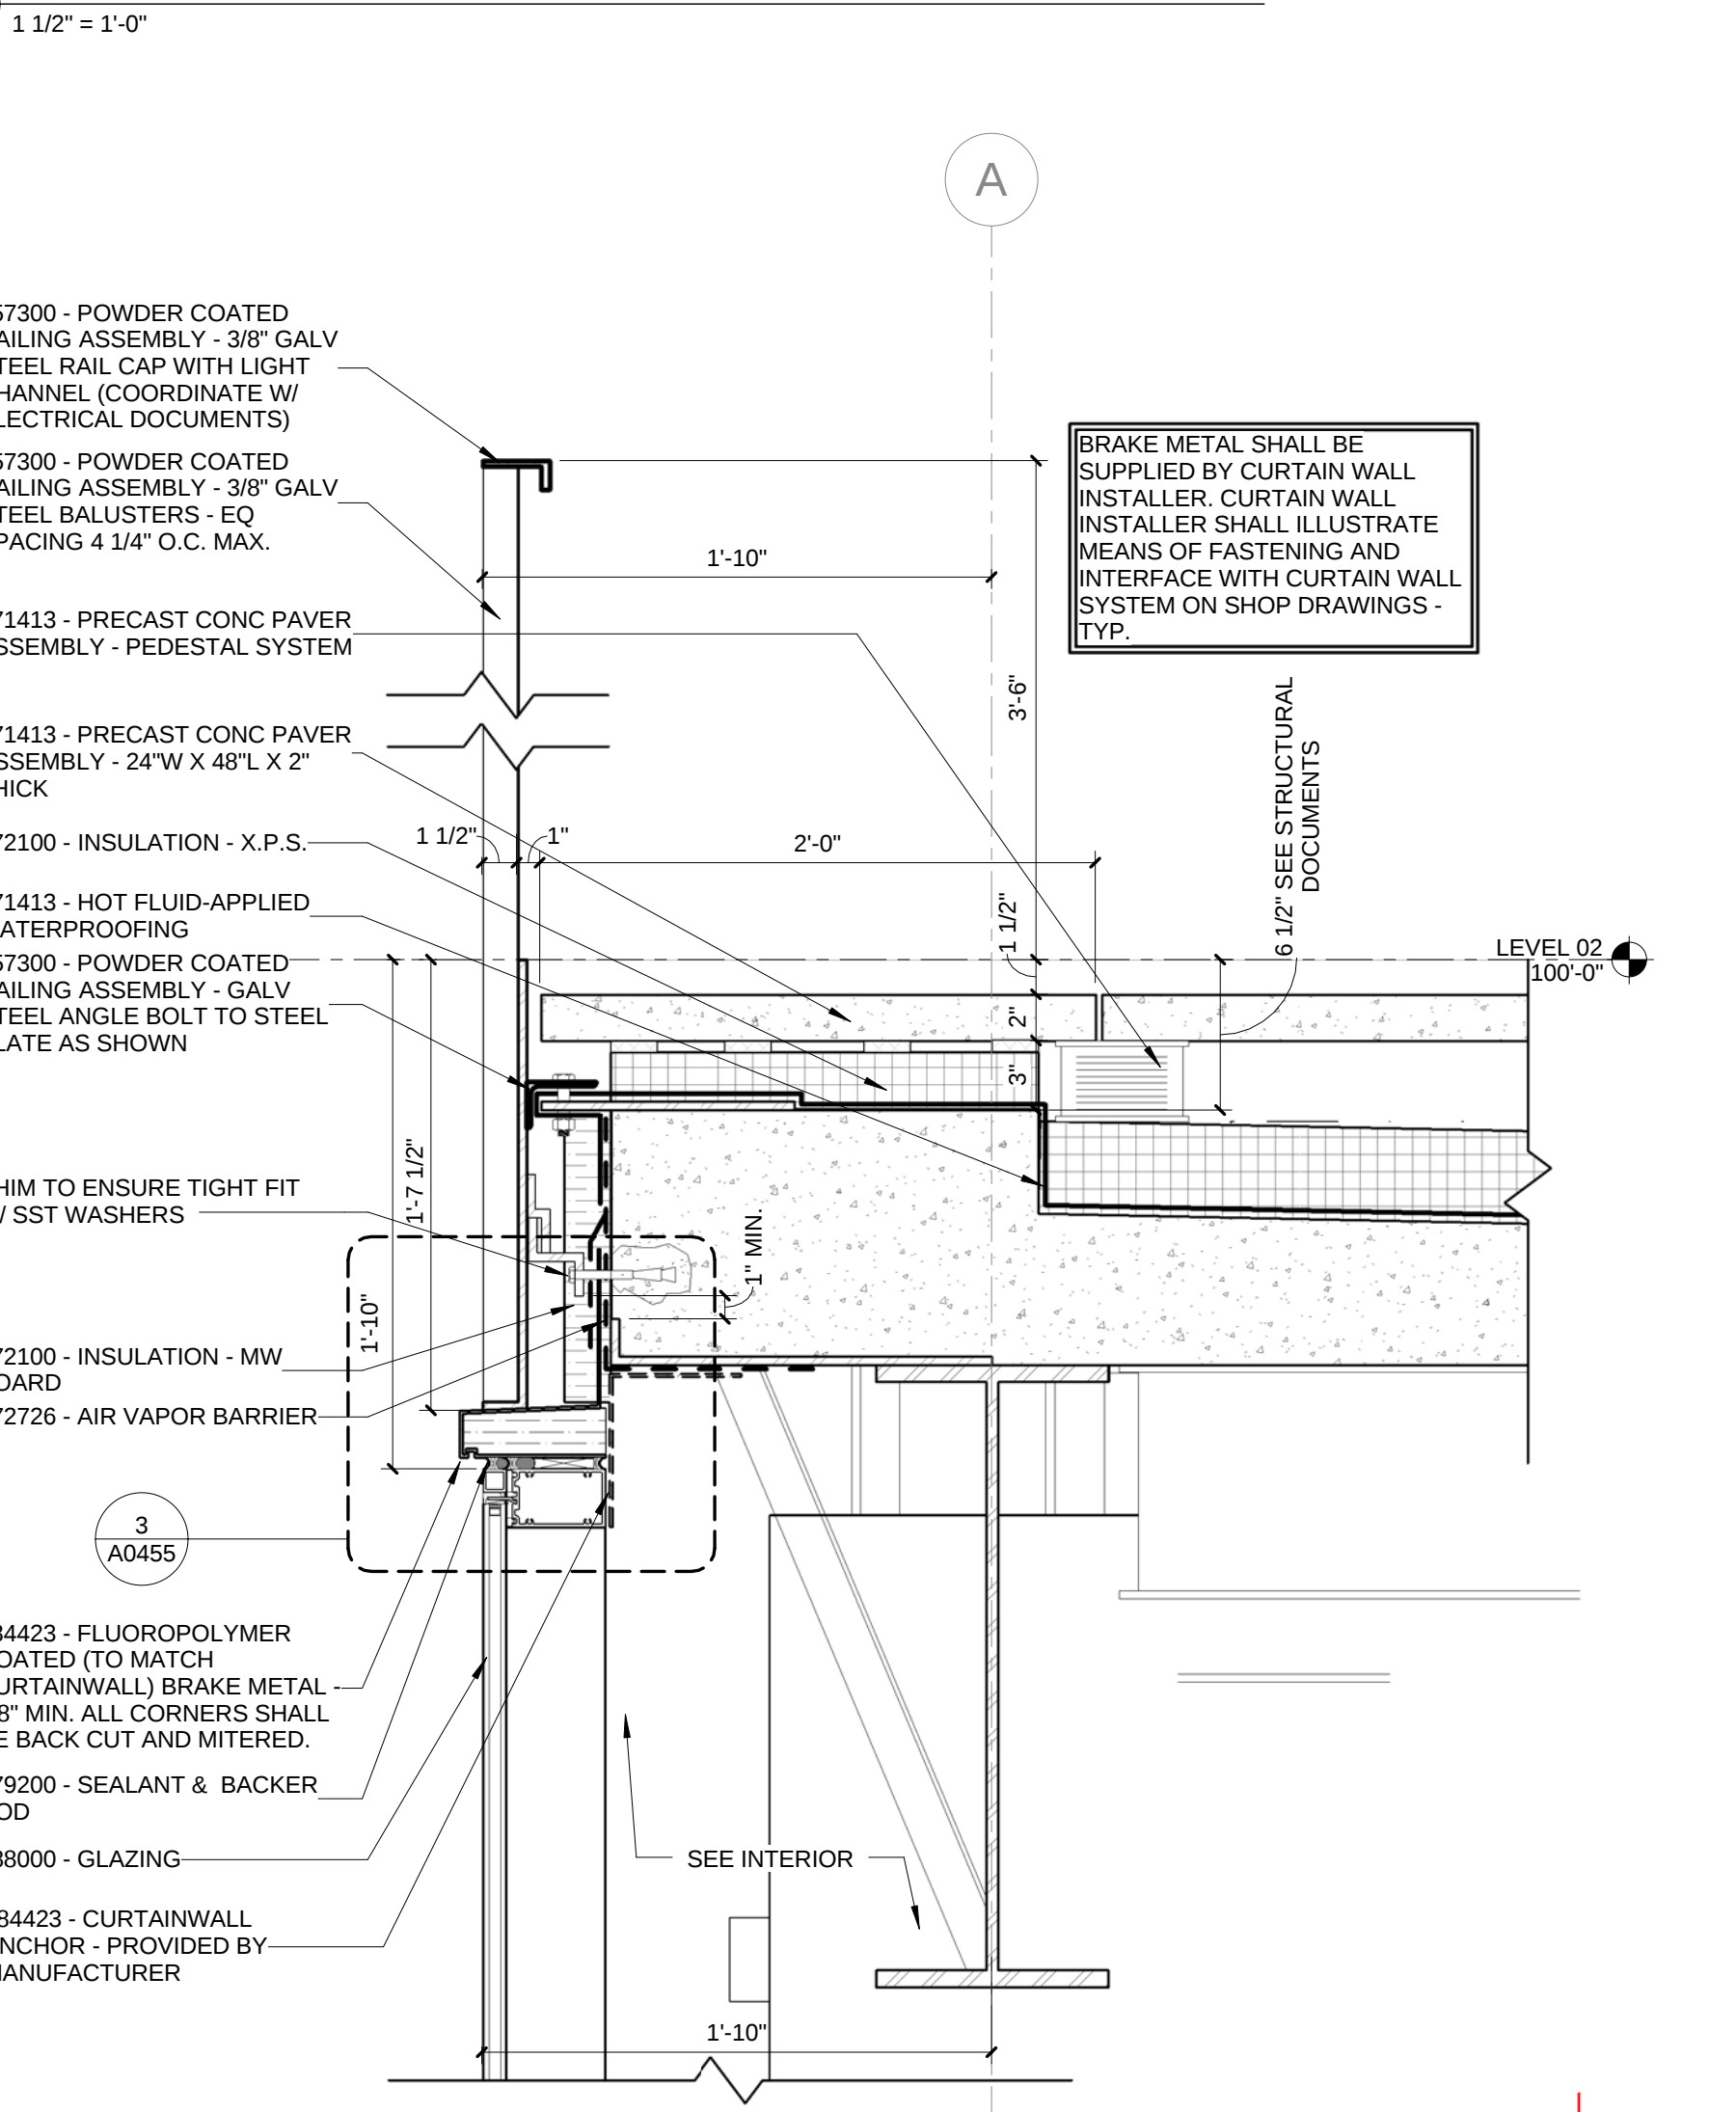

ENLARGED DETAIL - SOUTH WALKING SURFACE @ CURTAINWALL

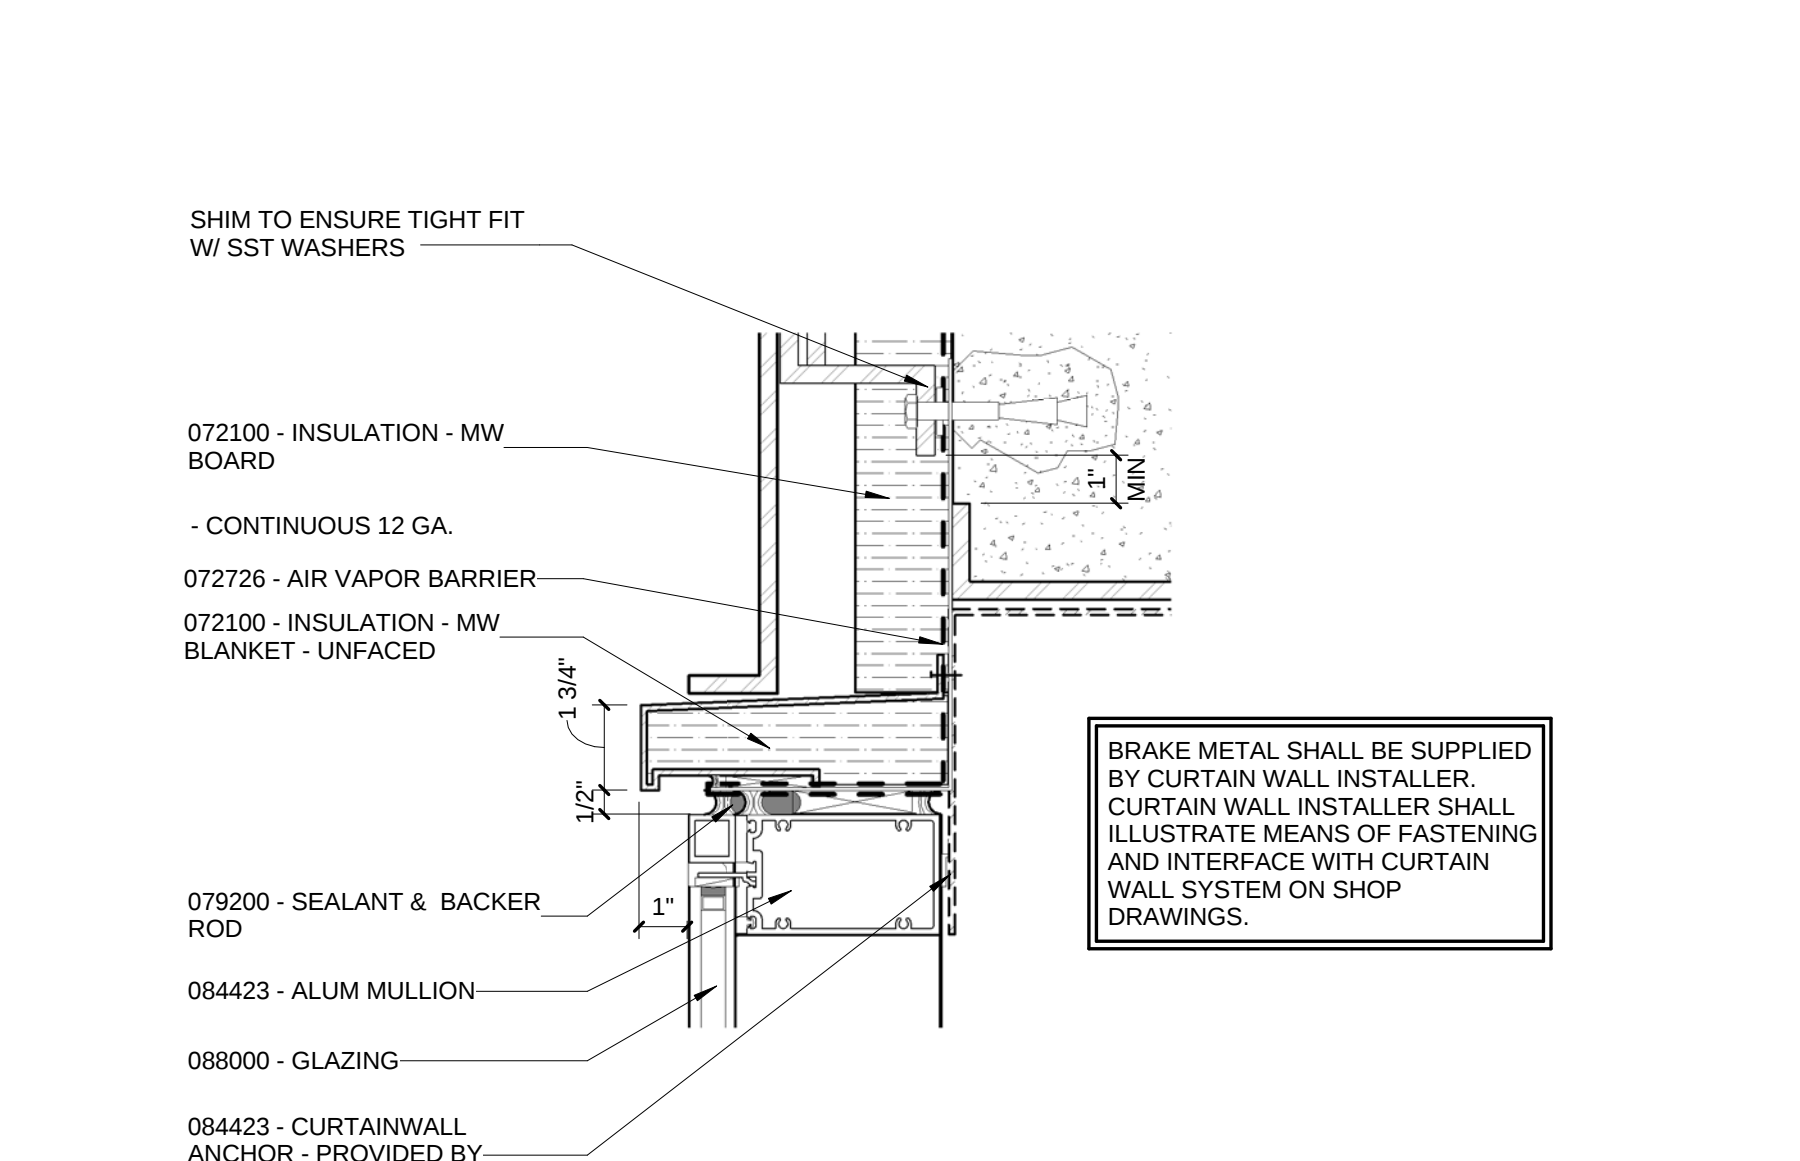

ENLARGED DETAIL - SOUTH WALKING SURFACE BRAKE METAL