




© Cannon Design 2015
All rights reserved. No part of this document may be reproduced or transmitted in any form without prior written authorization by The Cannon Corporation.
3/11/2016 12:43:36 PM

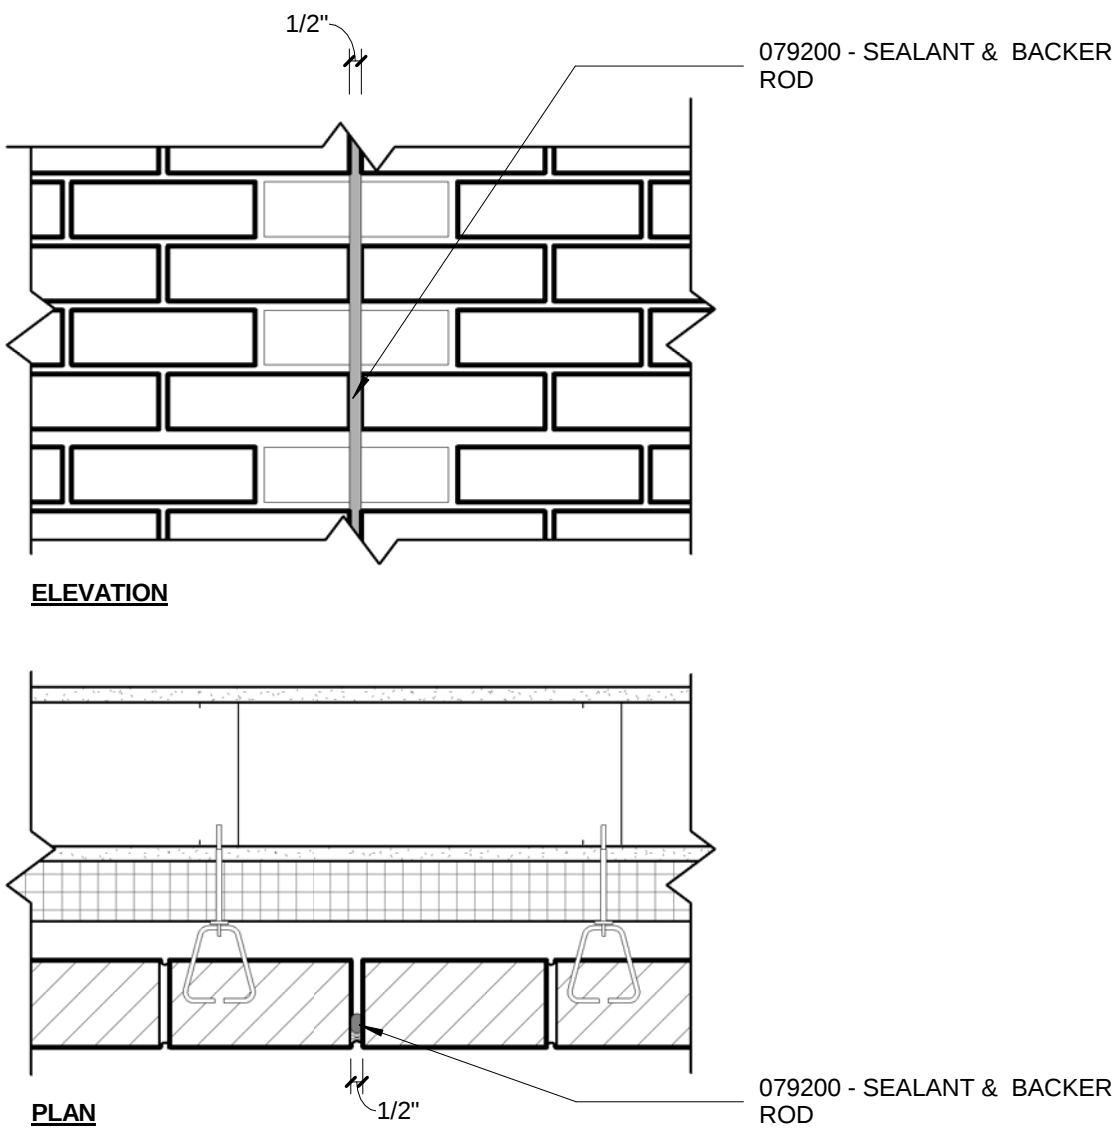


8 VERTICAL CONTROL JOINT
1 1/2" = 1'-0"

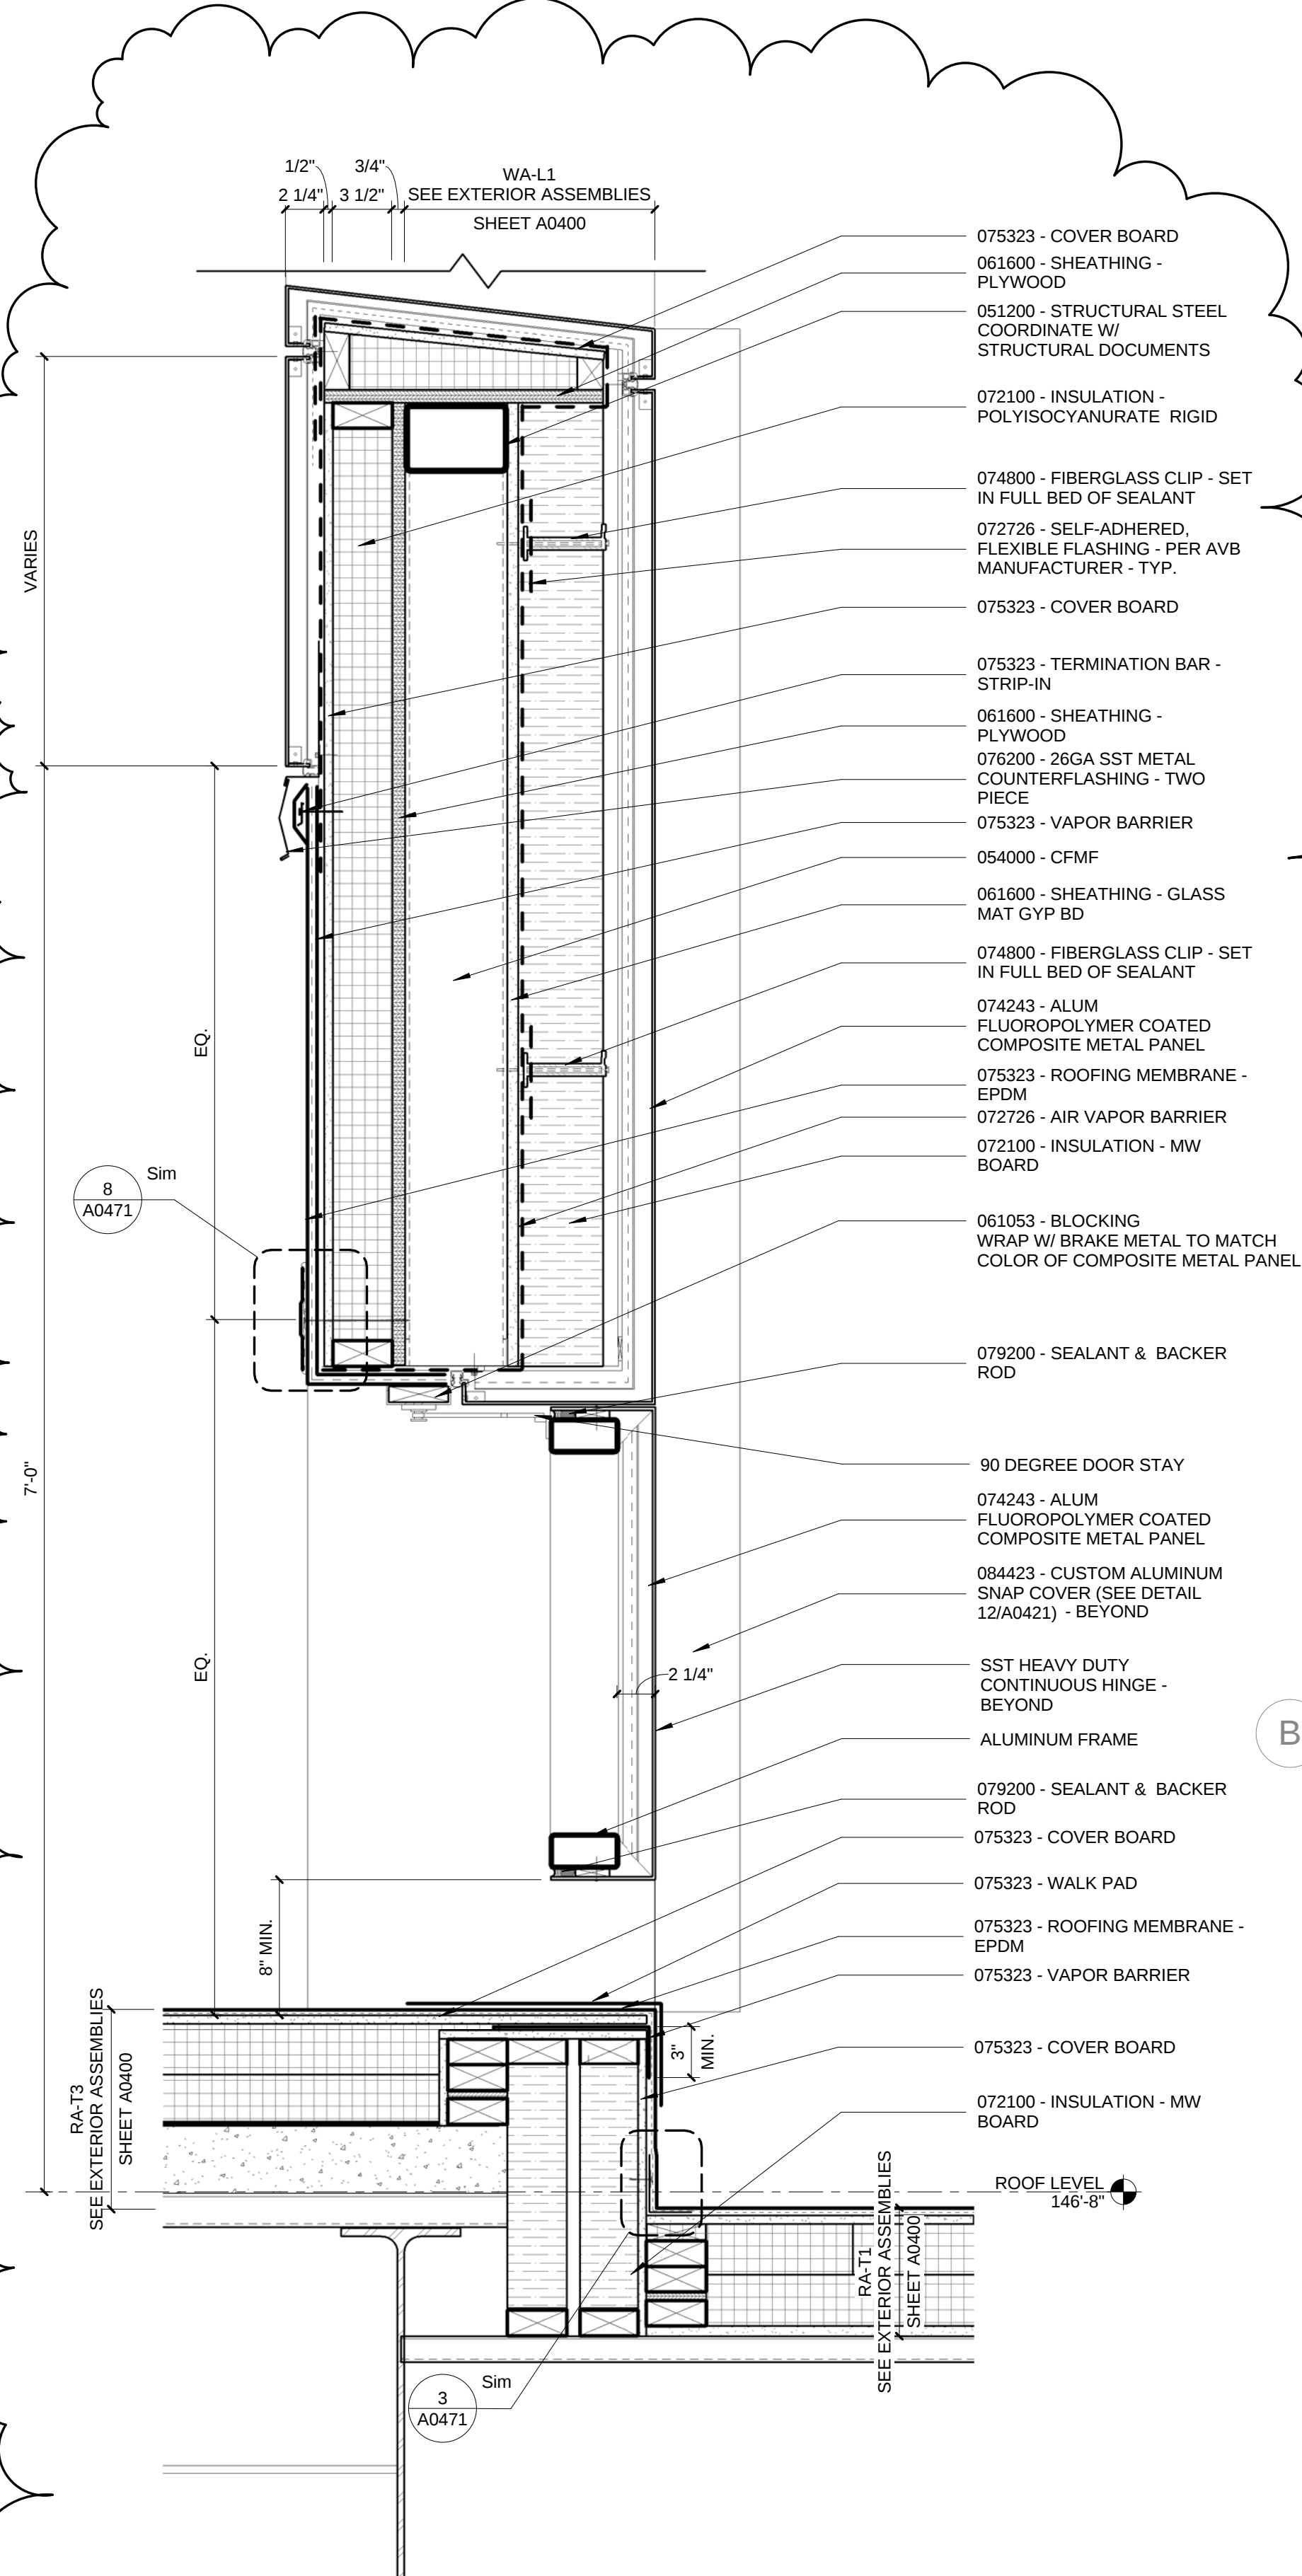


3 ENLARGED DETAIL - DOOR @ SOUTH ROOF
1 1/2" = 1'-0"

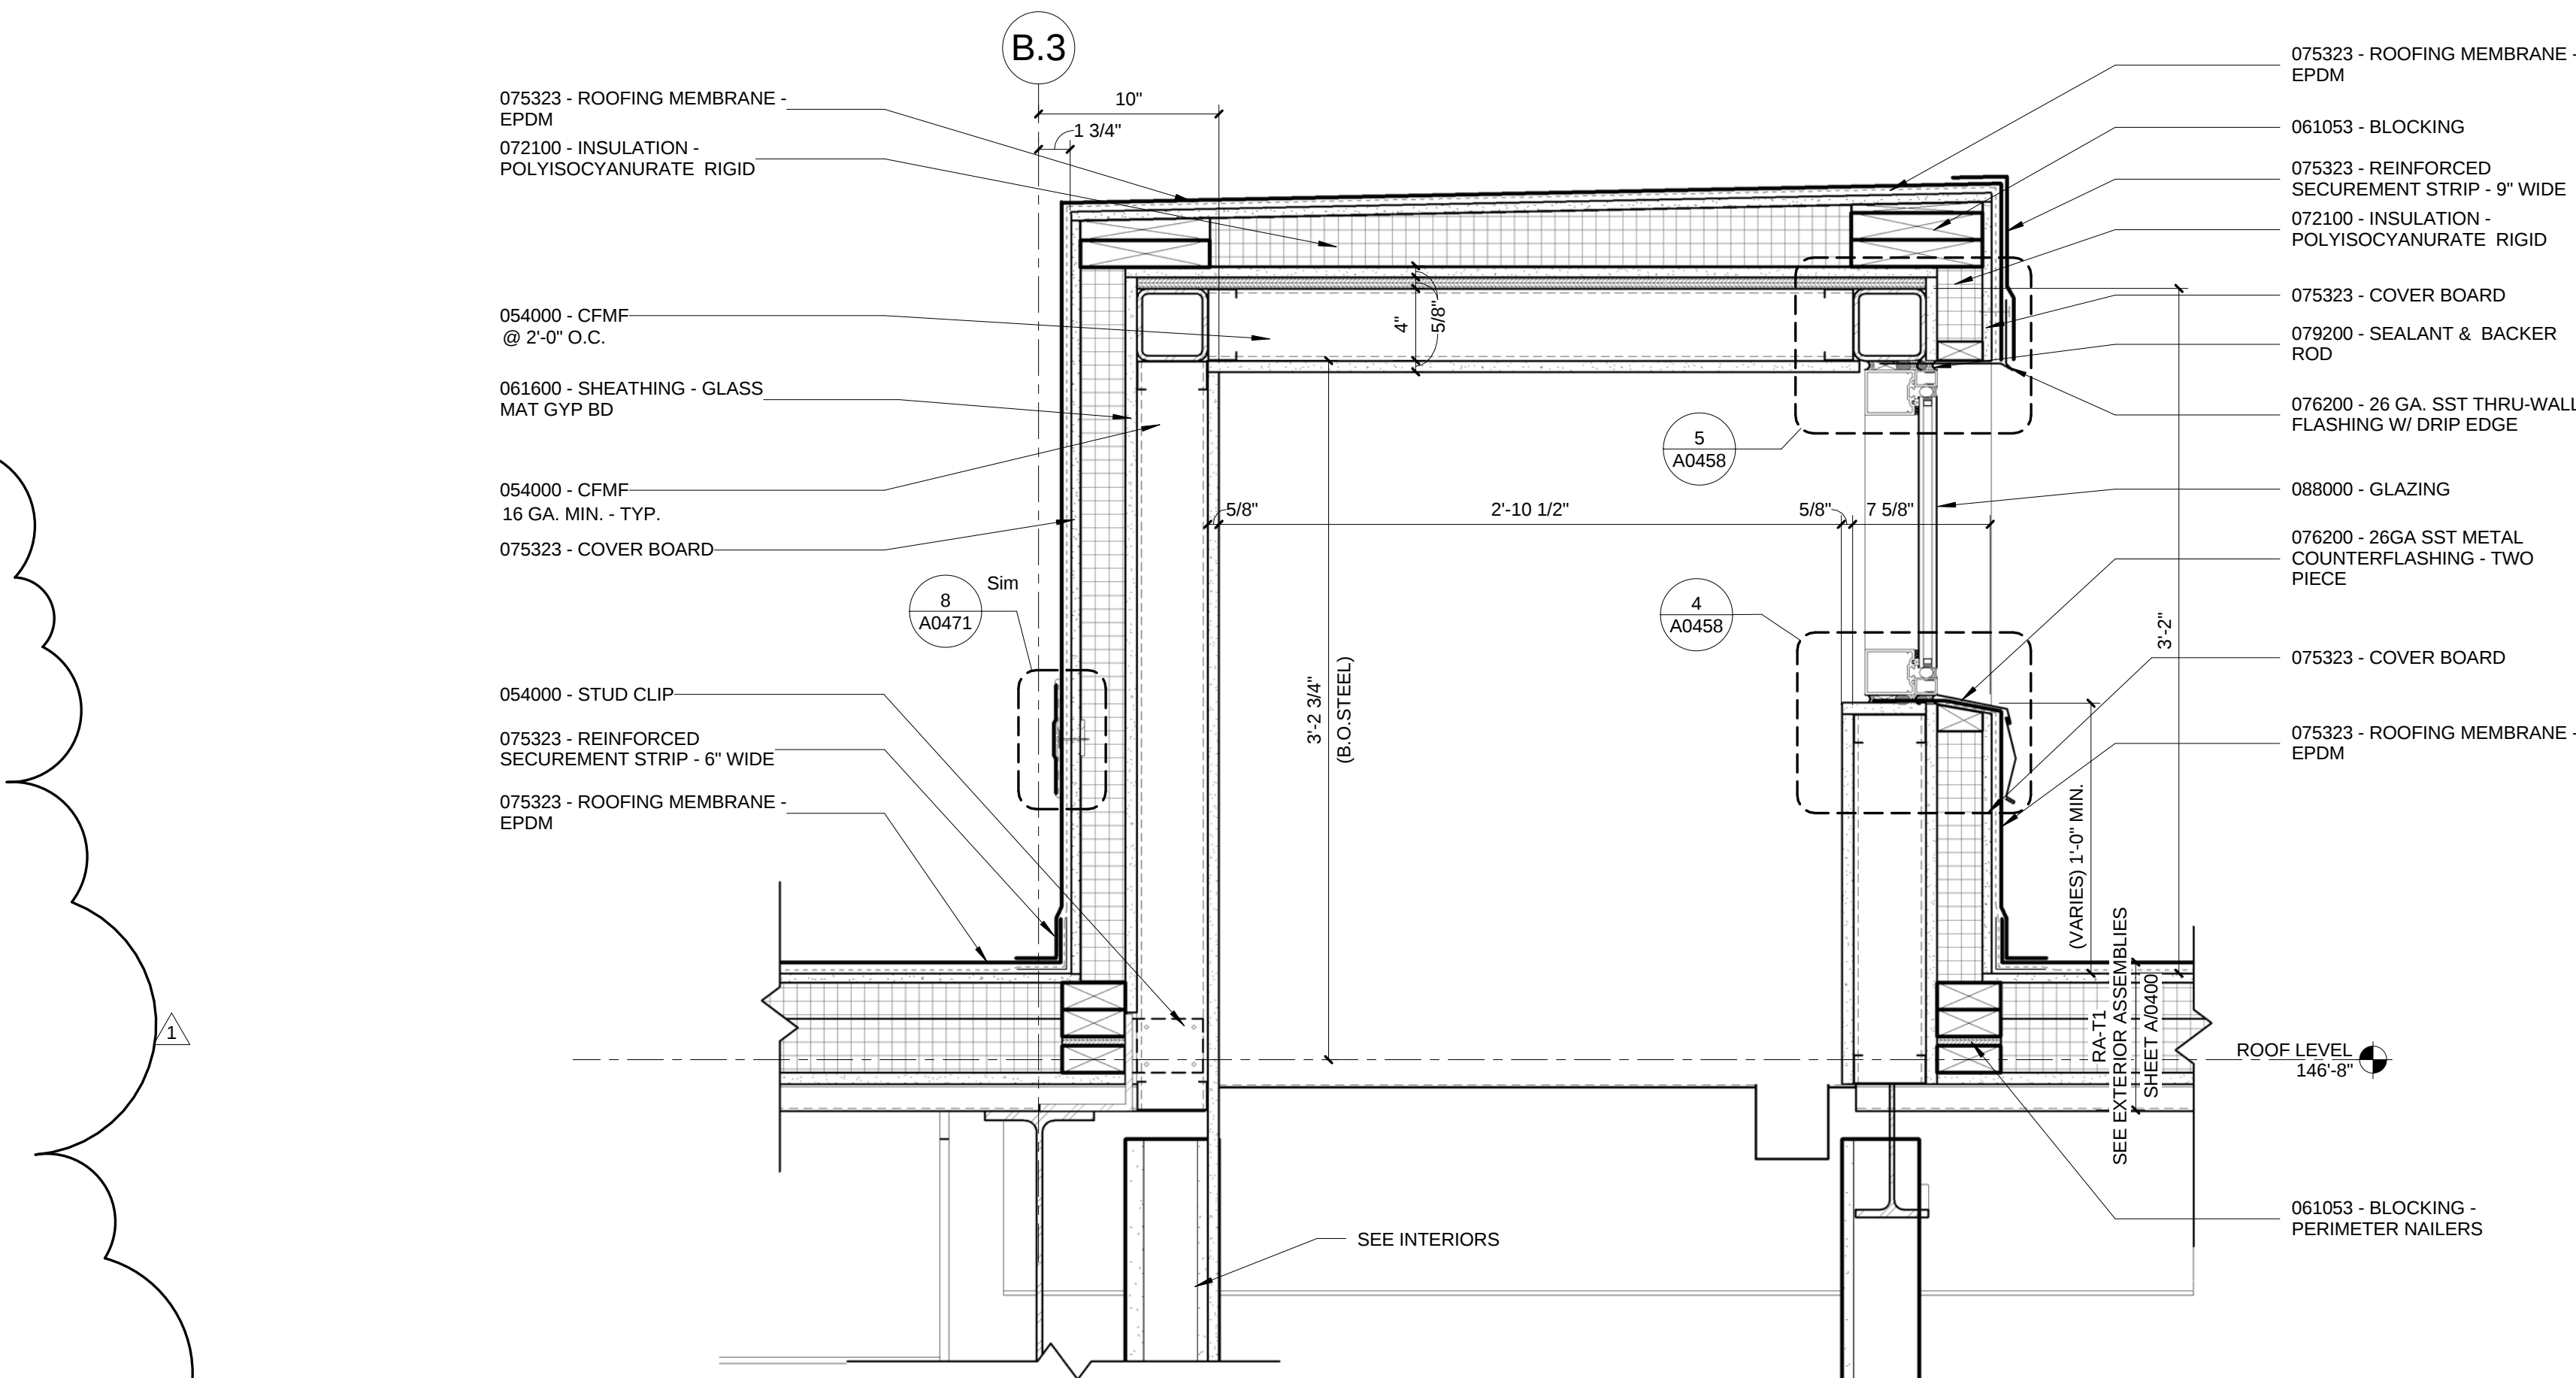


6 ENLARGED DETAIL - MONITOR ROOF
1 1/2" = 1'-0"

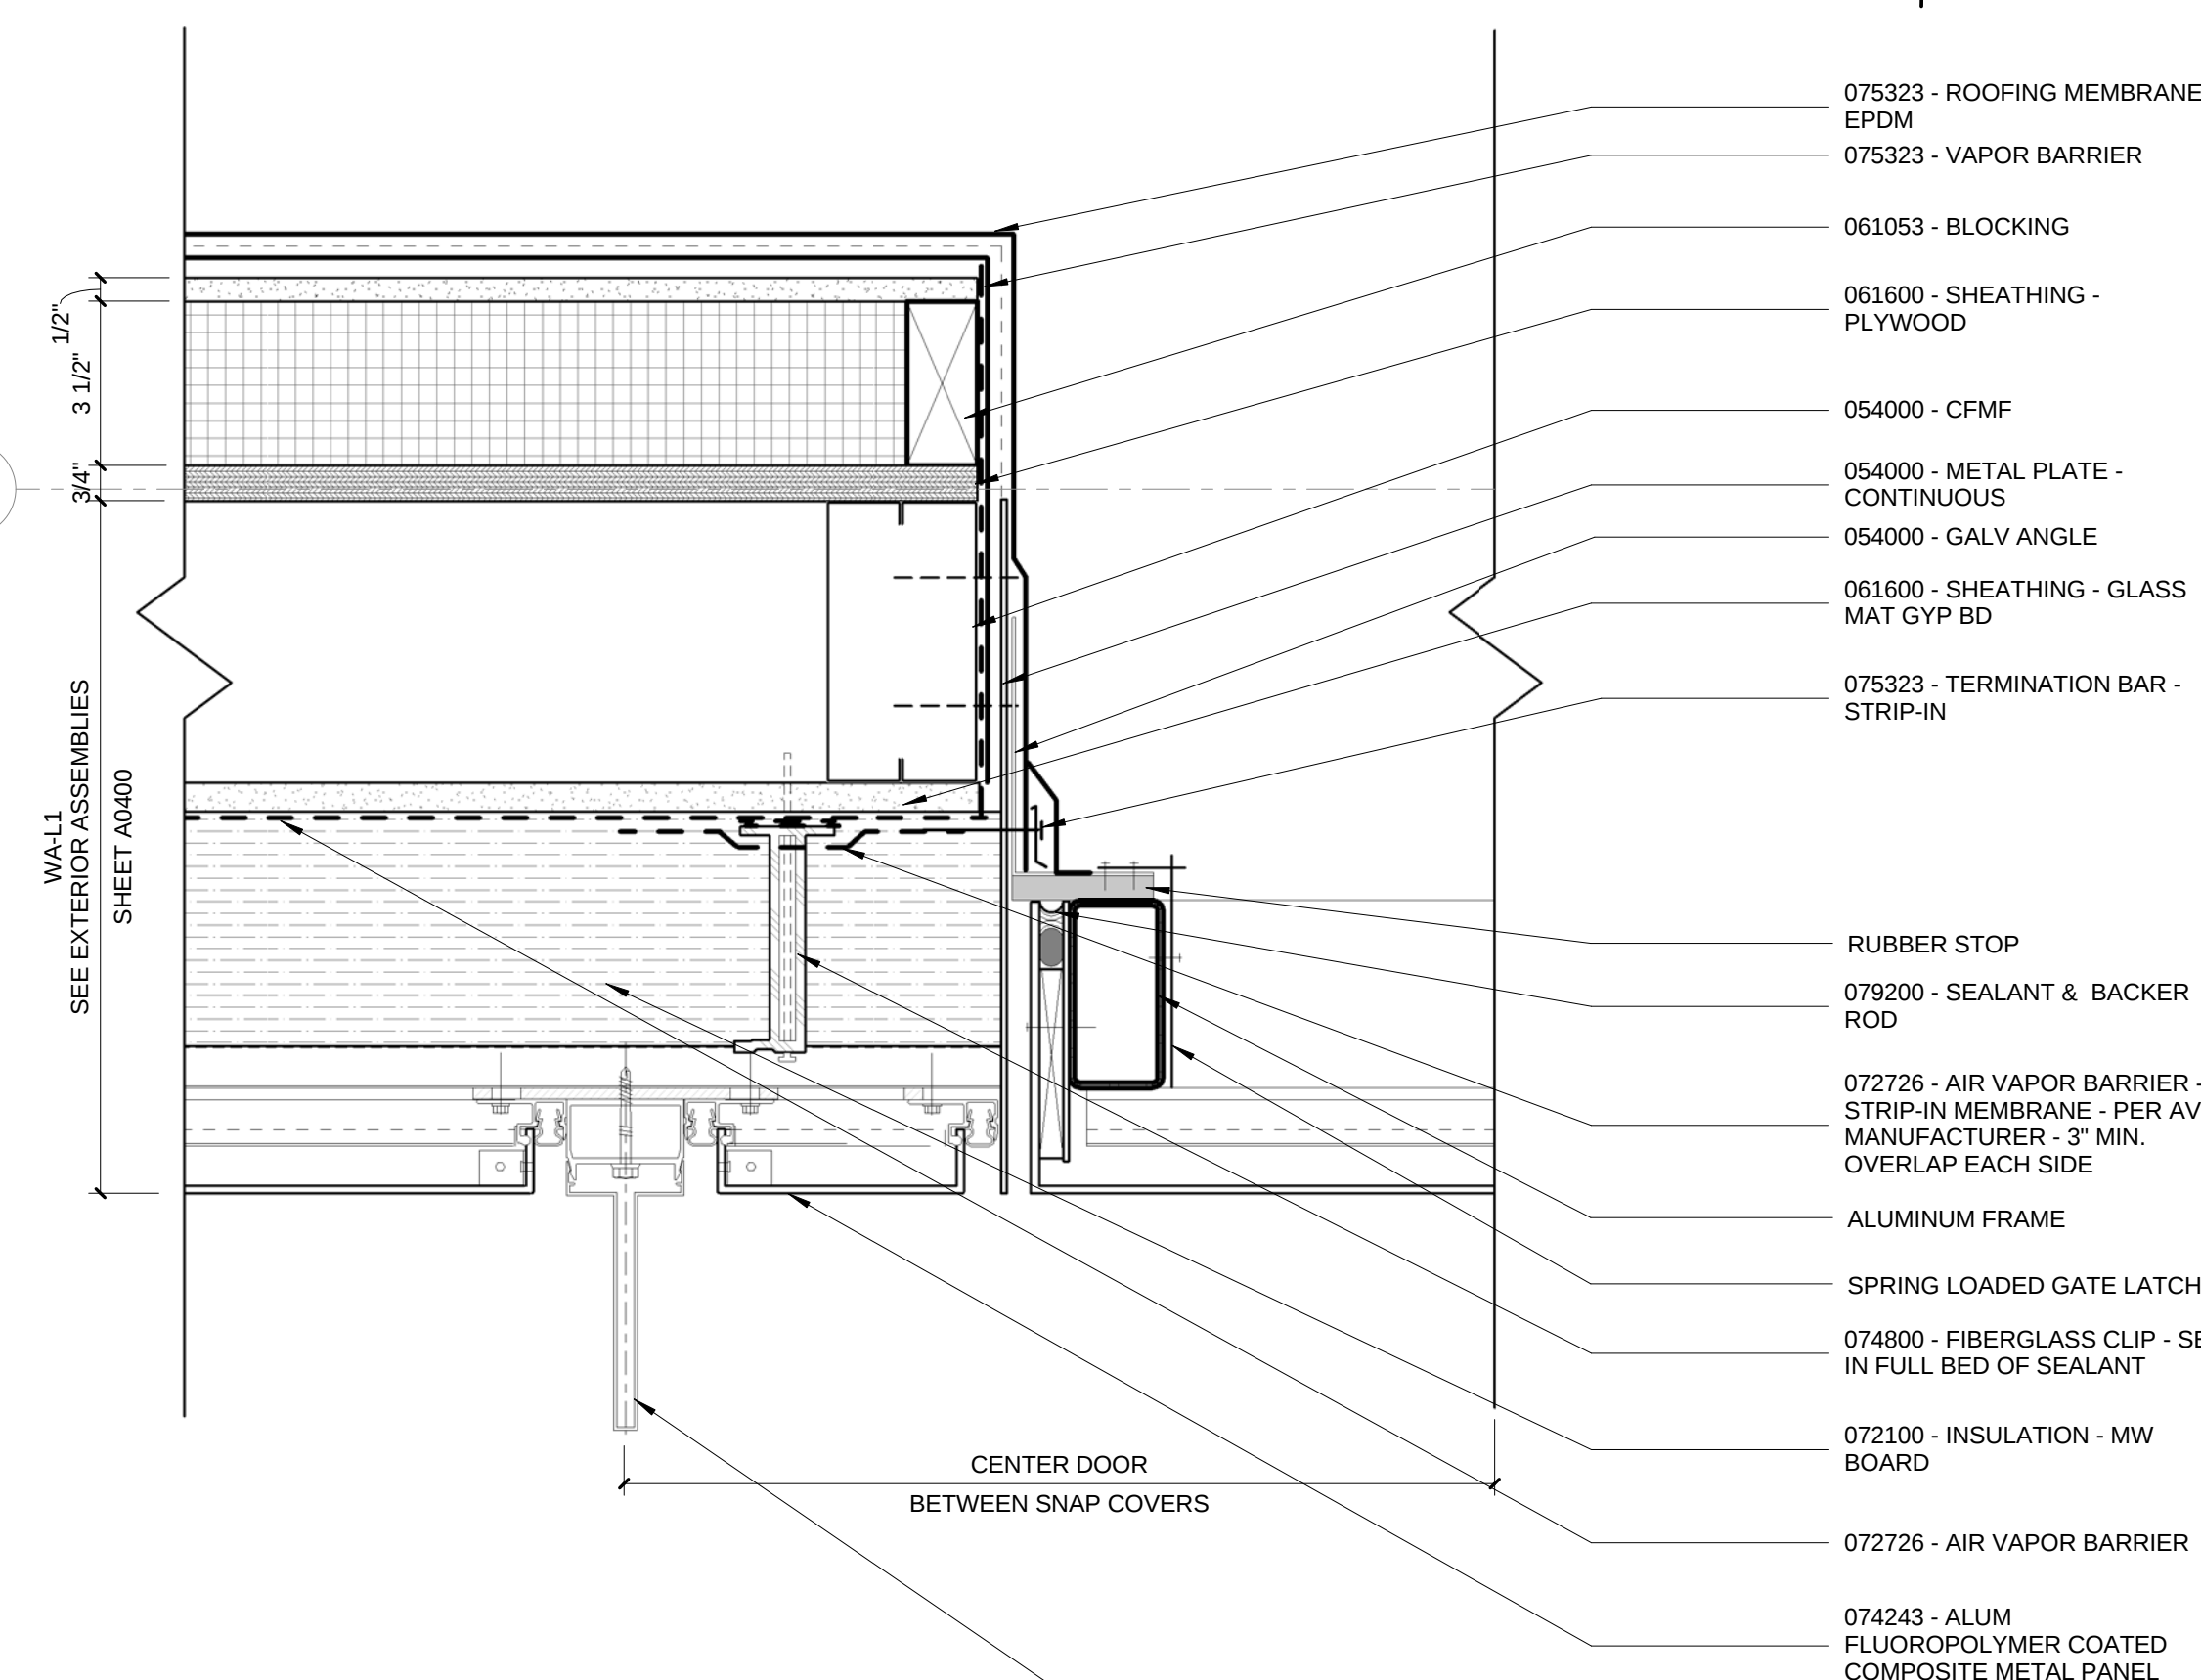


2 ENLARGED DETAIL - DOOR JAMB @ SOUTH ROOF
3" = 1'-0"

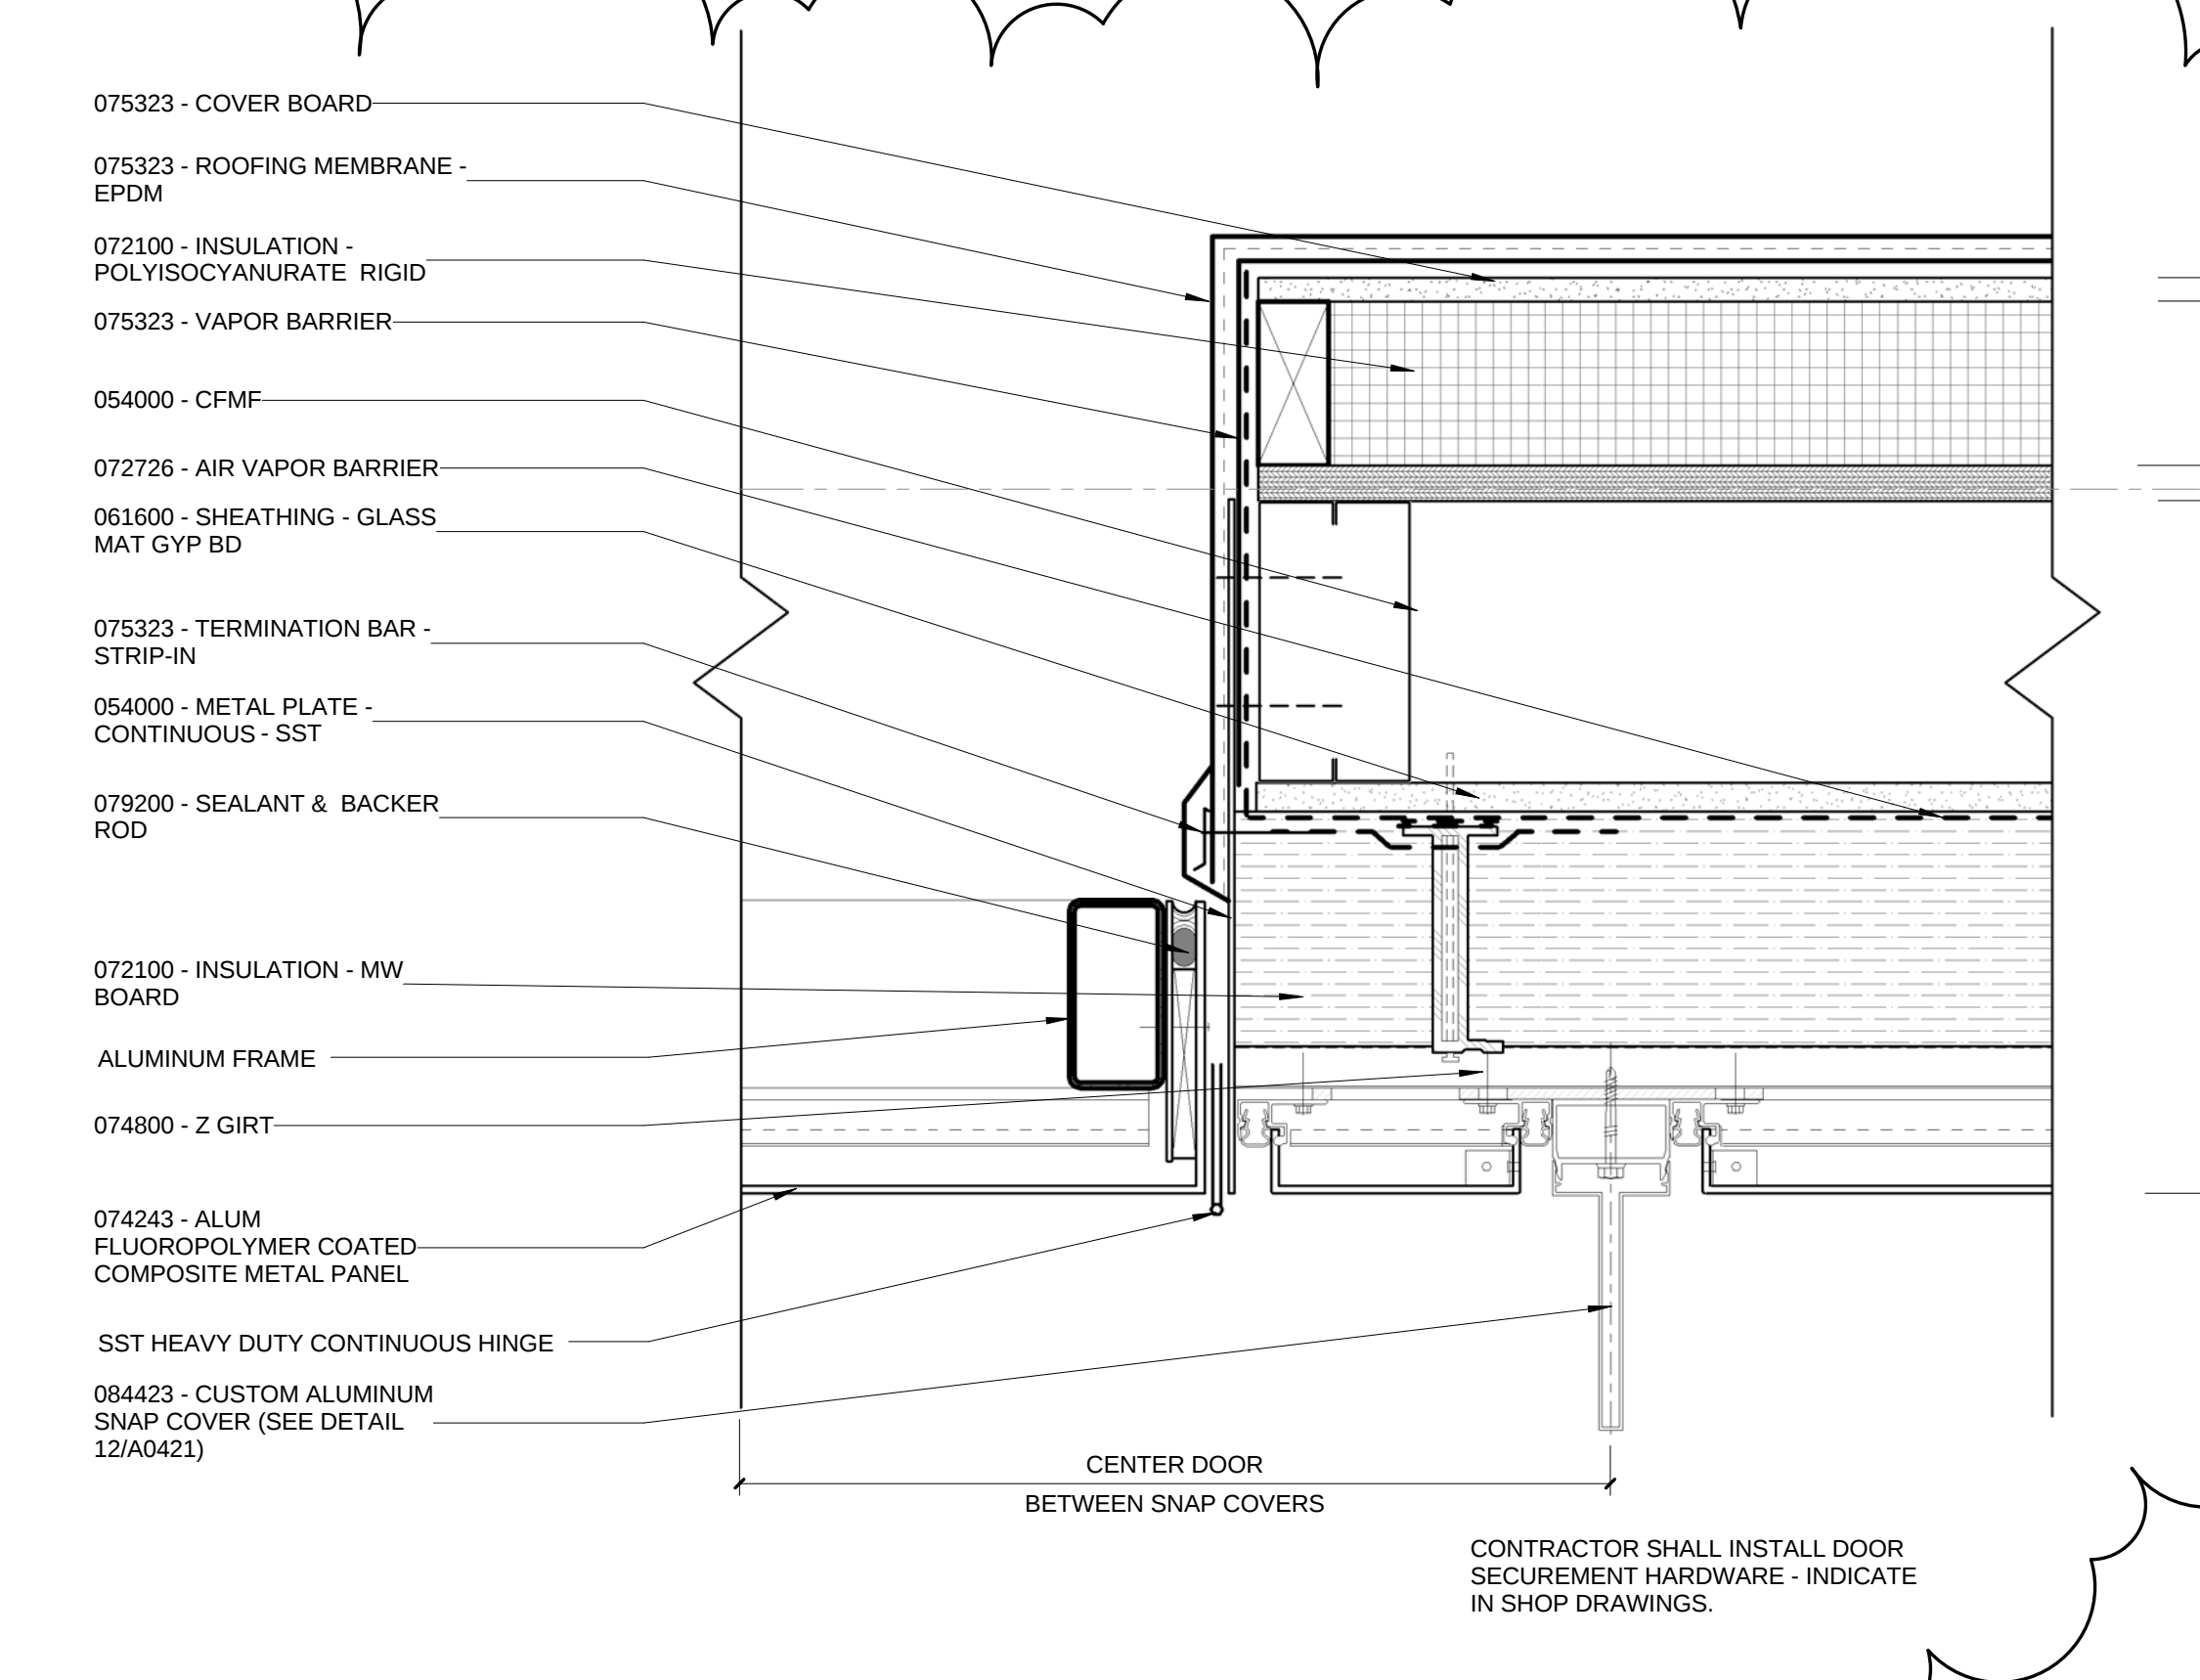


1 ENLARGED DETAIL - DOOR HINGE @ SOUTH ROOF
3" = 1'-0"

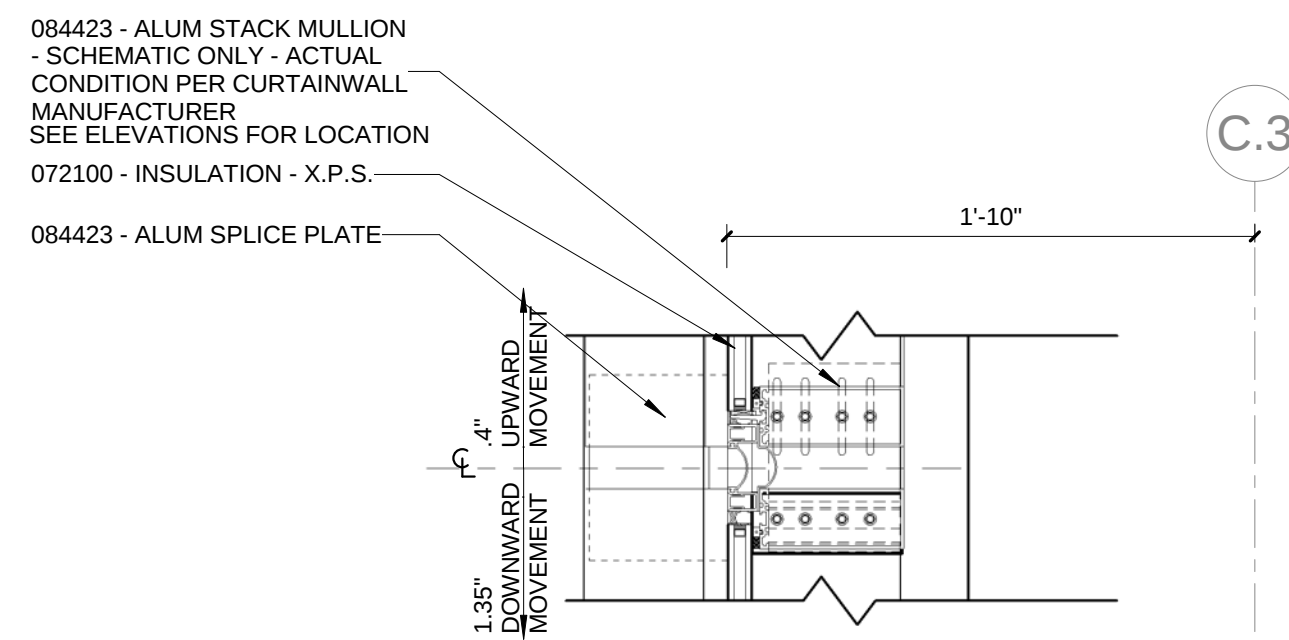

7 ENLARGED DETAIL - CURTAINWALL MOVEMENT JOINT
1 1/2" = 1'-0"

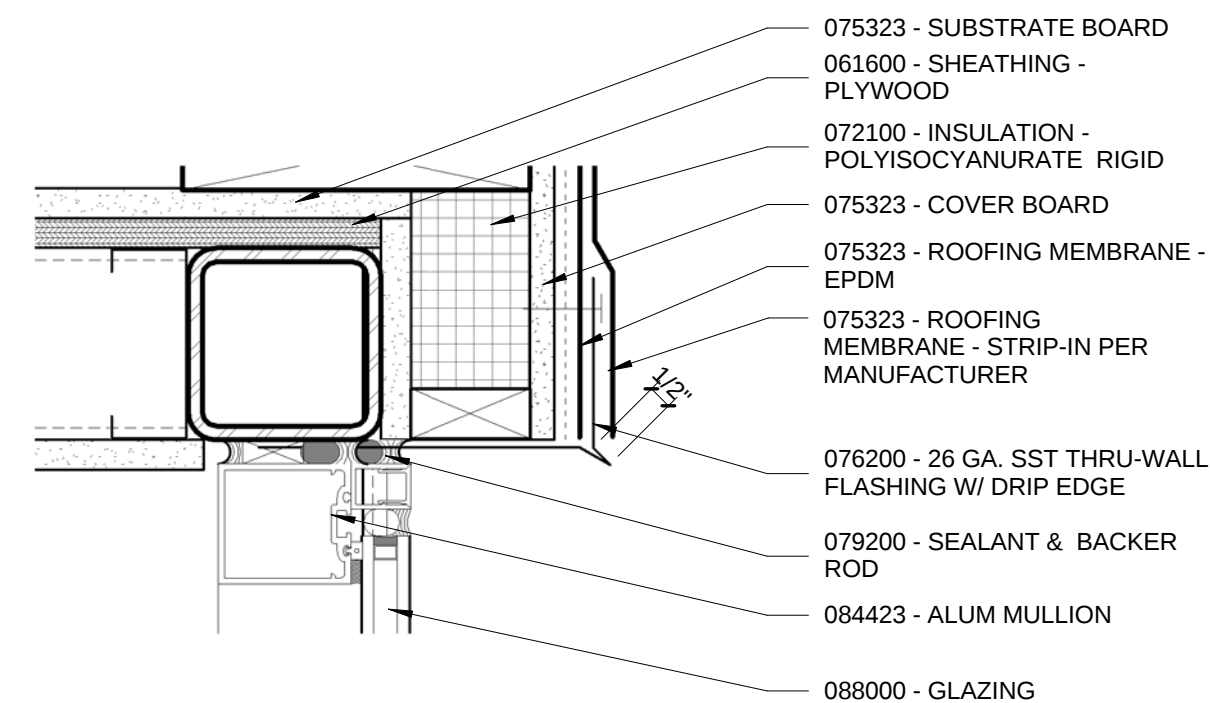

5 ENLARGED DETAIL - MONITOR ROOF HEAD DETAIL
3" = 1'-0"

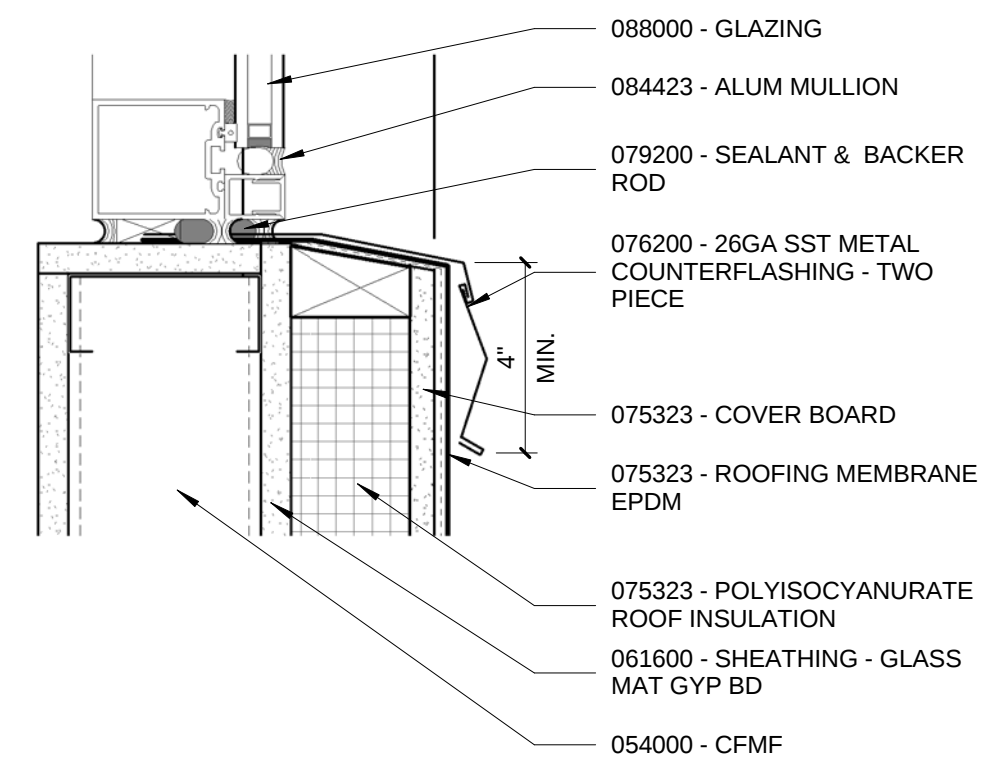

4 ENLARGED DETAIL - MONITOR ROOF SILL DETAIL
3" = 1'-0"

1100 Clark Avenue
St. Louis, Missouri 63102
T: 314.241.6250
F: 314.241.2570

William Tao & Associates, Inc.
ME/PE/PP Engineer
7955 Manchester Road, Suite 125
St. Louis, MO 63143
314-884-7600

David Mason & Associates, Inc.
Structural & Civil Engineer
800 South Vandeventer Avenue
St. Louis, MO 63110
314.534.1053

Faith Group Technology
3101 S. Hanley Rd, Suite 100
St. Louis, MO 63143
314.991.2229


Kuhnmann Leavitt, Inc.
Environmental Graphics & Signage
7400 Pershing Ave
St. Louis, MO 63130
314.725.6616

KWA Architects
Architecture
9721 Litzinger Road
St. Louis, MO 63124
314.962.2560

Spellman Brady & Company
Interior Designer
8251 Maryland Avenue, Suite 300
St. Louis, MO 63105
314.862.0070

SWT Design
Landscape Architect
7722 Big Bend Blvd
St. Louis, MO 63119
314.644.5700

Webb Engineering Services, Inc.
Planning & Fire Protection
1400 S. 3rd Street, Suite 201
St. Louis, MO 63104
314.588.0600

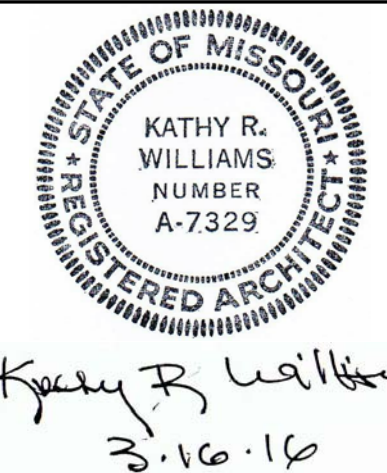

CONFORMED SET 01 JUL 2016

1	ADDENDUM 1-7	16 MAR 2016
1	ISSUED FOR CONSTRUCTION (BP1)	15 JAN 2016
No.	Description	Date

Drawing Title:

EXTERIOR SECTION DETAILS

Project No.: 04561.01 Checked by:

A0458