

KEYED NOTE LEGEND - REFLECTED CEILING PLAN


- C.1 122413 TYPE 1 SHADES: MOTORIZED ROLLER SHADES IN CONTINUOUS RECESSED POCKET (OFCI)
- C.2 122413 TYPE 2 SHADES: MOTORIZED DOUBLE ROLLER SHADES: SURFACE MOUNTED W/ CUSTOM COLOR FASCIA
- C.3 122413 TYPE 3 SHADES: MANUAL SHADES IN RECESSED POCKET
- C.4 122413 TYPE 4 SHADES: MULLION MOUNTED SHADE IN CONTINUOUS POCKET
- C.5 CEILING MOUNTING SUSPENSION FOR LCD SCREEN- PROVIDE STEEL SUPPORT ABOVE CEILING
- C.6 EXHAUST HOOD LOCATION - REFER TO FOOD SERVICE DRAWINGS
- C.7 FUME HOOD LOCATION - HOOD ENCLOSURE EXTENDS 6" ABOVE CEILING
- C.8 EXPOSED STRUCTURE
- C.9 083333 SIDE COILING DOOR TRACK
- C.10 ACOUSTICAL PANEL CEILING ABOVE WOOD GRILLE CEILING. 1" THICK
- C.11 ACOUSTICAL ISOLATION CEILING: 2 LAYERS 1/2" GYP BOARD CEILING ON SUSPENDED METAL FRAMING SUSPENSION SYSTEM TO BE ACOUSTICALLY ISOLATED FROM STRUCTURE BY SPRING/NEOPRENE ISOLATION HANGER - KINETIC NOISE CONTROL MODEL MUTA HANGERS PROVIDE CONTINUOUS LAYERS OF 3/5" FIBERGLASS ACOUSTIC BATTES. REFER TO DETAIL 16 SHEET A0842
- C.12 6" PANEL WHERE SHOWN @ 10'-6" O.C. MATCH CEILING TYPE
- C.13 RECESSED DRAPEY TRACK AND CURTAINS
- C.15 122413 TYPE 5 MOTORIZED DOUBLE ROLLER SHADE IN RECESSED POCKET.
- C.16 WOOD CEILING AT BOTTOM OF STAIRS - REFER TO STAIR 1 DRAWINGS AND DETAILS SHEET A0842
- C.17 CONTINUOUS COVE TYPE LIGHTING FIXTURE TAPED INTO GYP BOARD CEILING. REFER TO ELECTRICAL LIGHTING DRAWINGS AND TO DETAIL AT WALL SHEET A0842
- C.18 CEILING IN COLD ROOM BY COLD ROOM MFG
- C.19 G57500 MET ALUM. BEAM ENCLOSURE
- C.20 UNISTRUT MOUNTED TO CEILING W/ STEEL ANGLE HANGERS AND KICKERS ABOVE FOR SUPPORT
- C.21 STAINLESS STEEL STEAM CAPTURE HOOD ABOVE AUTOCLAVE
- C.22 REFER TO DETAIL 6/A0452
- C.23 122413 TYPE 6 SHADES: MANUAL SHADES IN RECESSED POCKET AT INTERIOR GLAZING: POCKET CONTINUOUS ACROSS OPENING
- C.24 INSULATED SOFFIT - SIMILAR TO WA-14 ON SHEET A0406
- C.25 CEILING MOUNTED SURGICAL LIGHT - SEE EQUIPMENT LIST (OFCI) - PROVIDE STRUCTURAL STEEL SUPPORT TO DECK - 4 - 2X2X 1/4" STEEL ANGLE HANGER WITH 4 - ANGLE KICKERS 2 X 2 X 1/4" AND MOUNTING PLATE PER MANUFACTURER. SEE DETAIL 01/A0814.
- C.26 CONTROL JOINT LOCATION
- C.27 ABOVE CEILING WHERE INDICATED WITH DASHED LINE: PROVIDE 2 HOUR RATED HORIZONTAL GYP BOARD ENCLOSURE AROUND DUCTS SERVING FLOOR GRILLES ON LEVEL ABOVE. REFER TO DETAIL SHEET A1002
- C.28 ABOVE CEILING WHERE INDICATED WITH DASHED LINE: PROVIDE 2 HOUR RATED HORIZONTAL GYP BOARD ENCLOSURE AROUND STANDPIPE RUN. REFER TO DETAIL SHEET A1002
- C.29 PROVIDE 2 HOUR RATED HORIZONTAL GYP BOARD ENCLOSURE AT BOTTOM OF SHAFT. REFER TO DETAIL SHEET A1002
- C.30 122413 TYPE 7 SHADES: MOTORIZED DOUBLE ROLLER SHADES: SURFACE MOUNTED W/ CUSTOM COLOR FASCIA
- C.31 122413 TYPE 8 MOTORIZED DOUBLE ROLLER SHADE IN RECESSED POCKET.
- C.32 SPECIAL ACOUSTICAL SEPARATION CEILING: APPLY KINETICS NOISE CONTROL QUIET TILE CAC-51 TO TOP SIDE OF ACOUSTICAL PANELS; ISOLATE CEILING TILE FROM STRUCTURE ABOVE WITH KNC AF HANGERS. - LEAVE 3/4" GAP ALL SIDES
- C.33 REVEAL TRIM AROUND DIAGONAL BRACE PENETRATION THROUGH CEILING
- C.34 LABORATORY OVERHEAD SERVICE CARRIER - REFER TO ENLARGED FLOOR PLANS
- C.35 EMERGENCY SAFETY SHOWER - PIPING TO HEAD ABOVE CEILING
- C.36 122413 TYPE 3 SHADES: MANUAL SHADES - STEPPED WITH SLOPE IN CONT. SLOPED OPENING

CEILING LEGEND

- APC-1 2' x 2' - ARMSTRONG OPTIMA TEGULAR 1" THICK, NRC - 90, IN 9/16" GRID
- APC-2 2' x 2' - ARMSTRONG ULTIMA TEGULAR 1" THICK, NRC - 90, IN 9/16" GRID
- APC-3A 2' x 2' - ARMSTRONG ULTIMA HEALTH ZONE IN 9/16" GRID
- APC-3B 2' x 2' - ARMSTRONG ULTIMA HEALTH ZONE TEGULAR 9/16" GRID
- APC-4 NOT USED
- APC-5 2' x 2' - ARMSTRONG FINE FISSURED IN 15/16" GRID
- APC-6 088310 ACOUSTICAL PLASTER: BASWAPHON (40 MM) OVER 1 1/2" INSULATION OVER GYP. BOARD
- APC-7 2' x 4' - ARMSTRONG ULTIMA TEGULAR IN 9/16" SILHOUETTE XL GRID W/ 6" PANEL INSERTS AS SHOWN
- APC-8 2' x 6' ARMSTRONG OPTIMA TEGULAR - 1" THICK, NRC - 90, IN 9/16" SILHOUETTE XL 1/8" GRID MATCH APC-7 - EXCEPT, REF. 085113- SPECIAL ACOUSTIC TREATMENT: APPLY SPECIAL ACOUSTIC MATERIAL TO TOP SIDE OF PANELS AND PROVIDE ISOLATORS FOR CEILING HANGERS:

- WDC-1 09 5426 WOOD GRILLE CEILING W/ 3/4" x 2 1/4" MEMBERS - 6 PER FOOT - NINEWOOD GRILL 1400 W/ 1" THICK ARMSTRONG OPTIMA PANELS FIT TO GRID SUPPORT ABOVE
- WDC-2 06 4216 FLUSH WOOD PANEL SOFFIT - MATCH WVP-1
- WDC-3 06 4216 OPAQUE WOOD PANEL TO MATCH WOOD ACOUST WALL PANEL

- GWB-1 PAINTED GYP. BOARD
- GWB-2 GYP. BOARD W/ COATING TO MATCH ADJACENT ACOUST. PLASTER

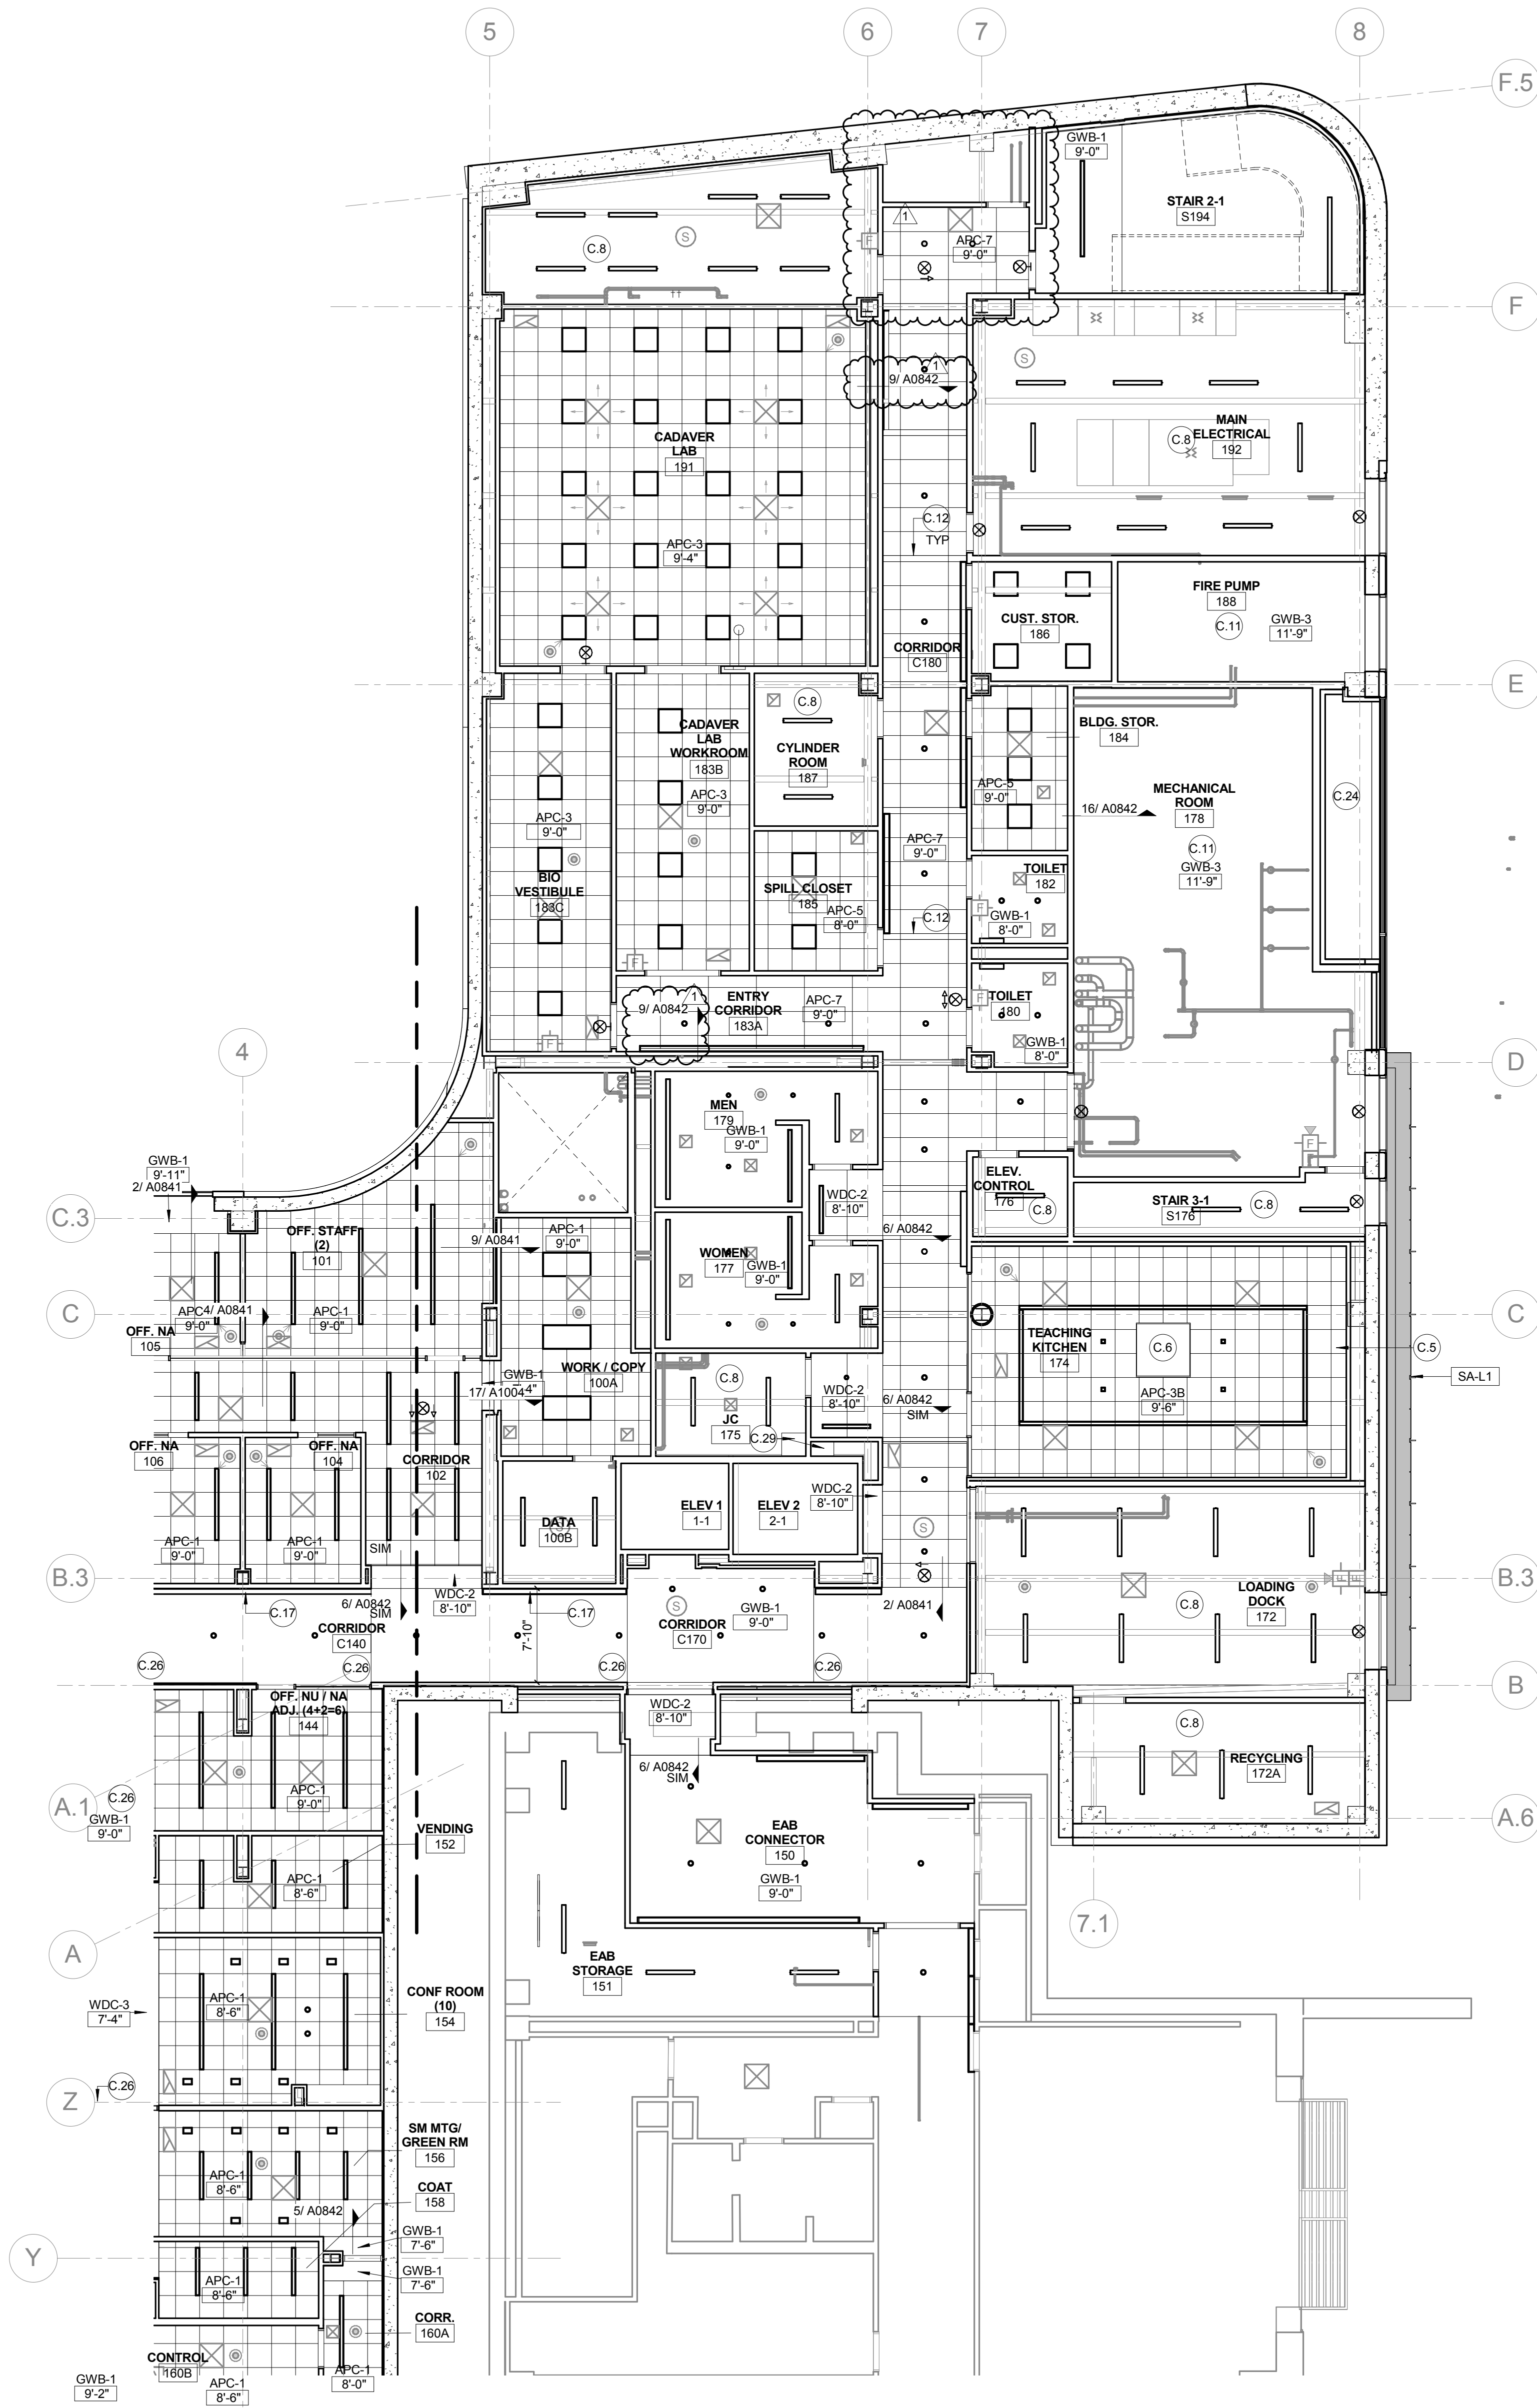


1 LEVEL 01 REFLECTED CEILING PLAN - AREA A

1/8" = 1'-0"

CONFORMED SET

01 JUL 2016

1 ADDENDUM 3-2		15 APR 2016
ISSUED FOR CONSTRUCTION (BP3)		15 MAR 2016
No.	Description	Date

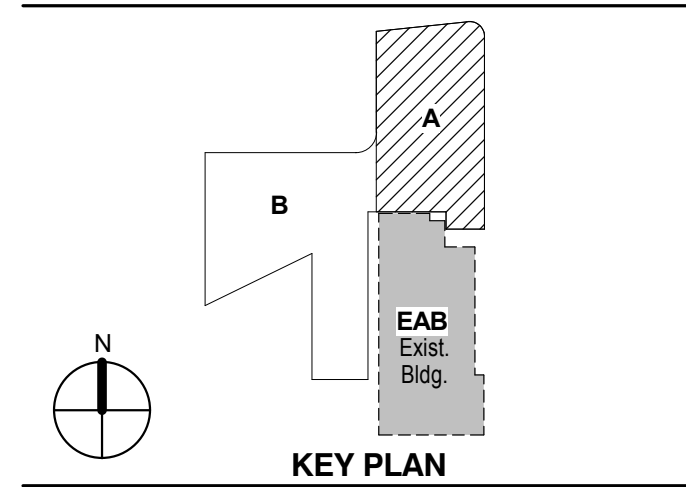

KEY PLAN

LEVEL 01 REFLECTED CEILING PLAN AREA A

Project No.: 04561.01

Checked by:

A0701.A