

LEGEND (THIS SHEET ONLY)



- ////// UTILITY TO BE REMOVED
- XXXXXXXX WALL TO BE REMOVED
- PMVT TO BE REMOVED
- TREE TO BE REMOVED

KEYED DEMOLITION NOTES

- SEE LANDSCAPE DRAWINGS FOR LIMITS OF EXISTING IRRIGATION SYSTEM REMOVAL.
- DISCONNECT EXISTING DOWNSPOUT LATERAL FROM COLLECTOR LINE AND REMOVE COLLECTOR LINE.
- SEE LANDSCAPE TREE PROTECTION PLAN FOR ADDITIONAL TREES TO BE REMOVED AND LIMITS OF TREE PROTECTION ZONE FOR TREES THAT ARE TO REMAIN.
- TO BE REMOVED AND REPLACED AT MSD INSPECTORS DISCRETION.

SHEET GENERAL NOTES

- ANY ABANDONED SEWERS SHALL BE REMOVED OR COMPLETELY GROUT FILLED.
- MSD PERMITS ARE REQUIRED PRIOR TO THE ABANDONMENT OR REMOVAL OF EXISTING SEWERS. TO RECEIVE MSD PERMITS THE PROJECT MUST HAVE MSD PLAN APPROVAL NOTIFY MSD 48 HOURS PRIOR TO SEWER ABANDONMENT AND/OR REMOVAL.

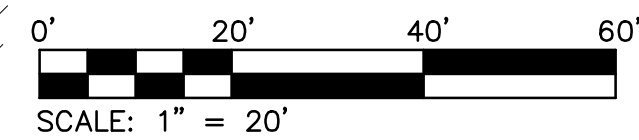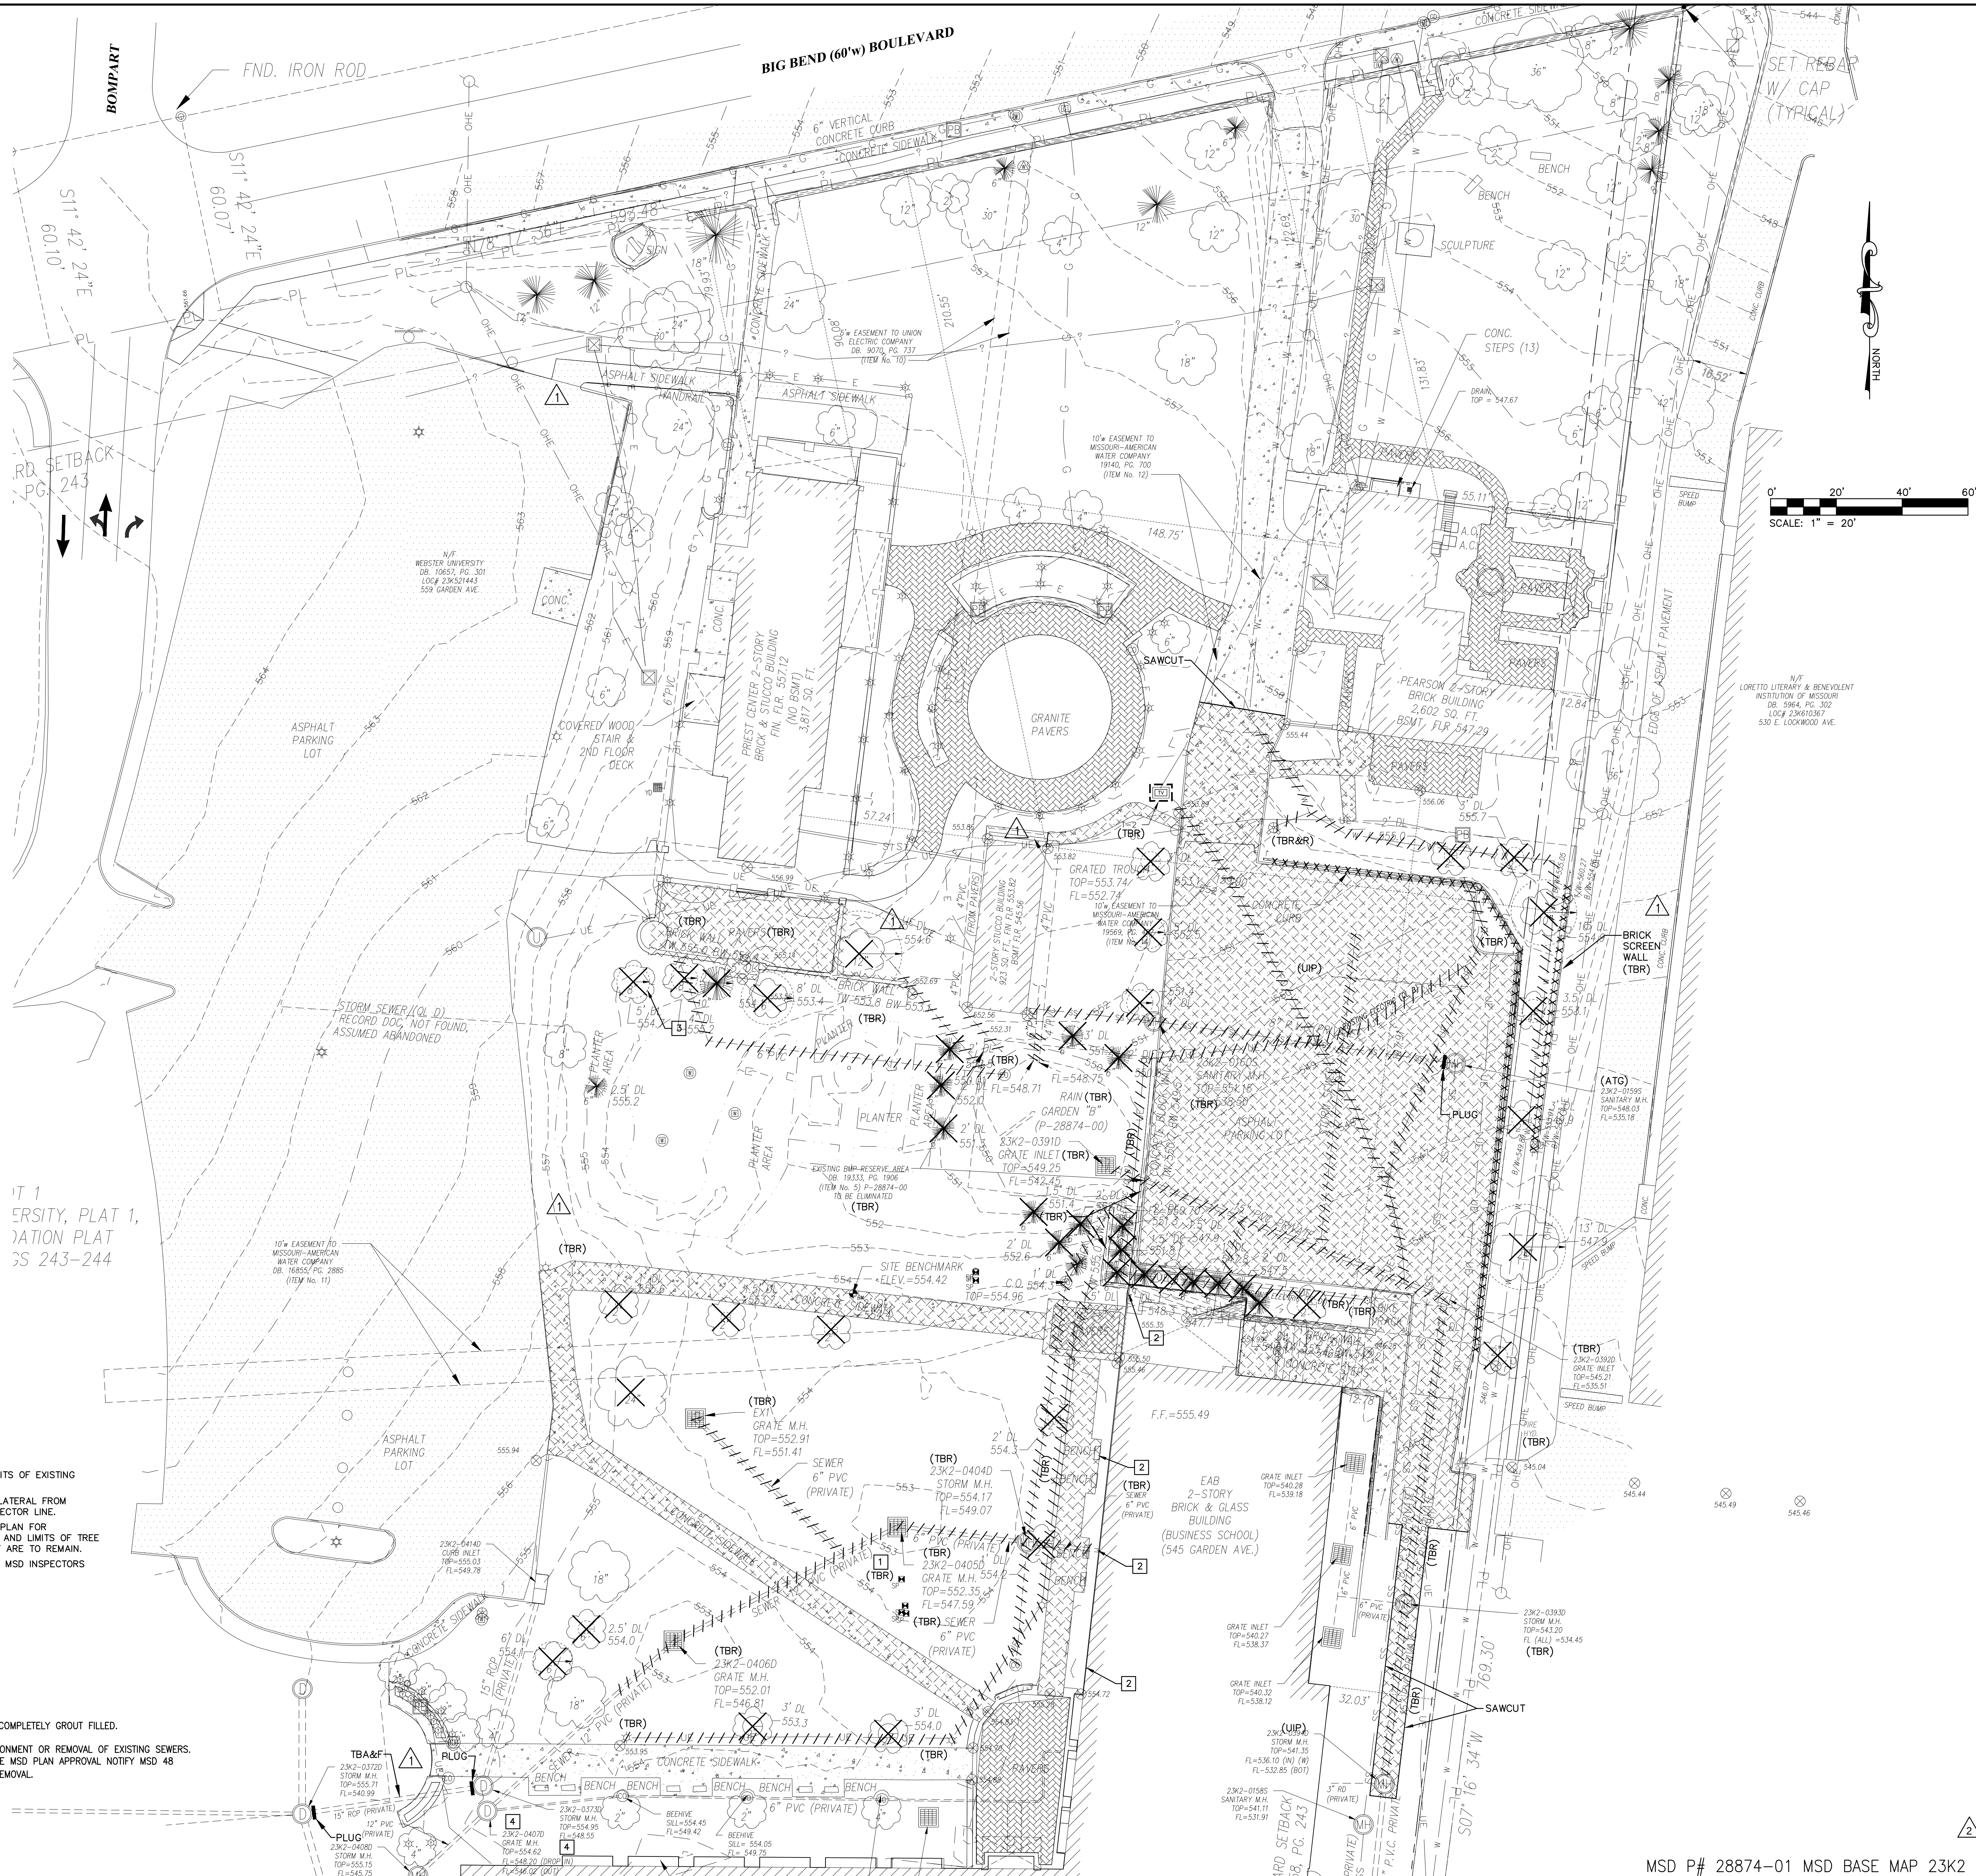

1100 Clark Avenue
St. Louis, Missouri 63102
T: 314.241.6250
F: 314.241.2570

William Tao & Associates, Inc.
ME/PE/PP Engineer
7955 Manchester Road, Suite 125
St. Louis, MO 63143
314.884.7600

David Mason & Associates, Inc.
Structural & Civil Engineer
MO Civil Cert of Authority # 003103
800 South Vandeventer Avenue
St. Louis, MO 63110
314.534.1053

Faith Group
Technology
3101 S. Hanley Rd, Suite 100
St. Louis, MO 63143
314.991.2228

Kuhlmann Leavitt, Inc.
Environmental Graphics & Signage
7400 Pershing Ave
St. Louis, MO 63130
314.725.6616

KWA Architects
Architecture
9721 Lezinger Road
St. Louis, MO 63124
314.962.2560

Spelman Brady & Company
Interior Designer
8251 Maryland Avenue, Suite 300
St. Louis, MO 63105
314.862.0070


SWT Design
Landscape Architect
7722 Big Bend Blvd
St. Louis, MO 63119
314.544.5700

Webb Engineering Services, Inc.
Planting & Fire Protection
1400 S. 3rd Street, Suite 201
St. Louis, MO 63104
314.588.0600



CONFORMED SET 01 JUL 2016

2	ADDENDUM 1-10	5 MAY 2016
1	ADDENDUM 1-1	29 JAN 2016
ISSUED FOR CONSTRUCTION (BPI)		15 JAN 2016
No.	Description	Date

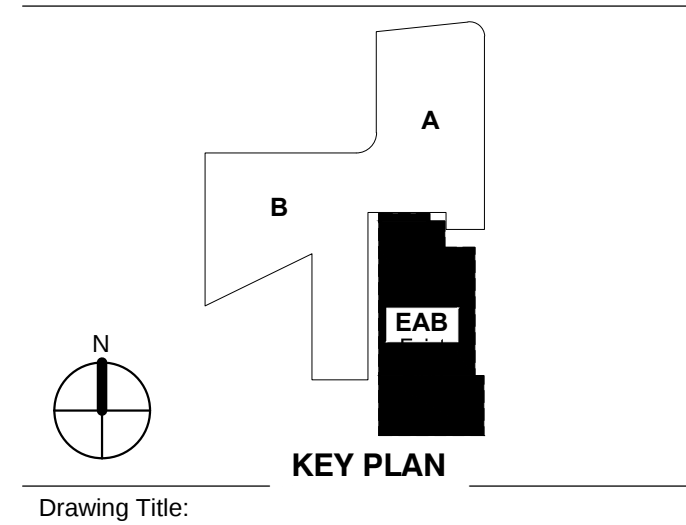

DEMOLITION PLAN

Project No.: 04561.00 Checked by:

C300