


© Cannon Design 2015
All rights reserved. No part of this document may be reproduced or transmitted in any form without written authorization by The Cannon Corporation.
3/17/2016 9:25:24 AM

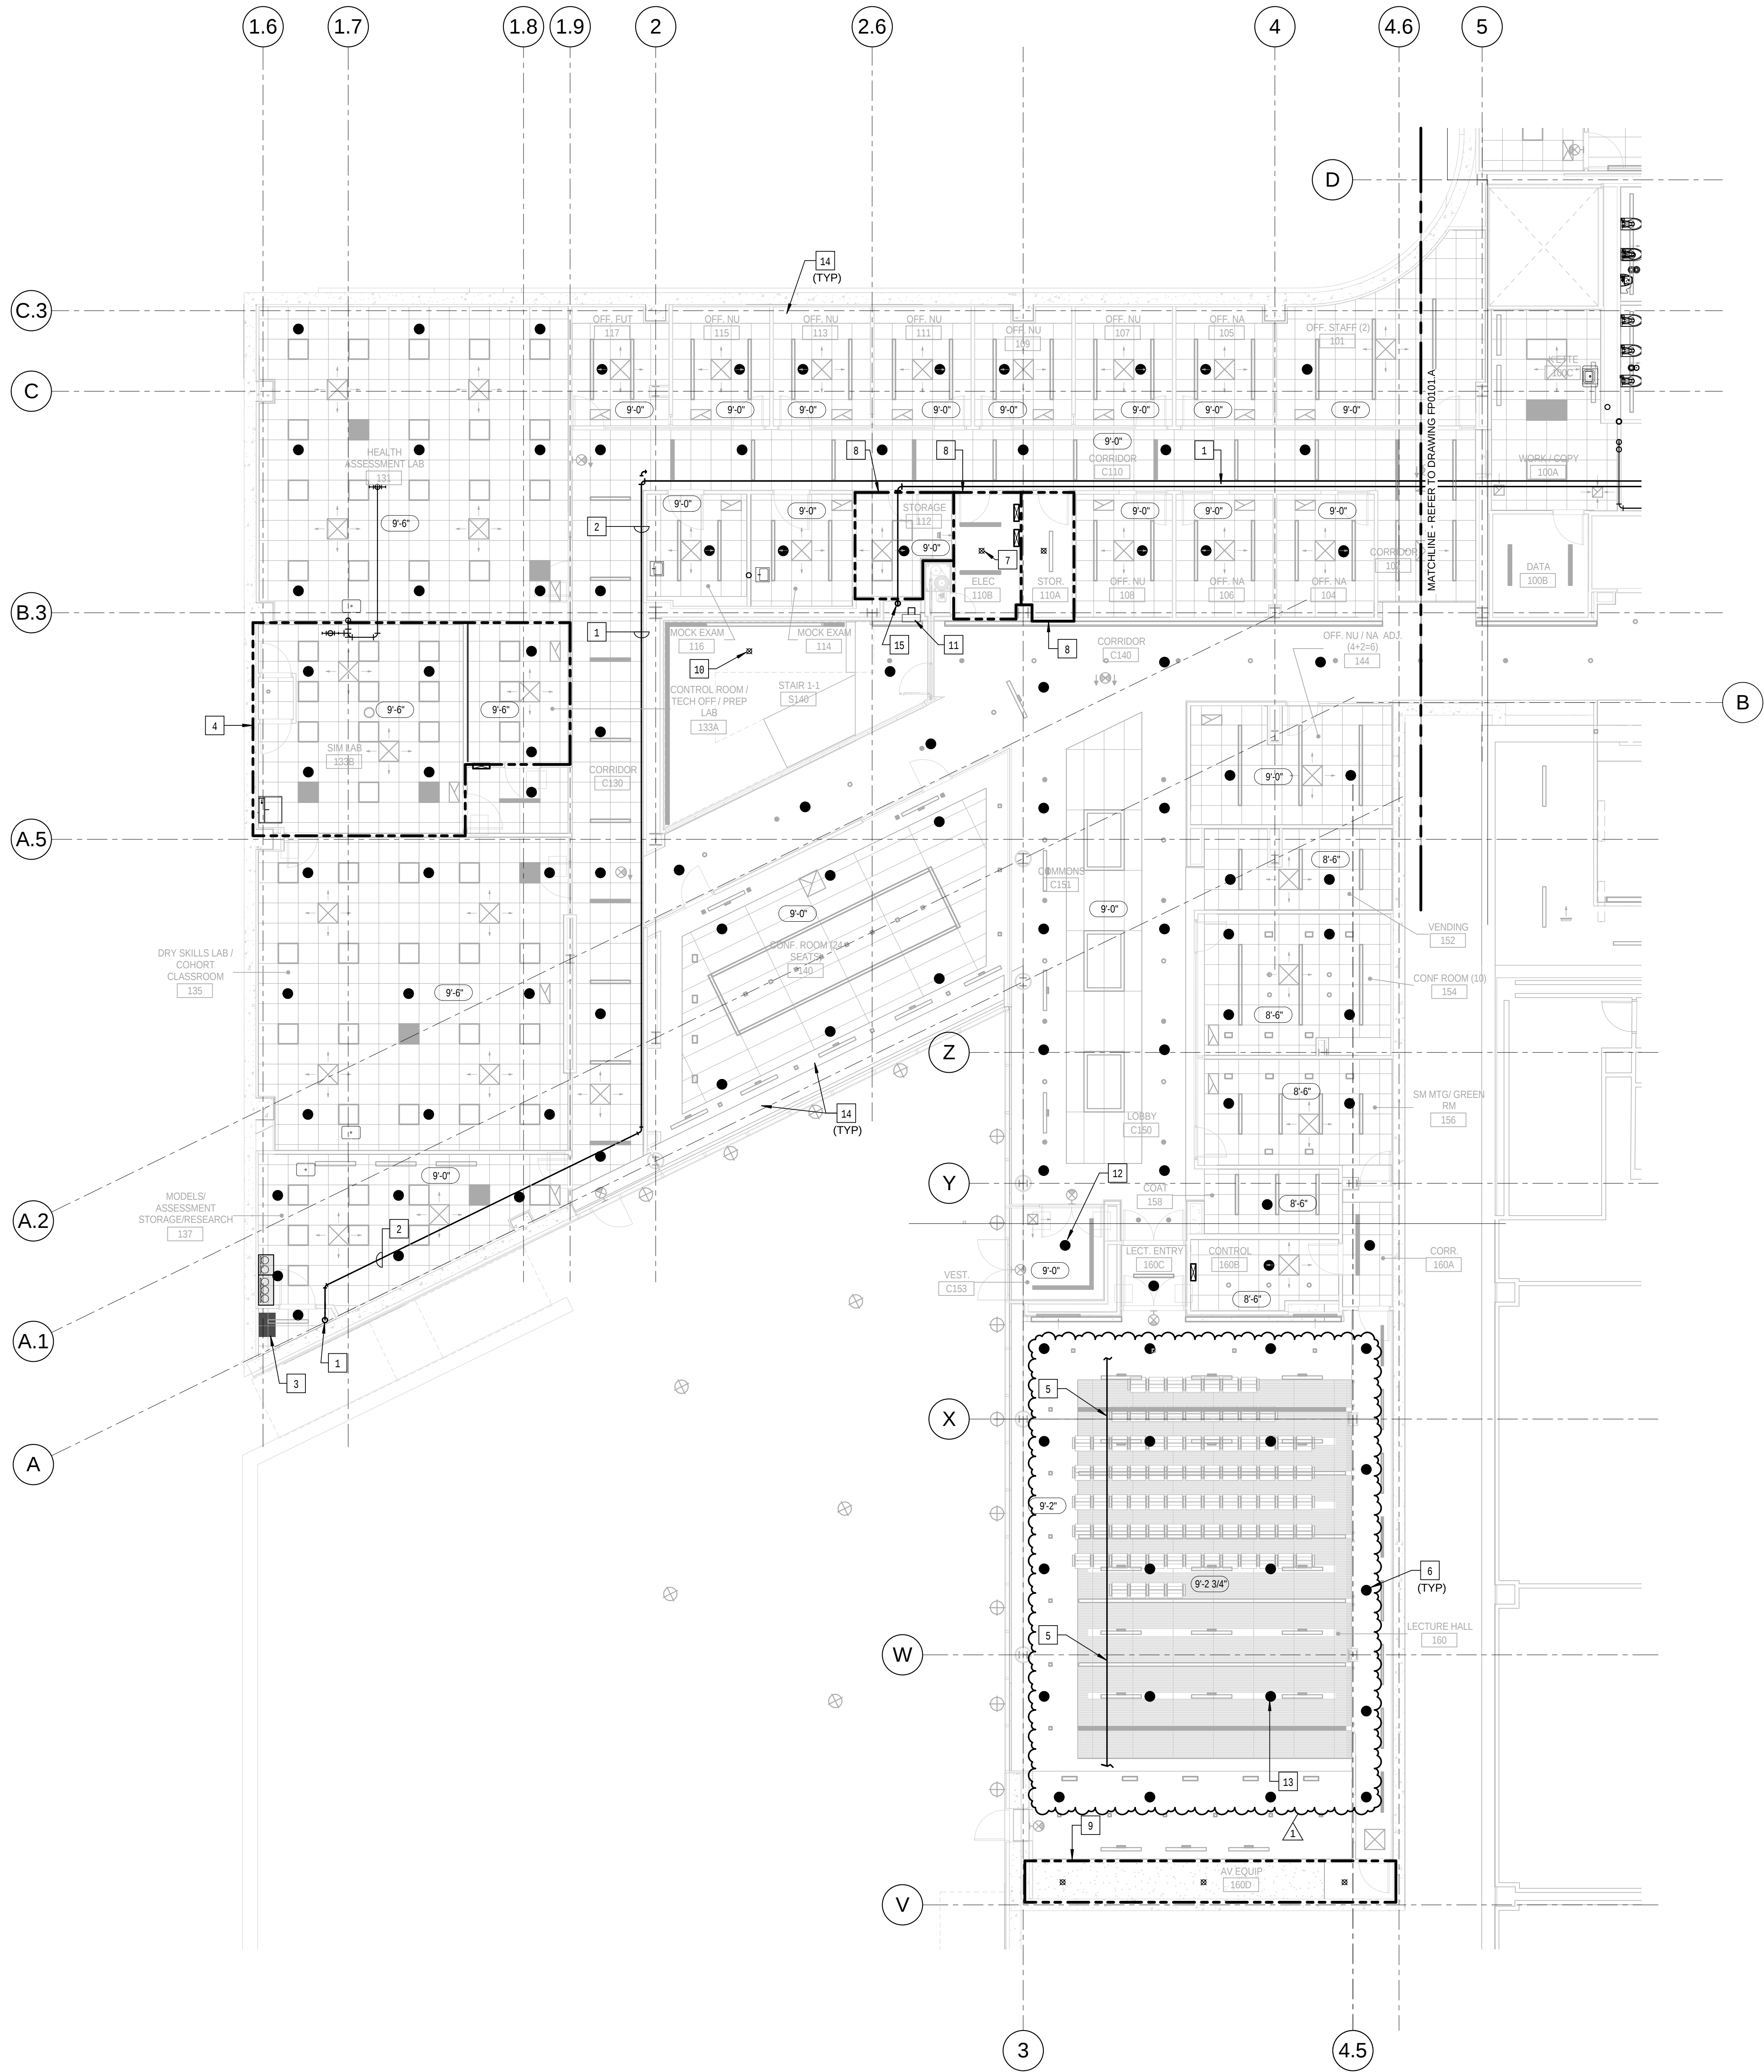

KEYED NOTES: (THIS SHEET ONLY)

- 1 FIRE DEPARTMENT CONNECTION PIPING UP FROM BELOW THE FLOOR SLAB. PROVIDE MECHANICAL LINK SEAL AND FLOOR FLANGE. IDENTIFY PIPE IN ACCORDANCE WITH THE SPECIFICATIONS.
- 2 FIRE SERVICE PIPE FROM FIRE DEPARTMENT CONNECTION. ROUTE 6" PIPE ABOVE THE CORRIDOR CEILING, AS HIGH AS POSSIBLE. COORDINATE ROUTING AND INSTALLATION WITH OTHER TRADES. PITCH PIPING TO DRAIN, PROVIDE CAPPED HOSE END DRAIN VALVES AS REQUIRED FOR LOW SPOTS IN THE RUN.
- 3 FREE STANDING PRE-ACTION, DOUBLE INTERLOCK SELF-CONTAINED INTEGRATED FIRE PROTECTION PACKAGE. PRE-ACTION SYSTEM TO PROVIDE PROTECTION FOR THE SIM LAB 133B AND CONTROL ROOM 133A. REFER TO SPECIFICATION SECTION 211316 'DRY-PIPE PRE-ACTION SPRINKLER SYSTEM'. COORDINATE INSTALLATION WITH THE ELECTRICAL AND PLUMBING CONTRACTORS.
- 4 THIS SPACE IS TO BE PROTECTED BY THE PRE-ACTION, DOUBLE INTERLOCK FIRE SYSTEM. COORDINATE PLACEMENT OF THE SPRINKLER HEADS AND DETECTION DEVICES WITH CEILING MOUNTED SURGICAL LIGHT.
- 5 COORDINATE THE ROUTING OF THE SPRINKLER PIPING IN THIS SPACE WITH PRE-FABRICATED OPENINGS IN THE STRUCTURAL STEEL. ACCESSIBLE SPACE ABOVE THE CEILING IS LIMITED. COORDINATE ALL PIPING AND SPRINKLER HEAD LOCATIONS WITH THE STRUCTURAL ELEMENTS, LIGHTING AND DUCTWORK. REFER TO THE ARCHITECTURAL PLANS FOR CEILING MATERIALS AND CONSTRUCTION. PIPING SHOWN MAY NOT REFLECT THE ACTUAL OPENING LOCATIONS, AND IS FOR REFERENCE ONLY.
- 6 COORDINATE SPRINKLER HEAD LOCATIONS AND PIPE ROUTING ABOVE AISLE SPACE WITH DUCTWORK, ROOF DRAIN PIPING AND LIGHTING.
- 7 COORDINATE LOCATION OF SPRINKLER HEAD IN THIS ROOM WITH THE ELECTRICAL EQUIPMENT AND OVERHEAD RACEWAYS. HOLD PIPING AS HIGH AS POSSIBLE. PROVIDE INTERMEDIATE TEMPERATURE RATED SPRINKLER HEAD.
- 8 THIS SPACE IS DESIGNATED AS ORDINARY HAZARD, GROUP 1.
- 9 THIS SPACE IS DESIGNATED AS ORDINARY HAZARD, GROUP 2.
- 10 PROVIDE SPRINKLER HEAD WITH CAGE GUARD BELOW STAIRS, CONCEAL SPRINKLER PIPING. EXPOSED/VISIBLE PIPING IS TO BE PAINTED TO MATCH THE BACKGROUND SURFACE.
- 11 RECESSED FIRE HOSE VALVE CABINET WITH 2.5 INCH ANGLE FIRE HOSE VALVE, CAP AND CHAIN. REFER TO ARCHITECTURAL DRAWINGS.
- 12 PROVIDE CONCEALED DRY-PENDENT DRY-TYPE SPRINKLER HEAD AT THIS LOCATION.
- 13 PROVIDE CONCEALED PENDENT SPRINKLER HEADS IN GYP. BOARD PORTION OF THE CEILING. REFER TO THE ARCHITECTURAL DRAWINGS FOR CEILING DETAILS. COORDINATE PLACEMENT WITH THE INSTALLATION OF THE AIR DEVICES AND CEILING MOUNTED WIRING AND/OR DEVICES. PIPING ABOVE THE CEILING THAT IS EXPOSED/VISIBLE IS TO BE PAINTED TO MATCH THE BACKGROUND SURFACE. COVER PLATE FINISH OF THE SPRINKLER HEAD IS TO BE SELECTED AND APPROVED BY THE ARCHITECT. OBTAIN SAMPLES FROM THE SPRINKLER MANUFACTURER OF THE TRUE COVERPLATE FINISHES AS DIRECTED BY THE ARCHITECT PRIOR TO ORDERING.
- 14 CONTRACTOR TO REVIEW ARCHITECTURAL DRAWING FOR RECESSED OR ELEVATED CEILING POCKETS. PROVIDE PROTECTION AS REQUIRED.
- 15 STANDPIPE SUPPLY PIPING UP TO SERVE FIRE HOSE VALVE CABINET ON EACH LEVEL. ROUTE DRAIN PIPING TO MOP BASIN IN JANITOR'S CLOSET #175.



Webster University
Interdisciplinary Science
Building

CANNONDESIGN

1100 Clark Avenue
St. Louis, Missouri 63102
T: 314.241.6250
F: 314.241.2570

William Tao & Associates, Inc.
MEP/FP Engineer
7955 Manchester Road, Suite 125
St. Louis, MO 63143
314.884.7600

David Mason & Associates, Inc.
Structural & Civil Engineer
800 South Vandeventer Avenue
St. Louis, MO 63110
314.534.1053

Faith Group
Technology
3101 S. Hanley Rd. Suite 100
St. Louis, MO 63143
314.991.2229

Kuhnman Leavitt, Inc.
Environmental Graphics & Signage
7400 Pershing Ave.
St. Louis, MO 63130
314.725.6616

KWA Architects
Architecture
9721 Litzinger Road
St. Louis, MO 63124
314.962.2500


Spellman Brady & Company
Interior Designer
8251 Maryland Avenue, Suite 300
St. Louis, MO 63105
314.862.0070

SWT Design
Landscape Architect
7722 Big Bend Blvd
St. Louis, MO 63119
314.644.5700

Webb Engineering Services, Inc.
Planning & Fire Protection
1400 S. 3rd Street, Suite 201
St. Louis, MO 63104
314.588.0600

CONFORMED SET 01 JUL 2016

1	ADDENDUM 2-1	17 MAR 2016
1	ISSUED FOR CONSTRUCTION (BP2)	01 MAR 2016
No.	Description	Date

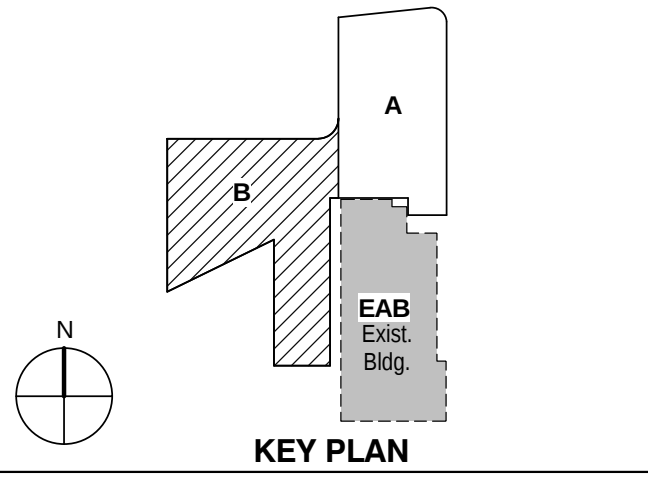

KEY PLAN

**LEVEL 01 AREA B FLOOR
PLAN - FIRE PROTECTION**

Project No.: 04561.01 Checked by:

FP0101.B

© Cannon Design 2015