



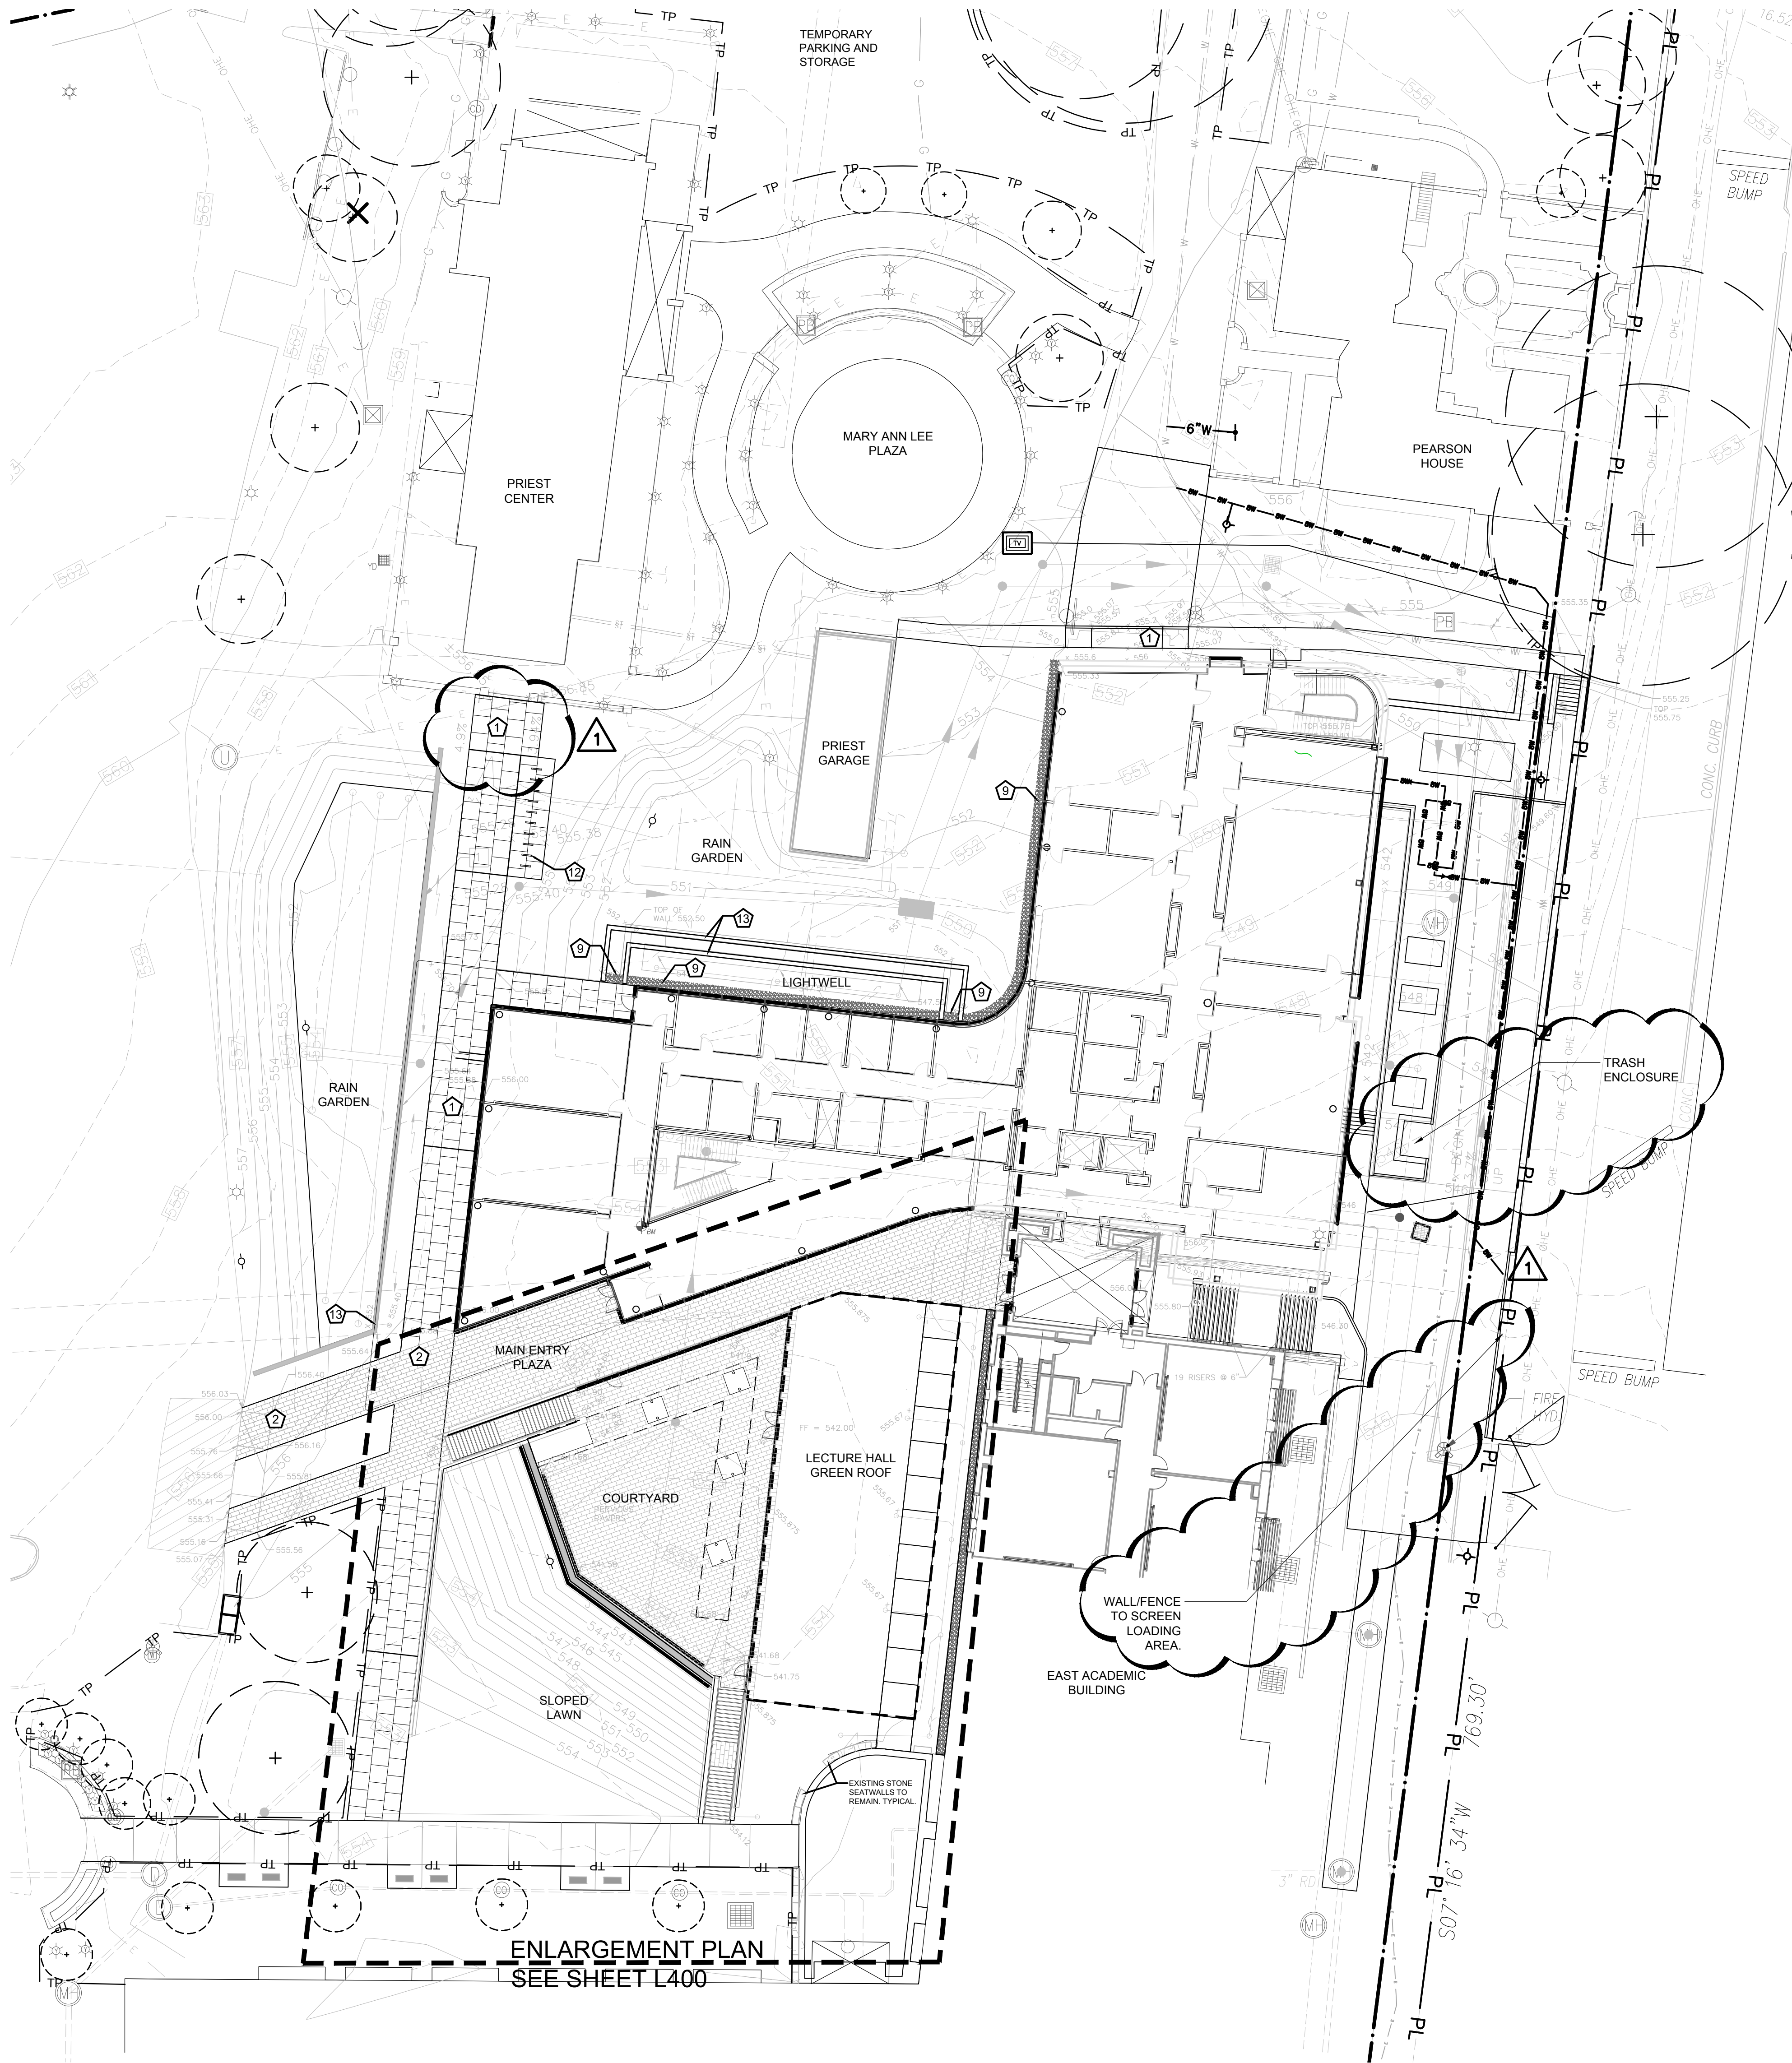

A MATERIALS PLAN
SCALE: 1" = 20'

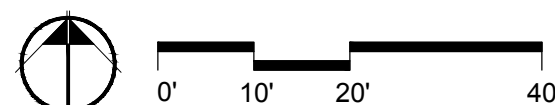

LEGEND

- EJ EXPANSION JOINTS
CJ CONTROL JOINT
- 1 STANDARD CONCRETE PAVING**
5" THICK CONCRETE PAVING, LIGHT BROOM FINISH.
EDGES TO BE 1/4" TOOLED RADIUS, SAW CUT JOINTS.
SEE CIVIL DRAWINGS FOR LAYOUT. CONTRACTOR
TO COORDINATE LOCATION OF ALL JOINTS WITH
LANDSCAPE ARCHITECT.
- 2 CONCRETE PAVERS**
WAUSAU TILE
12" X 24", COLOR TO BE: XP-40
SAND SETTING BED ON CONCRETE BASE
SEE DETAIL A/L501
- 3 CONCRETE PAVERS**
WAUSAU TILE
12" X 24", COLOR TO BE: XP-40
PEDESTAL SYSTEM
SEE DETAILS F,G/ L501
- 4 TREE PIT**
CLEAN 3/4" TRAP ROCK MULCH AT TREE PITS.
INCLUDES (2) LED UPLIGHTS PER TREE:
HYDREL MODEL, M9440-SS-12LED-WHT53K-MVOL-1VWFL-FLC20-34S-IHL-LP
SEE DETAILS C,D /L500
- 5 PERMEABLE CONCRETE PAVER**
HANOVER ARCHITECTURAL PRODUCTS
12" x 18", COLOR TO BE DETERMINED
SEE DETAIL SHEETS C, D/ L500 & CIVIL DRAWING DETAIL 5/C700
- 6 CONCRETE SEATWALL**
WITH IPE WOOD TOP.
SEE DETAIL D/L501
- 7 STAIRS**
SEE ARCHITECTURAL DRAWINGS
- 8 GREENROOF EDGE RESTRAINT**
HEIGHT OF EDGE VARIES. SEE ARCHITECTURAL
DRAWINGS
- 9 DECORATIVE GRAVEL MAINTENANCE STRIP**
BLACK MOUNTAIN TRAP ROCK
SEE DETAIL B/L500
- 10 EXISTING STONE BENCHES TO REMAIN**
PROTECT FROM DAMAGE
- 11 TRENCH DRAIN**
6" WIDE W/ PERFORATED STAINLESS STEEL
GRATE, MODEL #DS-226 BY NDS. INSTALL PER
MANUFACTURER RECOMMENDATIONS. SEE
CIVIL DRAWINGS FOR DETAILS
- 12 BIKE RACK**
LANDSCAPE FORMS
SEE DETAIL SHEET A/L500
- 13 CONCRETE RETAINING WALL**
CAST IN PLACE CONCRETE WALL WITH FORM
LINER FINISH. FORM LINER PATTERN TO BE
DETERMINED. REFERENCE ARCHITECTURAL
WALL DETAILS



Webster University
Interdisciplinary Science
Building

CANNONDESIGN

1100 Clark Avenue
St. Louis, Missouri 63102
T: 314.241.6250
F: 314.241.2570

William Tao & Associates, Inc.
ME/PFP Engineer
7955 Manchester Road, Suite 125
St. Louis, MO 63143
314-884-7600


David Mason & Associates, Inc.
Structural & Civil Engineer
800 South Vandeventer Avenue
St. Louis, MO 63110
314.534.1053

SWT Design
Landscape Architect
7722 Big Bend Blvd
St. Louis, MO 63119
314.644.5700

Spellman Brady & Company
Interior Designer
8251 Maryland Avenue, Suite 300
St. Louis, MO 63105
314.862.0070

Webb Engineering Services, Inc.
Plumbing & Fire Protection
1400 S. 3rd Street, Suite 201
St. Louis, MO 63104
314.588.0600

Faith Group
Technology
930 N. McKnight Rd
St. Louis, MO 63132
314.991.2228

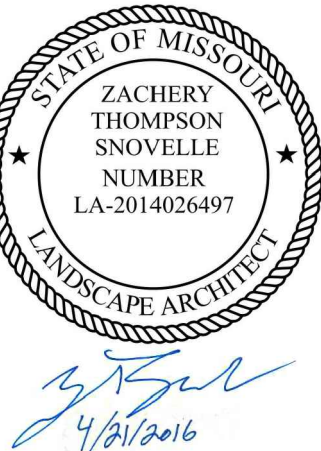

CONFORMED SET 01 JUL 2016

1 ADDENDUM 3-3 21 APR 2016
- ISSUED FOR CONSTRUCTION (BPS) 15 MAR 2016

No.	Description	Date
-----	-------------	------

Drawing Title:

MATERIALS PLAN

SWT Project No.: 20018.01 Checked by:

L101

MSD P# 28874-01 MSD BASE MAP 23K2