



THE SEAL(S) AND SIGNATURE(S) APPLY ONLY TO THE DOCUMENT TO WHICH THEY ARE AFFIXED, AND EXPRESSLY DISCLAIM ANY RESPONSIBILITY FOR ALL OTHER PLANS, SPECIFICATIONS, ESTIMATES, REPORTS OR OTHER DOCUMENTS OR INSTRUMENTS RELATING TO OR INTENDED TO BE USED FOR ANY PART OR PARTS OF THE ARCHITECTURAL OR ENGINEERING PROJECT.

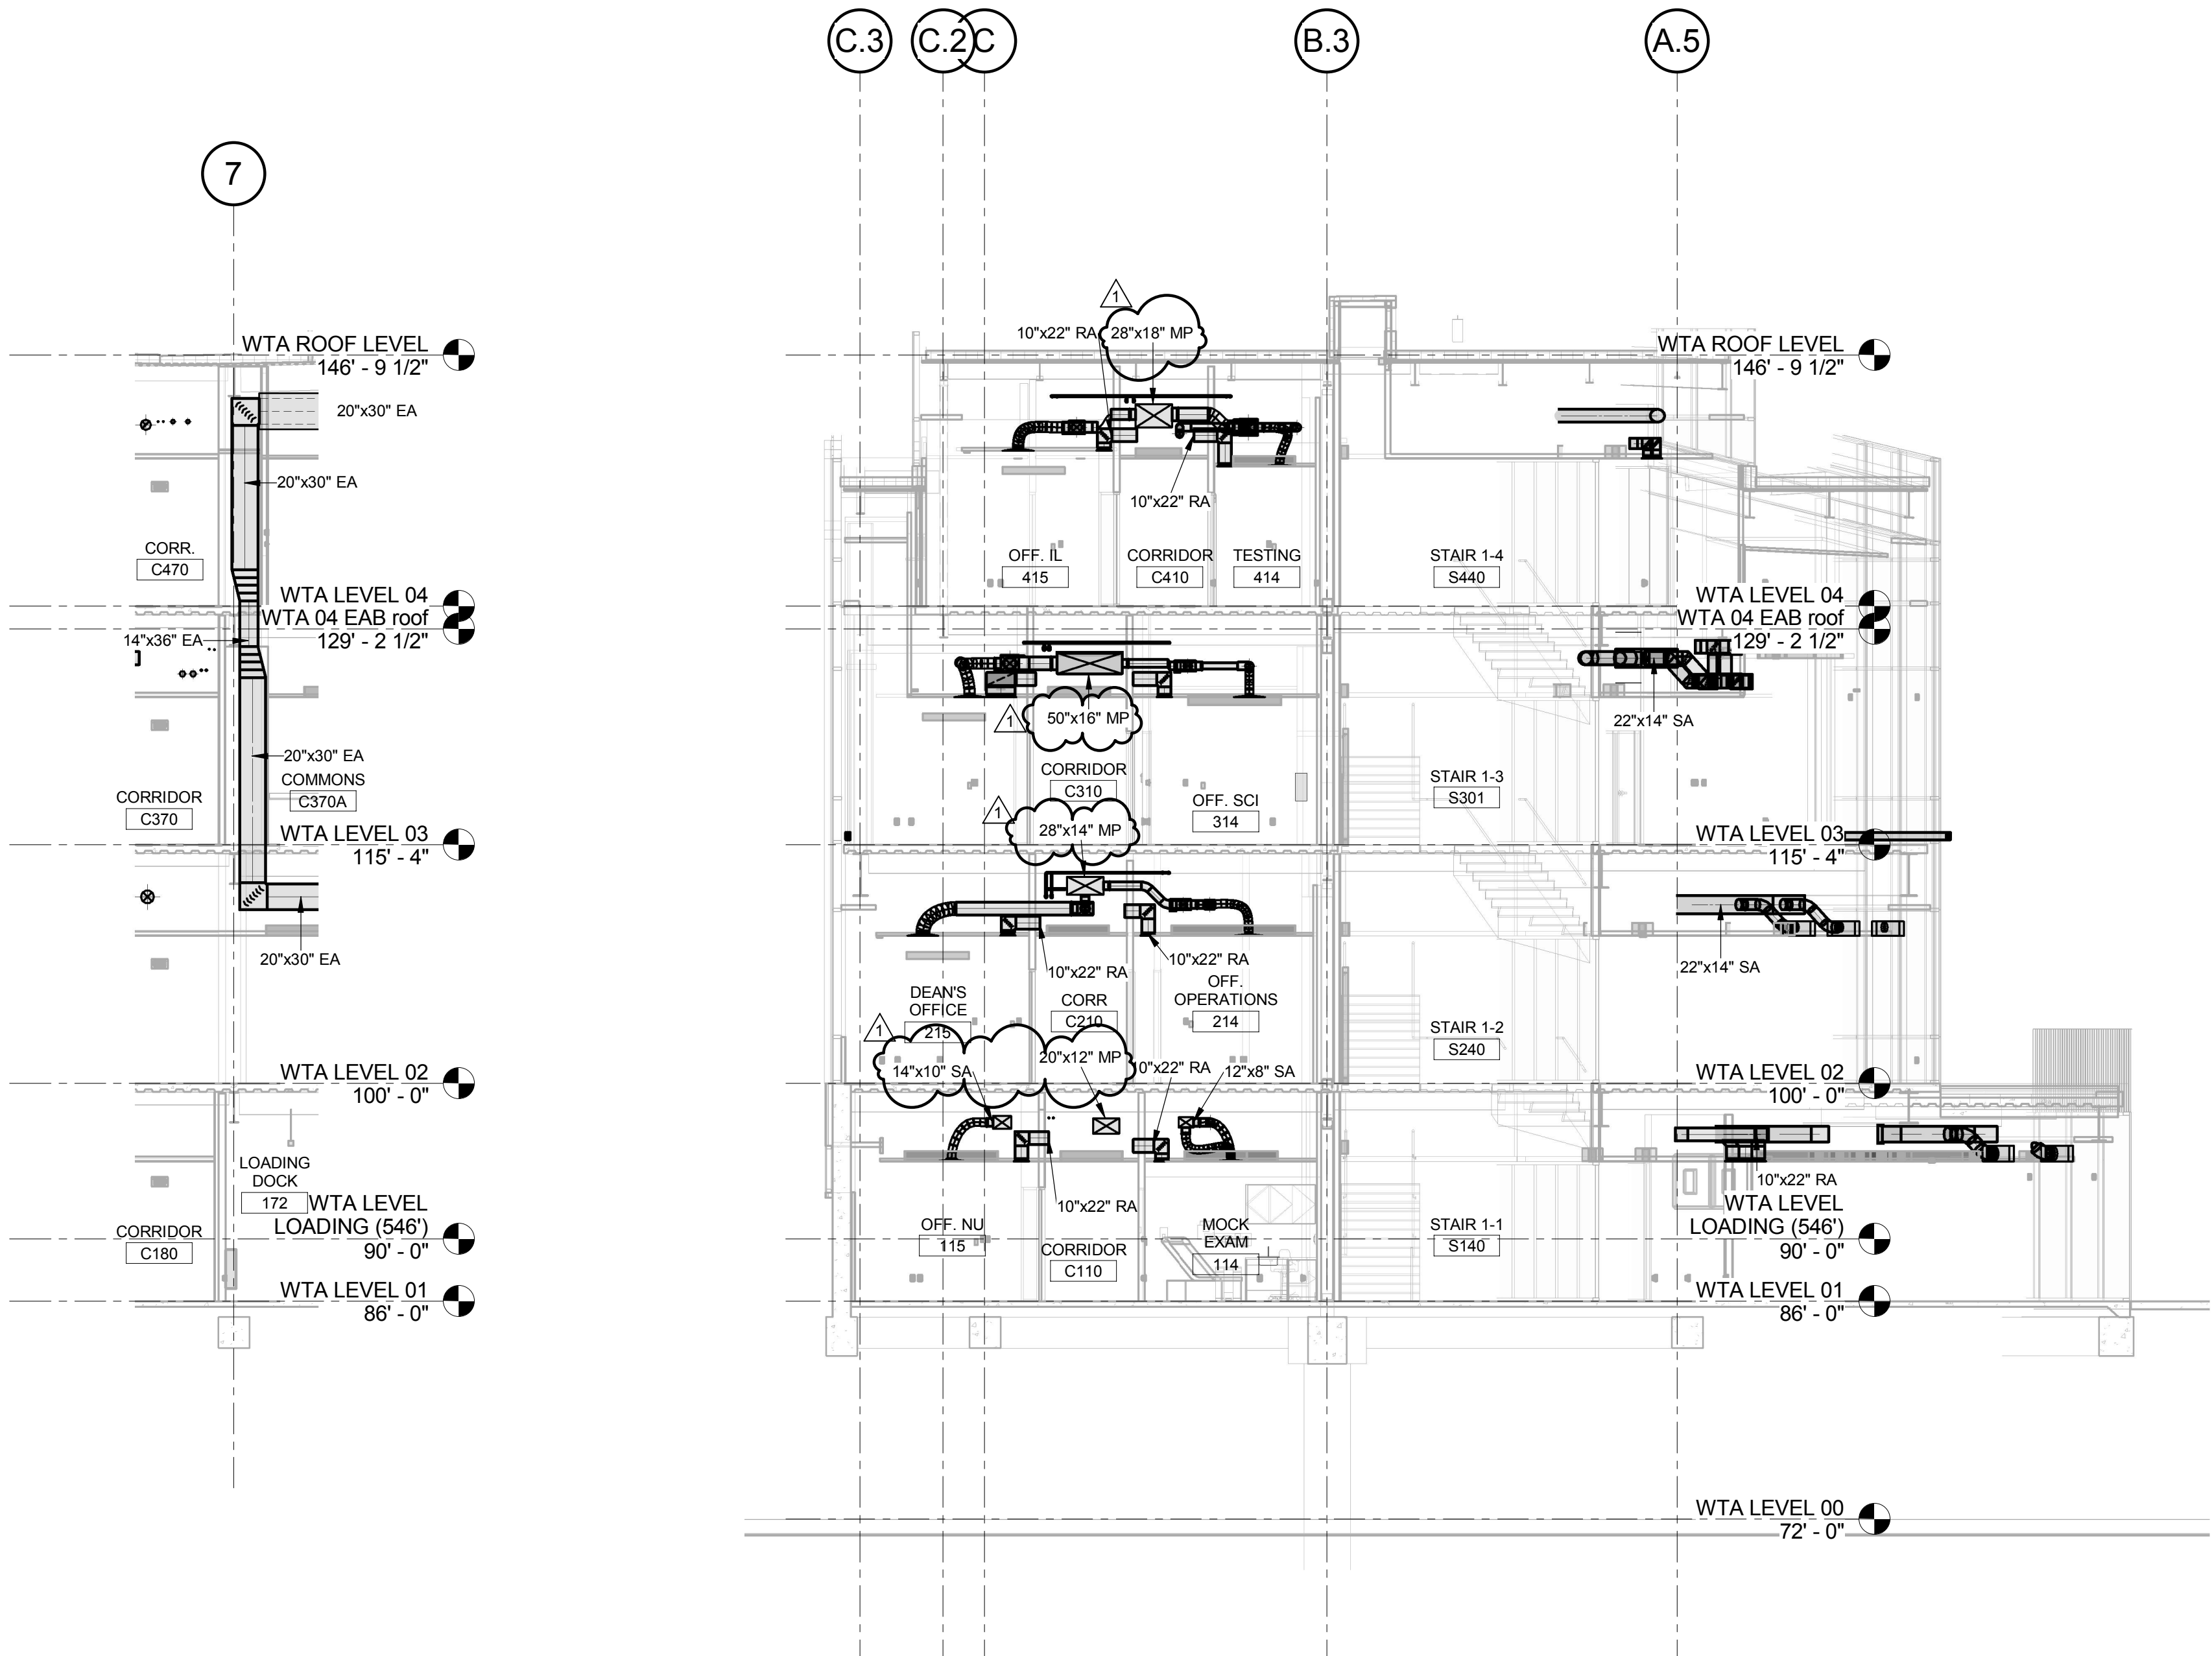

3 EXHAUST RISER LOOKING NORTH
1/8" = 1'-0"

1 AREA B - (LOOKING EAST)
1/8" = 1'-0"

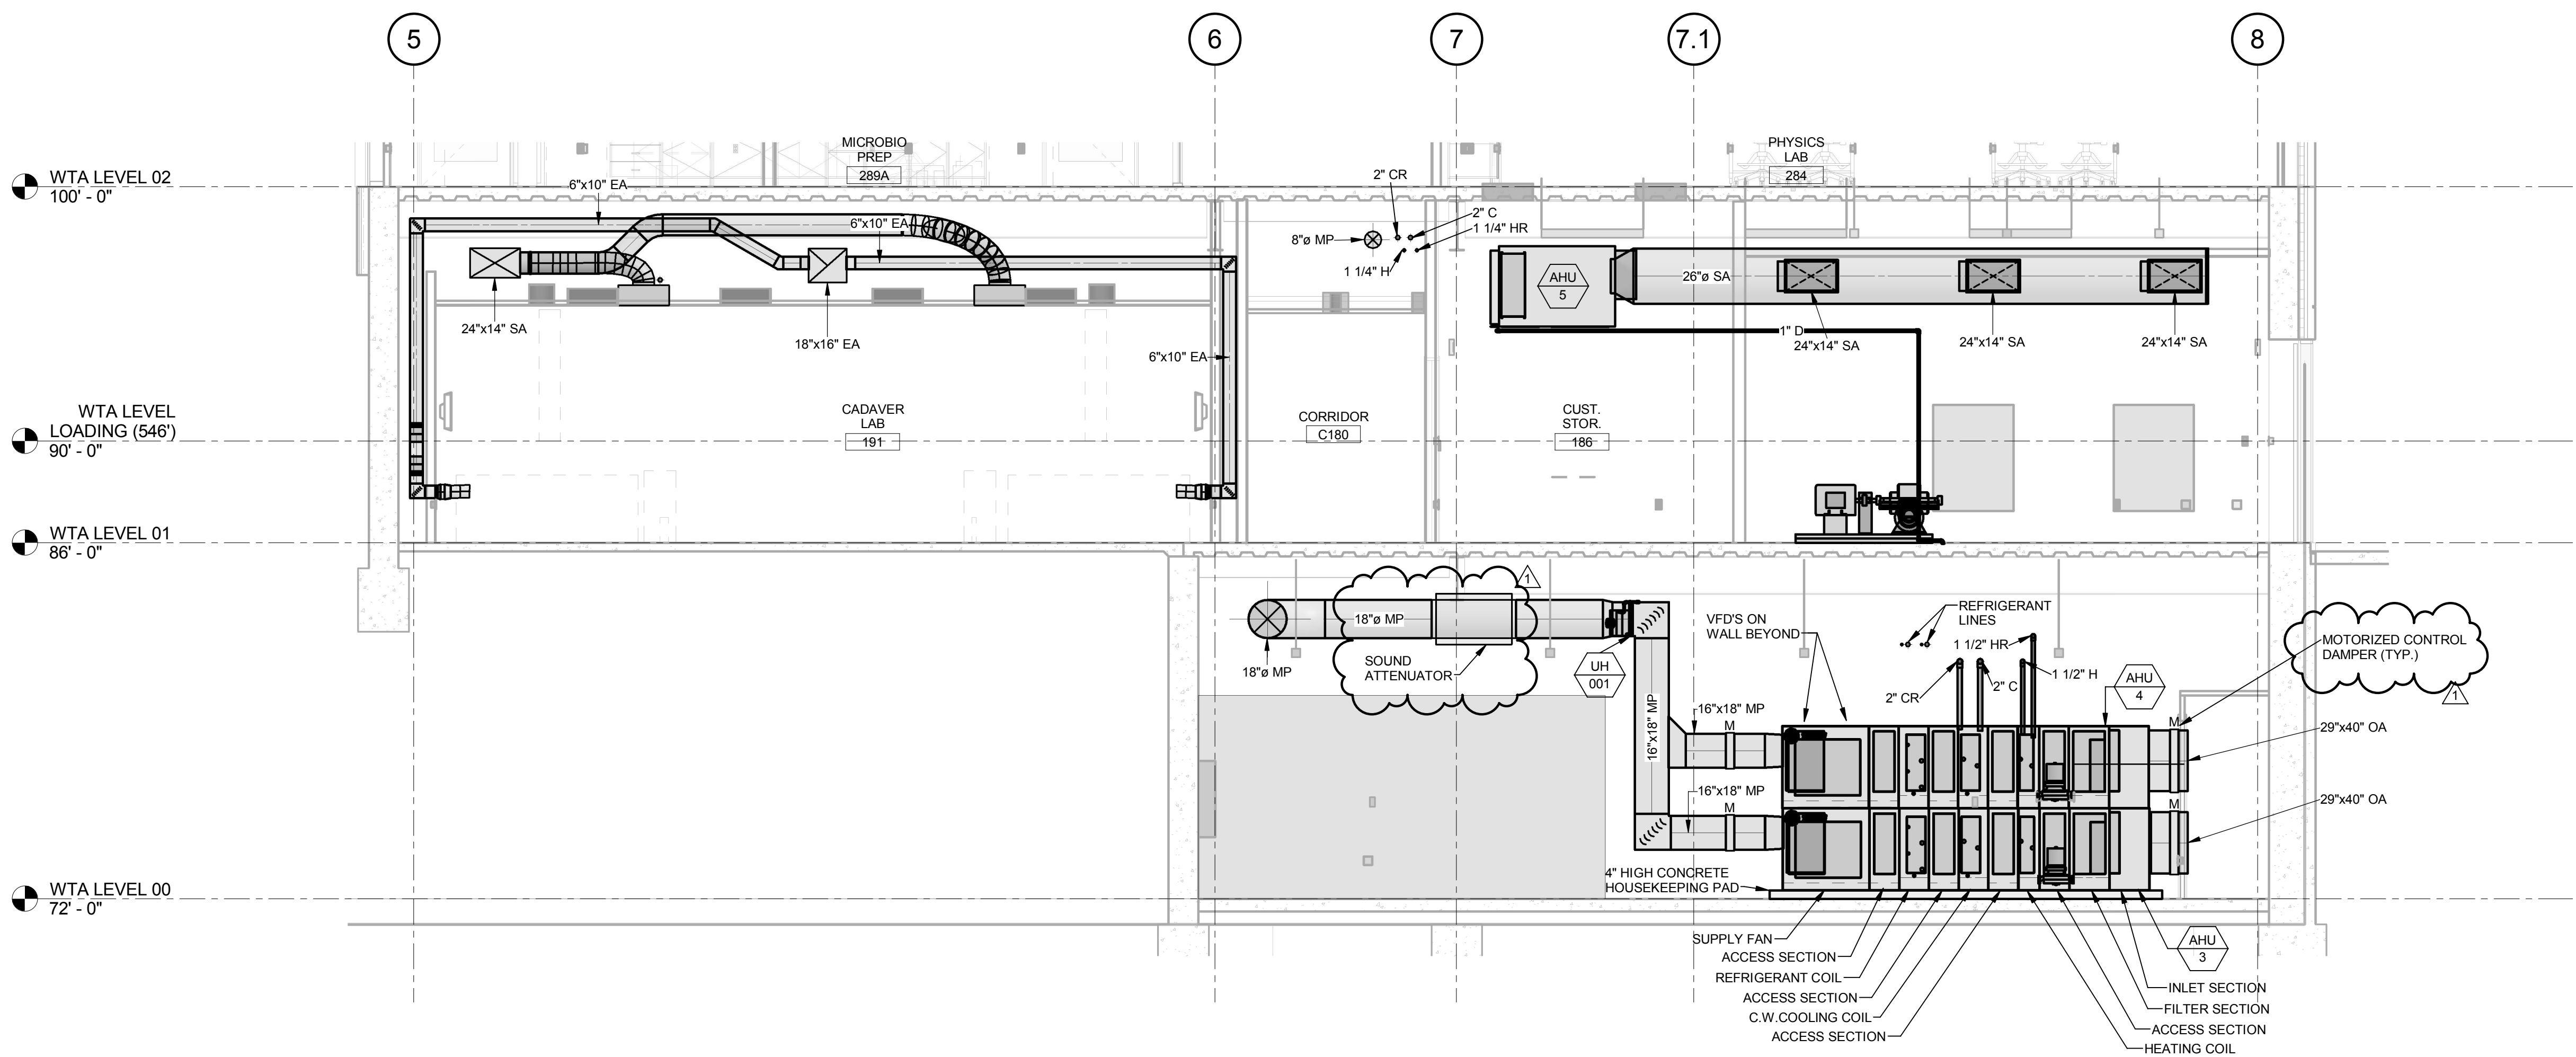

2 AHU-3 & 4 - (LOOKING NORTH)
1/4" = 1'-0"

CONFORMED SET 01 JUL 2016

1 ADDENDUM 2-1 17 MAR 2016
ISSUED FOR CONSTRUCTION (BP2) 01 MAR 2016
No. Description Date

Drawing Title:

SECTIONS & ELEVATIONS

Project No.: 04561.01 Checked by:

M0302