


CONFORMED SET 01 JUL 2016

4	ADDENDUM 2-4	24 MAY 2016
3	ADDENDUM 2-2	19 APR 2016
2	MSD SUBMITTAL	12 APR 2016
1	ADDENDUM 2-1	17 MAR 2016
-	ISSUED FOR CONSTRUCTION (BP2)	01 MAR 2016

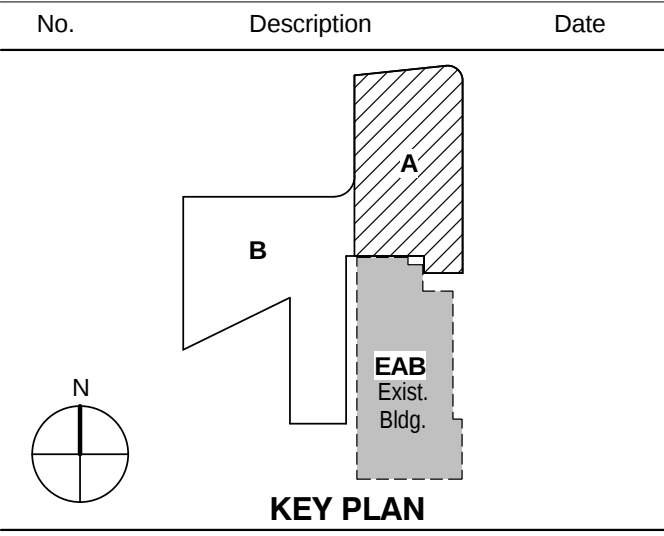


Drawing Title:

LEVEL 01 AREA A FLOOR
PLAN - PLUMBING

Project No.: 04561.01 Checked by:

P0101.A

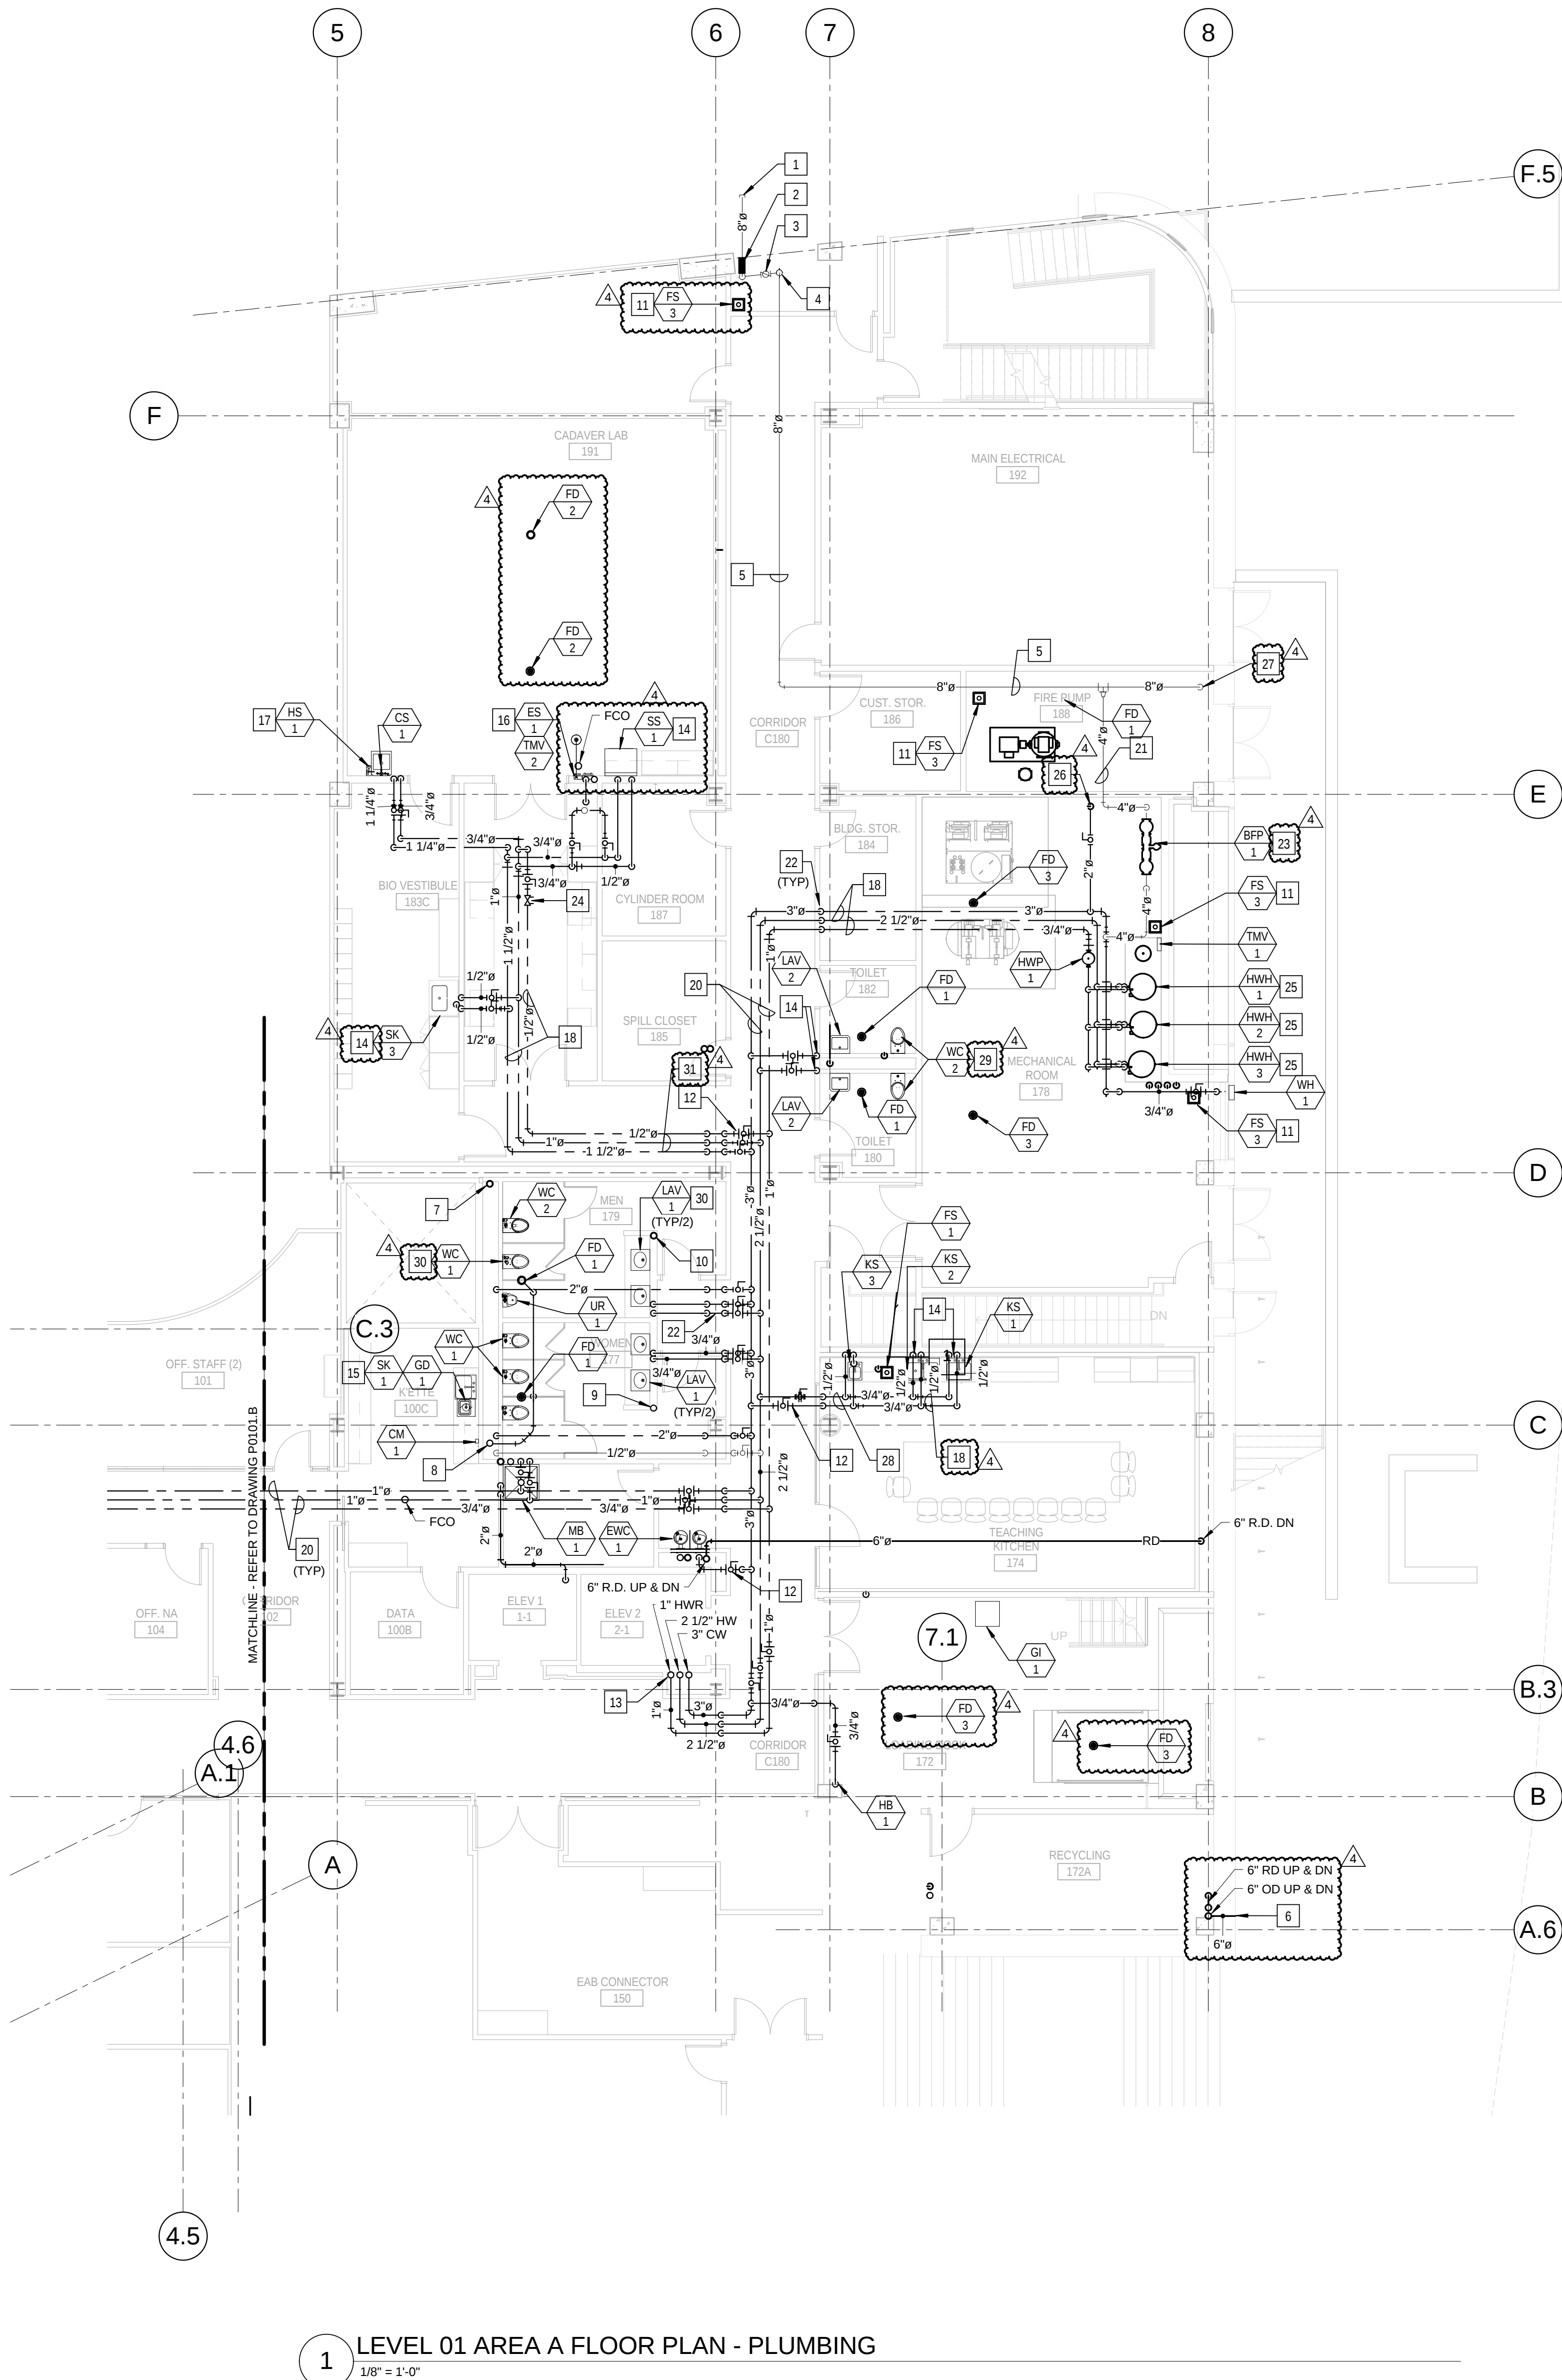

KEYED NOTES - (THIS SHEET ONLY)

- 8" COMBINATION FIRE/DOMESTIC WATER SERVICE. REFER TO CIVIL DRAWINGS FOR CONTINUATION.
- SLEEVE AND SEAL WATER TIGHT WITH "LINK-SEAL" ASSEMBLY. REFER TO DETAIL ON SHEET P0501.
- MAIN SERVICE VALVE FOR COMBINATION DOMESTIC WATER AND FIRE SERVICE. REFER TO DRAWING P0403, DETAIL 1/P0403.
- BUILDING PRESSURE GAUGE POSITION TO BE VISIBLE.
- 8" GALVANIZED COMBINATION FIRE/DOMESTIC WATER SERVICE ABOVE CEILING. COORDINATE WITH OTHER TRADES PRIOR TO ROUGH IN. REFER TO DRAWING P0401, DETAIL 1.
- COORDINATE LOCATION OF DOWN SPOUT NOZZLE AND WALL SLEEVE WITH OTHER TRADES PRIOR TO ROUGH IN.
- 4" SANITARY VENT RISER UP TO SERVE WATER CLOSETS, URINALS AND FLOOR DRAINS ON EACH LEVEL.
- 4" SANITARY WASTE RISER UP TO SERVE WATER CLOSETS, URINALS AND FLOOR DRAINS ON EACH LEVEL.
- 2" SANITARY WASTE RISER UP TO SERVE LAVATORIES ON EACH LEVEL.
- 2" SANITARY VENT RISER UP TO SERVE LAVATORIES ON EACH LEVEL.
- COORDINATE LOCATION OF FLOOR SINK WITH LAYOUT OF ROOM AND FOUNDATION BELOW PRIOR TO ROUGH IN.
- FURNISH AND INSTALL SHUT-OFF VALVES AT THE ENTRY TO EACH ROOM.
- FURNISH AND INSTALL 3" CW, 2 1/2" HW AND 1" HWR PIPING UP TO SERVE LEVEL 2. ALIGN PIPE WITH WALL ABOVE.
- FURNISH AND INSTALL 1/2" CW, 1/2" HW AND 2" VENT DOWN IN WALL TO SERVE FIXTURES.
- BREAK-ROOM SINKS ARE TO BE SERVED FROM WATER, WASTE AND VENT PIPING IN TOILET ROOM CHASE.
- EMERGENCY SHOWER TO BE SERVED WITH FIELD FURNISHED AND INSTALLED 1" TEMPERED WATER TO SHOWER HEAD FROM WALL RECESSED CABINET. EYEWASH PORTION OF ASSEMBLY WILL REQUIRE 2" WASTE AND 2" VENT TYPICAL FOR ALL INSTALLATIONS. REFER TO DRAWING P0403, DETAIL 3/P0403.
- WALL RECESSED CW AND HW HOSE STATION. SERVE WITH 1/2" CW AND 1/2" HW FROM CLINICAL SINK. COORDINATE LOCATION AND MOUNTING HEIGHT WITH OTHER TRADES PRIOR TO ROUGH IN.
- PIPING IN EACH ROOM SHALL BE RUN AS HIGH AS POSSIBLE TO AVOID CONFLICTS. COORDINATE INSTALLATION AND ROUTING WITH OTHER TRADES PRIOR TO ROUGH IN.
- NOT USED.
- PIPING IN CORRIDOR TO BE AT BOTTOM OF STRUCTURAL STEEL CROSS MEMBERS. COORDINATE INSTALLATION AND ROUTING WITH OTHER TRADES PRIOR TO ROUGH IN.
- 4" GALVANIZED DOMESTIC WATER TO DOMESTIC WATER BEAUFLOW PREVENTER.
- DROP PIPING DOWN TO BELOW STRUCTURAL STEEL MEMBER. HOLD TIGHT TO BOTTOM OF STEEL.
- DOMESTIC WATER SERVICE BACK FLOW PREVENTER. REFER TO DRAWING P0501, DETAIL 6/P0501.
- HOT WATER RETURN CIRCUIT SETTER VALVE. LOCATE IN AN ACCESSIBLE LOCATION ABOVE THE CEILING. REFER TO DRAWING P0502, DETAIL 11/P0502.
- REFER TO DRAWING P0403, DETAIL 2/P0403 FOR HOT WATER HEATER PIPING DIAGRAM.
- 2" DOMESTIC WATER SERVICE DOWN TO LEVEL 0. REFER TO DRAWING P0011 FOR CONTINUATION.
- 8" GALVANIZED WATER SERVICE DOWN FOR FIRE SERVICE.
- REFER TO DRAWING P0402, DETAIL 1 FOR RISER DIAGRAMS.
- REFER TO DRAWING P0402, DETAIL 2 FOR RISER DIAGRAMS.
- REFER TO DRAWING P0401 FOR PUBLIC TOILET ROOM RISER DIAGRAMS.
- REFER TO DRAWING P0405 FOR WATER SUPPORT RISER 1.

1 LEVEL 01 AREA A FLOOR PLAN - PLUMBING
1/8" = 1'-0"