


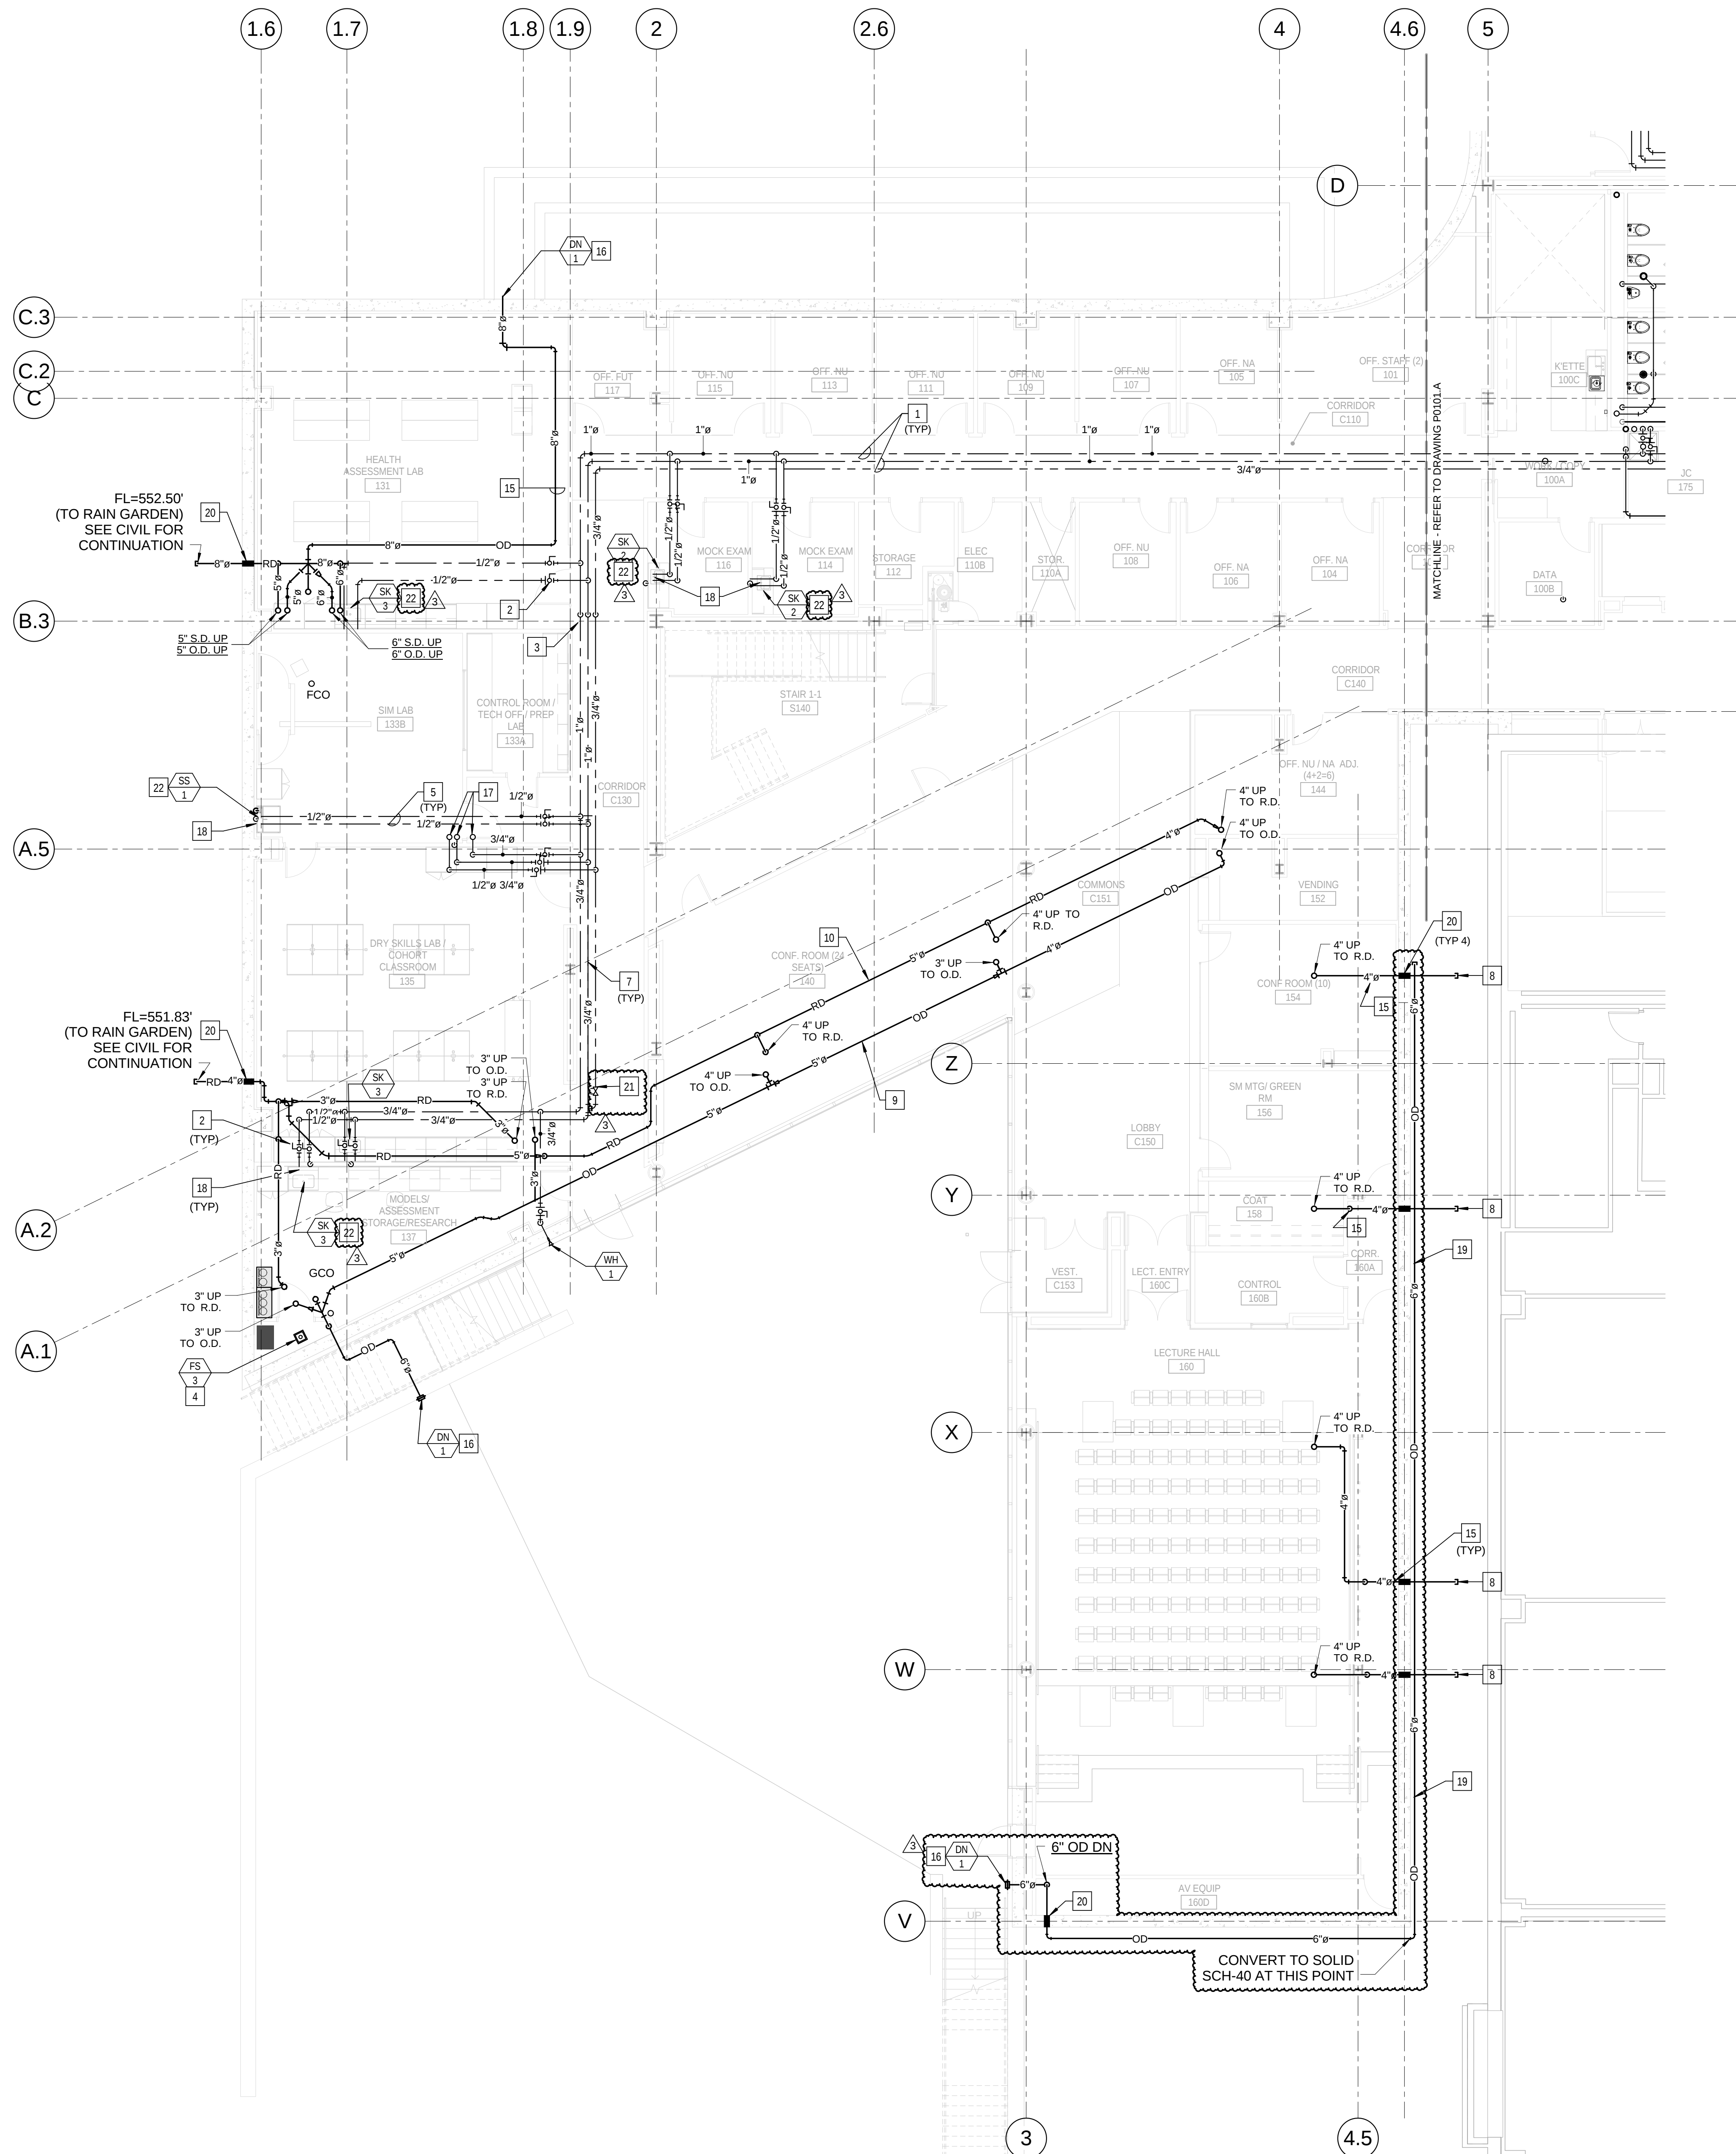

1 LEVEL 01 AREA B FLOOR PLAN - PLUMBING
1/8" = 1'-0"


KEYED NOTES - (THIS SHEET ONLY)

- 1 PIPING IN CORRIDOR TO BE AT BOTTOM OF STRUCTURAL STEEL CROSS MEMBERS. COORDINATE INSTALLATION AND ROUTING WITH OTHER TRADES PRIOR TO ROUGH-IN.
- 2 PROVIDE SHUT-OFF VALVES AT THE ENTRY TO EACH ROOM.
- 3 DROP PIPING DOWN TO BELOW STRUCTURAL STEEL MEMBER. HOLD TIGHT TO BOTTOM OS STEEL.
- 4 COORDINATE LOCATION OF FLOOR SINK WITH LAYOUT OF ROOM AND FOOTINGS/FOUNDATION BELOW.
- 5 PIPING IN EACH ROOM TO BE RUN AS HIGH AS POSSIBLE TO AVOID CONFLICTS. COORDINATE INSTALLATION AND ROUTING WITH OTHER TRADES PRIOR TO ROUGH-IN.
- 6 NOT USED.
- 7 HOLD PIPING TIGHT TO BOTTOM STRUCTURAL STEEL.
- 8 4" STORM DRAIN FROM GREEN ROOF, EXTEND TO 5'-0" FROM BUILDING WALL. COORDINATE WITH THE CIVIL PLANS FOR FLOW LINE ELEVATIONS. REFER TO THE CIVIL DRAWINGS FOR CONTINUATION OF PIPING.
- 9 STORM PIPING FOR UNDER PAVER SECONDARY STORM DRAINAGE SYSTEM. COORDINATE ROUTING AND INSTALLATION WITH OTHER TRADES PRIOR TO ROUGH-IN. HOLD PIPING AS HIGH AS POSSIBLE TO MAINTAIN SLOPE.
- 10 4" STORM PIPING FOR UNDER PAVER PRIMARY STORM DRAINAGE SYSTEM. COORDINATE ROUTING AND INSTALLATION WITH OTHER TRADES PRIOR TO ROUGH-IN. HOLD PIPING AS HIGH AS POSSIBLE TO MAINTAIN SLOPE.
- 11 NOT USED.
- 12 NOT USED.
- 13 NOT USED.
- 14 NOT USED.
- 15 COORDINATE ROUTING AND INSTALLATION OF STORM PIPING WITH STRUCTURAL STEEL AND DUCTWORK. PIPING WILL BE REQUIRED TO RUN BELOW THE DUCTWORK, AND OFFSET BELOW THE STRUCTURAL MEMBERS.
- 16 COORDINATE AND VERIFY LOCATION OF DOWN SPOUT NOZZLE AND WALL SLEEVE PRIOR TO ROUGH-IN.
- 17 1/4" CW, 1/2" HW AND 1/2" HWR PIPING UP TO LEVEL 2. ALIGN PIPING WITH WALL ABOVE
- 18 1/2" CW, 1/2" HW AND 2" VENT DOWN IN WALL TO SERVE FIXTURE.
- 19 FURNISH AND INSTALL 6" PERFORATED SCHEDULE 40 PVC SECONDARY DRAIN SYSTEM ALONG THE EAST SIDE OF THE GREEN ROOF AS INDICATED ON PLAN. CONVERT TO SOLID SCHEDULE 40 PVC PIPING AS NOTED ON PLAN. COORDINATE WITH CIVIL AND REFER TO THE ARCHITECTURAL PLANS FOR PIPE TRENCH DETAIL.
- 20 SLEEVE AND SEAL WATER TIGHT WITH "LINK-SEAL" ASSEMBLY. REFER TO DETAIL ON SHEET P0501.
- 21 HOT WATER RETURN CIRCUIT SETTER VALVE. LOCATE IN AN ACCESSIBLE LOCATION ABOVE THE CEILING. REFER TO DRAWING P0502, DETAIL 11.
- 22 REFER TO DRAWING P0402, DETAIL 3 FOR RISER DIAGRAM.

CONFORMED SET 01 JUL 2016

3 ADDENDUM 2-4 24 MAY 2016
2 ADDENDUM 2-2 19 APR 2016
1 ADDENDUM 2-1 17 MAR 2016
- ISSUED FOR CONSTRUCTION (BP2) 01 MAR 2016

No.	Description	Date
-----	-------------	------

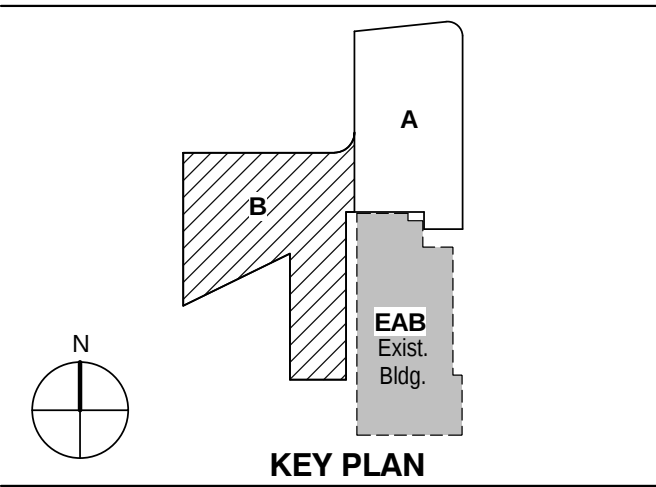

KEY PLAN

LEVEL 01 AREA B FLOOR
PLAN - PLUMBING

Project No.: 04561.01 Checked by:

P0101.B