


© Cannon Design 2015
All rights reserved. No part of this document may be reproduced or transmitted in any form without written authorization by The Cannon Corporation.
5/24/2016 8:51:07 AM

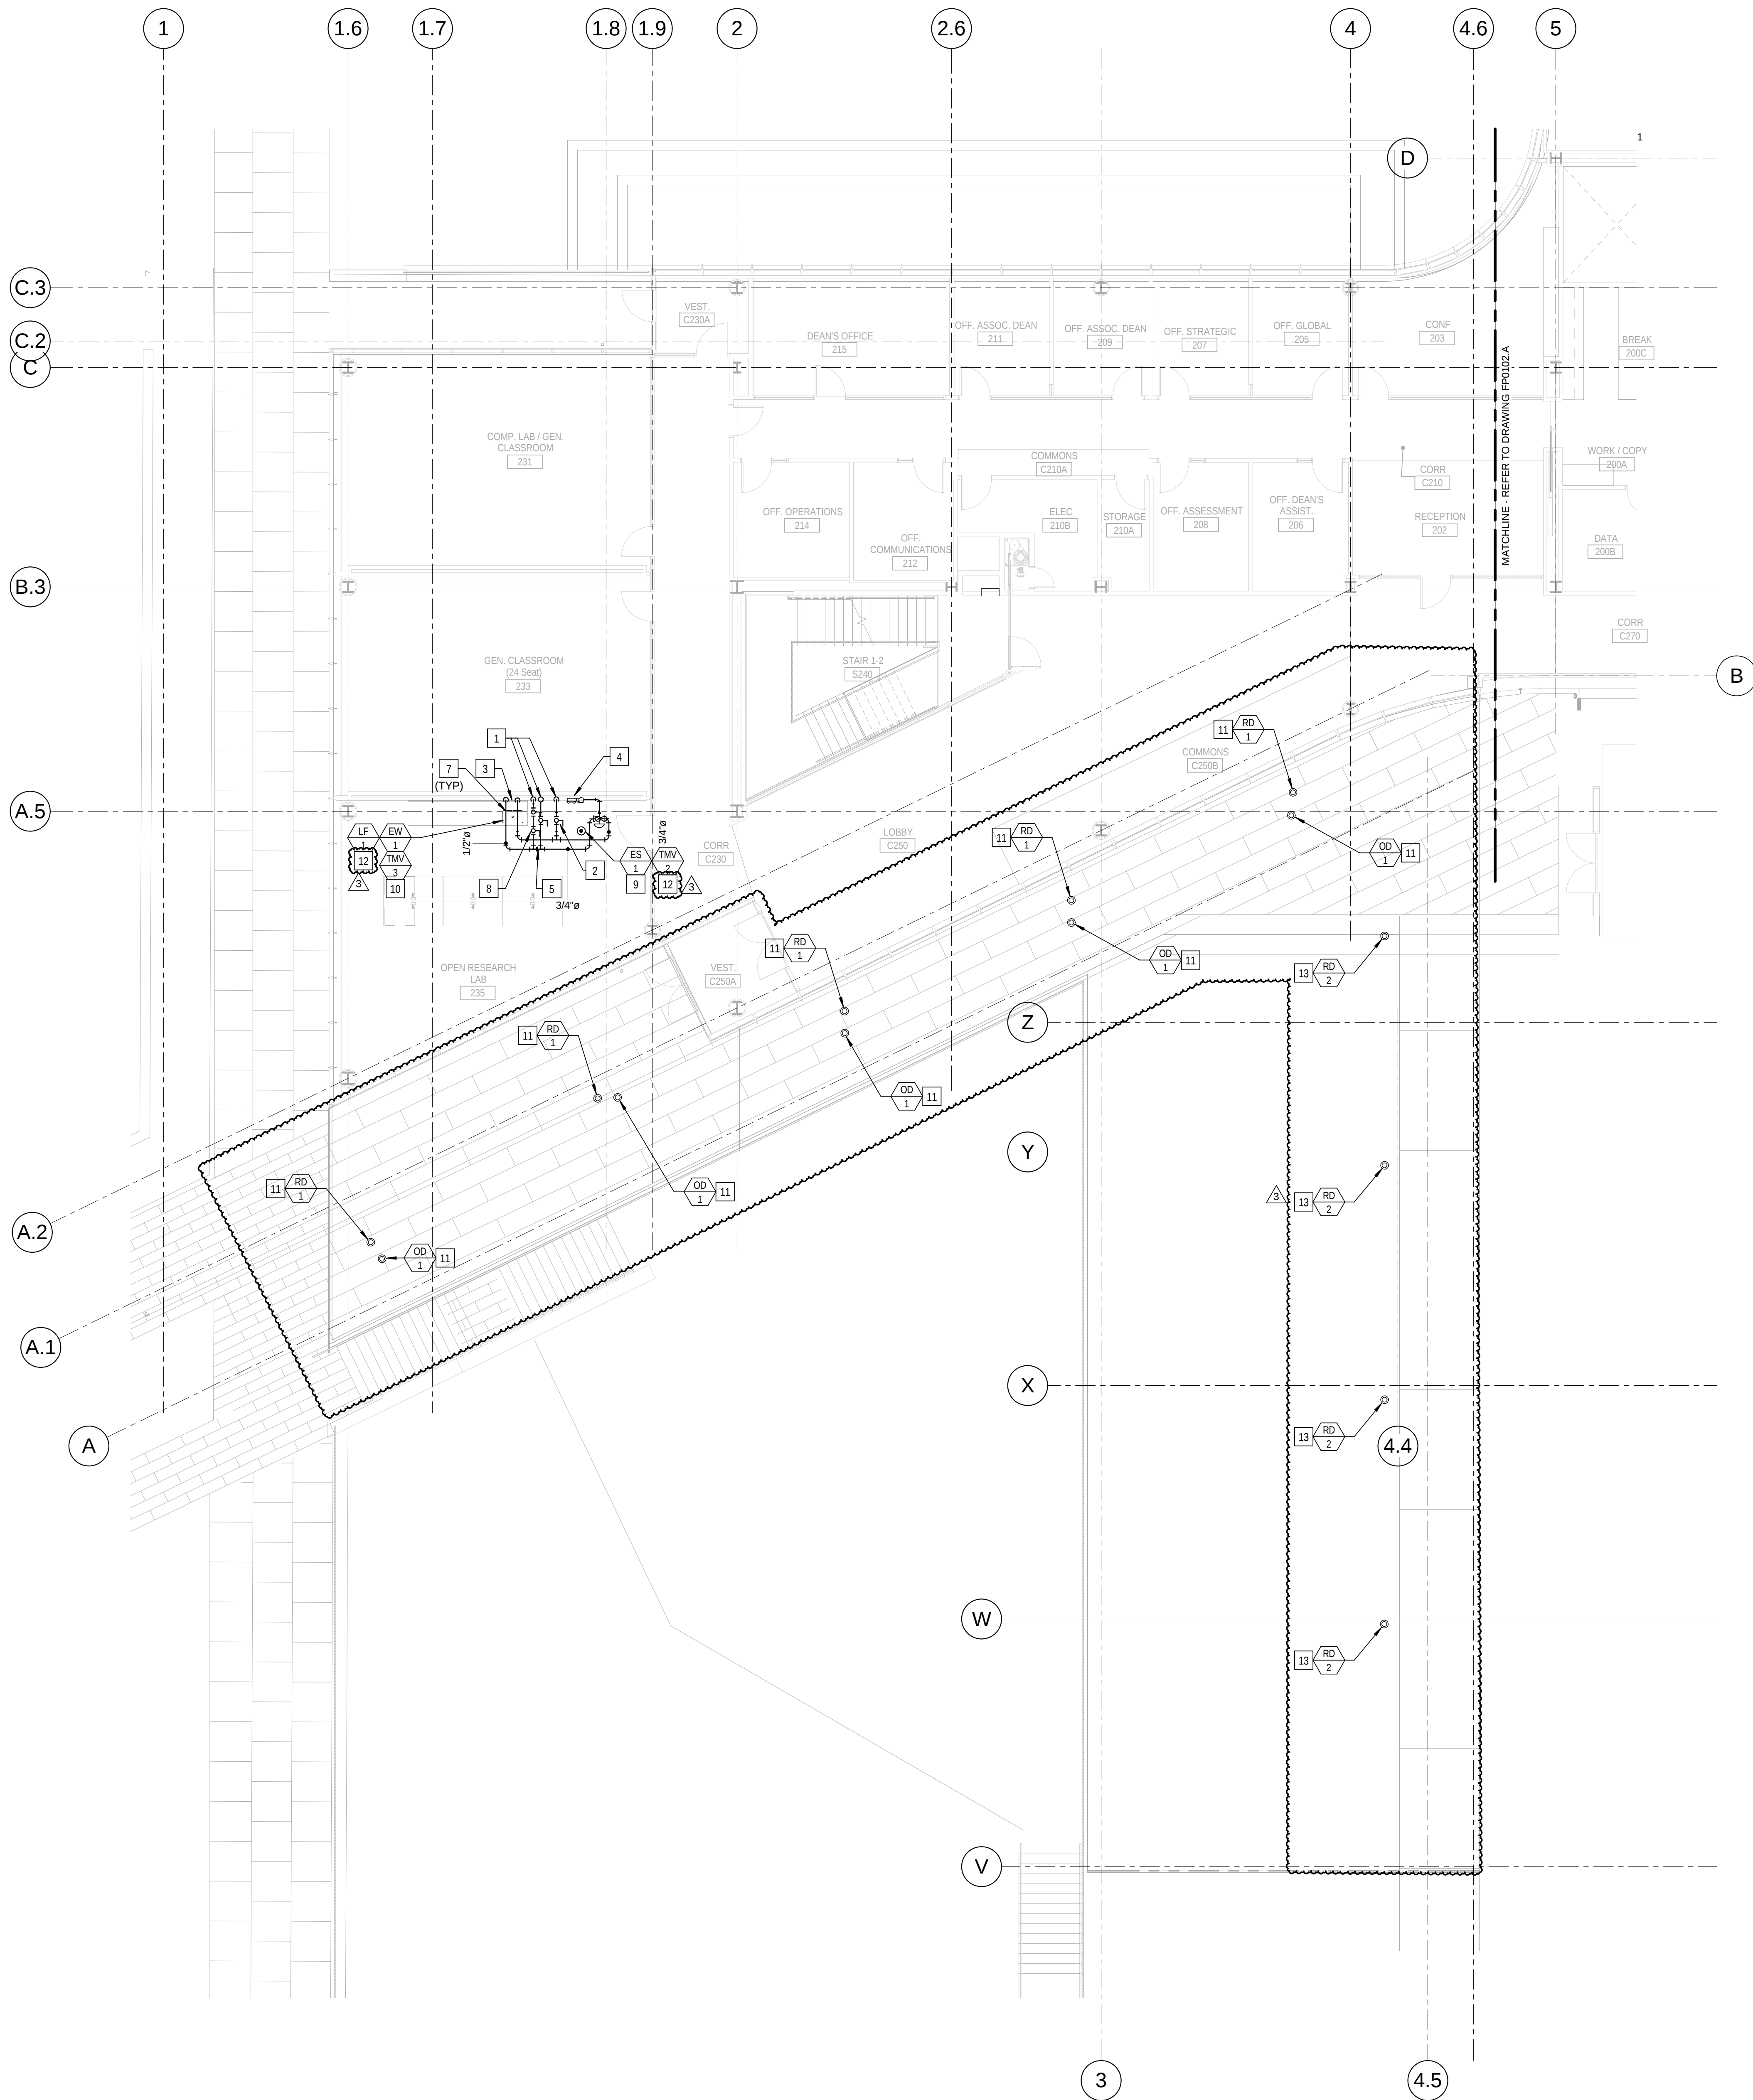

1 LEVEL 02 AREA B FLOOR PLAN - PLUMBING
1/8" = 1'-0"

KEYED NOTES-PLUMBING NEW WORK:

- 1 3/4" CW, 3/4" HW AND 1/2" HWR PIPING UP FROM LEVEL 1.
- 2 PROVIDE SHUT-OFF VALVES AT THE ENTRY TO EACH ROOM.
- 3 1/2" CW, 1/2" HW AND 2" VENT DOWN IN WALL TO SERVE FIXTURE.
- 4 2" SANITARY VENT DOWN IN WALL TO SERVE EMERGENCY SHOWER.
- 5 PIPING IN EACH ROOM TO BE RUN AS HIGH AS POSSIBLE TO AVOID CONFLICTS. COORDINATE INSTALLATION AND ROUTING WITH OTHER TRADES PRIOR TO ROUGH-IN.
- 6 NOT USED.
- 7 HOLD PIPING TIGHT TO BOTTOM STRUCTURAL STEEL.
- 8 HOT WATER CIRCULATING LINE. PROVIDE SHUT-OFF VALVE, CIRCUIT SETTER AND CHECK VALVE. LOCATE IN AN ACCESSIBLE LOCATION ABOVE THE CEILING. REFER TO DRAWING P0502, DETAIL 11.
- 9 EMERGENCY SHOWER TO BE SERVED WITH FIELD FURNISHED AND INSTALLED 1" TEMPERED WATER TO SHOWER HEAD FROM WALL RECESSED CABINET. EYEWASH PORTION OF ASSEMBLY TO PROVIDED 2" WASTE AND 2" VENT. TYPICAL FOR ALL INSTALLATIONS. REFER TO DRAWING P0403, DETAIL 3.
- 10 DECK MOUNTED EMERGENCY EYEWASH TO BE LOCATED AT SINK. INSTALL THERMOSTATIC MIXING VALVE IN CABINET SPACE BELOW THE SINK. COORDINATE MOUNTING REQUIREMENTS OF EYEWASH AND TMV WITH THE GENERAL CONTRACTOR. TYPICAL FOR ALL INSTALLATION. REFER TO DRAWING P0403, DETAIL 4.
- 11 LOCATION OF ROOF DRAIN AND OVERFLOW DRAIN. BELOW THE WALKING PAVERS. REFER TO THE ARCHITECTURAL PLANS FOR EXACT LOCATION AND DETAILS.
- 12 REFER TO DRAWING P0402, DETAIL 3 FOR RISER DIAGRAMS.
- 13 LOCATION OF ROOF DRAIN FOR THE GREEN ROOF. REFER TO THE ARCHITECTURAL PLANS FOR EXACT LOCATION AND DETAILS.



Webster University
Interdisciplinary Science
Building

CANNONDESIGN

1100 Clark Avenue
St. Louis, Missouri 63102
T: 314.241.6250
F: 314.241.2570

William Tao & Associates, Inc.
MEP/FP Engineer
7955 Manchester Road, Suite 125
St. Louis, MO 63143
314.884.7600

David Mason & Associates, Inc.
Structural & Civil Engineer
800 South Vandeventer Avenue
St. Louis, MO 63110
314.534.1053

Faith Group
Technology
3101 S. Hanley Rd, Suite 100
St. Louis, MO 63143
314.991.2228

Kuhnmann Leavitt, Inc.
Environmental Graphics & Signage
7400 Pershing Ave
St. Louis, MO 63130
314.725.6616

KWA Architects
Architecture
9721 Litzinger Road
St. Louis, MO 63124
314.962.2560


Spellman Brady & Company
Interior Designer
8251 Maryland Avenue, Suite 300
St. Louis, MO 63105
314.862.0070

SWT Design
Landscape Architect
7722 Big Bend Blvd
St. Louis, MO 63119
314.644.5700

Webb Engineering Services, Inc.
Planning & Fire Protection
1400 S. 3rd Street, Suite 201
St. Louis, MO 63104
314.588.0600

CONFORMED SET 01 JUL 2016

3 ADDENDUM 2-4 24 MAY 2016
2 ADDENDUM 2-2 19 APR 2016
1 ADDENDUM 2-1 17 MAR 2016
- ISSUED FOR CONSTRUCTION (BP2) 01 MAR 2016

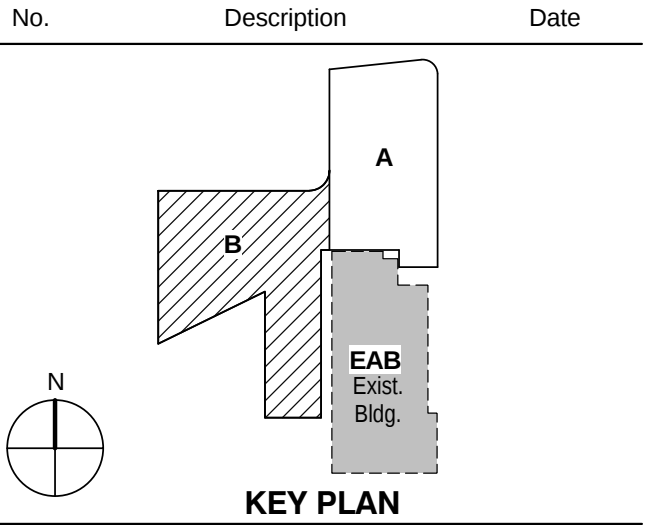

KEY PLAN

Drawing Title:
**LEVEL 02 AREA B FLOOR
PLAN - PLUMBING**

Project No.: 04561.01 Checked by:

P0102.B