


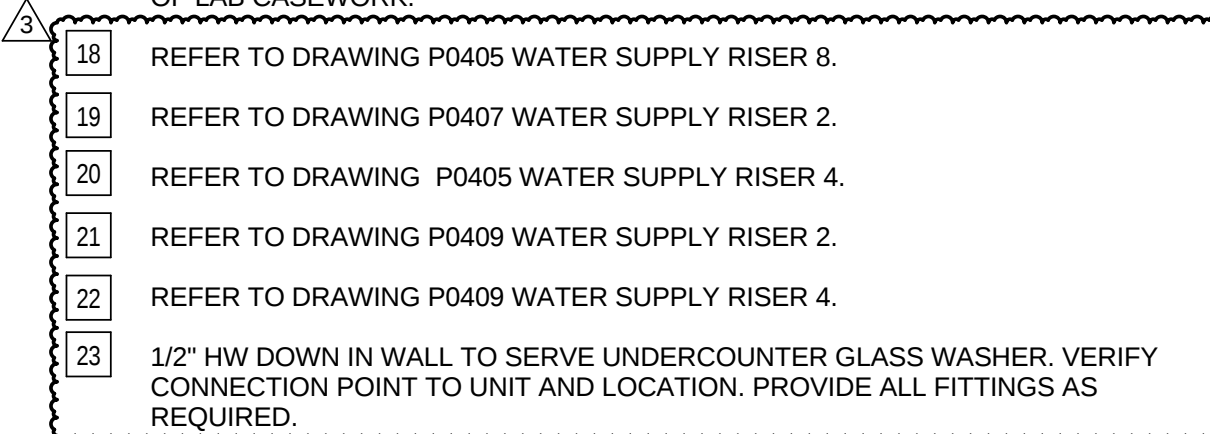

P0104.A