


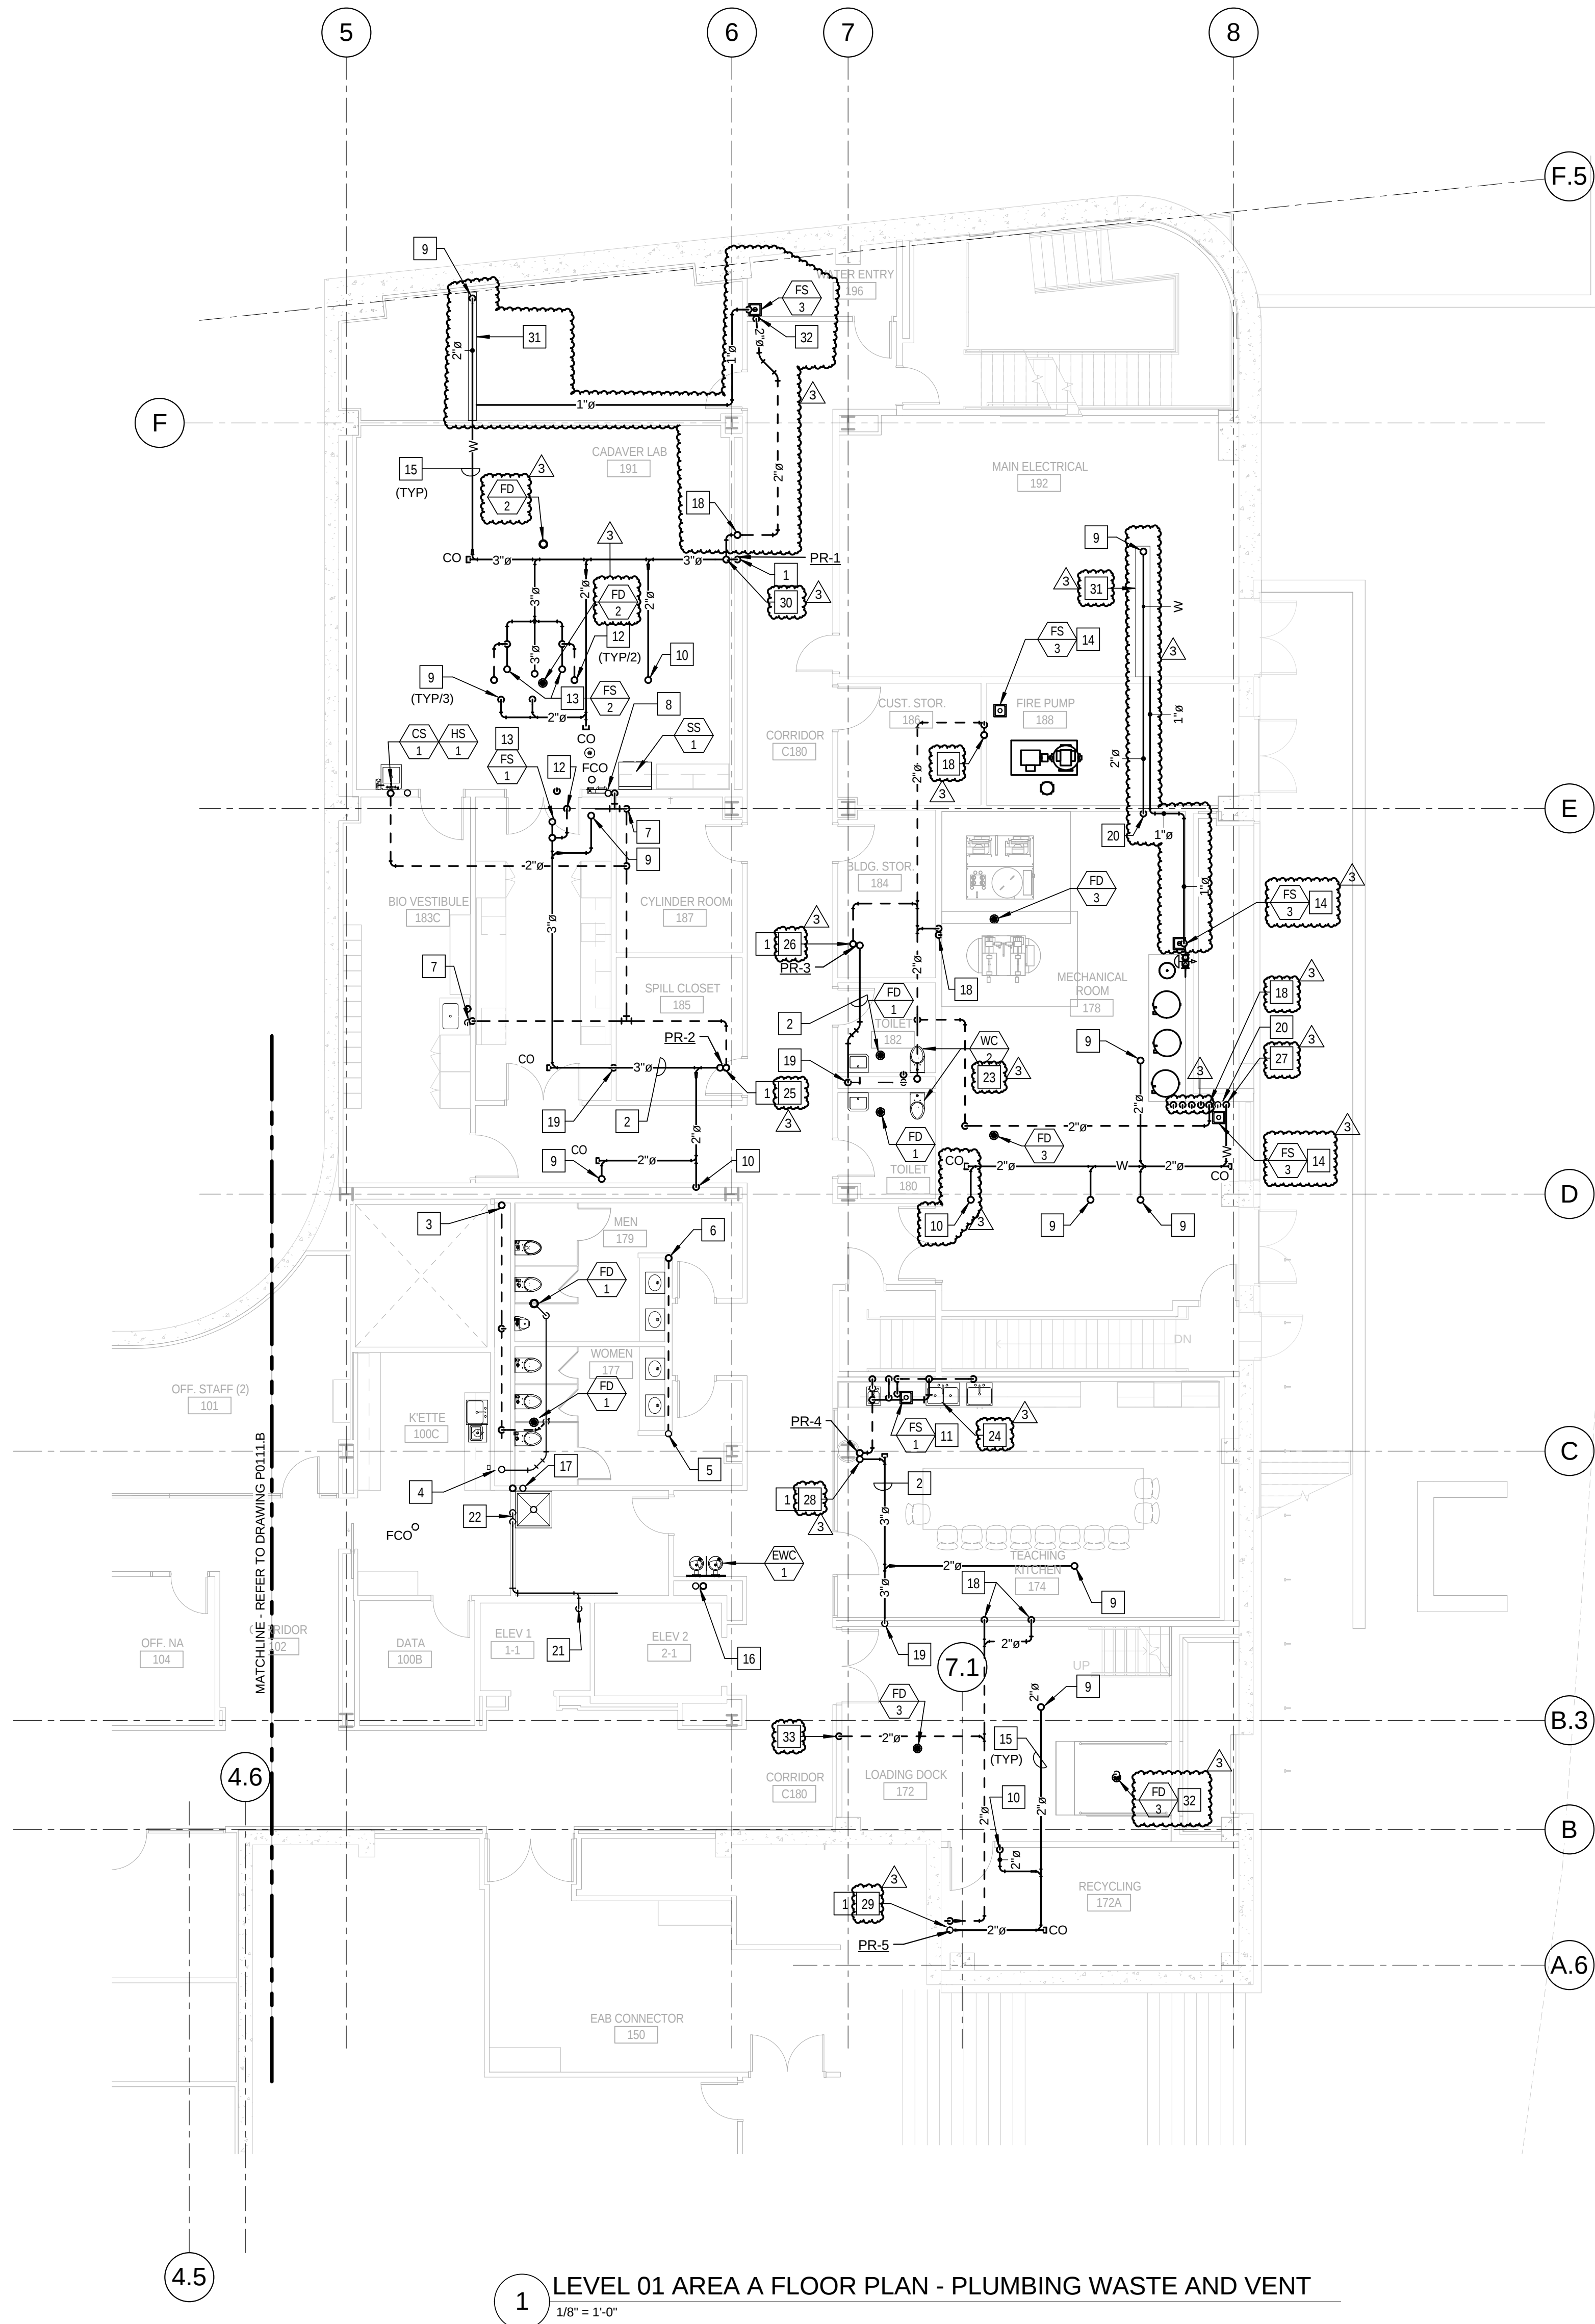

1 LEVEL 01 AREA A FLOOR PLAN - PLUMBING WASTE AND VENT
1/8" = 1'-0"


KEYED NOTES: (THIS SHEET ONLY)

- 1 3" SANITARY WASTE AND 3" SANITARY VENT RISERS.
- 2 3" SANITARY WASTE OFF-SET ABOVE THE CEILING TO CONTINUE DOWN TO LEVEL 0.
- 3 4" SANITARY VENT RISER UP AND DOWN.
- 4 4" SANITARY WASTE UP AND DOWN. REFER TO DRAWING P0401 FOR RISER DIAGRAM.
- 5 2" SANITARY WASTE UP AND DOWN. REFER TO DRAWING P0401 FOR RISER DIAGRAM.
- 6 2" SANITARY VENT UP AND DOWN.
- 7 2" SANITARY VENT DOWN IN WALL TO SERVE LABORATORY SINK.
- 8 2" SANITARY VENT DOWN IN WALL TO SERVE EMERGENCY SHOWER.
- 9 2" SANITARY WASTE UP TO LEVEL 2 LAB SINK.
- 10 2" SANITARY WASTE UP TO LEVEL 2 EMERGENCY SHOWER EYE/FACE WASH STATION. REFER TO DRAWING P0403 DETAIL 3/ P0403.
- 11 FLOOR SINK TO BE LOCATED BELOW THE CASEWORK TO ACCEPT DISCHARGE FROM THE DISHWASHER AND UNDER COUNTER ICE MAKER. COORDINATE LOCATION WITH CABINET AND APPLIANCES.
- 12 2" SANITARY VENT UP TO LEVEL 2, ALIGN WITH CASEWORK AND WALL ABOVE.
- 13 FLOOR SINK SET TO SERVE LEVEL 2. COORDINATE LOCATION OF FLOOR SINK WITH CASEWORK ABOVE AND WITH ABOVE CEILING CONDITIONS ON THIS LEVEL.
- 14 FLOOR SINK SET TO SERVE THIS LEVEL.
- 15 PIPING IN EACH ROOM TO BE RUN AS HIGH AS POSSIBLE TO AVOID CONFLICTS. COORDINATE INSTALLATION AND ROUTING WITH OTHER TRADES PRIOR TO ROUGH-IN.
- 16 2" SANITARY WASTE AND 2" SANITARY VENT RISERS TO SERVE ELECTRIC WATER COOLERS ON EACH LEVEL. REFER TO DRAWING P0401 FOR WASTE AND VENT RISERS.
- 17 3" SANITARY WASTE AND 2" VENT RISERS TO SERVE MOP BASINS ON LEVELS 1 AND 3 AND COUNTERTOP SINK ON LEVEL 2. REFER TO DRAWING P0401 FOR WASTE AND VENT RISER.
- 18 2" VENT UP FROM LEVEL 0. REFER TO DRAWING P0011.
- 19 3" WASTE DOWN TO LEVEL 0. REFER TO DRAWING P0011 FOR CONTINUATION.
- 20 2" WASTE DOWN TO LEVEL 0. REFER TO DRAWING P0011 FOR CONTINUATION.
- 21 2" DISCHARGE FROM ELEVATOR SUMP PUMP. EXTEND TO ABOVE THE CEILING OF LEVEL 1 TO JANITOR CLOSET L75.
- 22 TERMINATE ELEVATOR SUMP PUMP DISCHARGE AT THE MOP BASIN WITH AN IN-DIRECT WASTE INTO THE BASIN.
- 23 REFER TO DRAWING P0402 DETAIL 2/ P0402, FOR PLUMBING RISER DIAGRAMS.
- 24 REFER TO DRAWING P0402 DETAIL 1/ P0402, FOR PLUMBING RISER DIAGRAMS.
- 25 REFER TO DRAWING P0404 SANITARY WASTE AND VENT RISER DIAGRAM 2-2.
- 26 REFER TO DRAWING P0406 SANITARY WASTE AND VENT RISER DIAGRAM 3-2.
- 27 REFER TO DRAWING P0406 SANITARY WASTE AND VENT RISER DIAGRAM 3-4.
- 28 REFER TO DRAWING P0408 SANITARY WASTE AND VENT RISER DIAGRAM 4-1.
- 29 REFER TO DRAWING P0408 SANITARY WASTE AND VENT RISER DIAGRAM 5-1.
- 30 REFER TO DRAWING P0404 SANITARY WASTE AND VENT RISER DIAGRAM 1-1.
- 31 TROUGH SAFETY PAN TO BE SUSPENDED BELOW SANITARY WASTE PIPING. EXTEND 1" DRAIN TO SANITARY FLOOD RECEPTOR. REFER TO PLUMBING DRAWING P0503, DETAIL 4.
- 32 2" VENT DOWN IN WALL TO SERVE FLOOR SINK IN WATER ENTRY ROOM.
- 33 2" VENT DOWN IN WALL TO SERVE FLOOR DRAIN IN LOADING DOCK.

CONFORMED SET 01 JUL 2016

3	ADDENDUM 2-4	24 MAY 2016
2	ADDENDUM 2-2	19 APR 2016
1	ADDENDUM 2-1	17 MAR 2016
-	ISSUED FOR CONSTRUCTION (BP2)	01 MAR 2016

No.	Description	Date
-----	-------------	------

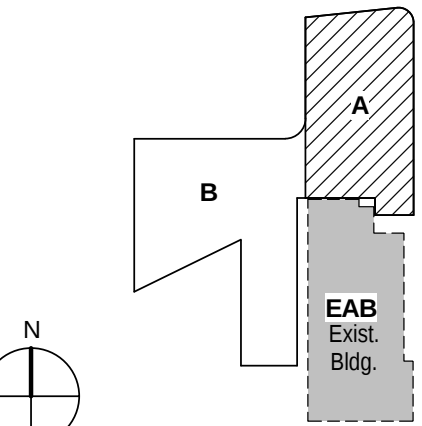

KEY PLAN

Drawing Title:

LEVEL 01 AREA A FLOOR
PLAN - PLUMBING WASTE
AND VENT

Project No.: 04561.01 Checked by:

P0111.A