
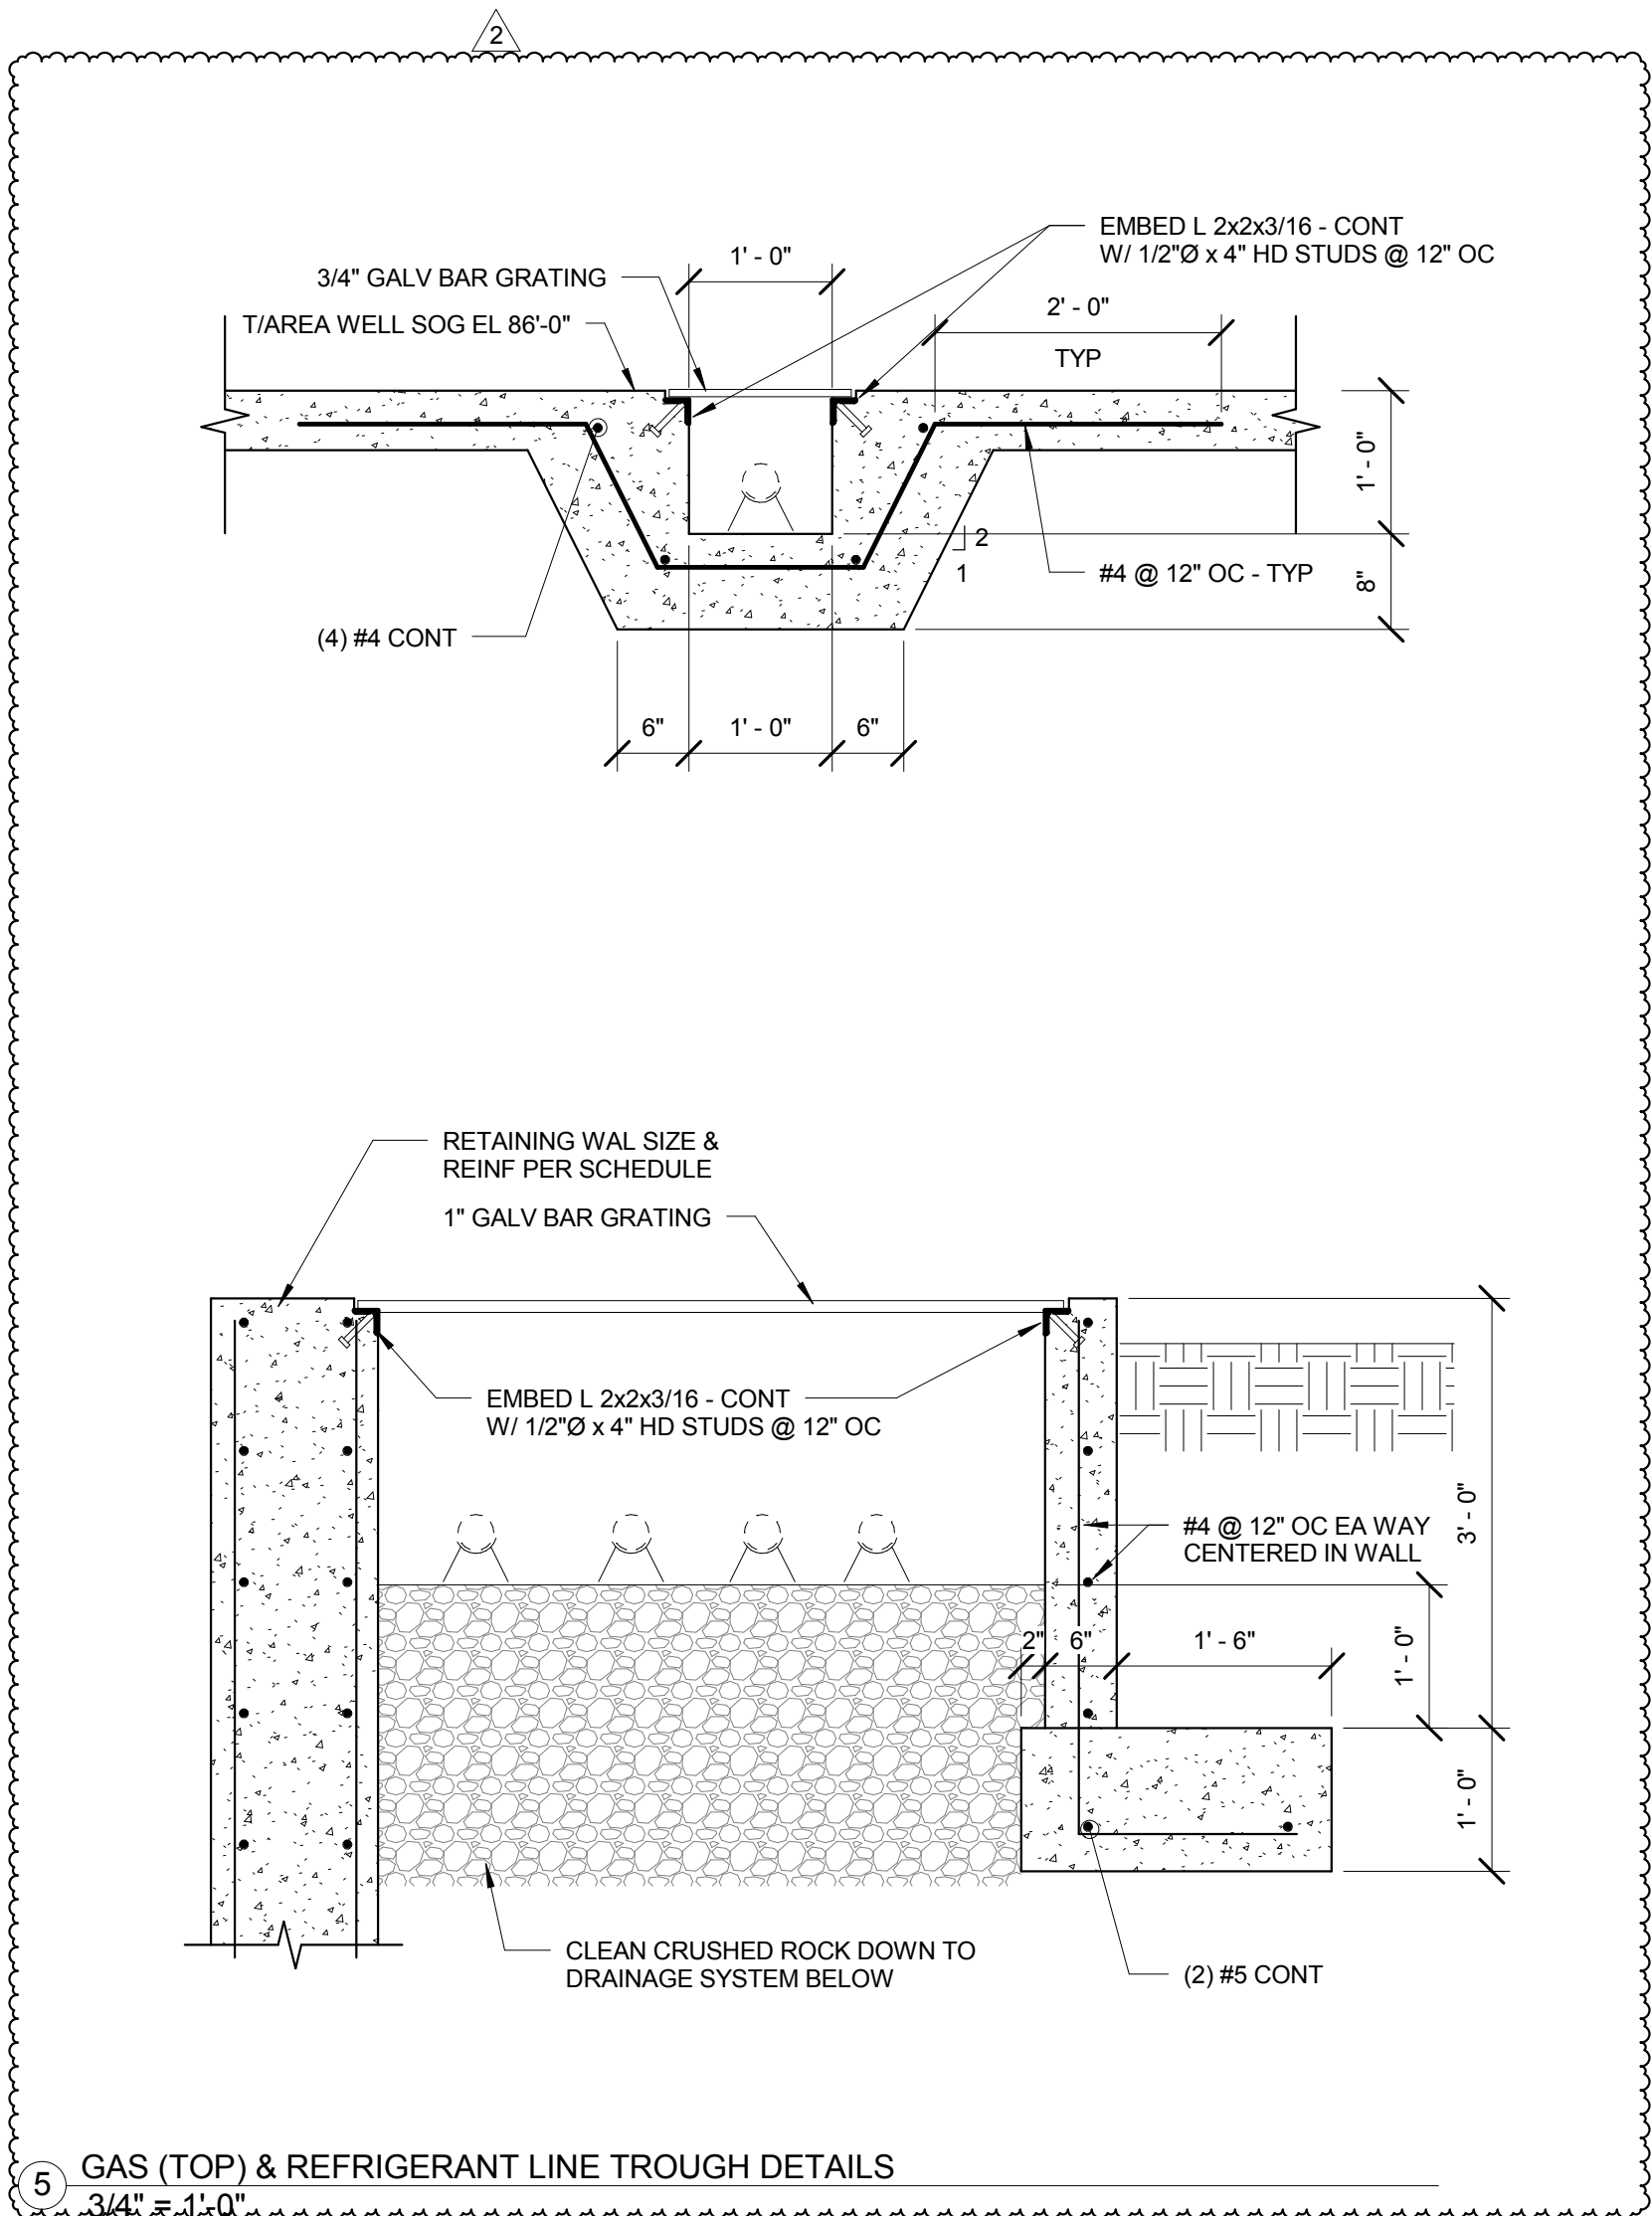


GRADE BEAM SCHEDULE									
MARK	SIZE		REINFORCING	SIDE BARS (EA FACE)	STIRRUP			REMARKS	
	WIDTH	DEPTH			SIZE	SPACING	TYPE		
GB1	24"	24"	(3) #6 	(1) #6	#4	@ 12" o.c., TYPICAL		HOOK BARS AT DISCONTINUOUS ENDS	
GB2	24"	24"	(3) #6 	N/A	#4	@ 12" o.c., TYPICAL		HOOK BARS AT DISCONTINUOUS ENDS	
GB3	30"	30"	(5) #9 	(2) #6	#4	@ 15" o.c., TYPICAL		HOOK BARS AT DISCONTINUOUS ENDS	
GB4	24"	30"	(4) #7 	(1) #6	#4	@ 15" o.c., TYPICAL		HOOK BARS AT DISCONTINUOUS ENDS	
GB5	24"	30"	(4) #7 	(2) #6	#4	@ 15" o.c., TYPICAL			
GB6	24"	30"	(5) #7 	(2) #6	#4	@ 15" o.c., TYPICAL			
GB7	32"	30"	(5) #8 	(2) #6	#4	@ 15" o.c., TYPICAL		HOOK BARS AT DISCONTINUOUS ENDS	
GB8	24"	30"	(4) #8 	(2) #6	#4	@ 15" o.c., TYPICAL		STIRRUPS @ 8" o.c. IN CANTILEVER	
GB9	30"	36"	(5) #7 	(2) #7	#4	@ 12" o.c., TYPICAL		HOOK BARS AT DISCONTINUOUS ENDS	
GB10	24"	30"	(6) #8 	(2) #6	#4	@ 15" o.c., TYPICAL			
GB11	32"	30"	(7) #8 	(2) #6	#4	@ 12" o.c., TYPICAL			
GB12	32"	36"	(7) #9 	(2) #6	#4	@ 12" o.c., TYPICAL		HOOK BARS AT DISCONTINUOUS ENDS	
GB13	36"	30"	(5) #8 	(2) #6	#4	@ 15" o.c., TYPICAL		STIRRUPS @ 8" o.c. IN CANTILEVER	

GRADE BEAM NOTES
1. PROVIDE STANDARD HOOKS FOR TOP & BOTTOM BARS AS INDICATED AT SUPPORTS.
2. PROVIDE CORNER BARS AT INTERSECTING GRADE BEAMS.

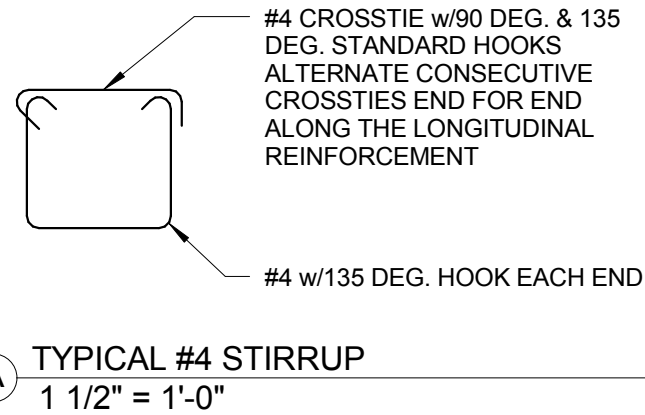


PIER CAP SCHEDULE				
MARK	PIER CAP SIZE	HORIZONTAL REINFORCING	VERTICAL REINFORCING	REMARKS
PC1	4'-6"x4'-6"x3'-0"	#5 U-BARS @ 10" o.c. EACH FACE	#6 U-BARS @ 10" o.c. T&B	
PC2	5'-0"x5'-0"x3'-0"	#5 U-BARS @ 10" o.c. EACH FACE	#6 U-BARS @ 10" o.c. T&B	
PC3	5'-6"x5'-6"x3'-0"	#5 U-BARS @ 10" o.c. EACH FACE	#6 U-BARS @ 10" o.c. T&B	
PC4	5'-0"x5'-0"x7'-0"	#5 U-BARS @ 10" o.c. EACH FACE	#6 U-BARS @ 10" o.c. T&B	
PC5	4'-6"x4'-6"x4'-6"	#5 U-BARS @ 10" o.c. EACH FACE	#6 U-BARS @ 10" o.c. T&B	
PC6	7'-0"x7'-0"x3'-0"	#5 U-BARS @ 10" o.c. EACH FACE	#6 U-BARS @ 10" o.c. T&B	

DRILLED PIER SCHEDULE				
MARK	PIER DIA.	REINFORCING	TIE SIZE & SPACING	SOCKET DEPTH
DP1	30"	7 - #8	#4 @ 16"	5'-0"
DP2	36"	8 - #8	#4 @ 16"	6'-0"
DP3	36"	8 - #8	#4 @ 16"	6'-0"
DP4	42"	10 - #8	#4 @ 16"	7'-0"
DP5	42"	10 - #8	#4 @ 16"	7'-0"

ESTIMATED BOTTOM OF DRILLED PIER ELEVATIONS - FOR BIDDING PURPOSES ONLY

LEVEL 0 DRILLED PIERS LOCATED ON AND NORTH OF GRID C.3 = 518'-0"
LEVEL 0 DRILLED PIERS LOCATED SOUTH OF GRID C.3 = 515'-0"
LEVEL 1 DRILLED PIERS LOCATED NORTH OF GRID E = 517'-0"
LEVEL 1 DRILLED PIERS LOCATED ON GRIDS A & B = 522'-0"
LEVEL 1 DRILLED PIERS LOCATED FROM GRID V TO Z ON GRID 3 = 508'-0"
LEVEL 1 DRILLED PIERS LOCATED FROM GRID V TO Z ON GRID 4.5 = 521'-0"
LEVEL 1 DRILLED PIERS LOCATED IN WEST WING = 517'-0"

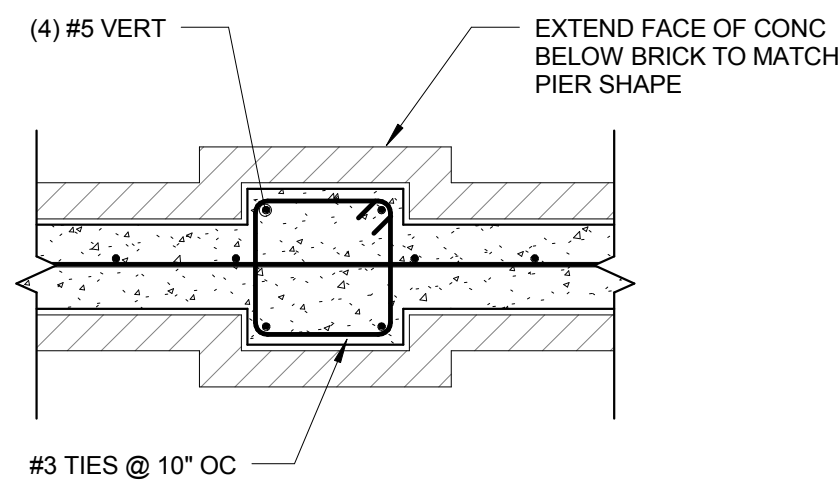

@ PIER LOCATIONS

