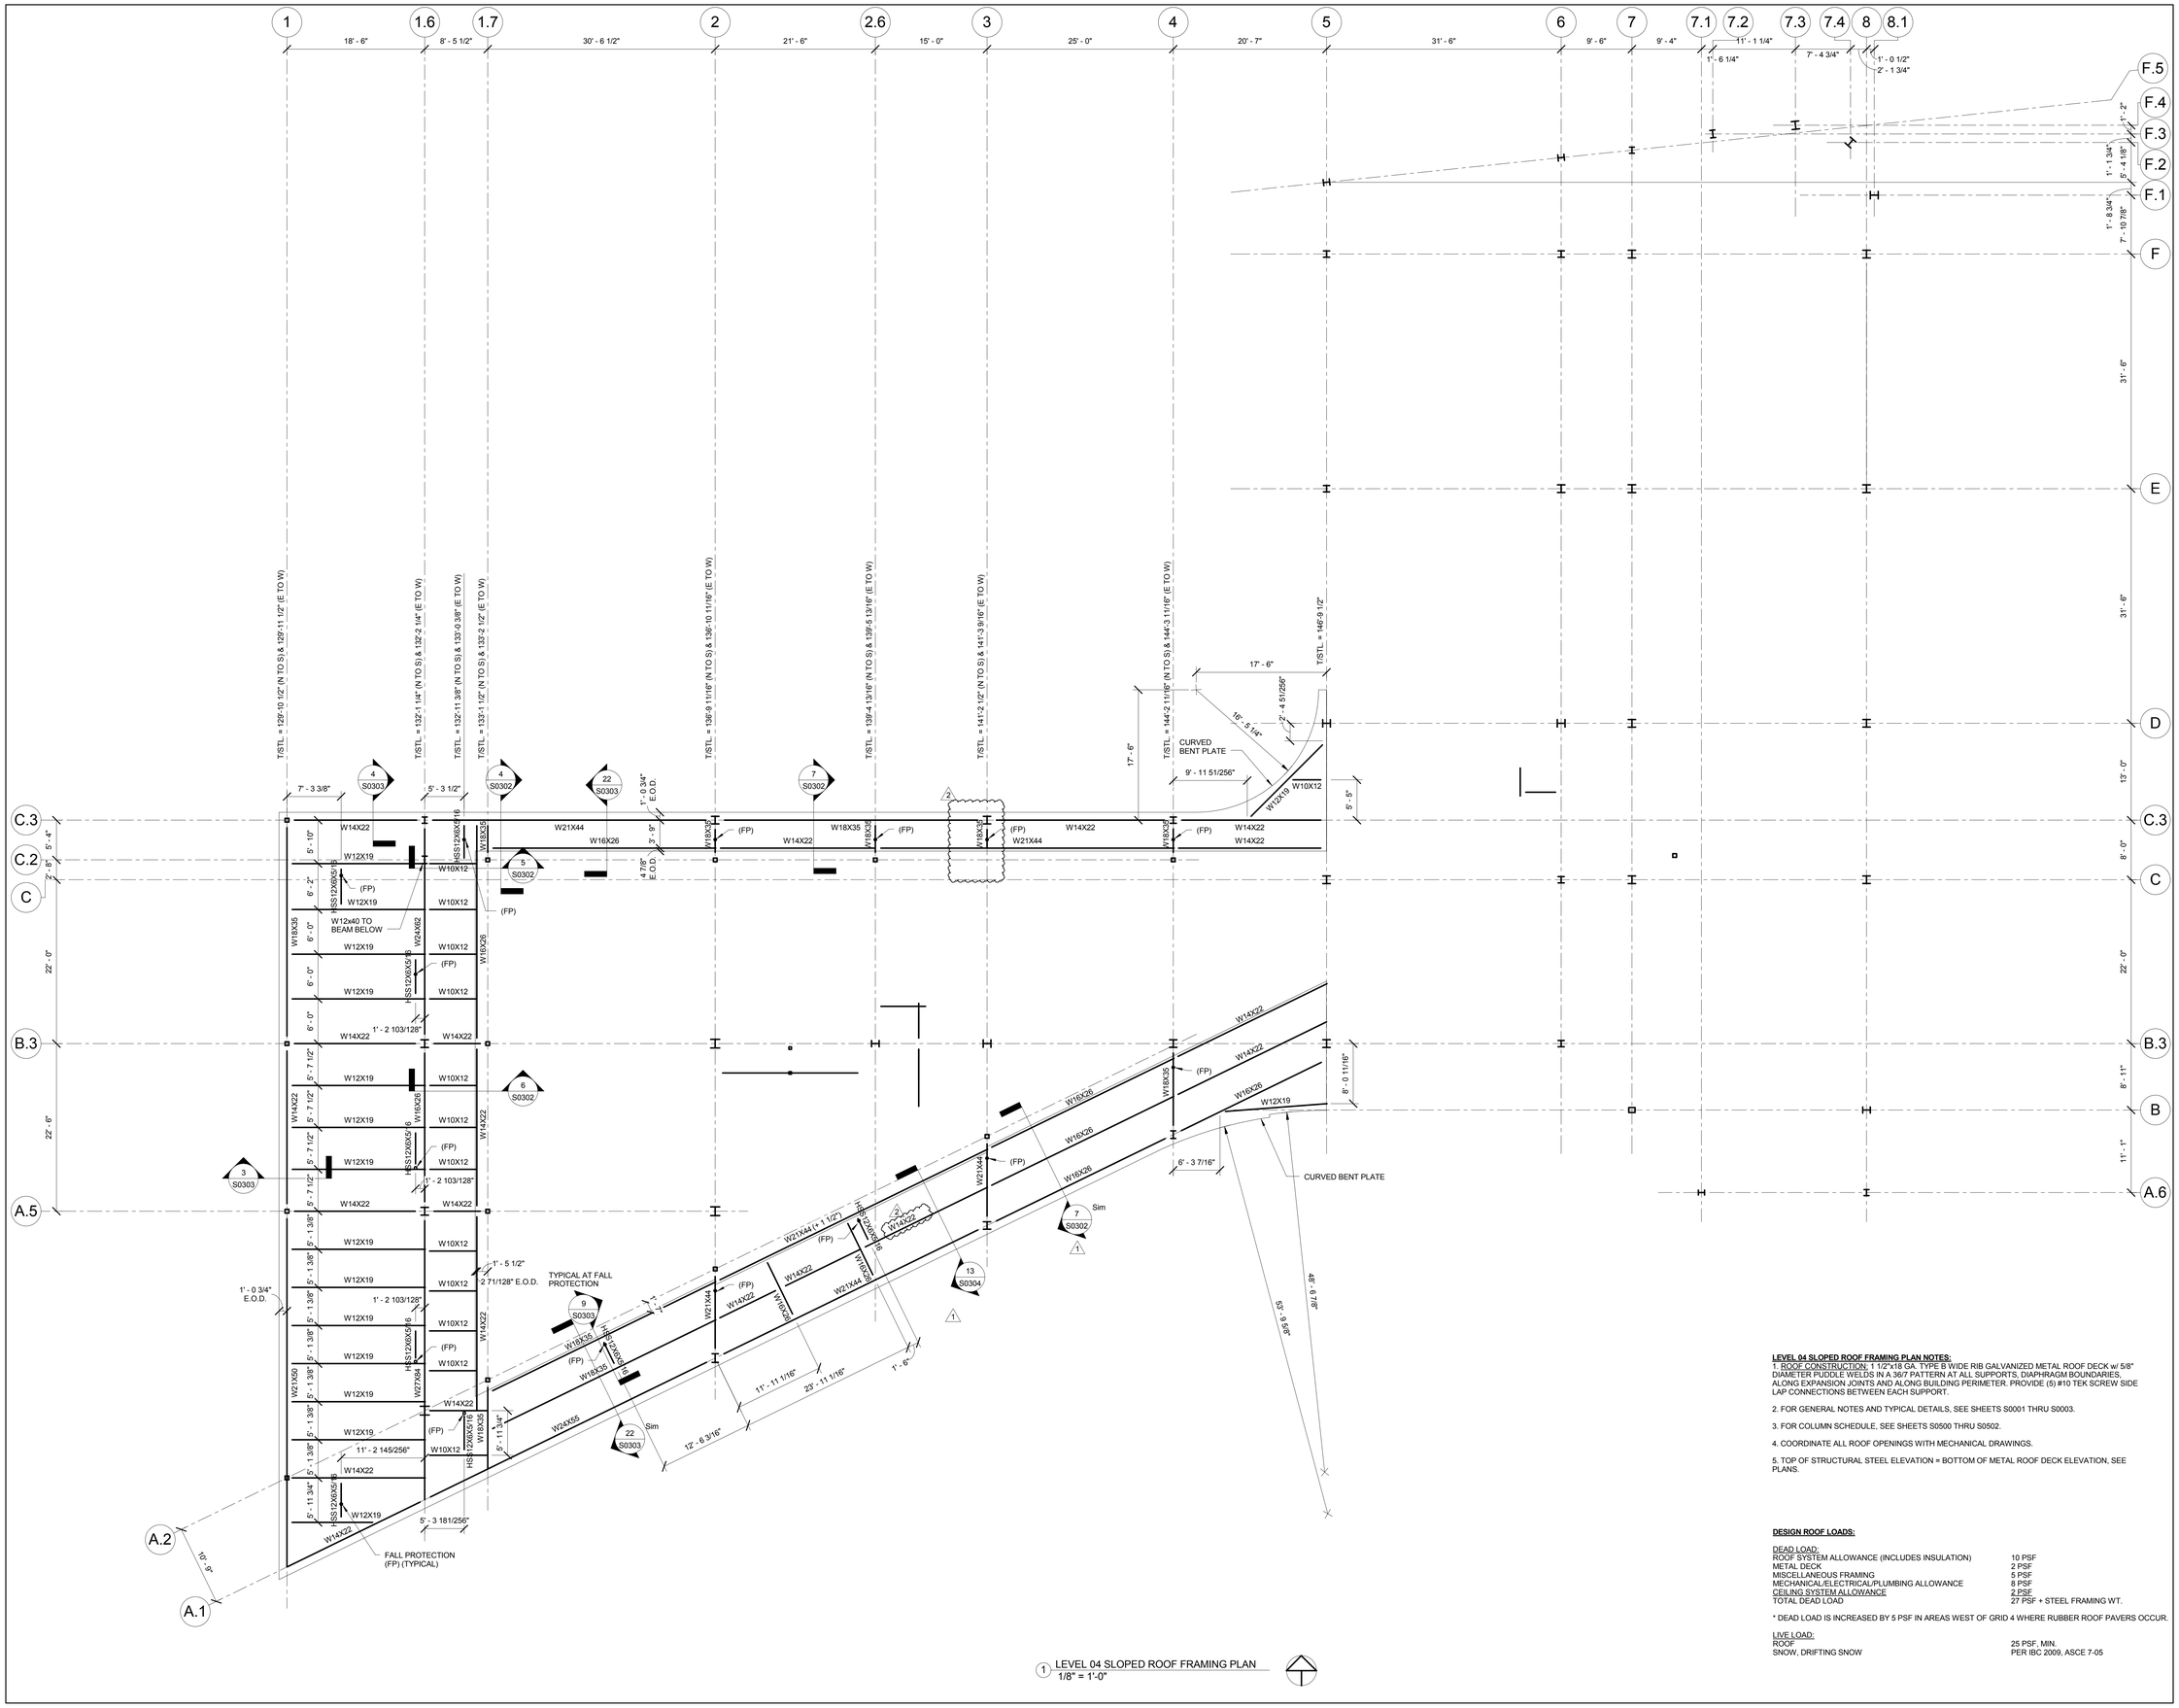
1
1.6
1.7
2
2.6
3
4
5
6
7
7.1
7.2
7.3
7.4
8
8.1
18' - 6"
8' - 5 1/2"
30' - 6 1/2"
21' - 6"
15' - 0"
25' - 0"
20' - 7"
31' - 6"
9' - 6"
9' - 4"
11' - 1 1/4"
1' - 6 1/4"
7' - 4 3/4"
1' - 0 1/2"
2' - 1 3/4"
F.5
F.4
F.3
F.2
F.1
F
E
D
C.3
C.2
C
B.3
B
A.6
A.5
A.2
A.1
31' - 6"
31' - 6"
13' - 0"
8' - 0"
22' - 0"
8' - 11"
11' - 1"
22' - 0"
22' - 6"
10' - 0"
T/STL = 129'-10 1/2" (N TO S) & 129'-11 1/2" (E TO W)
T/STL = 132'-1 1/4" (N TO S) & 132'-2 1/4" (E TO W)
T/STL = 132'-11 3/8" (N TO S) & 133'-0 3/8" (E TO W)
T/STL = 133'-1 1/2" (N TO S) & 133'-2 1/2" (E TO W)
T/STL = 136'-9 11/16" (N TO S) & 136'-10 11/16" (E TO W)
T/STL = 139'-4 13/16" (N TO S) & 139'-5 13/16" (E TO W)
T/STL = 141'-2 1/2" (N TO S) & 141'-3 9/16" (E TO W)
T/STL = 144'-2 11/16" (N TO S) & 144'-3 11/16" (E TO W)
T/STL = 146'-9 1/2"
17' - 6"
16' - 5 1/4"
2' - 4 51/256"
CURVED BENT PLATE
9' - 11 51/256"
W10X12
W10X19
5' - 5"
8' - 0 11/16"
6' - 3 7/16"
CURVED BENT PLATE
52' - 9 5/8"
48' - 9 7/8"
7' - 3 3/8"
5' - 3 1/2"
1' - 0 3/4" E.O.D.
3' - 8"
4 7/8" E.O.D.
W14X22
W12X19
W21X44
W16X26
W18X35
W18X40
W18X35
W18X35
W18X35