


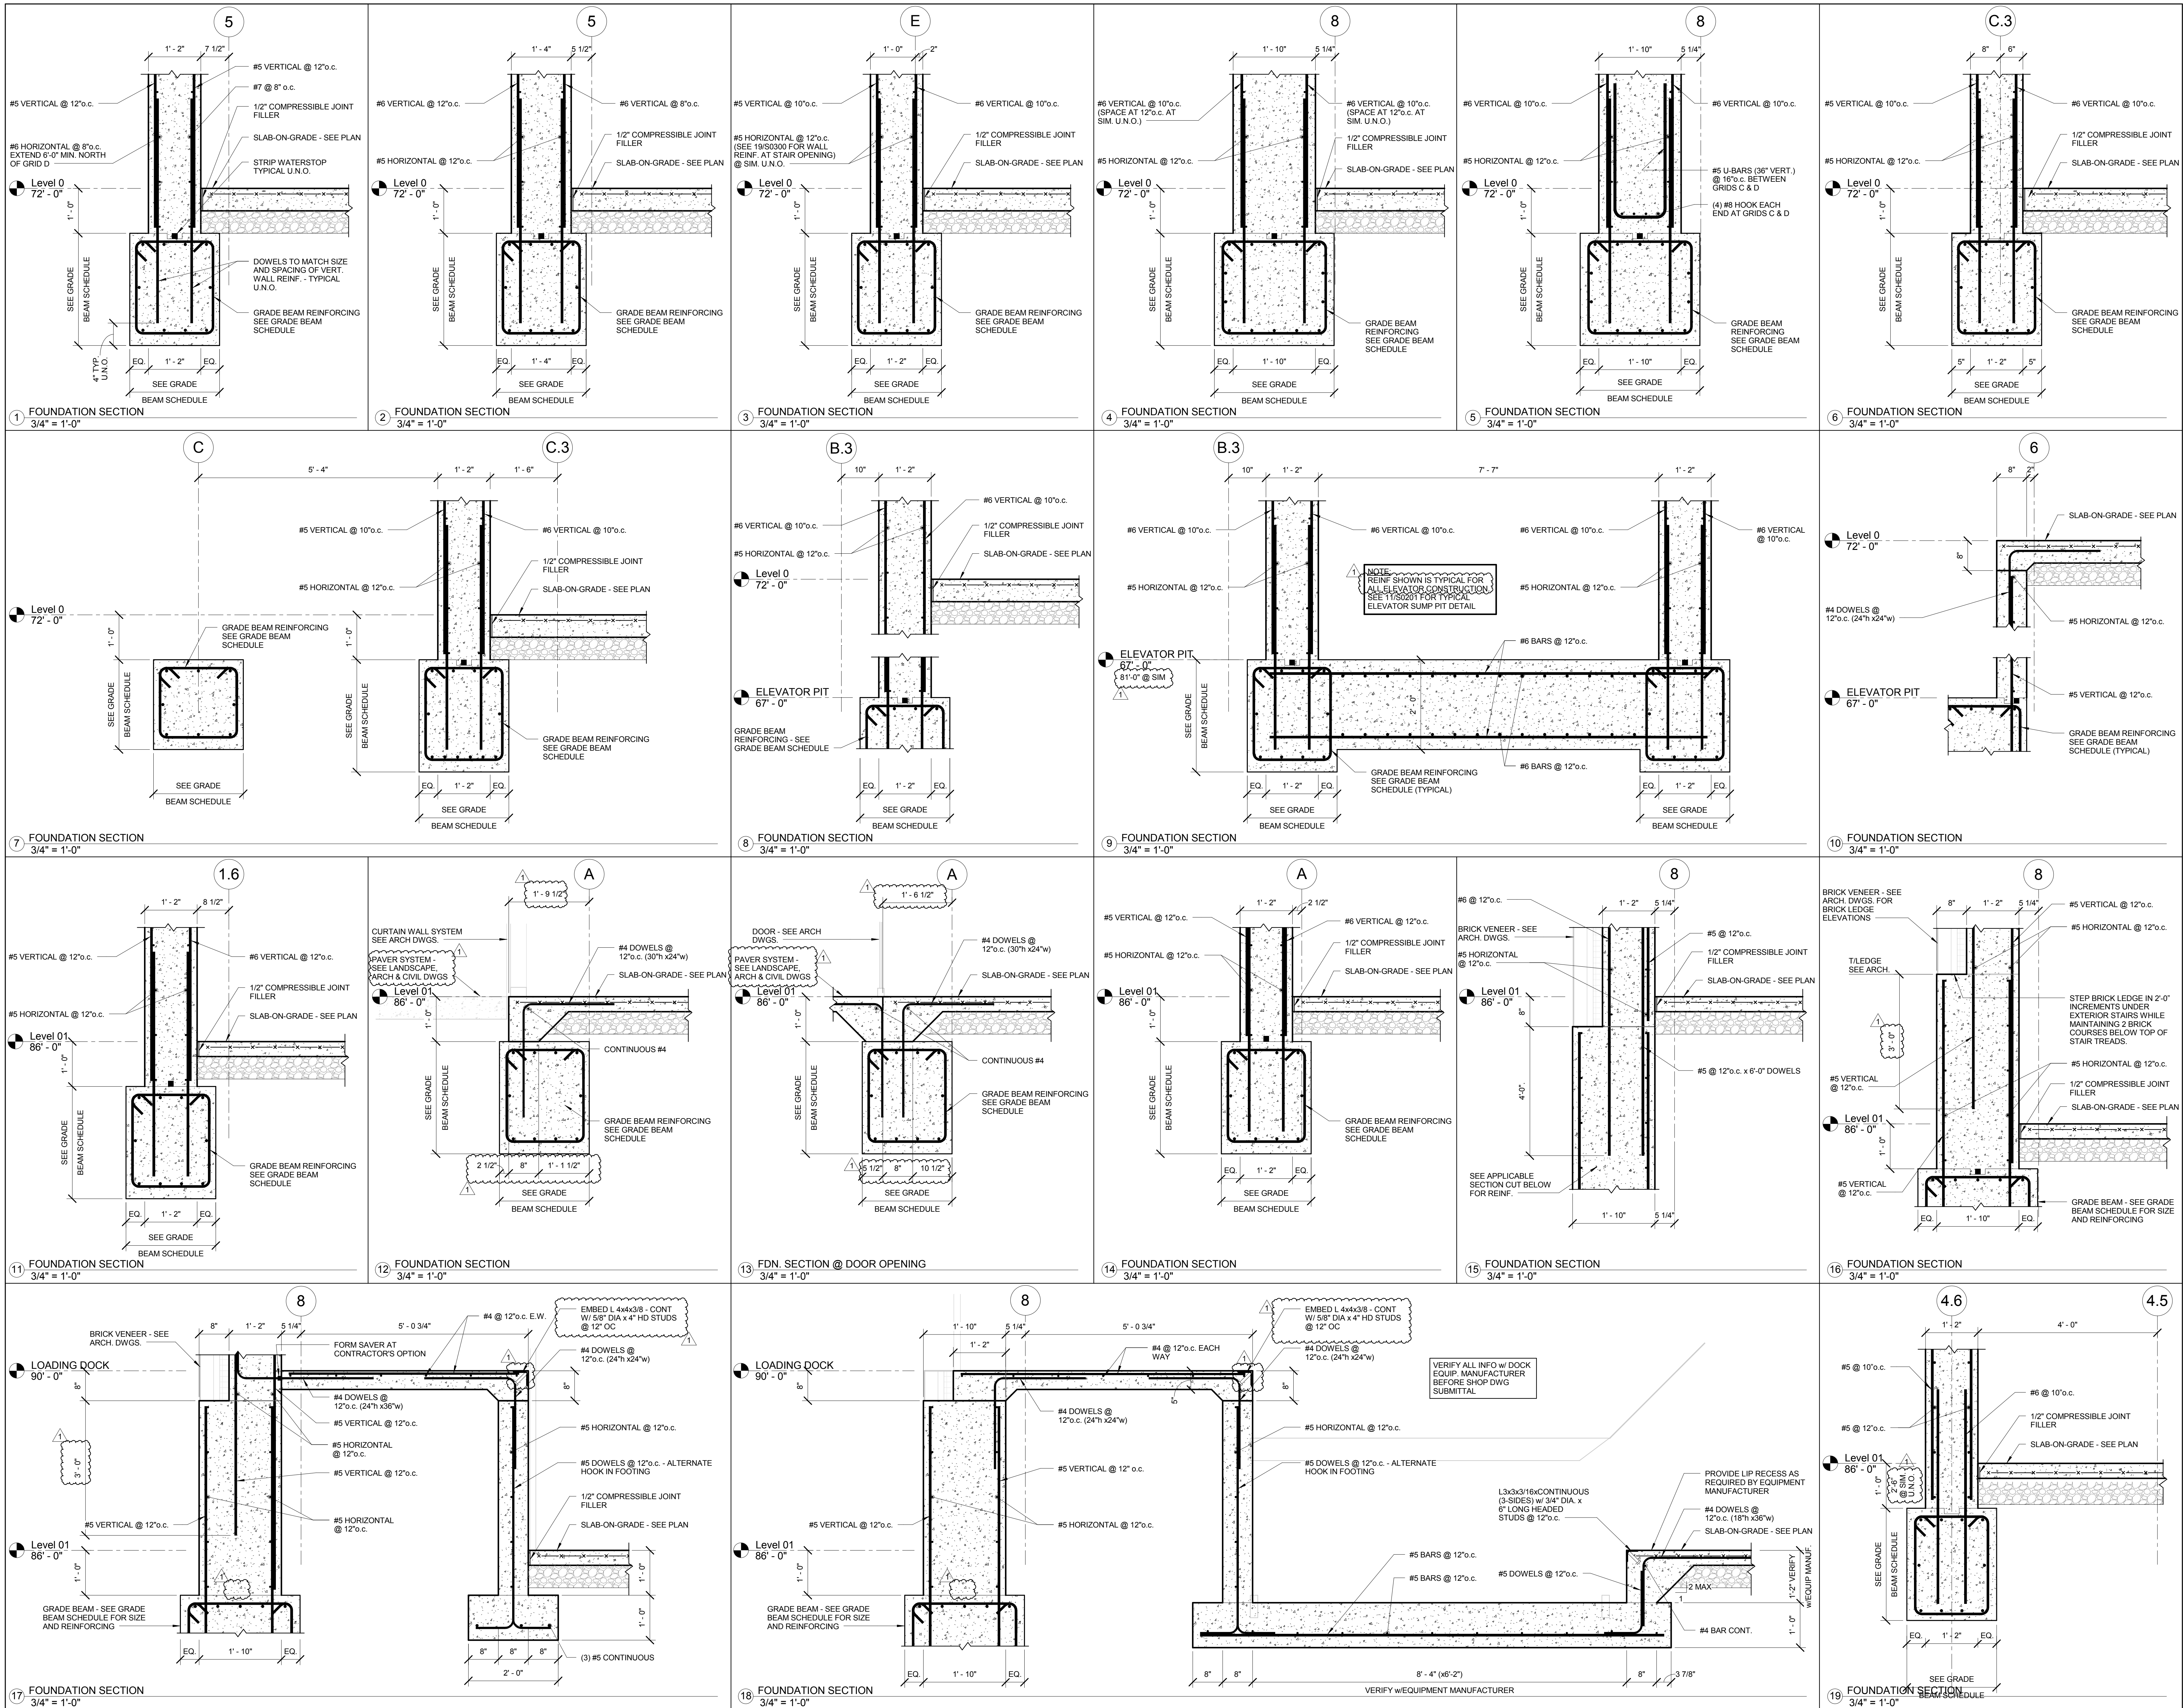

CONFORMED SET 01 JUL 2016

1. ADDENDUM 1-1 29 JAN 2016
- ISSUED FOR CONSTRUCTION (BPT) 15 JAN 2016
No. Description Date

Drawing Title:

**FOUNDATION SECTIONS
AND DETAILS**

Project No.: 04561.01 Checked by:

S0200