


© Cannon Design 2015
All rights reserved. No part of this document may be reproduced or transmitted in any form or by any means, electronic or mechanical, including photocopying and recording, or by any information storage or retrieval system, without written authorization by The Cannon Corporation.
4/18/2016 1:45:09 PM

1 LEVEL 01 - AREA B
1/8" = 1'-0"

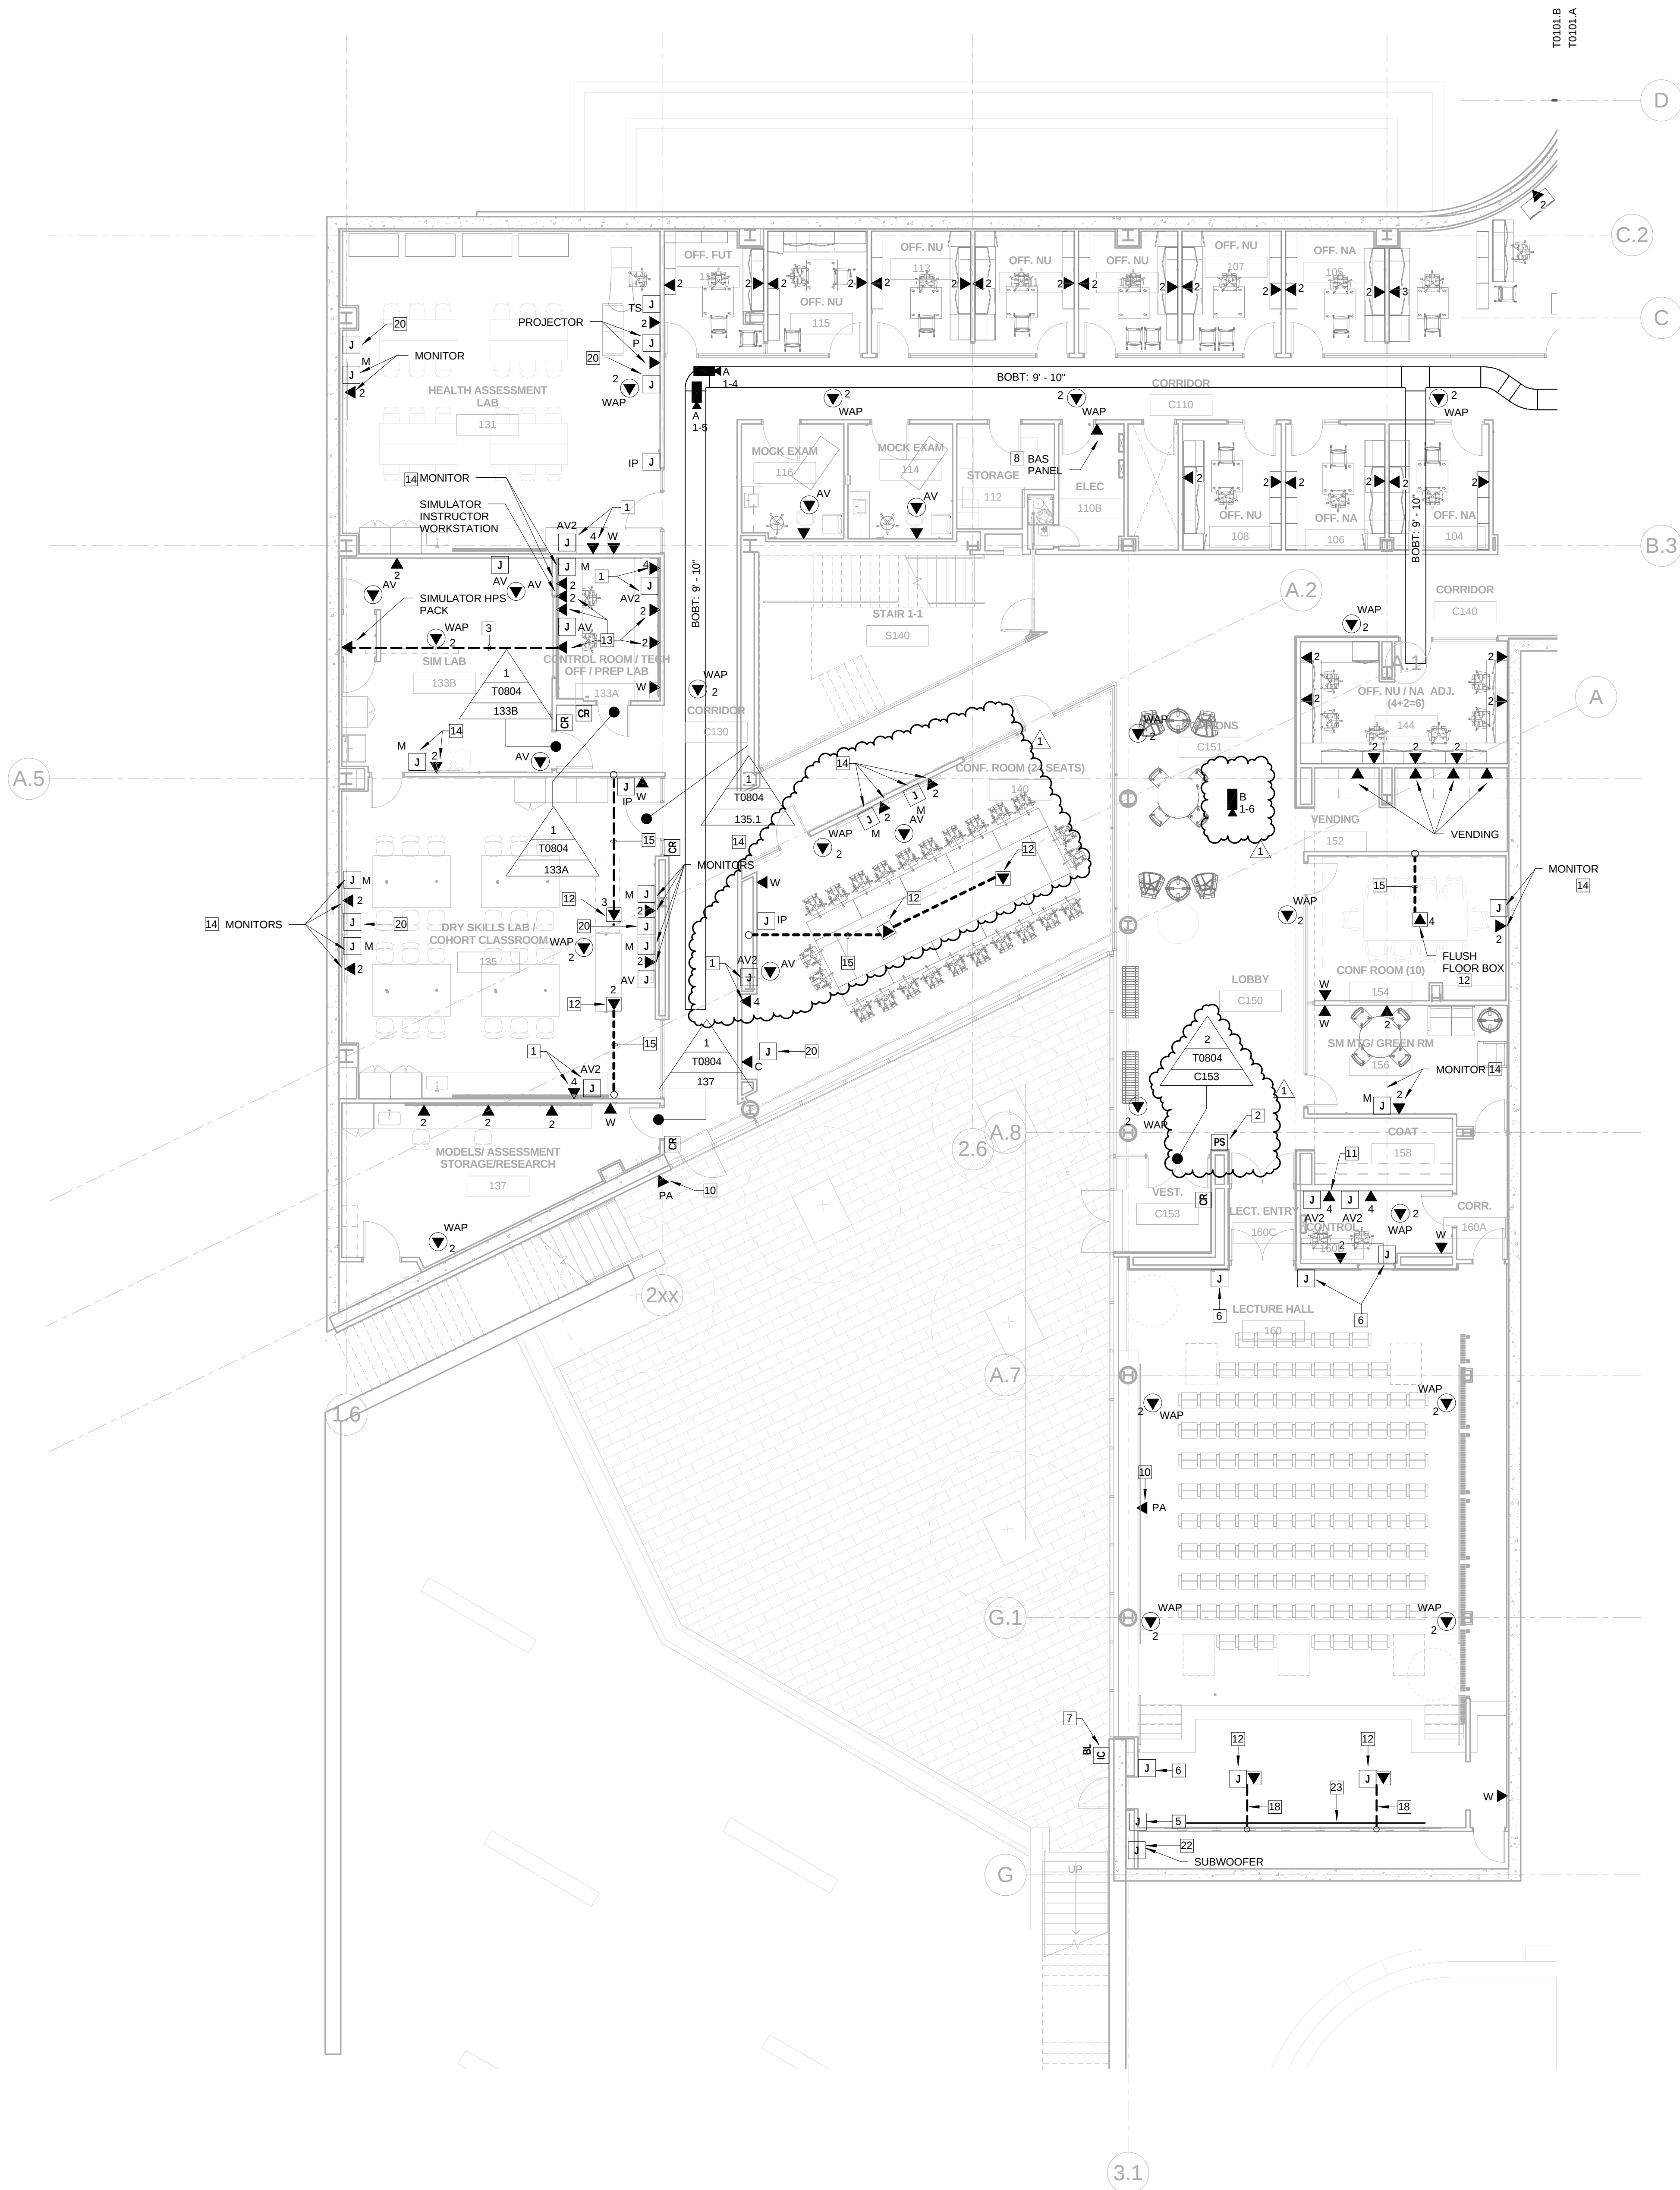

GENERAL NOTES:

THIS SHEET ONLY

1. DATA OUTLETS IN OFFICES SHALL BE LOCATED ADJACENT TO AND AT THE SAME MOUNTING HEIGHT AS THE POWER RECEPTACLES, COORDINATE LOCATION WITH THE ELECTRICAL CONTRACTOR.
2. TELECOMMUNICATION CABLEING ON THIS SHEET SHALL BE RUN TO LEVEL 01 DATA ROOM 100B.
3. FLOOR BOXES ARE SPECIFIED ON THE ELECTRICAL DRAWINGS UNLESS OTHERWISE NOTED.

KEYED NOTES:

THIS SHEET ONLY

1. CABINET MOUNTED AV EQUIPMENT (OFVI), COORDINATE DEVICE LOCATION WITH CABINET AND AV EQUIPMENT INSTALLER.
2. LOCAL DOOR LOCK POWER SUPPLY.
3. PROVIDE (1) CAT 6A CABLE IN 1" PVC CONDUIT IN SLAB. COORDINATE TERMINATION REQUIREMENTS WITH SIMULATOR EQUIPMENT INSTALLER.
4. PROVIDE A FLUSH MOUNTED WALL BOX (HUBBELL HBL260) WITH A SINGLE GANG RING FOR AV CABLES. STUB A 2" CONDUIT INTO ACCESSIBLE CEILING SPACE.
5. PROVIDE A 4-11/16" SQUARE X 2-1/8" DEEP BOX WITH A SINGLE RING (VERTICAL) AND A 1" CONDUIT STUBBED INTO ACCESSIBLE CEILING SPACE FOR THE AC SYSTEM TOUCH SCREEN CONTROLLER.
6. PROVIDE A 4-11/16" SQUARE X 2-1/8" DEEP BOX WITH 2-GANG RING (VERTICAL) AND (1) 1 1/2" CONDUIT STUBBED INTO ACCESSIBLE CEILING.
7. WALL MOUNT BLUE LIGHT EMERGENCY INTERCOM STATION WITH WIRELESS RAPID COMMUNICATION. SHALL BE FURNISHED BY OWNER AND INSTALLED BY ELECTRICAL CONTRACTOR. STATION SHALL BE MOUNTED SO INTERCOM IS 48" ABOVE GRADE. SEE ELECTRICAL DRAWINGS FOR POWER REQUIREMENTS.
8. CONFIRM EXACT LOCATION AND TERMINATION REQUIREMENTS WITH MECHANICAL CONTRACTOR PRIOR TO INSTALLATION.
9. NOT USED
10. COORDINATE HEIGHT AND LOCATION WITH PA SPEAKER INSTALLER.
11. PROVIDE A 24" W X 4" H VERTICAL WALL MOUNTED BASKET TRAY FROM THE AV EQUIPMENT RACK UP INTO THE ACCESSIBLE CEILING SPACE FOR AV CABLEING. COORDINATE EXACT LOCATION WITH AV EQUIPMENT INSTALLER.
12. SEE ELECTRICAL DRAWINGS FOR FLOOR BOX INFORMATION.
13. INSTALL COMMUNICATION OUTLET IN THE COMMUNICATIONS SIDE OF THE 2-CHANNEL RACEWAY. SEE ELECTRICAL DRAWINGS FOR RACEWAY INFORMATION.
14. CONFIRM EXACT LOCATION OF DATA OUTLET AND MONITOR BOX WITH AV VENDOR PRIOR TO INSTALLATION.
15. PROVIDE (2) 1" CONDUITS IN SLAB FOR DATA AND AV CABLES. STUB CONDUIT UP THROUGH WALL CAVITY TO ACCESSIBLE CEILING SPACE.
16. NOT USED
17. NOT USED
18. PROVIDE (1) 1 1/2" CONDUIT FOR AV AND (1) 1" CONDUIT FOR DATA IN SLAB. STUB UP INTO ACCESSIBLE CEILING SPACE.
19. NOT USED
20. PROVIDE A 4-11/16" SQUARE X 2-1/8" DEEP WALL MOUNTED BOX FOR PTZ CAMERA WITH A 1" CONDUIT WITH PULL STRING STUBBED INTO ACCESSIBLE CEILING SPACE. COORDINATE MOUNTING HEIGHT AND LOCATION WITH PTZ CAMERA INSTALLER.
21. NOT USED
22. PROVIDE A 2-GANG J-BOX UNDER THE STAGE WITH A 1" CONDUIT STUBBED INTO ACCESSIBLE CEILING SPACE ABOVE THE CONTROL ROOM FOR THE SUBWOOFER.
23. PROVIDE (8) HUBBELL LARGE CAPACITY WALL BOXES (HBL260) WITH (1) 1 1/2" CONDUIT EACH STUBBED INTO ACCESSIBLE CEILING SPACE IN THE AV EQUIPMENT ROOM FOR THE VIDEO WALL MONITORS. COORDINATE BOX MOUNTING HEIGHT AND LOCATION WITH VIDEO WALL INSTALLER.



Webster University
Interdisciplinary Science
Building

CANNONDESIGN

1100 Clark Avenue
St. Louis, Missouri 63102
T: 314.241.6250
F: 314.241.2570

William Tao & Associates, Inc.
MEP/FP Engineer
7955 Manchester Road, Suite 125
St. Louis, MO 63143
314.884.7600

David Mason & Associates, Inc.
Structural & Civil Engineer
800 South Vandeventer Avenue
St. Louis, MO 63110
314.534.1053

Faith Group
Technology
3101 S. Hanley Rd., Suite 100
St. Louis, MO 63143
314.991.2229

Kuhmann Leavitt, Inc.
Environmental Graphics & Signage
7400 Pershing Ave.
St. Louis, MO 63130
314.725.6616

KWA Architects
Architecture
9721 Litzinger Road
St. Louis, MO 63124
314.962.2560


Spellman Brady & Company
Interior Designer
8251 Maryland Avenue, Suite 300
St. Louis, MO 63105
314.862.0070

SWT Design
Landscape Architect
7722 Big Bend Blvd
St. Louis, MO 63119
314.644.5700

Webb Engineering Services, Inc.
Planning & Fire Protection
1400 S. 3rd Street, Suite 201
St. Louis, MO 63104
314.588.0600

CONFORMED SET 01 JUL 2016

1 ADDENDUM 2-2 19 APR 2016
ISSUED FOR CONSTRUCTION (BP2) 01 MAR 2016

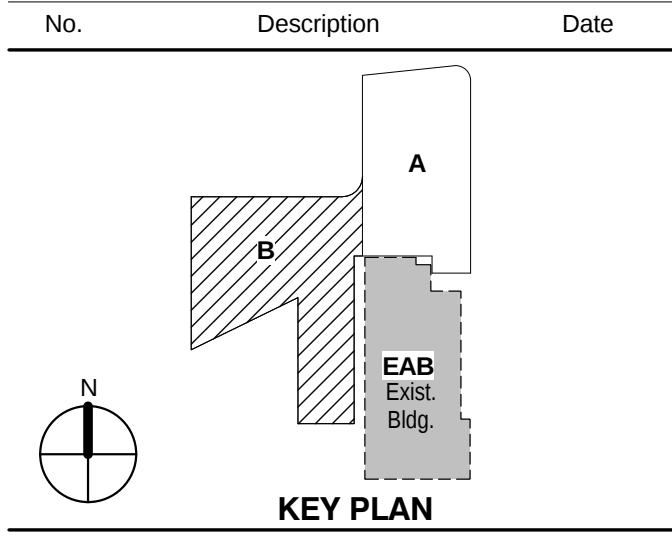

KEY PLAN

**LEVEL 01 FLOOR PLAN -
AREA B**

Project No.: 04561.01 Checked by:

T0101.B