



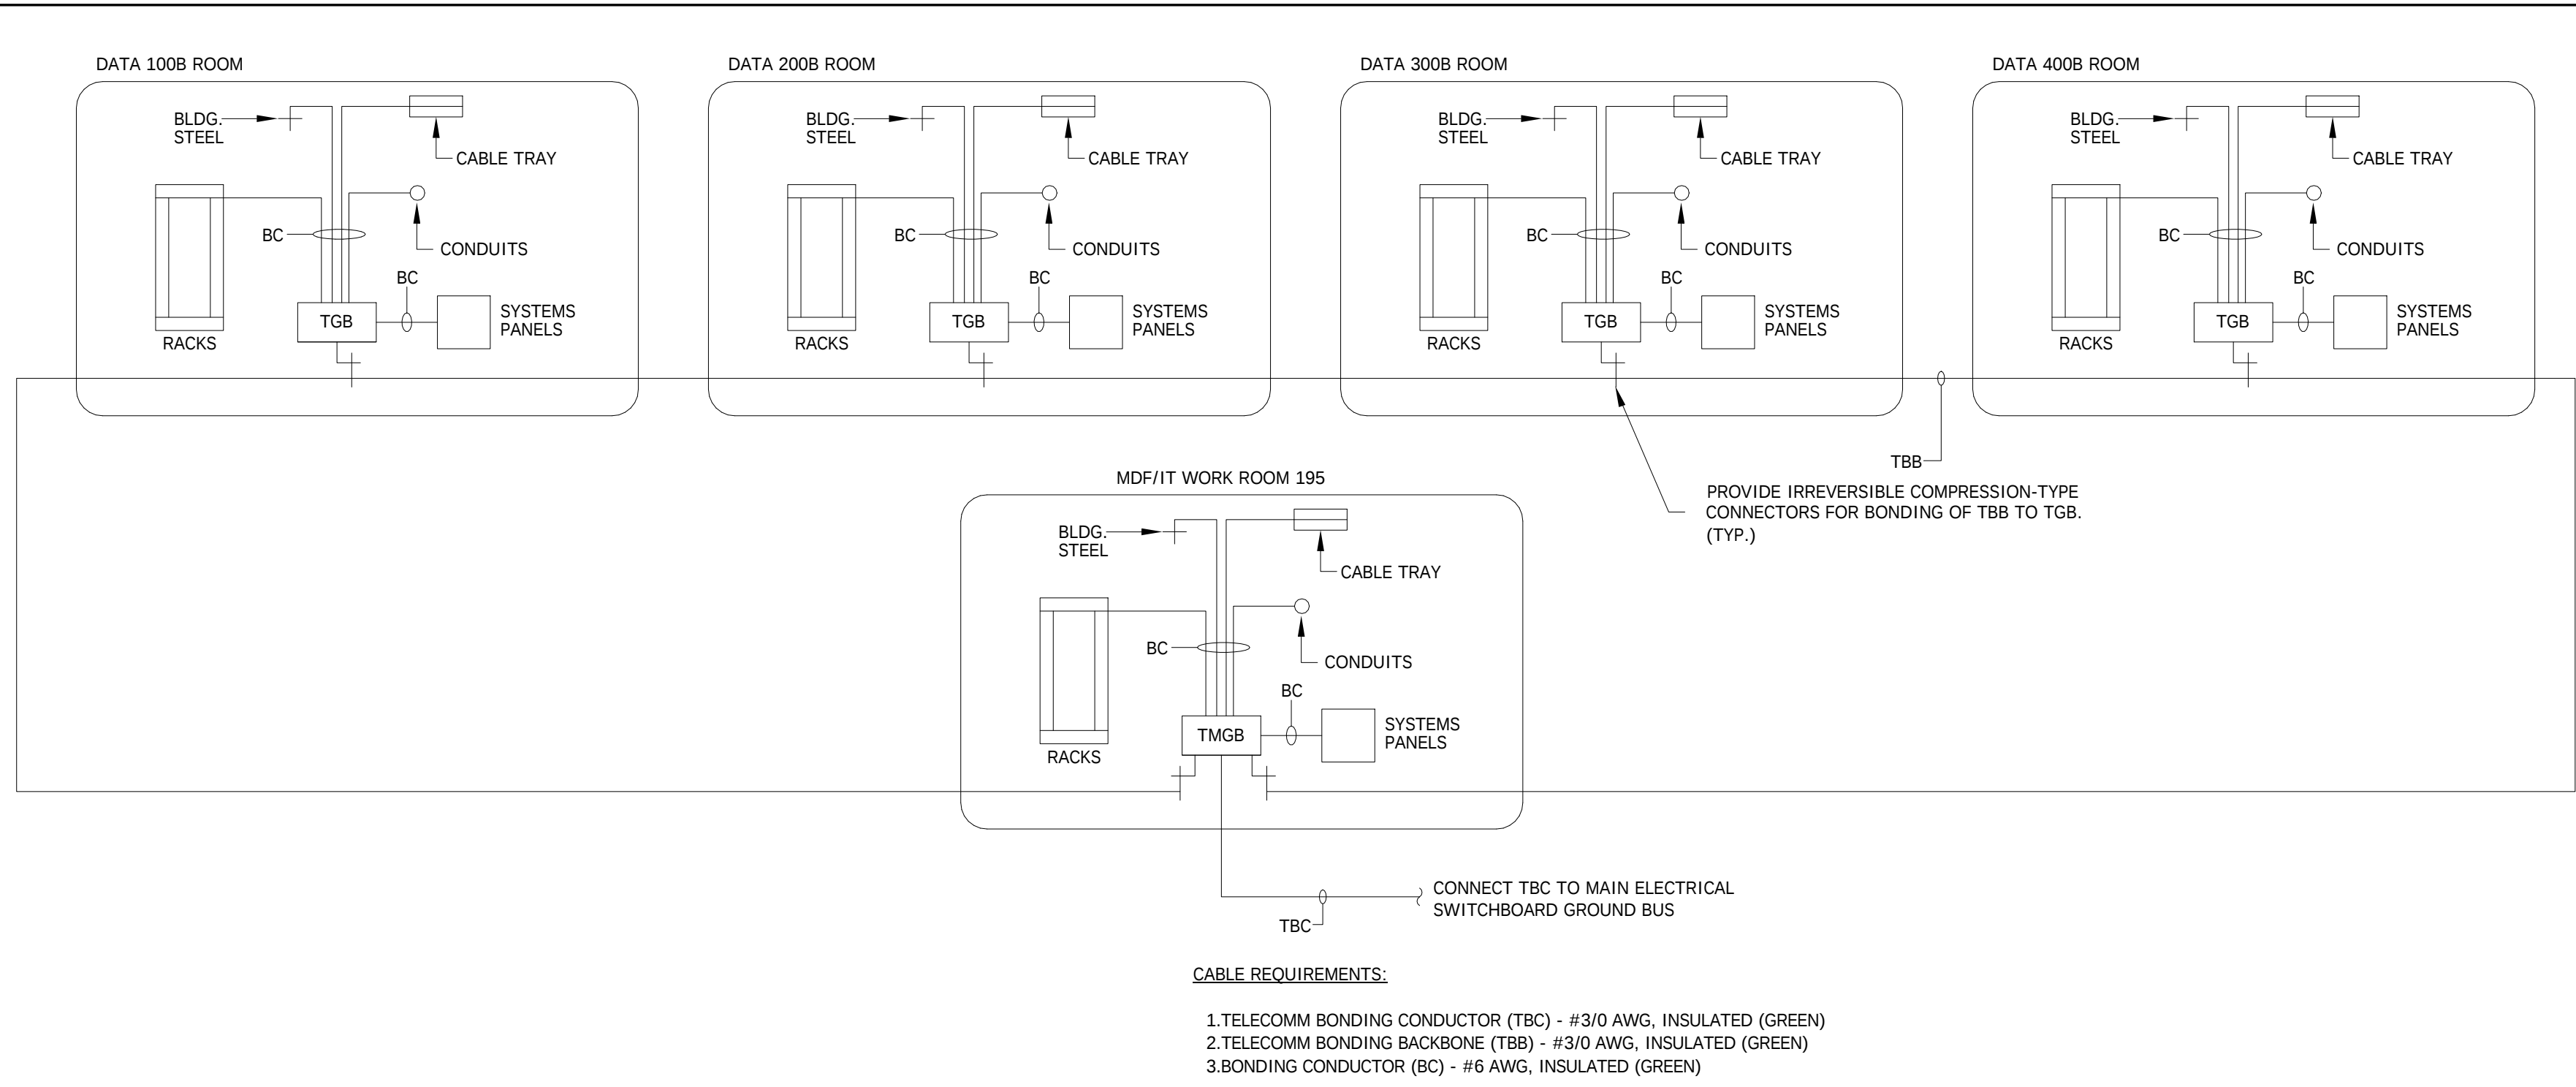


1 COMMUNICATION GROUNDING SYSTEM
SCALE: NOT TO SCALE

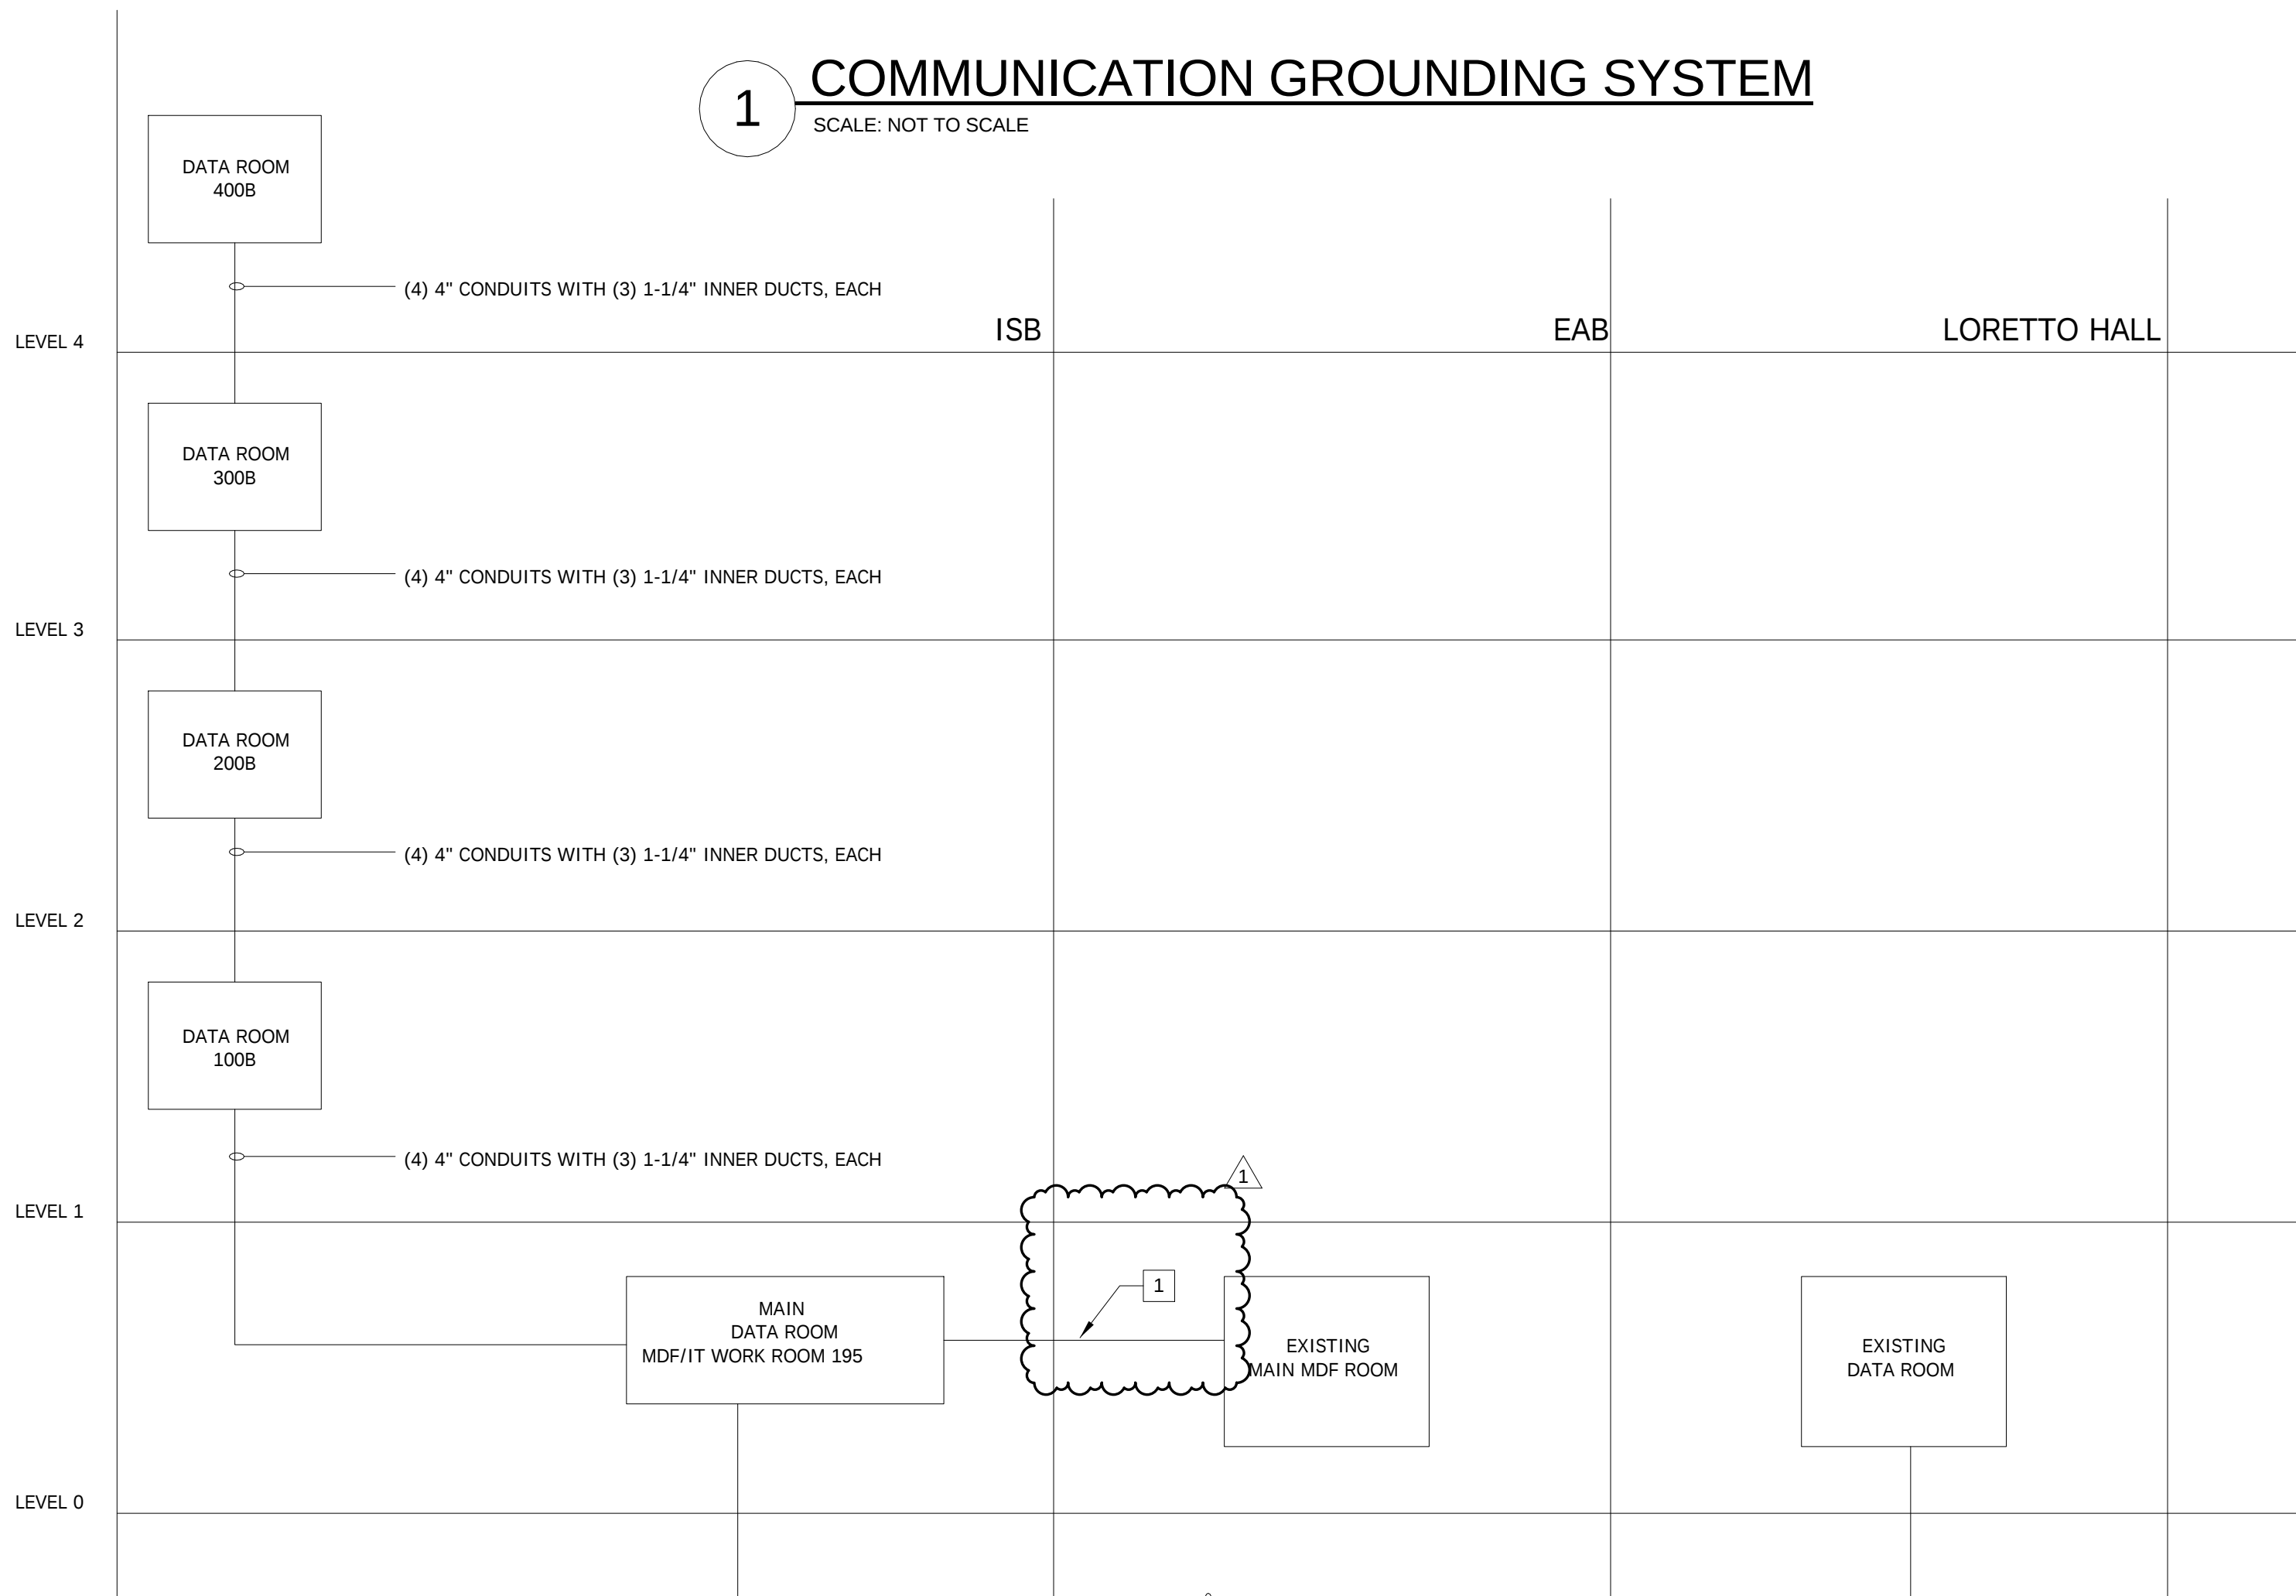

KEYED NOTES

- 1 CABLES SHALL BE ROUTED CONCEALED THROUGH THE EAB AND ISB IN CABLE TRAY WHERE CABLE TRAY EXISTS AND AS SHOWN ON THE ISB DRAWINGS, BETWEEN CABLE TRAY, INSTALL IN J-HOOKS.


2 TELECOM CONDUIT RISER DIAGRAM
SCALE: NOT TO SCALE

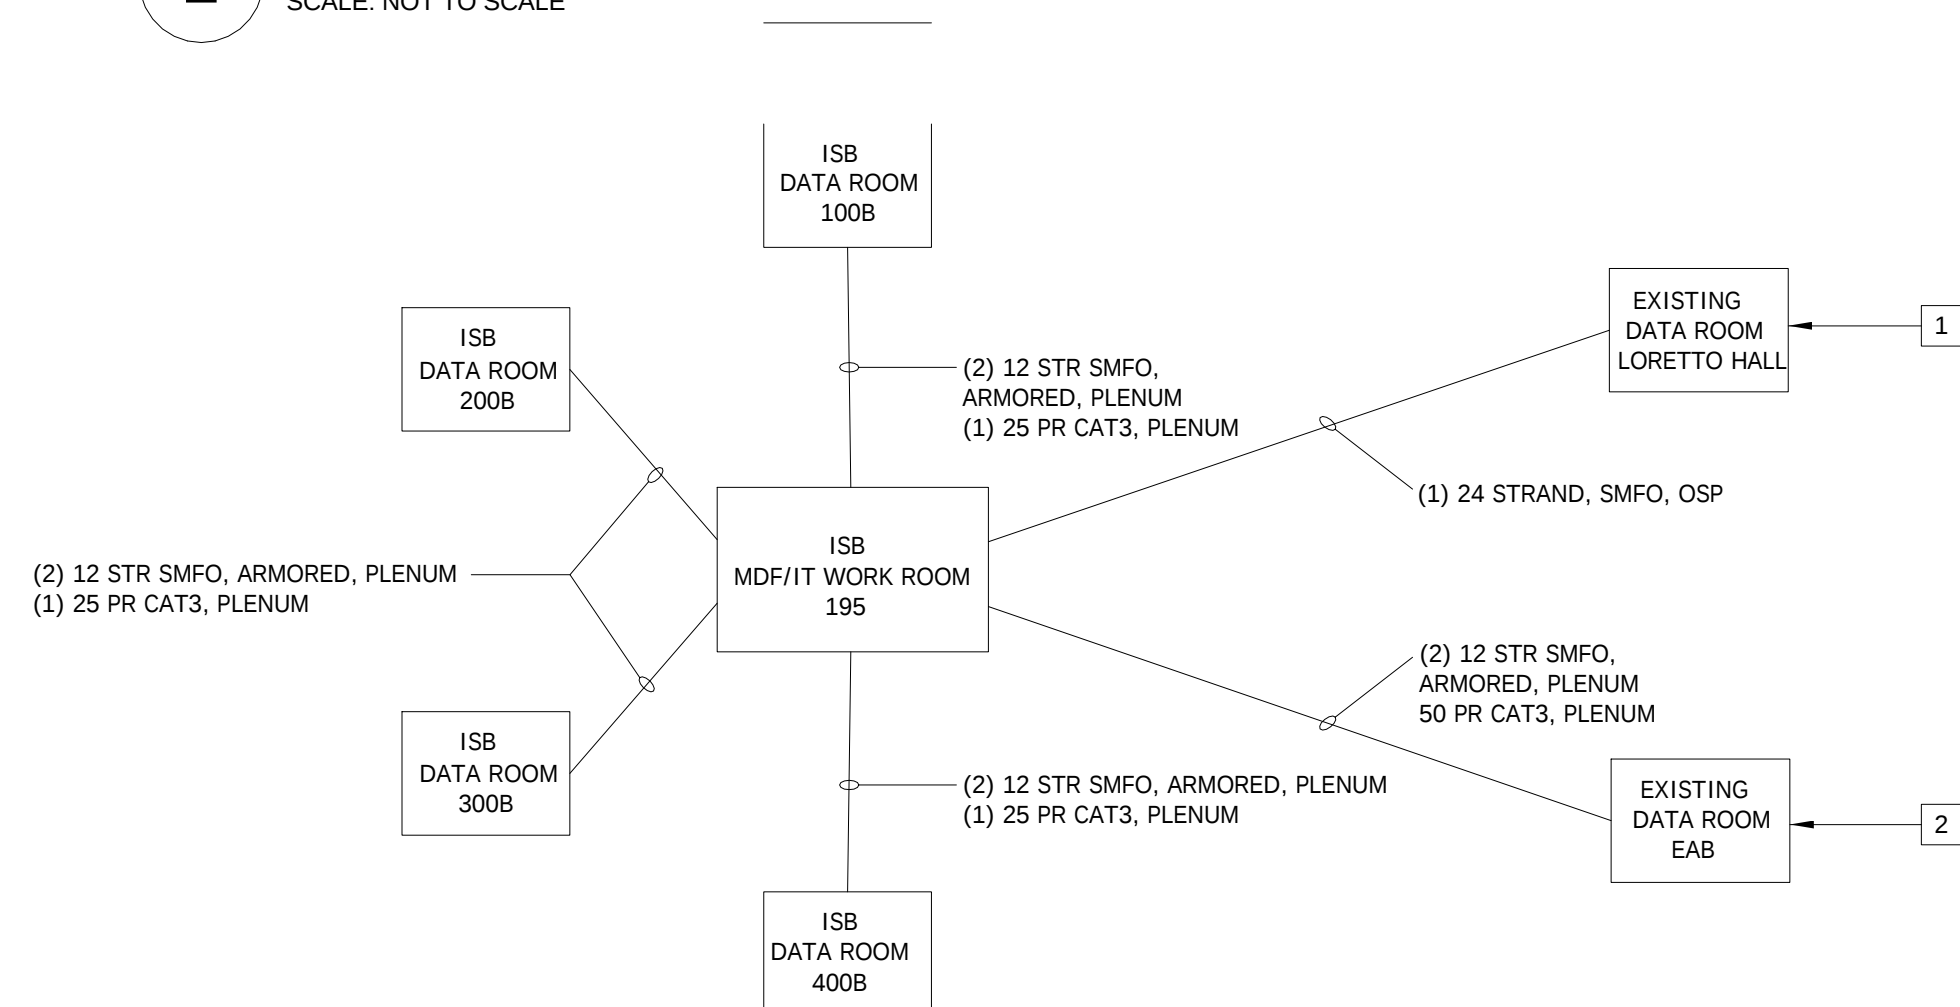


KEYED NOTES

- 1 PROVIDE A 48 PORT SMFO WALL MOUNT PATCH PANEL INSIDE THE DATA ROOM. CONFIRM EXACT LOCATION WITH WEBSTER UNIVERSITY IT DEPARTMENT PRIOR TO INSTALLATION. SEE DETAIL #16 ON SHEET T0201.
- 2 PROVIDE A 48 PORT SMFO RACK MOUNT PATCH PANEL IN EXISTING RACK. PROVIDE 50 PAIR M66 PUNCH DOWN BLOCK NEXT TO EXISTING PUNCH DOWN BLOCKS. TERMINATE, TEST AND LABEL ALL CABLES PER STANDARDS.

3 PDS BACKBONE CABLING DIAGRAM
SCALE: NOT TO SCALE

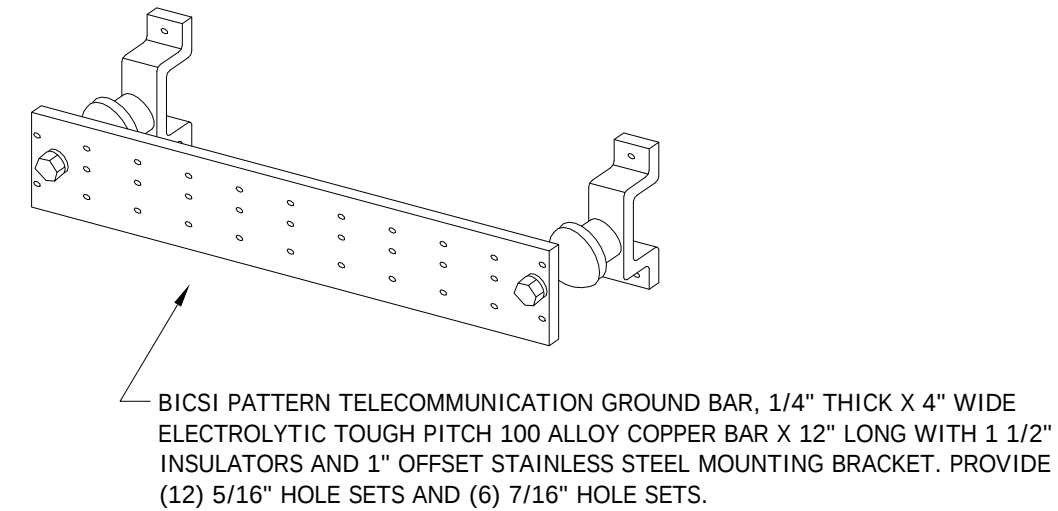


TELECOMM GROUND BAR (TGB) DETAIL
SCALE: NONE

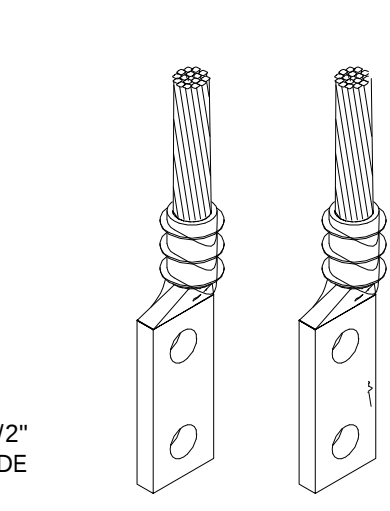


GROUND CONDUCTOR/
BAR CONNECTION
SCALE: NONE


4 TELECOM GROUNDING DETAILS
SCALE: NOT TO SCALE

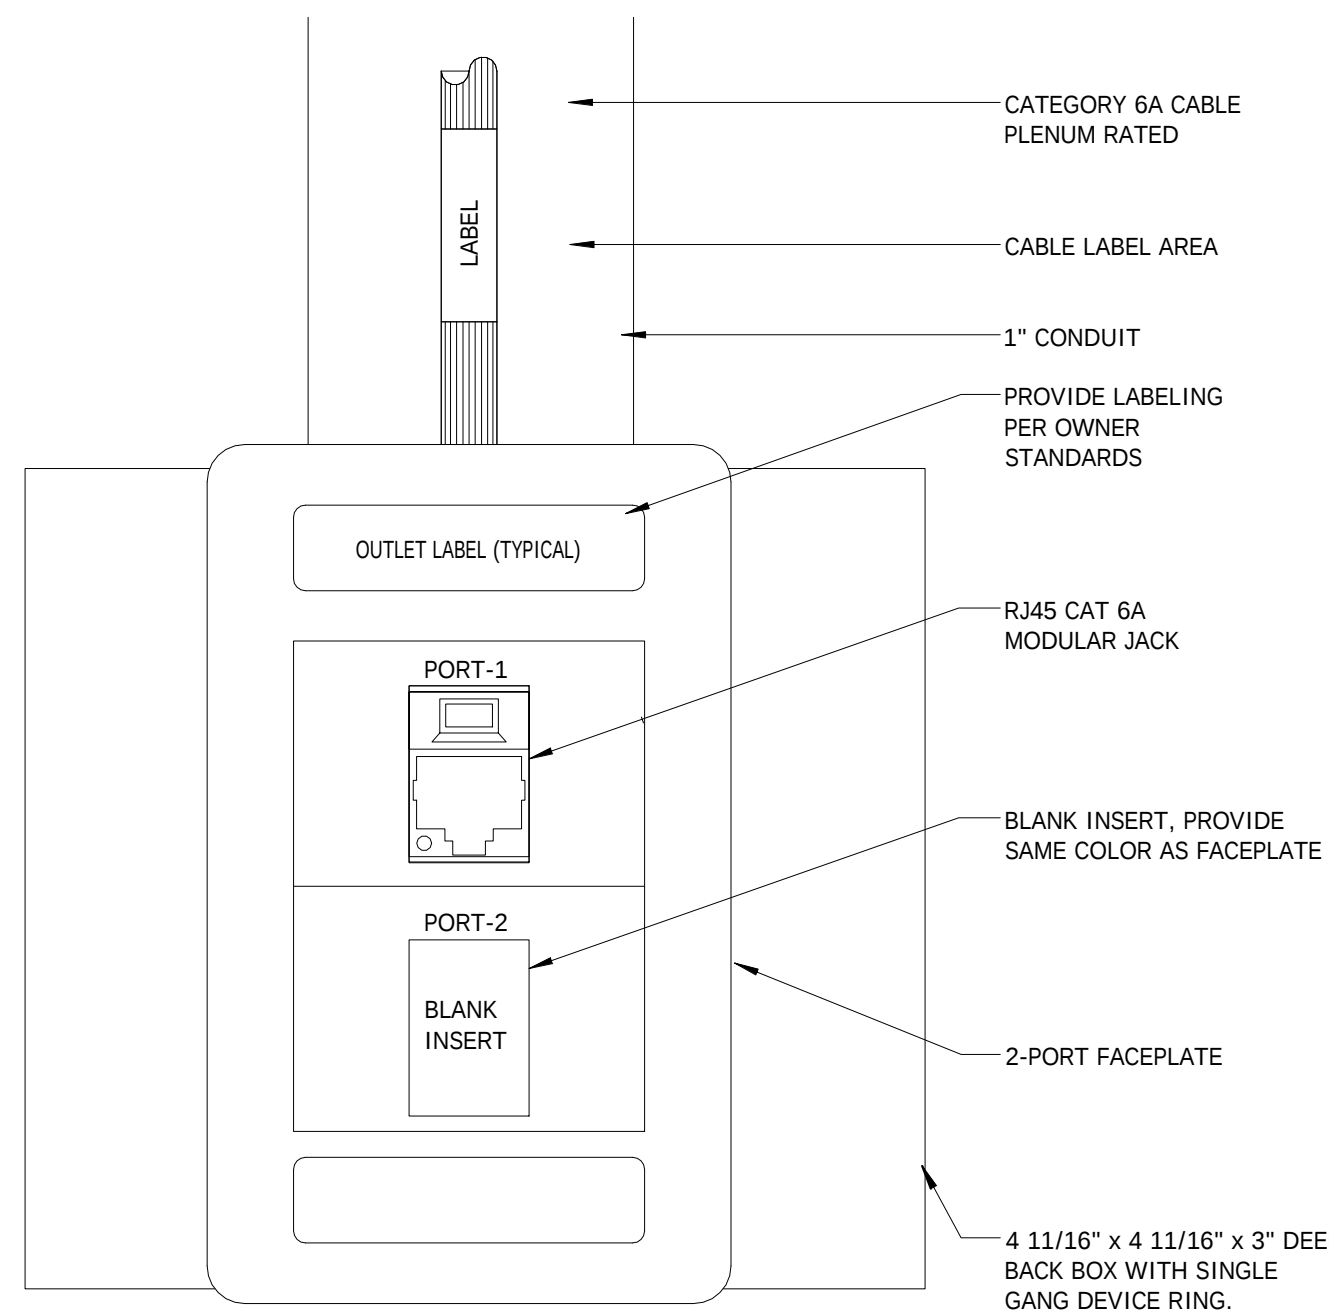


5 TYPICAL 1 PORT FACEPLATE DETAIL
SCALE: NONE

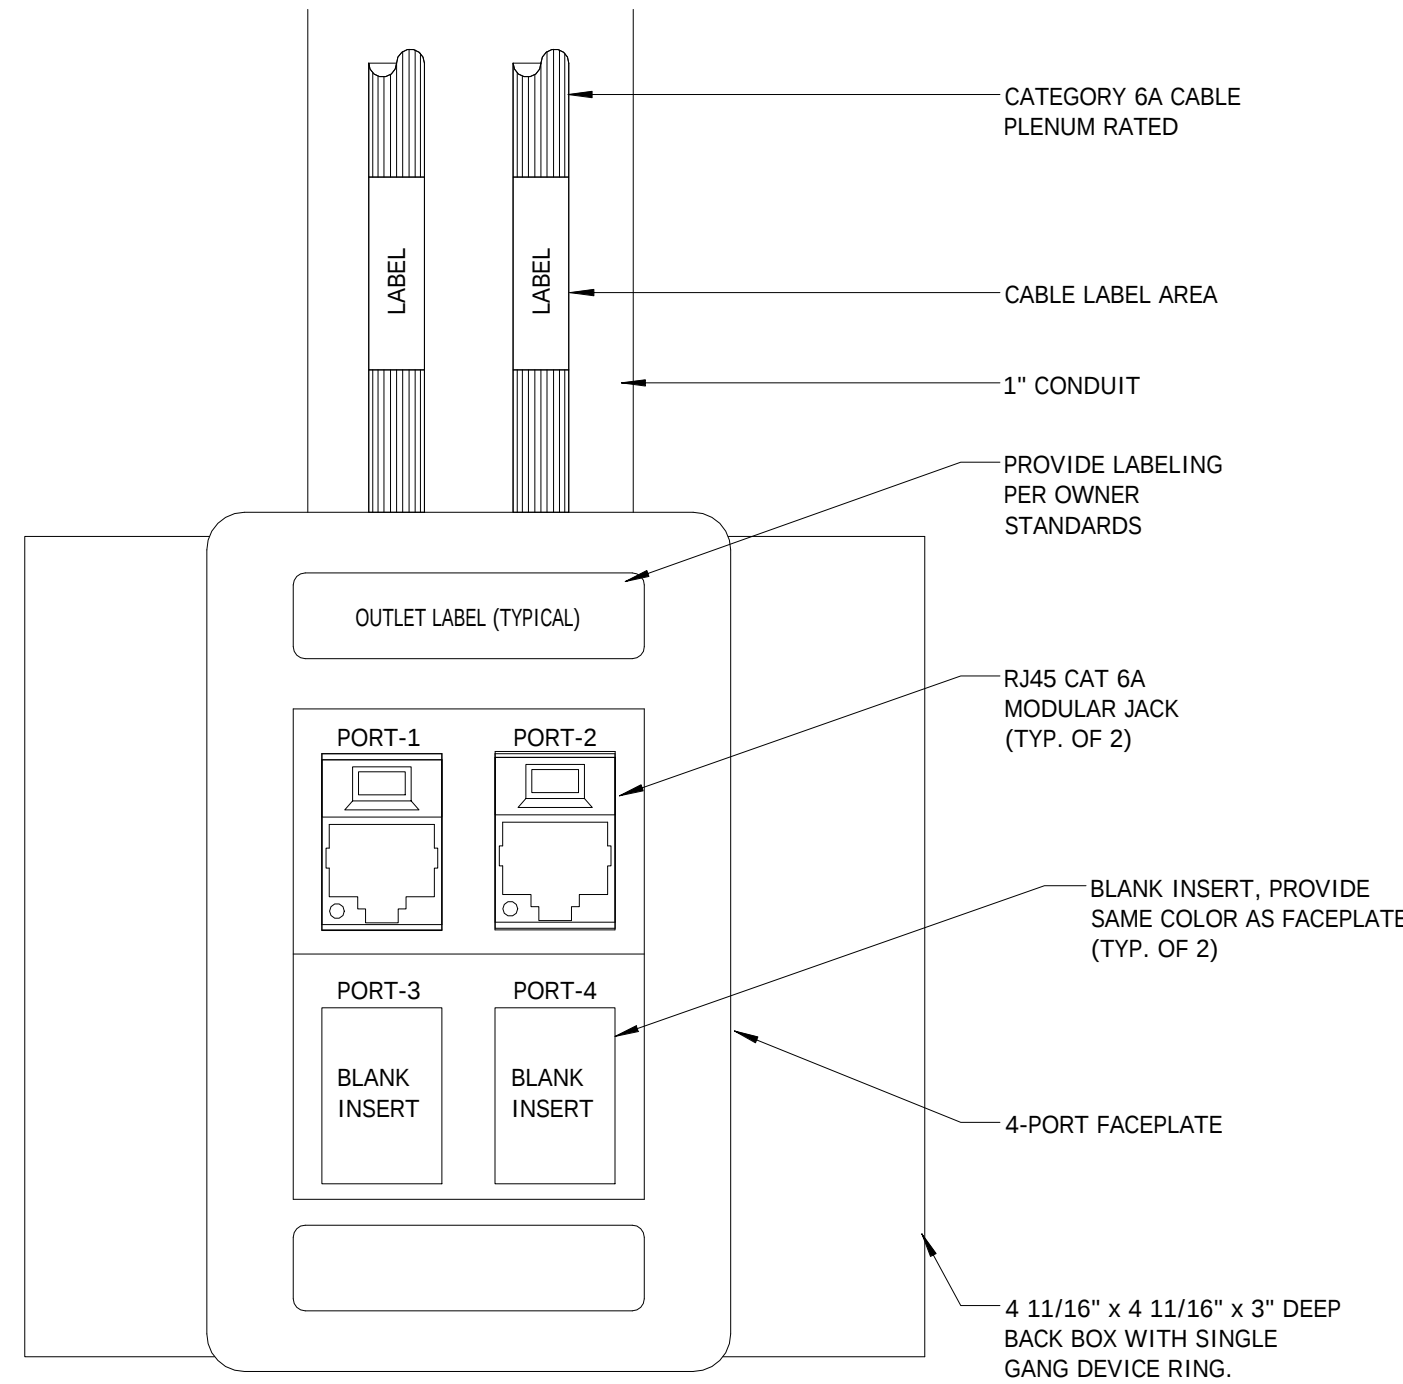


SCALE: NONE

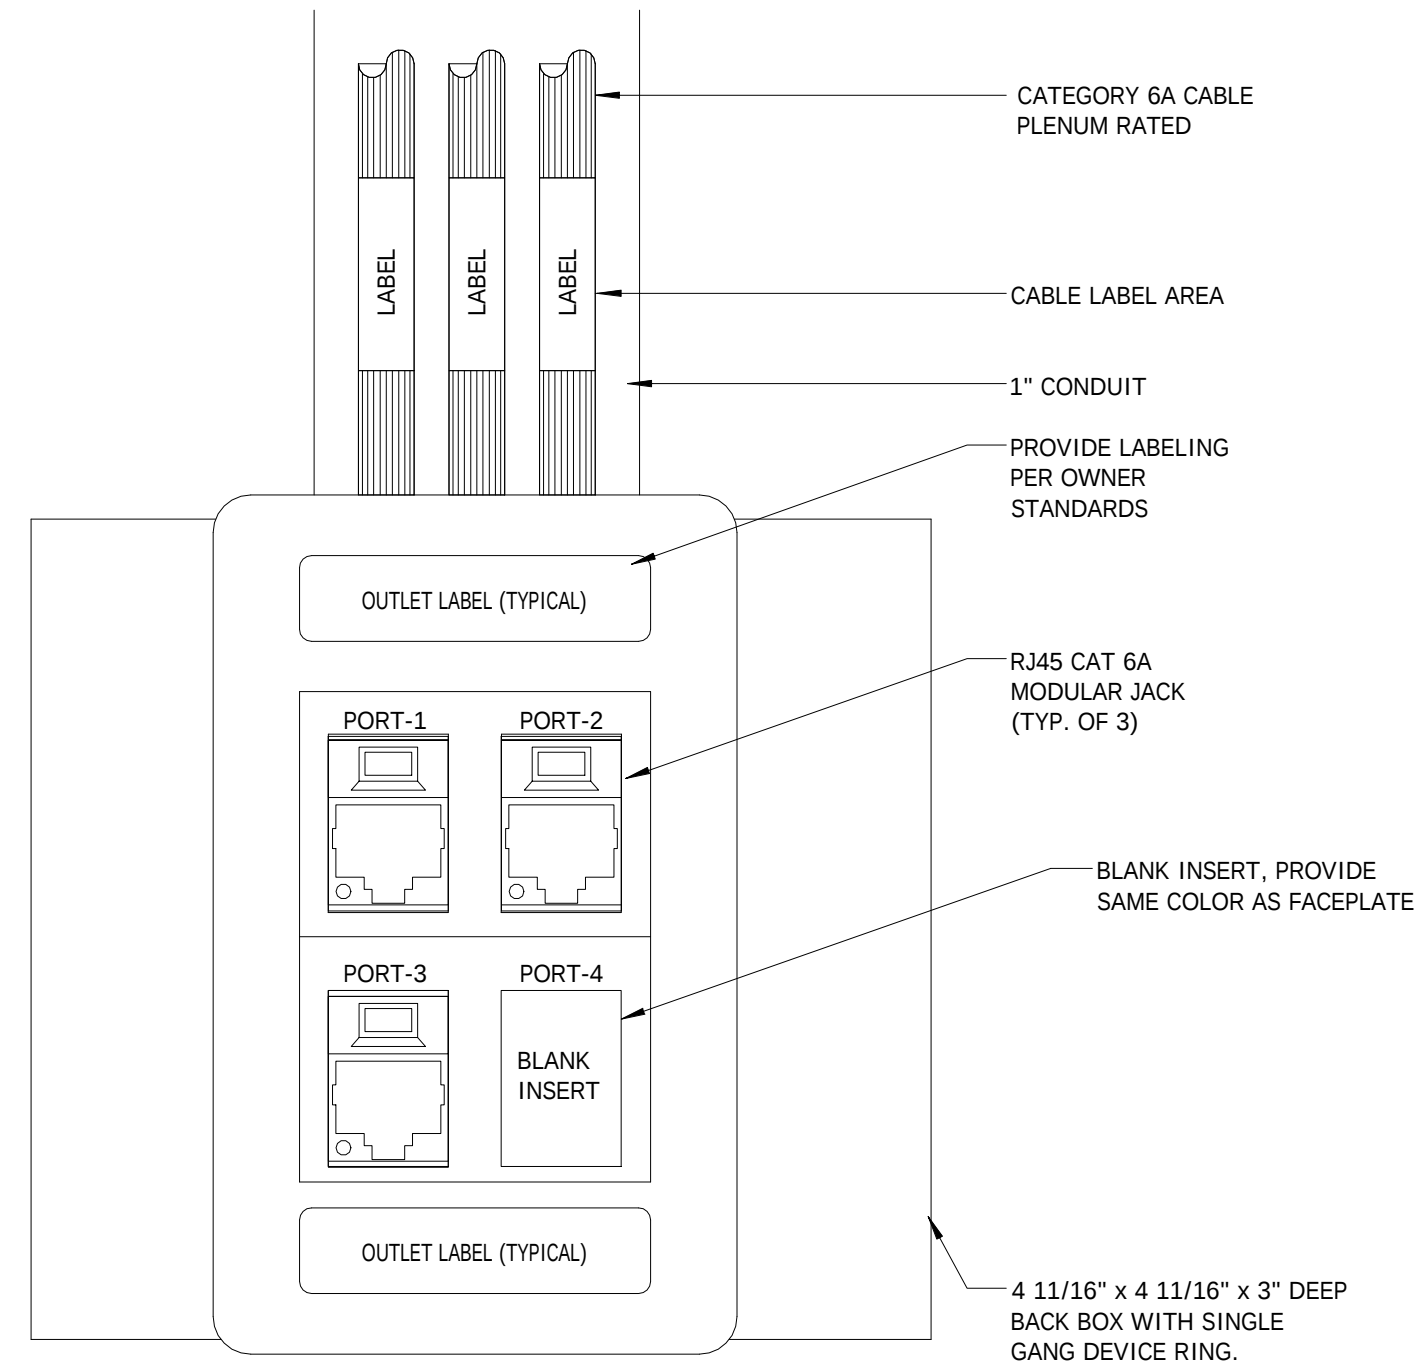

SCALE: NONE

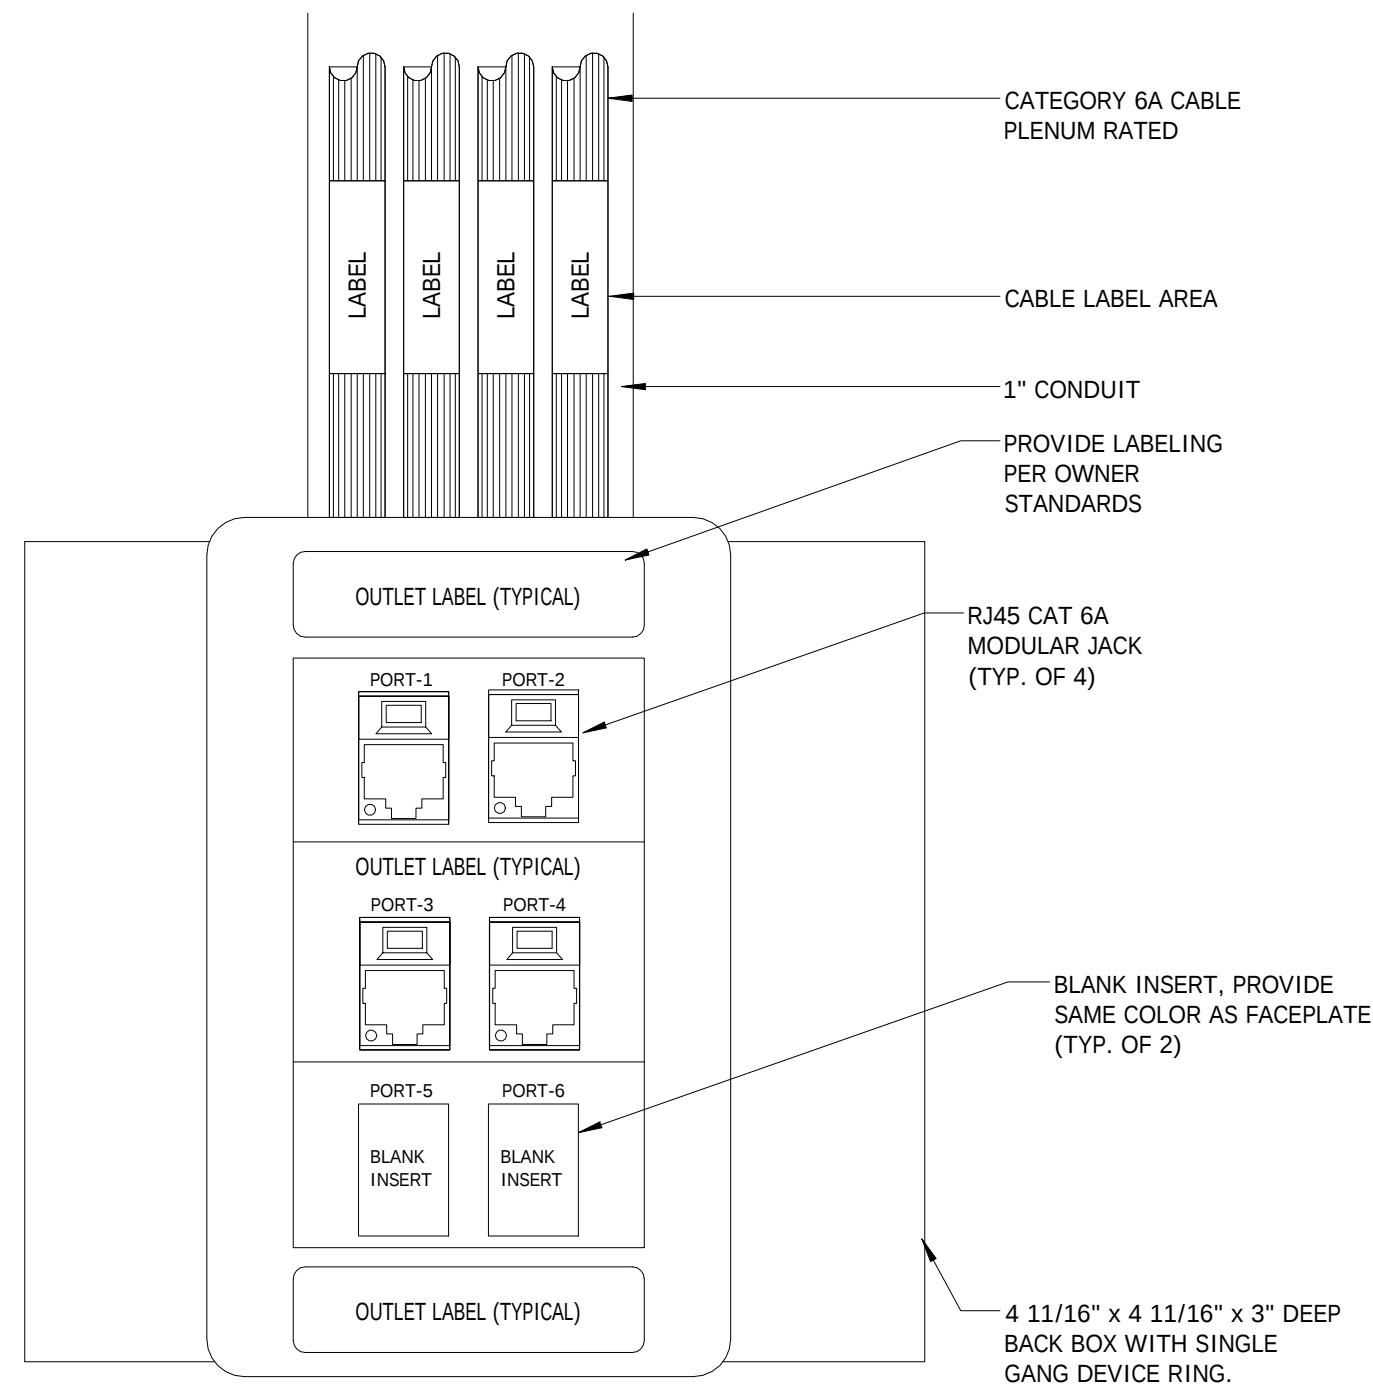

SCALE: NONE

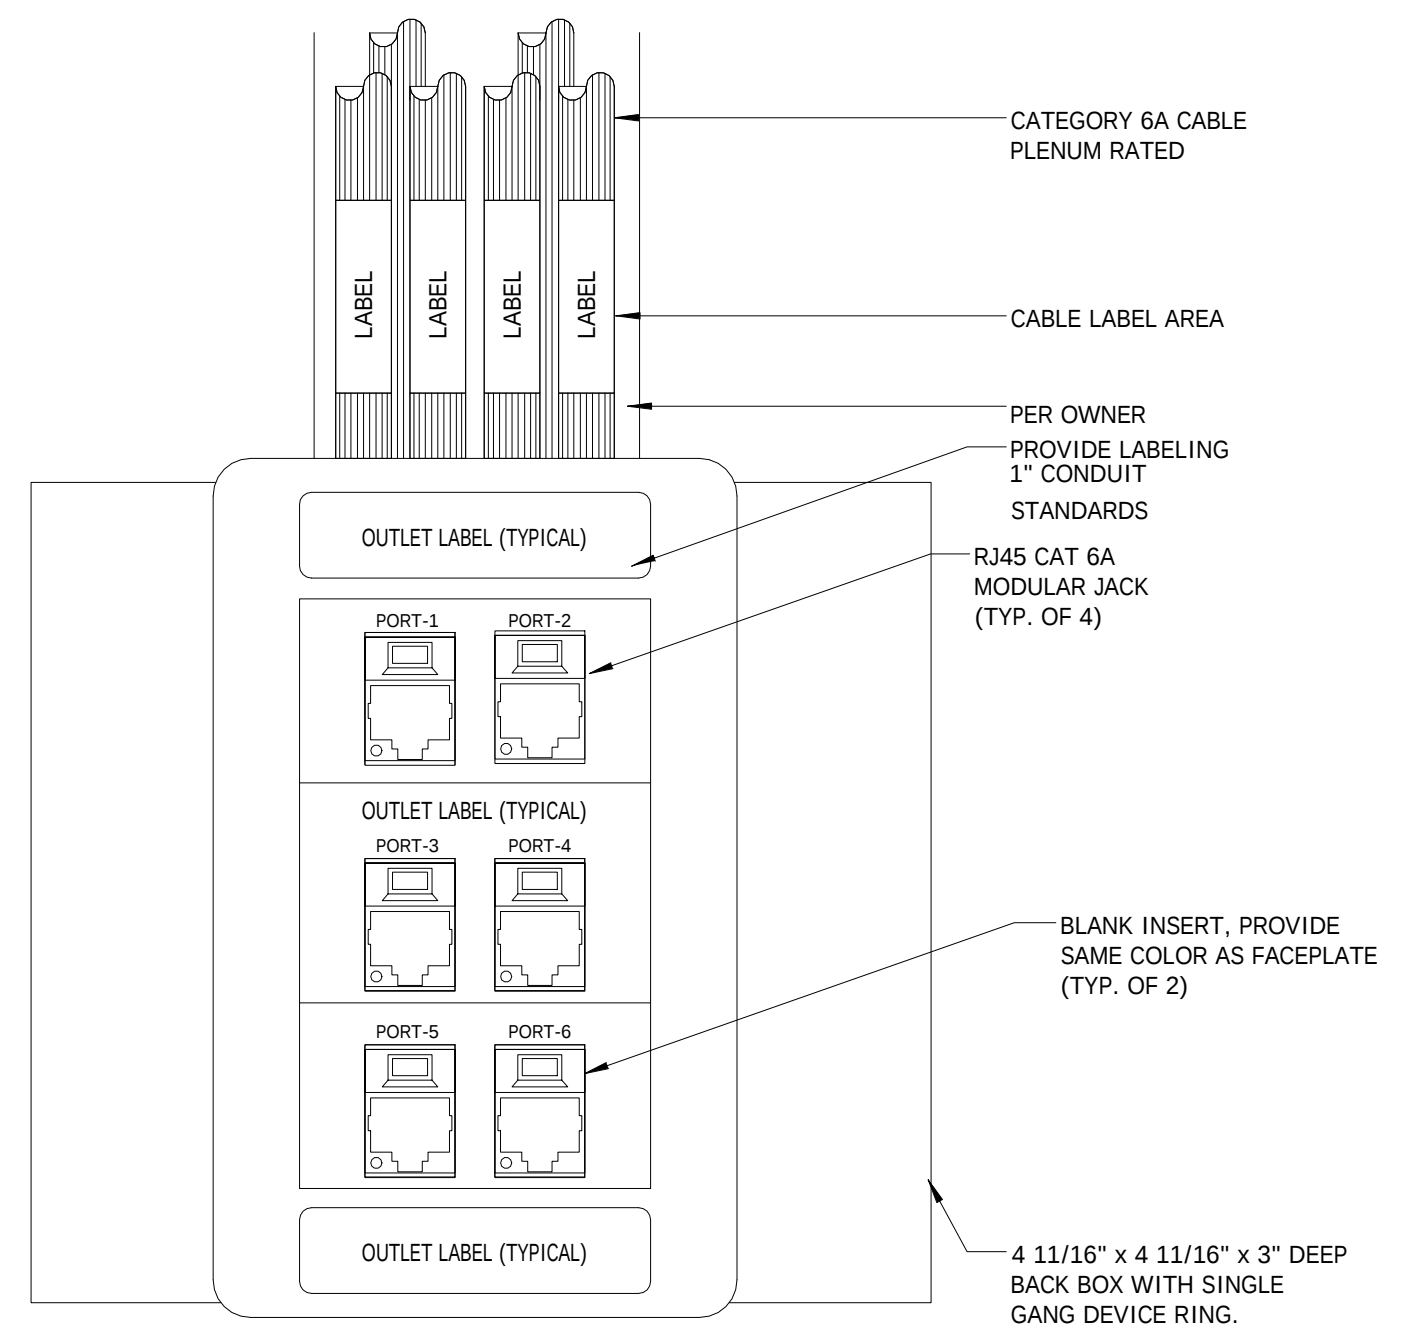

SCALE: NONE