



PARIC CORPORATION
77 Westport Plaza Suite 250
St. Louis, MO 63146
TEL: 636-561-9500
FAX: 636-561-9501

REQUEST FOR INFORMATION	DATE: February 25, 2016	NO.: 6
--------------------------------	--------------------------------	---------------

To: Cannon Design

Attn: Kelvin Patel

From: Paric Corporation

Requested By: Devin Gates

Project Name: Webster University Interdisciplinary Science Building Project No.: 15051

Subject: Proposal to lower sanitary line

Response Required By: March 03, 2016

Drawing / Spec Reference:

Information Requested:

Please see attached sketches. In the RFI # 5 response to question number 6 we were told the lines cannot be moved to the north due to the existing duct bank. This will still cause a constructability issue due to the elevation.

Suggestion: Paric proposes to lower the top of the sanitary pipe below 541' at the corner of the building (as shown) to avoid this conflict.

Response:

Paric's proposed lowering of sanitary pipe is acceptable. Sewer profile drawing will be revised (see attached) for MSD submittal / approval. Note the final approval is contingent on MSD approval."

ARCHITECT'S RESPONSE:

This information is provided as an interpretation of the Contract Documents for implementation. It is not an authorization for change to the Contract Sum or Contract Time. If this information results in a claim for a change to the Contract, the Contractor shall notify the [Construction Manager][Architect] of a change through the change process.


Answered By: Mark Davis, DMA

Date: March 7, 2016

BLUE =
SHORING

RED CLOUD
REPRESENTS AREA
SHOWN IN ATTACHED
MODEL

GENERATOR

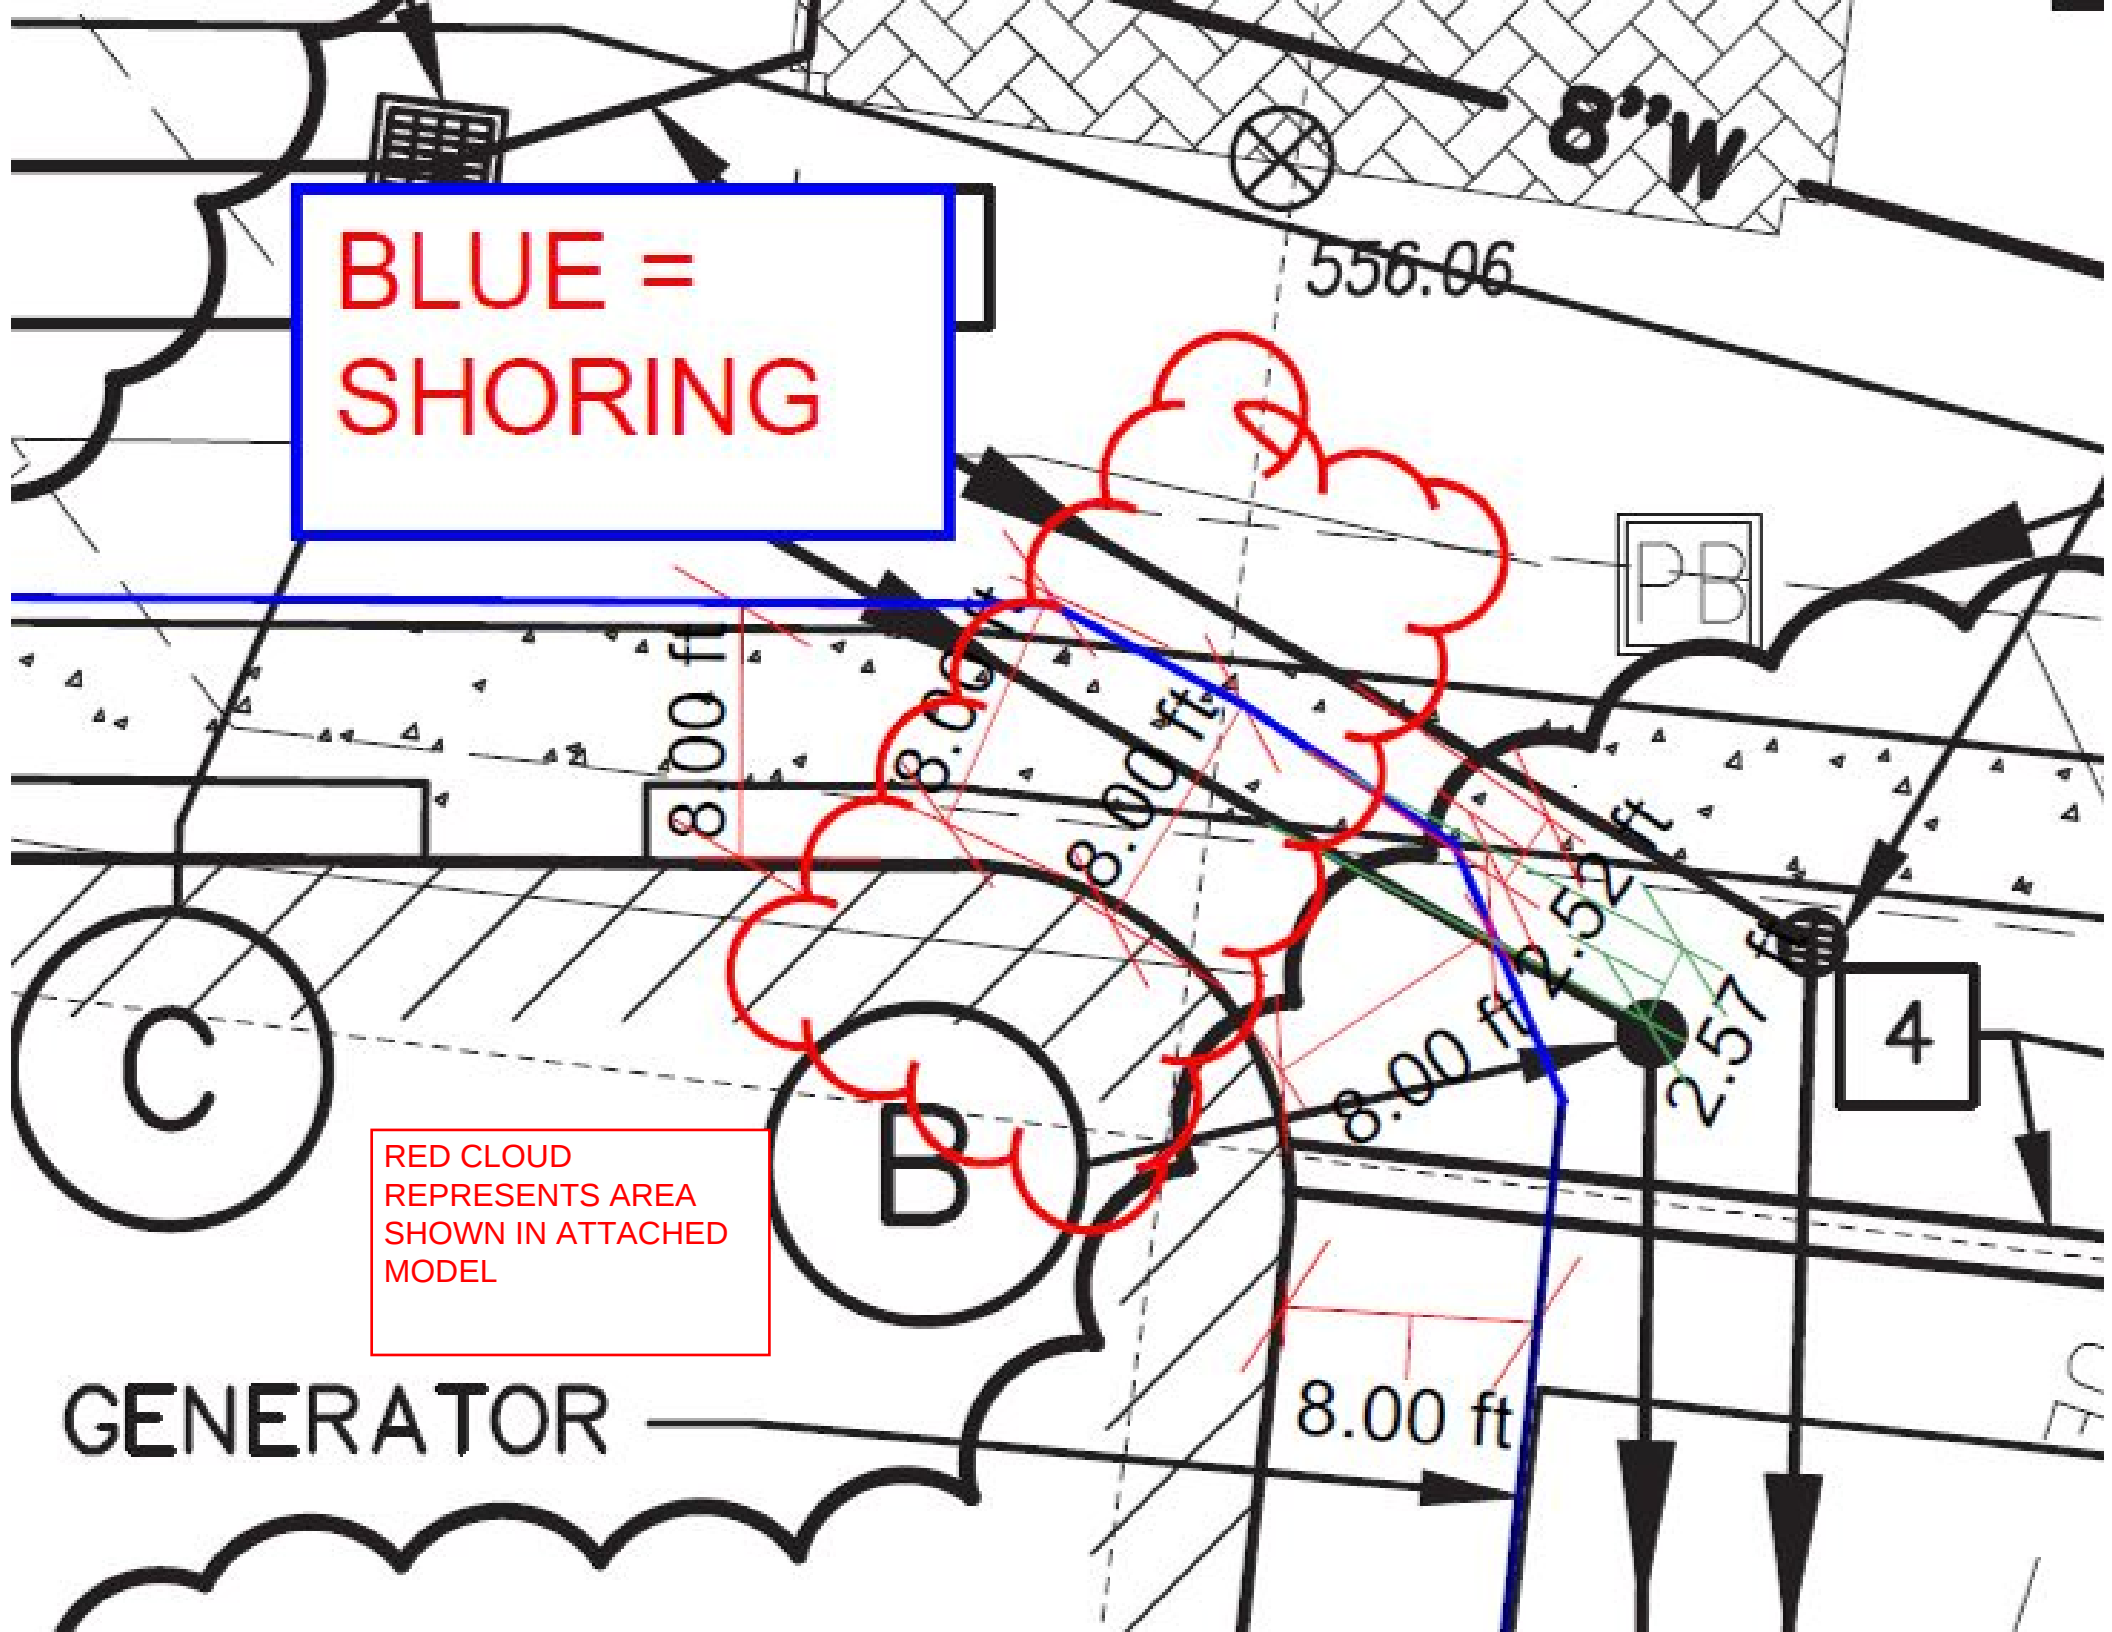

SANITARY SYSTEM 1 PROFILE

