



PARIC CORPORATION
77 Westport Plaza Suite 250
St. Louis, MO 63146
TEL: 636-561-9500
FAX: 636-561-9501

REQUEST FOR INFORMATION	DATE: May 12, 2016	NO.: RFI-074
--------------------------------	---------------------------	---------------------

To: Cannon Design

Attn:

From: Paric Corporation

Requested By: Devin Gates

Project Name: Webster University Interdisciplinary Science Building Project No.: 15051

Subject: Curtainwall paint color sample

Response Required By: May 19, 2016

Drawing / Spec Reference:

Information Requested:

The curtainwall contractor needs color chips of the selected paint finish for the exterior aluminum curtain wall, system EGS-2A. With these chips they can forward to the supplier so it can be matched in a kynar finish and color samples can be issued for formal approval. Will Cannon provide chips?

The specs call for a differing color on the mullions for this system. Does the color selected apply to the horizontal rails too?

Response:

EGS-2A (curtain wall at the sunken courtyard including lecture hall) & EGS-3 (Punched windows at the north area well) are to be black in color.

This color applies to the entire curtain wall system, including the doors within it (see yellow highlighted area of attachment).


Provide manufacturer's standard black color samples for selection.

ARCHITECT'S RESPONSE:


This information is provided as an interpretation of the Contract Documents for implementation. It is not an authorization for change to the Contract Sum or Contract Time. If this information results in a claim for a change to the Contract, the Contractor shall notify the [Construction Manager][Architect] of a change through the change process.

Answered By: Kelvin Patel


Date: 05/16/2016

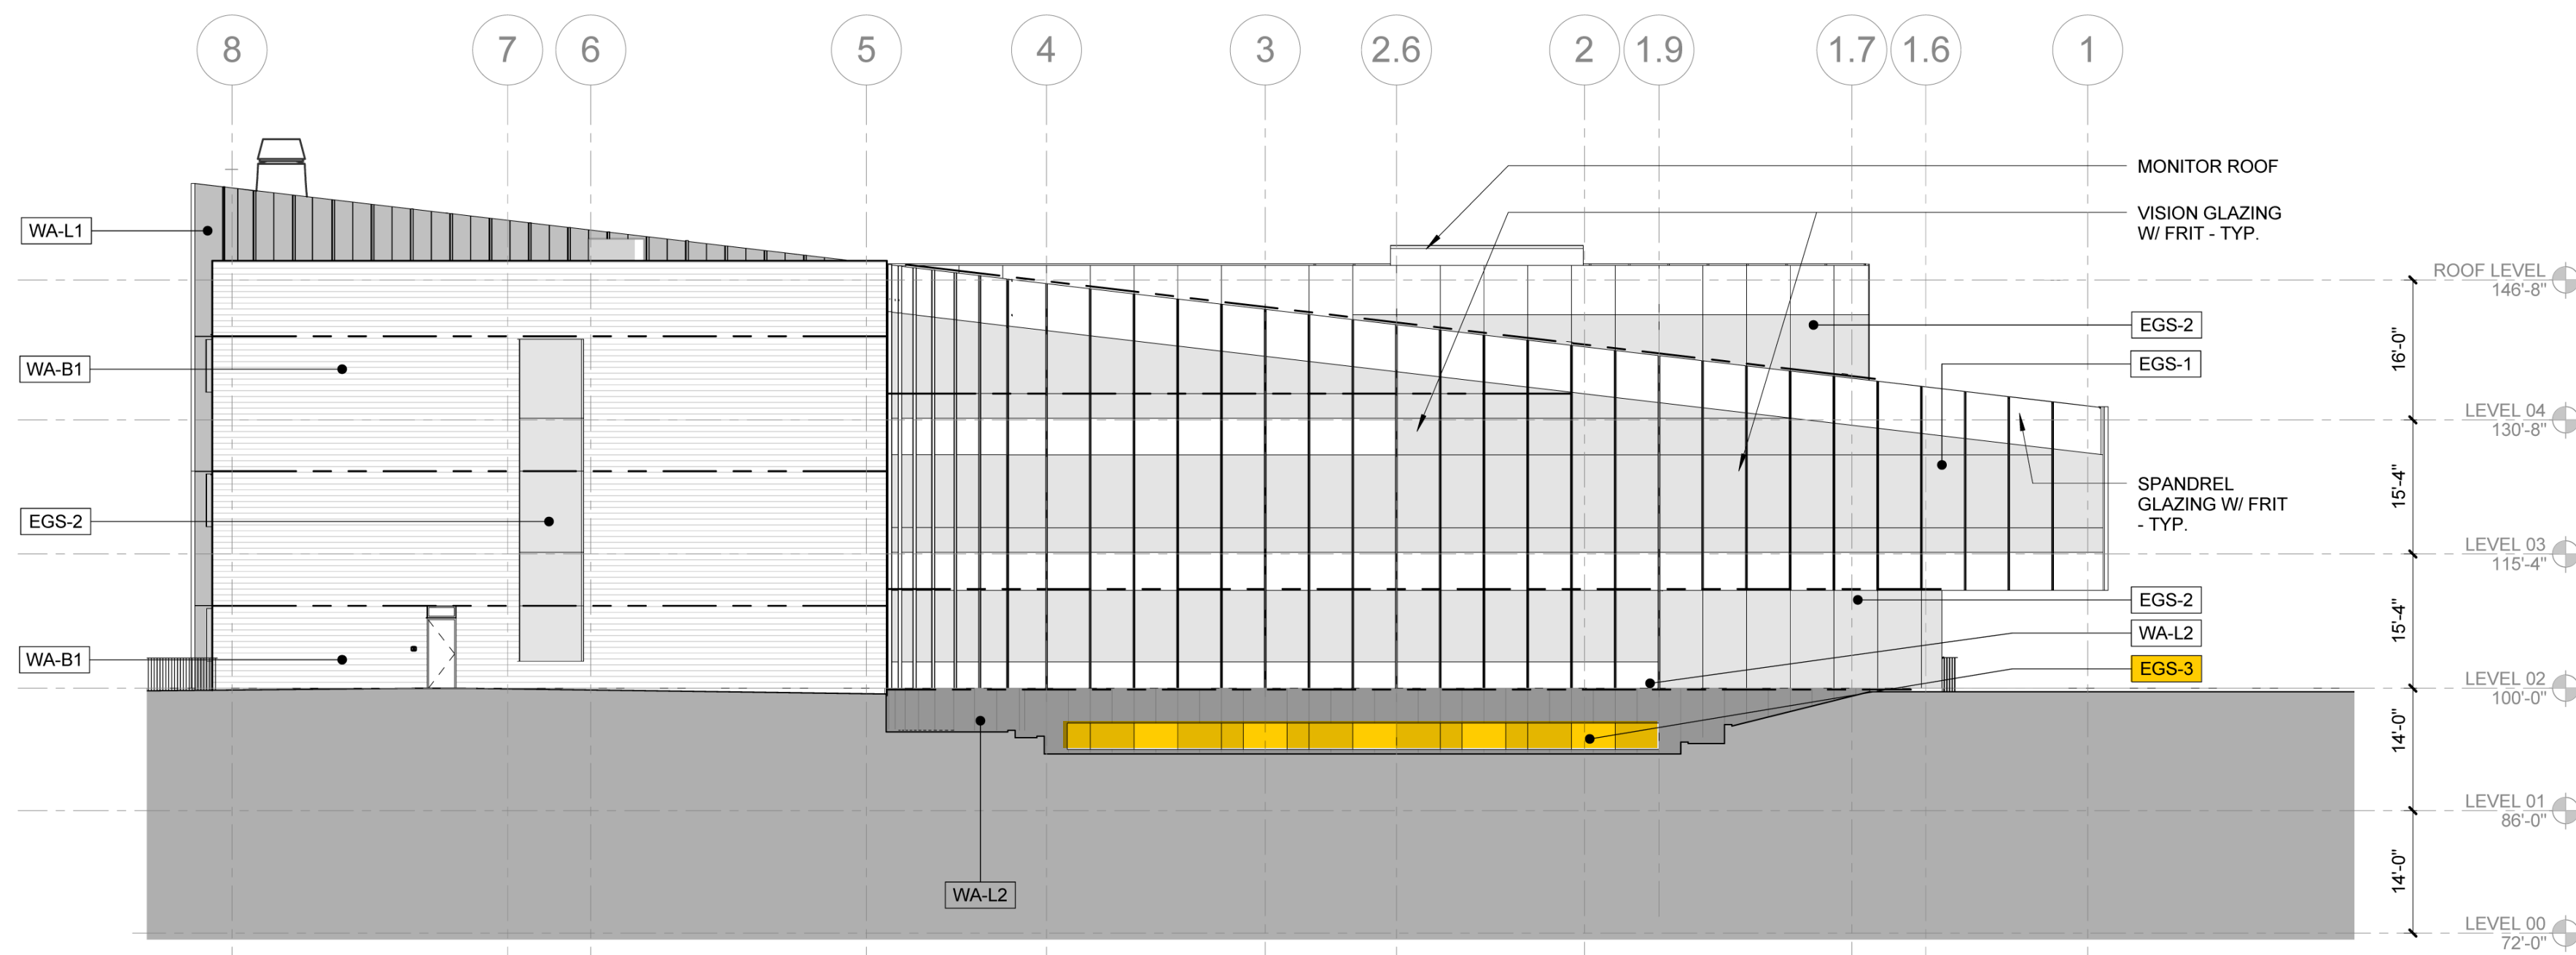

4 EXTERIOR NORTH
1/16" = 1'-0"

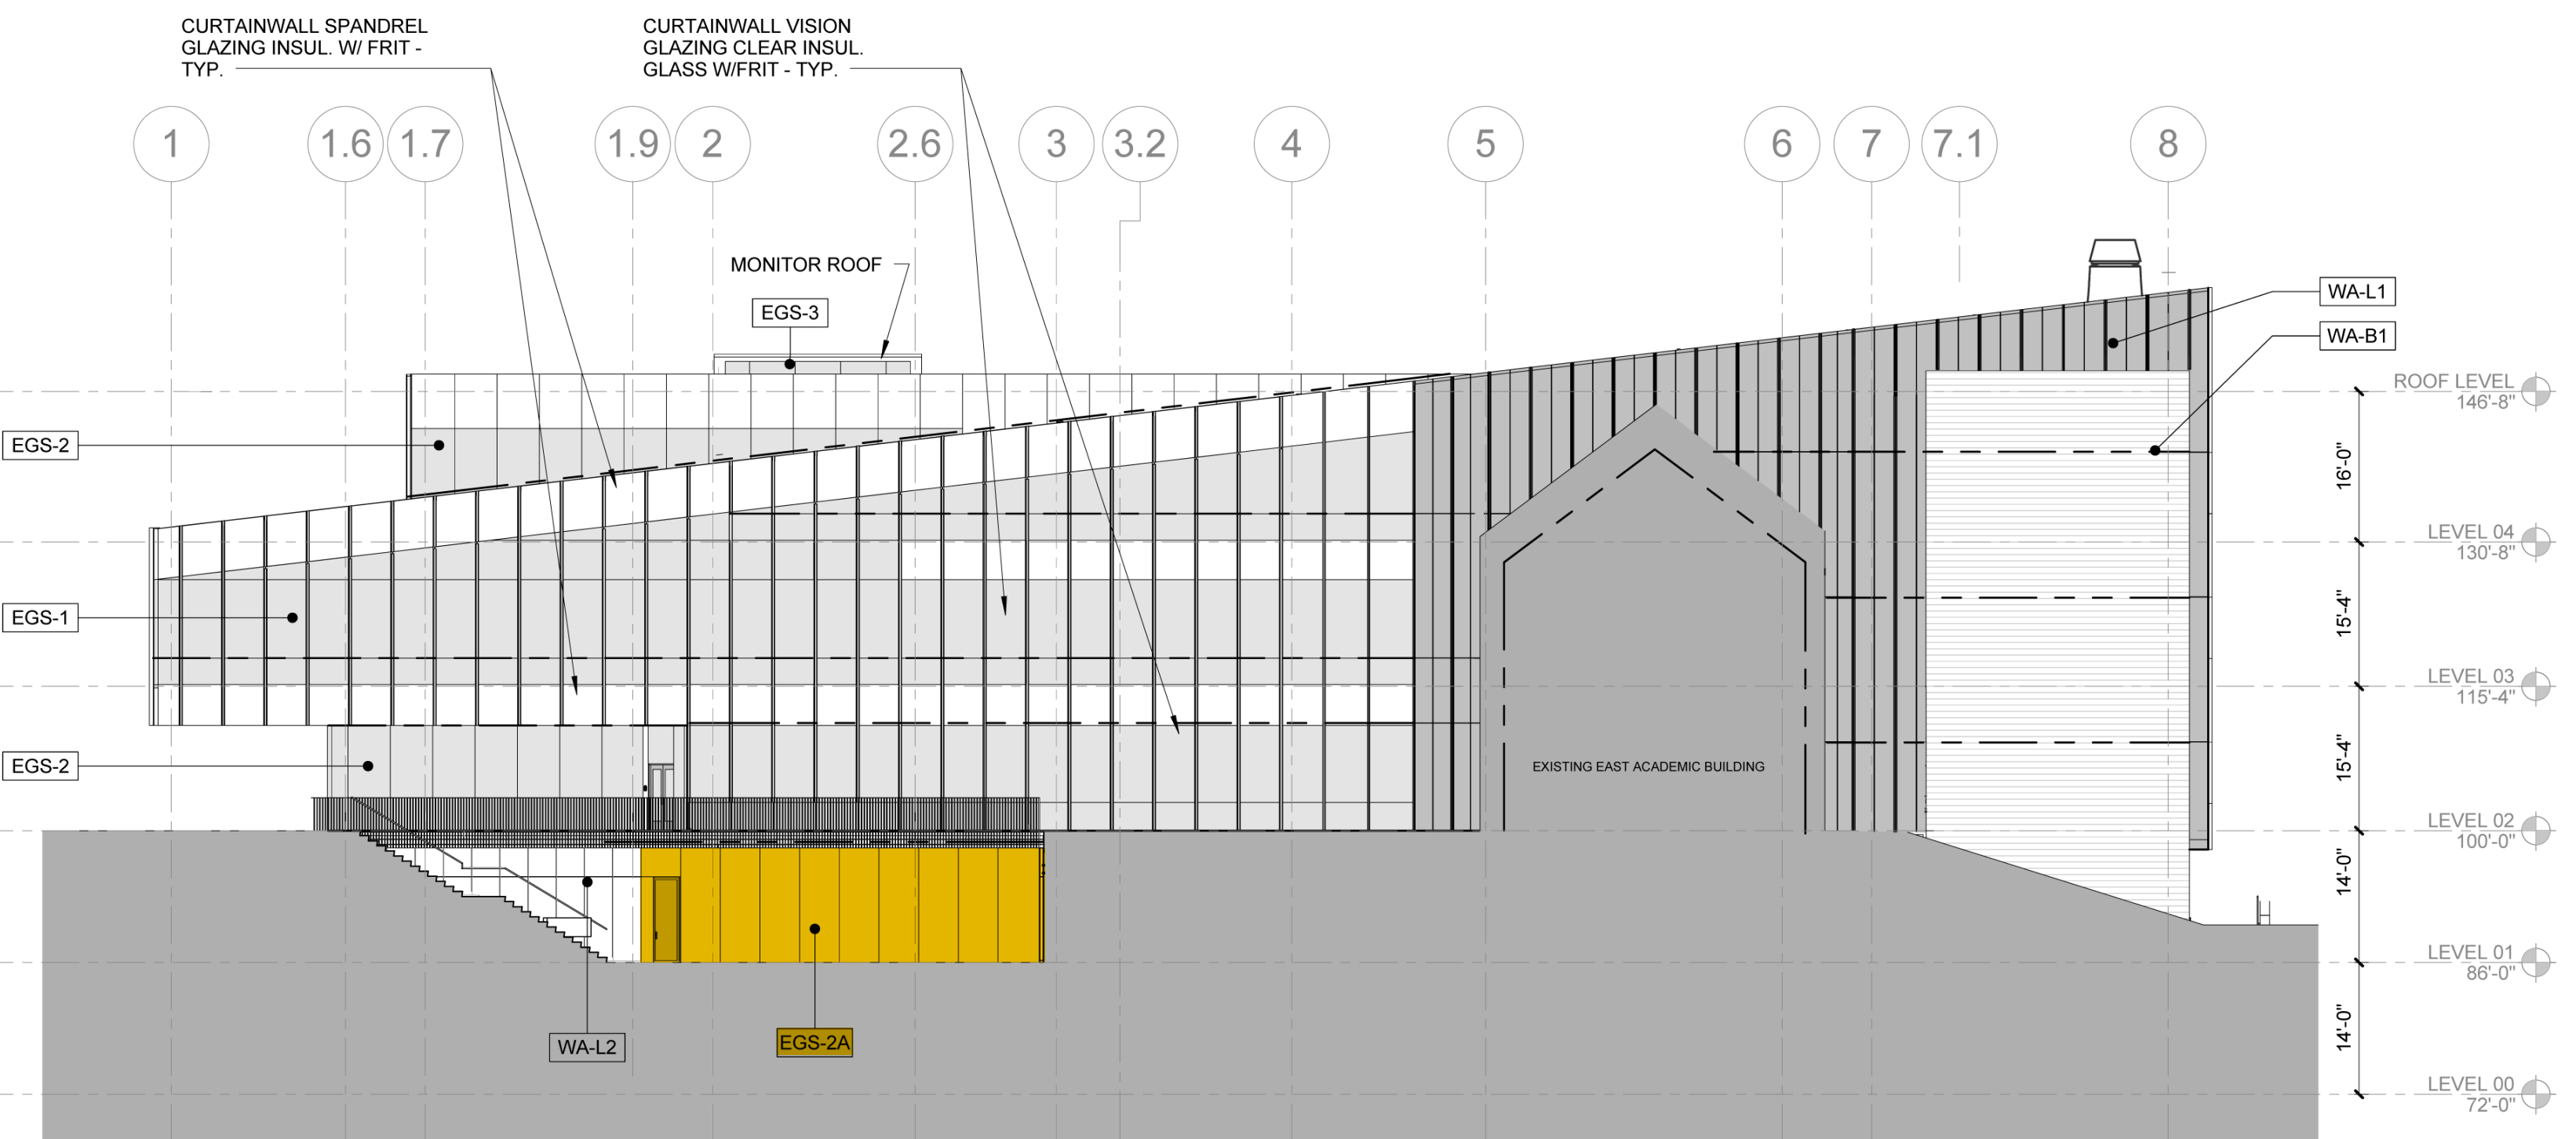

3 EXTERIOR SOUTH
1/16" = 1'-0"

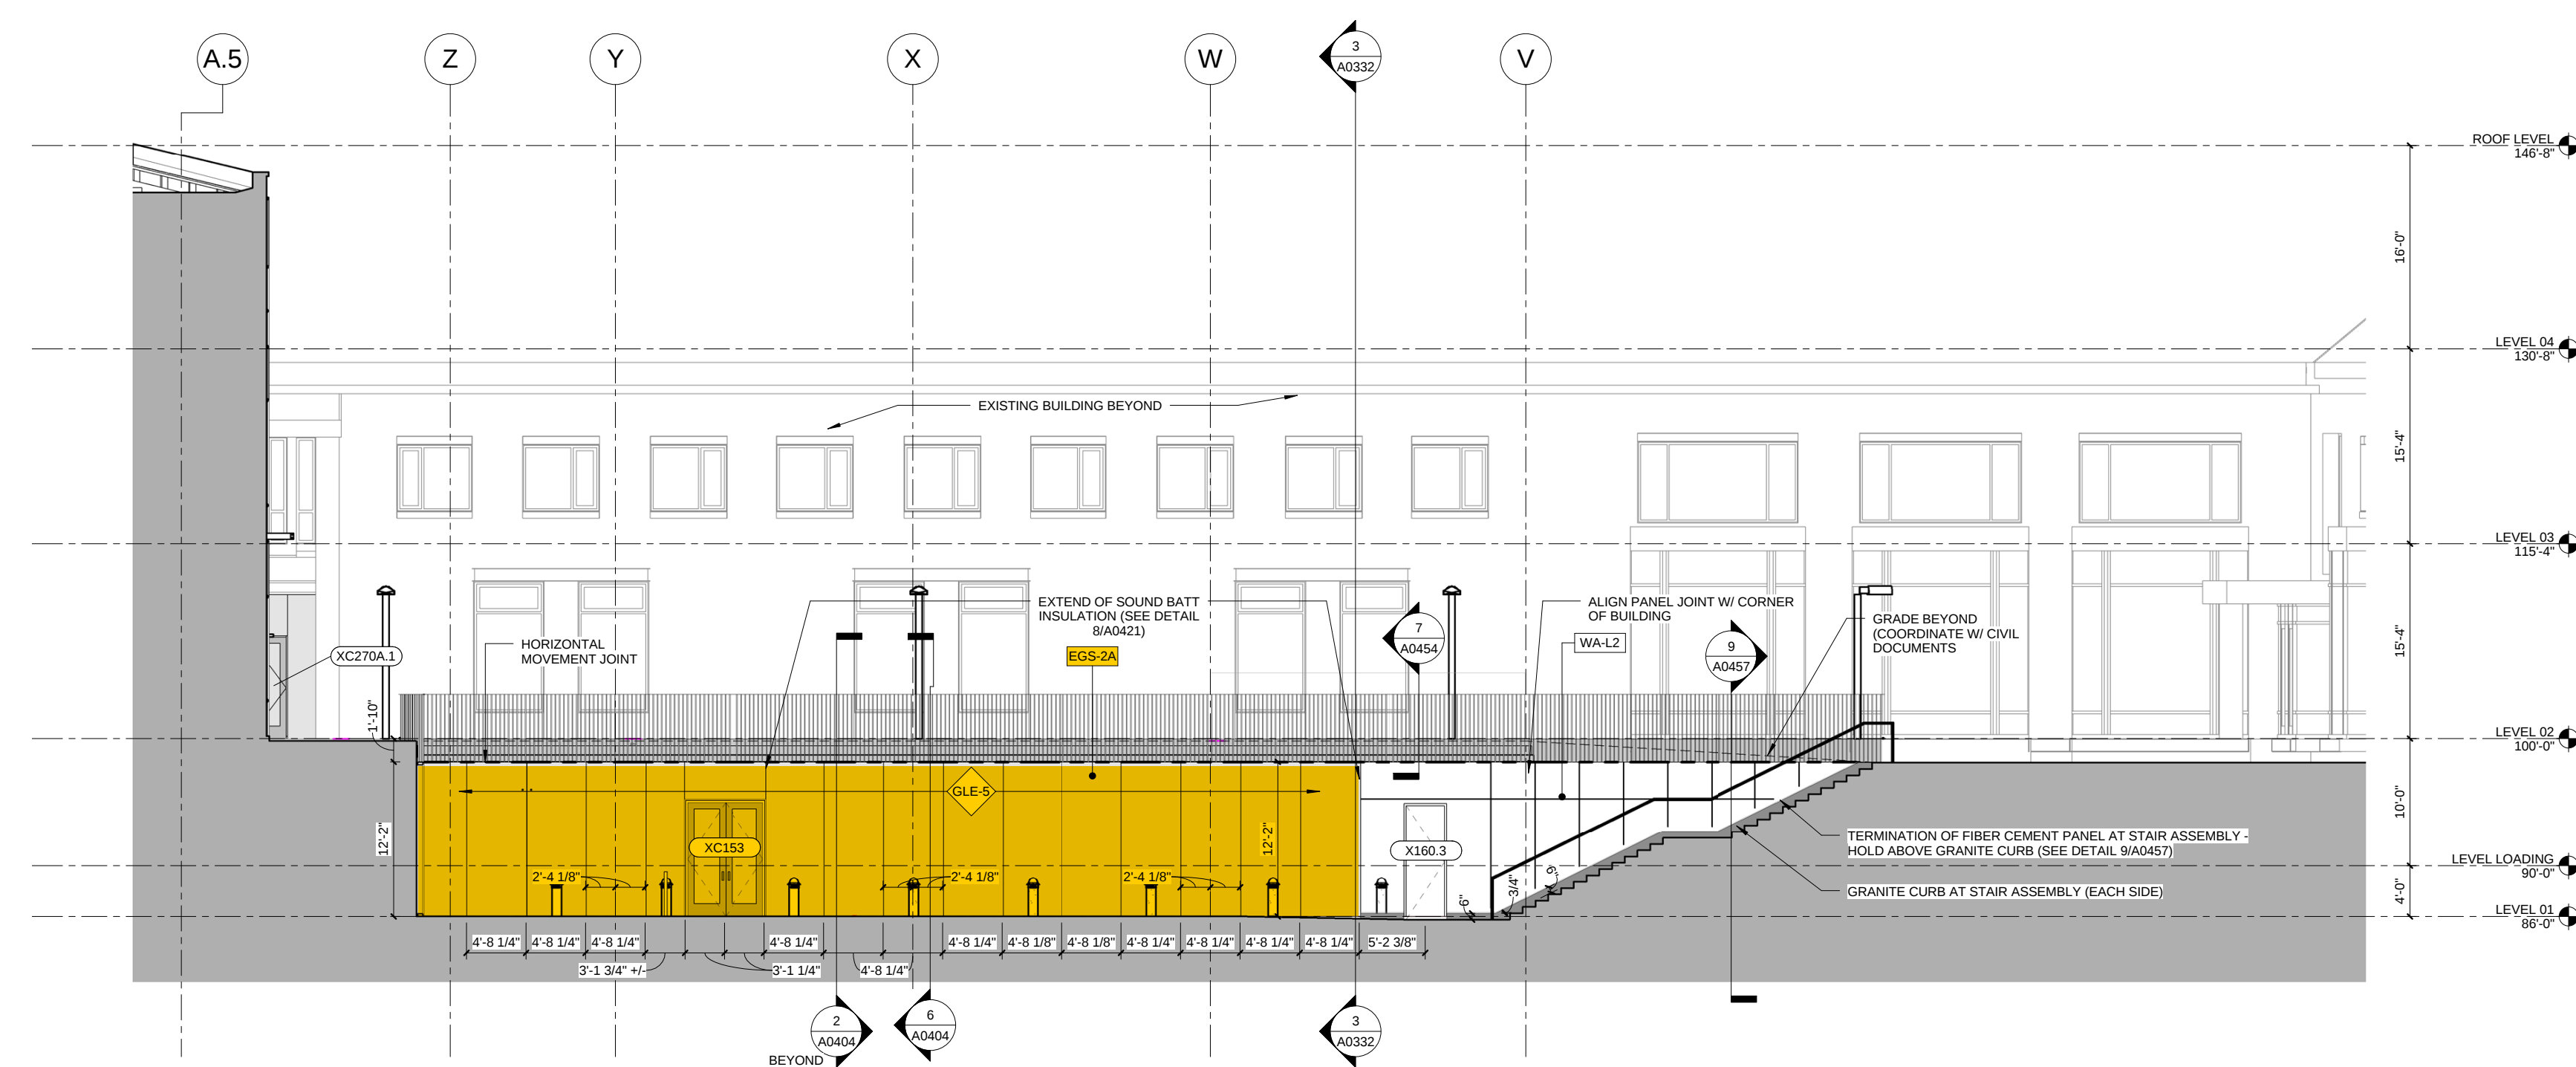

2 WEST ELEVATION AT SOUTH WING
1/8" = 1'-0"