



PARIC CORPORATION
77 Westport Plaza Suite 250
St. Louis, MO 63146
TEL: 636-561-9500
FAX: 636-561-9501

REQUEST FOR INFORMATION **DATE:** May 16, 2016 **NO.:** RFI-086

To: Cannon Design

Attn: Kelvin Patel

From: Paric Corporation

Requested By: Devin Gates

Project Name: Webster University Interdisciplinary Science Building Project No.: 15051

Subject: Stud wall at room 185

Response Required By: May 23, 2016

Drawing / Spec Reference:

Information Requested:


Room 185 Spill Closet

Plumbing drawing calls for a 3" sanitary line to drop down in the West wall of 185 Spill Closet. This is a 3-5/8" stud and is too small for a 3" sanitary pipe. See attached.

Solution: Increase stud wall to 6".

Response:

Revise the west wall of '185 SPILL CLOSET' room to type 'R6' with 6" stud. See sketch.

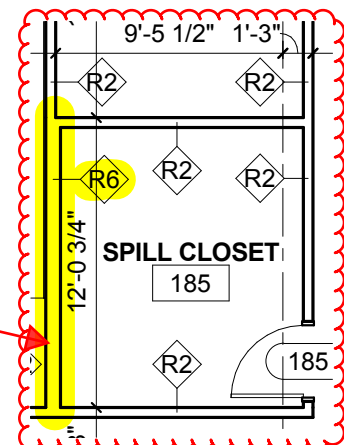

ARCHITECT'S RESPONSE:

This information is provided as an interpretation of the Contract Documents for implementation. It is not an authorization for change to the Contract Sum or Contract Time. If this information results in a claim for a change to the Contract, the Contractor shall notify the [Construction Manager][Architect] of a change through the change process.

Answered By: Kelvin Patel

Date: 05/20/2016