



PARIC CORPORATION
77 Westport Plaza Suite 250
St. Louis, MO 63146
TEL: 636-561-9500
FAX: 636-561-9501

REQUEST FOR INFORMATION **DATE:** May 16, 2016 **NO.:** RFI-087

To: Cannon Design

Attn: Kelvin Patel

From: Paric Corporation

Requested By: Devin Gates

Project Name: Webster University Interdisciplinary Science Building Project No.: 15051

Subject: Clinical service sink clearance at cadaver lab

Response Required By: May 23, 2016

Drawing / Spec Reference:


Information Requested:

The clinical service sink called out on the South wall of the room requires a carrier, and needs a minimum of 12" of clear space inside the wall (including stud dimensions, excluding drywall) to contain the piping and the carrier.

Suggestion: Recommend creating a soffit/chase to increase the space for the piping.

Response:

Revise per attached sketch.

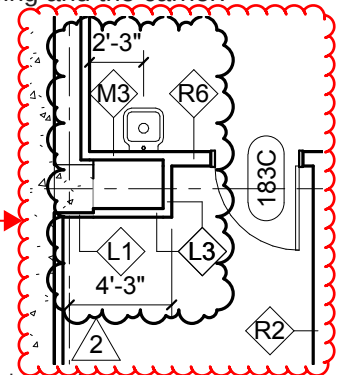

ARCHITECT'S RESPONSE:

This information is provided as an interpretation of the Contract Documents for implementation. It is not an authorization for change to the Contract Sum or Contract Time. If this information results in a claim for a change to the Contract, the Contractor shall notify the [Construction Manager][Architect] of a change through the change process.

Answered By: Kelvin Patel

Date: 05/20/2016