



PARIC CORPORATION
77 Westport Plaza Suite 250
St. Louis, MO 63146
TEL: 636-561-9500
FAX: 636-561-9501

REQUEST FOR INFORMATION

DATE: May 16, 2016

NO.: RFI-088

To: Cannon Design

Attn: Kelvin Patel

From: Paric Corporation

Requested By: Devin Gates

Project Name: Webster University Interdisciplinary Science Building

Project No.: 15051

Subject: Required clearance at loading dock

Response Required By: May 23, 2016

Drawing / Spec Reference:

Information Requested:


For coordination of overhead MEP what is the minimum clearance above the loading dock floor (relative elevation 86'-0") that must be maintained?

Response:

Provide min. 8'-0" clear height at the upper landing of the dock lift and above highest stop of dock lift.

ARCHITECT'S RESPONSE:

This information is provided as an interpretation of the Contract Documents for implementation. It is not an authorization for change to the Contract Sum or Contract Time. If this information results in a claim for a change to the Contract, the Contractor shall notify the [Construction Manager][Architect] of a change through the change process.

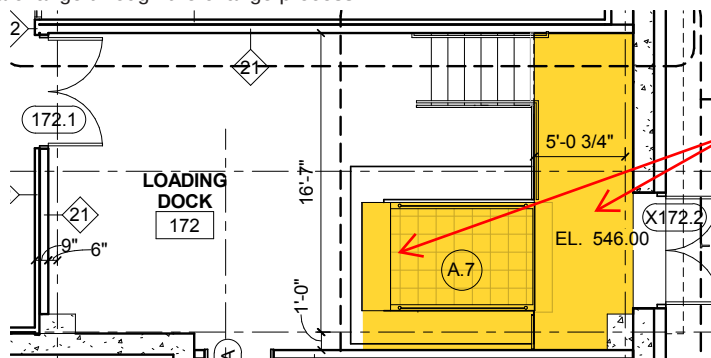

Min. 8'-0" clear height at upper landing & above lift at highest stop.

Answered By: Kelvin Patel

Date: 05/20/2016