



PARIC CORPORATION
77 Westport Plaza Suite 250
St. Louis, MO 63146
TEL: 636-561-9500
FAX: 636-561-9501

REQUEST FOR INFORMATION **DATE:** May 23, 2016 **NO.:** RFI-105

To: Cannon Design

Attn: Kelvin Patel

From: Paric Corporation

Requested By: Joe Voypick

Project Name: Webster University Interdisciplinary Science Building Project No.: 15051

Subject: stud wall needed at room 133B

Response Required By: May 30, 2016


Drawing / Spec Reference:

Information Requested:

Room 133B SIM Lab shows a furring strip at the exterior West wall, which contains a sink. The plumbing for the sink requires a 3-5/8" stud wall (minimum) to contain the piping. Please provide a 3-5/8" stud wall at this sink, or relocate the sink to an interior wall with a 3-5/8" stud (minimum).

Response:

Revise the furring partition at the exterior west wall at room 133B to type 'L3'.
See sketch with revised dimensions & partition type.
This revision will be issued in future addendum.

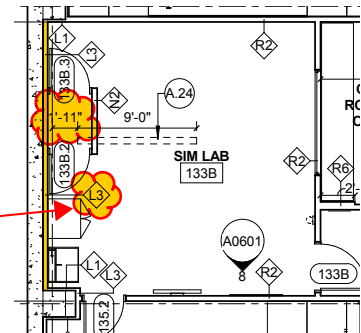

ARCHITECT'S RESPONSE:

This information is provided as an interpretation of the Contract Documents for implementation. It is not an authorization for change to the Contract Sum or Contract Time. If this information results in a claim for a change to the Contract, the Contractor shall notify the [Construction Manager][Architect] of a change through the change process.

Cc: Kathy Bathe, Paric Corporation

Answered By: Kelvin Patel

Date: 05/23/2016