



PARIC
EXPERIENCE. EXCELLENCE

PARIC CORPORATION
77 Westport Plaza Suite 250
St. Louis, MO 63146
TEL: 636-561-9500
FAX: 636-561-9501

REQUEST FOR INFORMATION **DATE:** June 03, 2016 **NO.:** RFI-151

To: Cannon Design

Attn: Kelvin Patel

From: Paric Corporation

Requested By: Joe Voypick

Project Name: 15051-Webster University Interdisciplinary Science
Building

Project No.: 15051

Subject: Exterior Frame Details

Response Required By: June 10, 2016

Drawing / Spec Reference:

Information Requested:

Please see attached. We are trying to figure out the exterior 'frames' on the building...

Response: The 10'6" dimension in question is indicated on Detail 1, Sheet A0422, as the North face of the 1¾" brake metal extrusion. See attached Sheet A0422.

ARCHITECT'S RESPONSE:


This information is provided as an interpretation of the Contract Documents for implementation. It is not an authorization for change to the Contract Sum or Contract Time. If this information results in a claim for a change to the Contract, the Contractor shall notify the [Construction Manager][Architect] of a change through the change process.

Cc: Kathy Bathe, Paric Corporation

Answered By: _____

Date: June 9, 2016

3
3" = 1'-0"

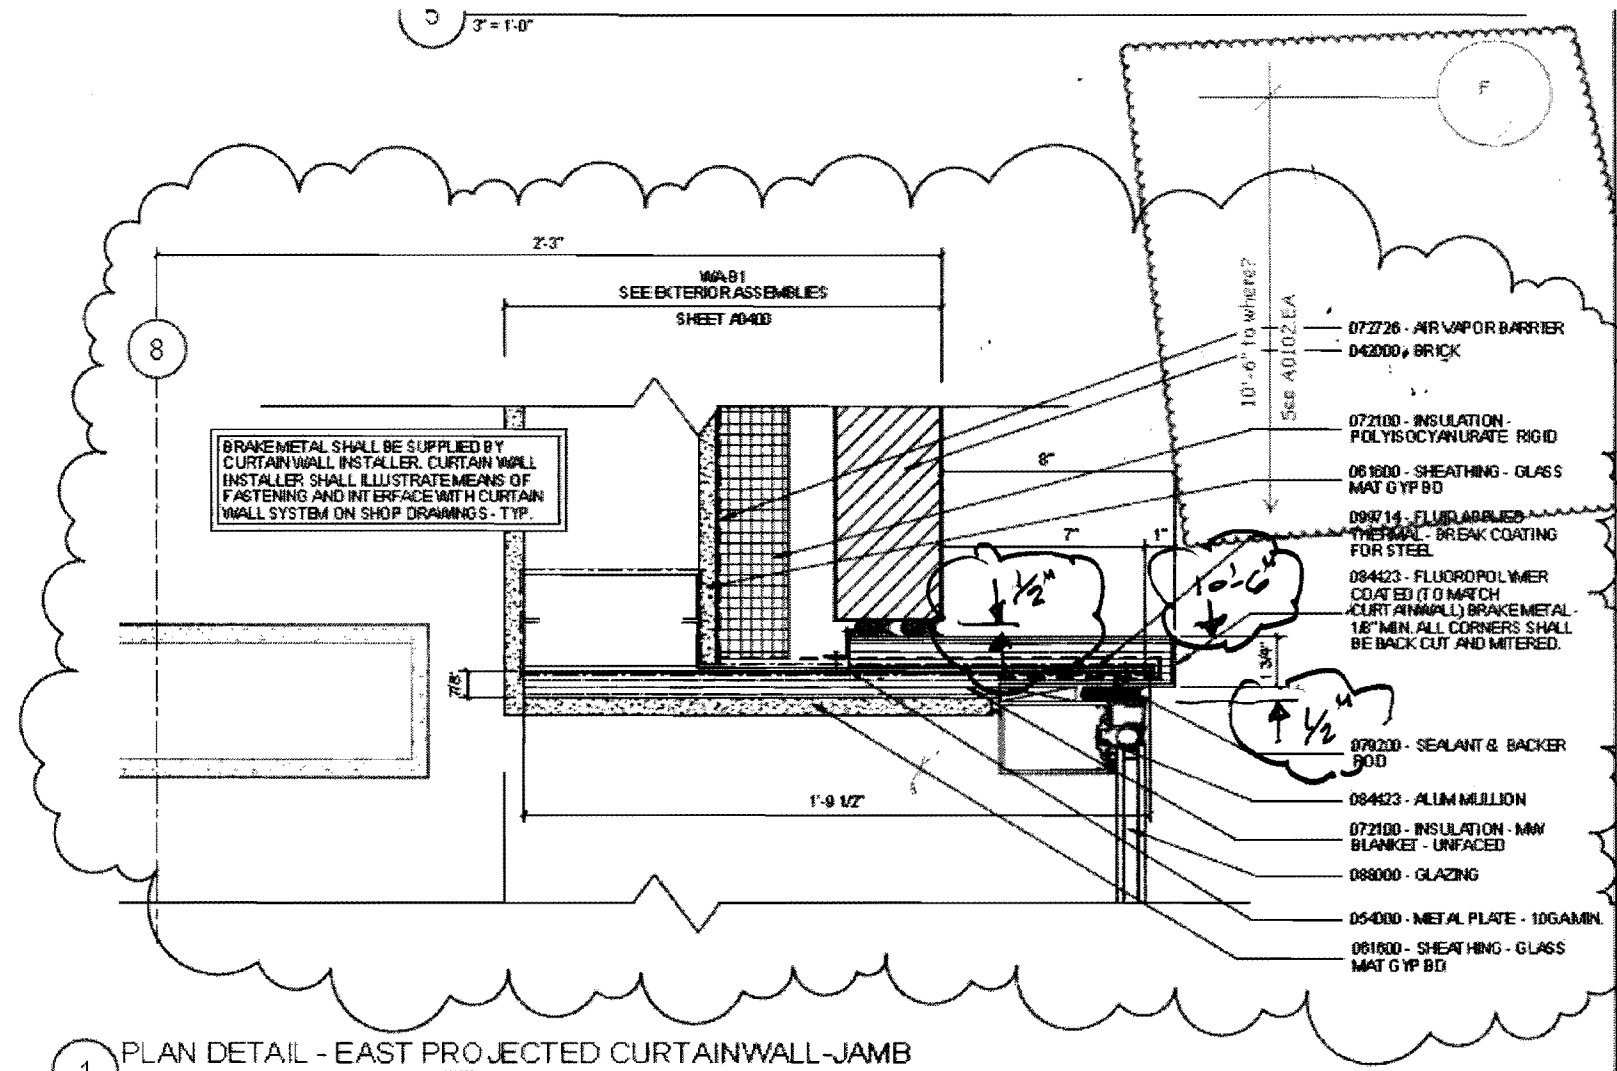

- 072726 - AIR VAPOR BARRIER
- 042000 - BRICK
- 072100 - INSULATION - POLYISOCYANURATE RIGID
- 061600 - SHEATHING - GLASS MAT GYP BD
- 084423 - FLUOROPOLYMER COATED (TO MATCH CURTAINWALL) BRAKEMETAL 1/8" MIN. ALL CORNERS SHALL BE BACK CUT AND MITERED.
- 070200 - SEALANT & BACKER ROD
- 084423 - ALUM MILLION
- 072100 - INSULATION - MINI BLANKET - UNFACED
- 088000 - GLAZING
- 054000 - METAL PLATE - 10GALV.
- 061600 - SHEATHING - GLASS MAT GYP BD

1 ADDENDUM 1-1		29 JAN 2016
ISSUED FOR CONSTRUCTION (BP1)		15 JAN 2016
No.	Description	Date

Drawing Title:

EXTERIOR PLAN DETAILS

Project No.: 04561.01 Checked by:

A0422

1 PLAN DETAIL - EAST PROJECTED CURTAINWALL-JAMB
3" = 1'-0"