



PARIC CORPORATION
77 Westport Plaza Suite 250
St. Louis, MO 63146
TEL: 636-561-9500
FAX: 636-561-9501

REQUEST FOR INFORMATION **DATE:** June 10, 2016 **NO.:** RFI-161

To: Cannon Design

Attn: Kelvin Patel

From: Paric Corporation

Requested By: Joe Voypick

Project Name: 15051-Webster University Interdisciplinary Science Building Project No.: 15051

Subject: Paver Drains on Lvl 02 Area B exterior walkway

Response Required By: June 17, 2016

Drawing / Spec Reference:

Information Requested:

Sheet A0423, Detail 4 shows two sets of primar/overflow area drains in the area near C-1.6. The plumbing plans P0101.B/P0102.B do not show any piping or area drains in this area. Please advise if they are required.

Response: These have been added to the drawings, and will be issued in an up-coming addendum.


ARCHITECT'S RESPONSE:

This information is provided as an interpretation of the Contract Documents for implementation. It is not an authorization for change to the Contract Sum or Contract Time. If this information results in a claim for a change to the Contract, the Contractor shall notify the [Construction Manager][Architect] of a change through the change process.

Cc: Kathy Bathe, Paric Corporation

Answered By: Mike Whitworth

Date: June 11, 2016

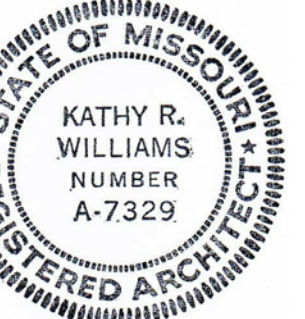

Kathy R. Williams
3.16.16


2	ADDENDUM 1-7	16 MAR 2016
1	ADDENDUM 1-1	29 JAN 2016
-	ISSUED FOR CONSTRUCTION (BP1)	15 JAN 2016
No.	Description	Date

Drawing Title:

EXTERIOR PLAN DETAILS

Project No.: 04561.01 Checked by:


A0423

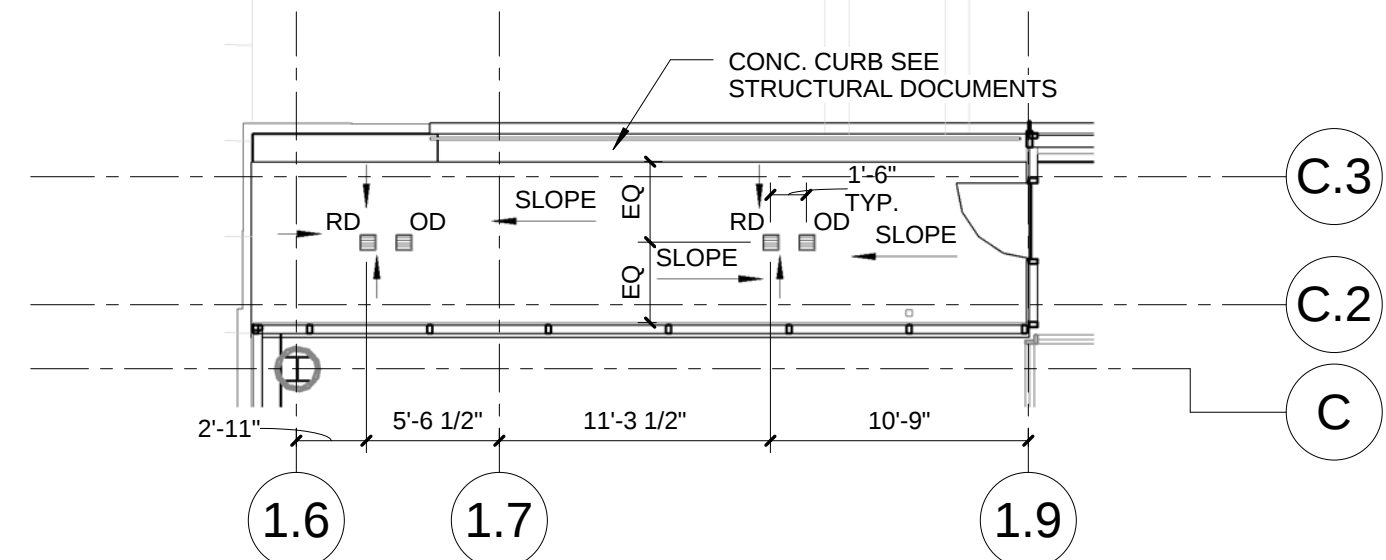


NOTE:

1. DRAINS TO BE SET 1" BELOW THE TOP OF SLAB. CONCRETE SLABS TO BE 4-WAY SLOPED TO DRAINS, 1/4" PER FOOT (SEE STRUCTURAL DOCUMENTS)
2. PAVERS NOT SHOWN FOR CLARITY (SEE LANDSCAPE DOCUMENTS)

4 PLAN DETAIL - NORTH PAVER ROOF PLAN
1/8" = 1'-0"

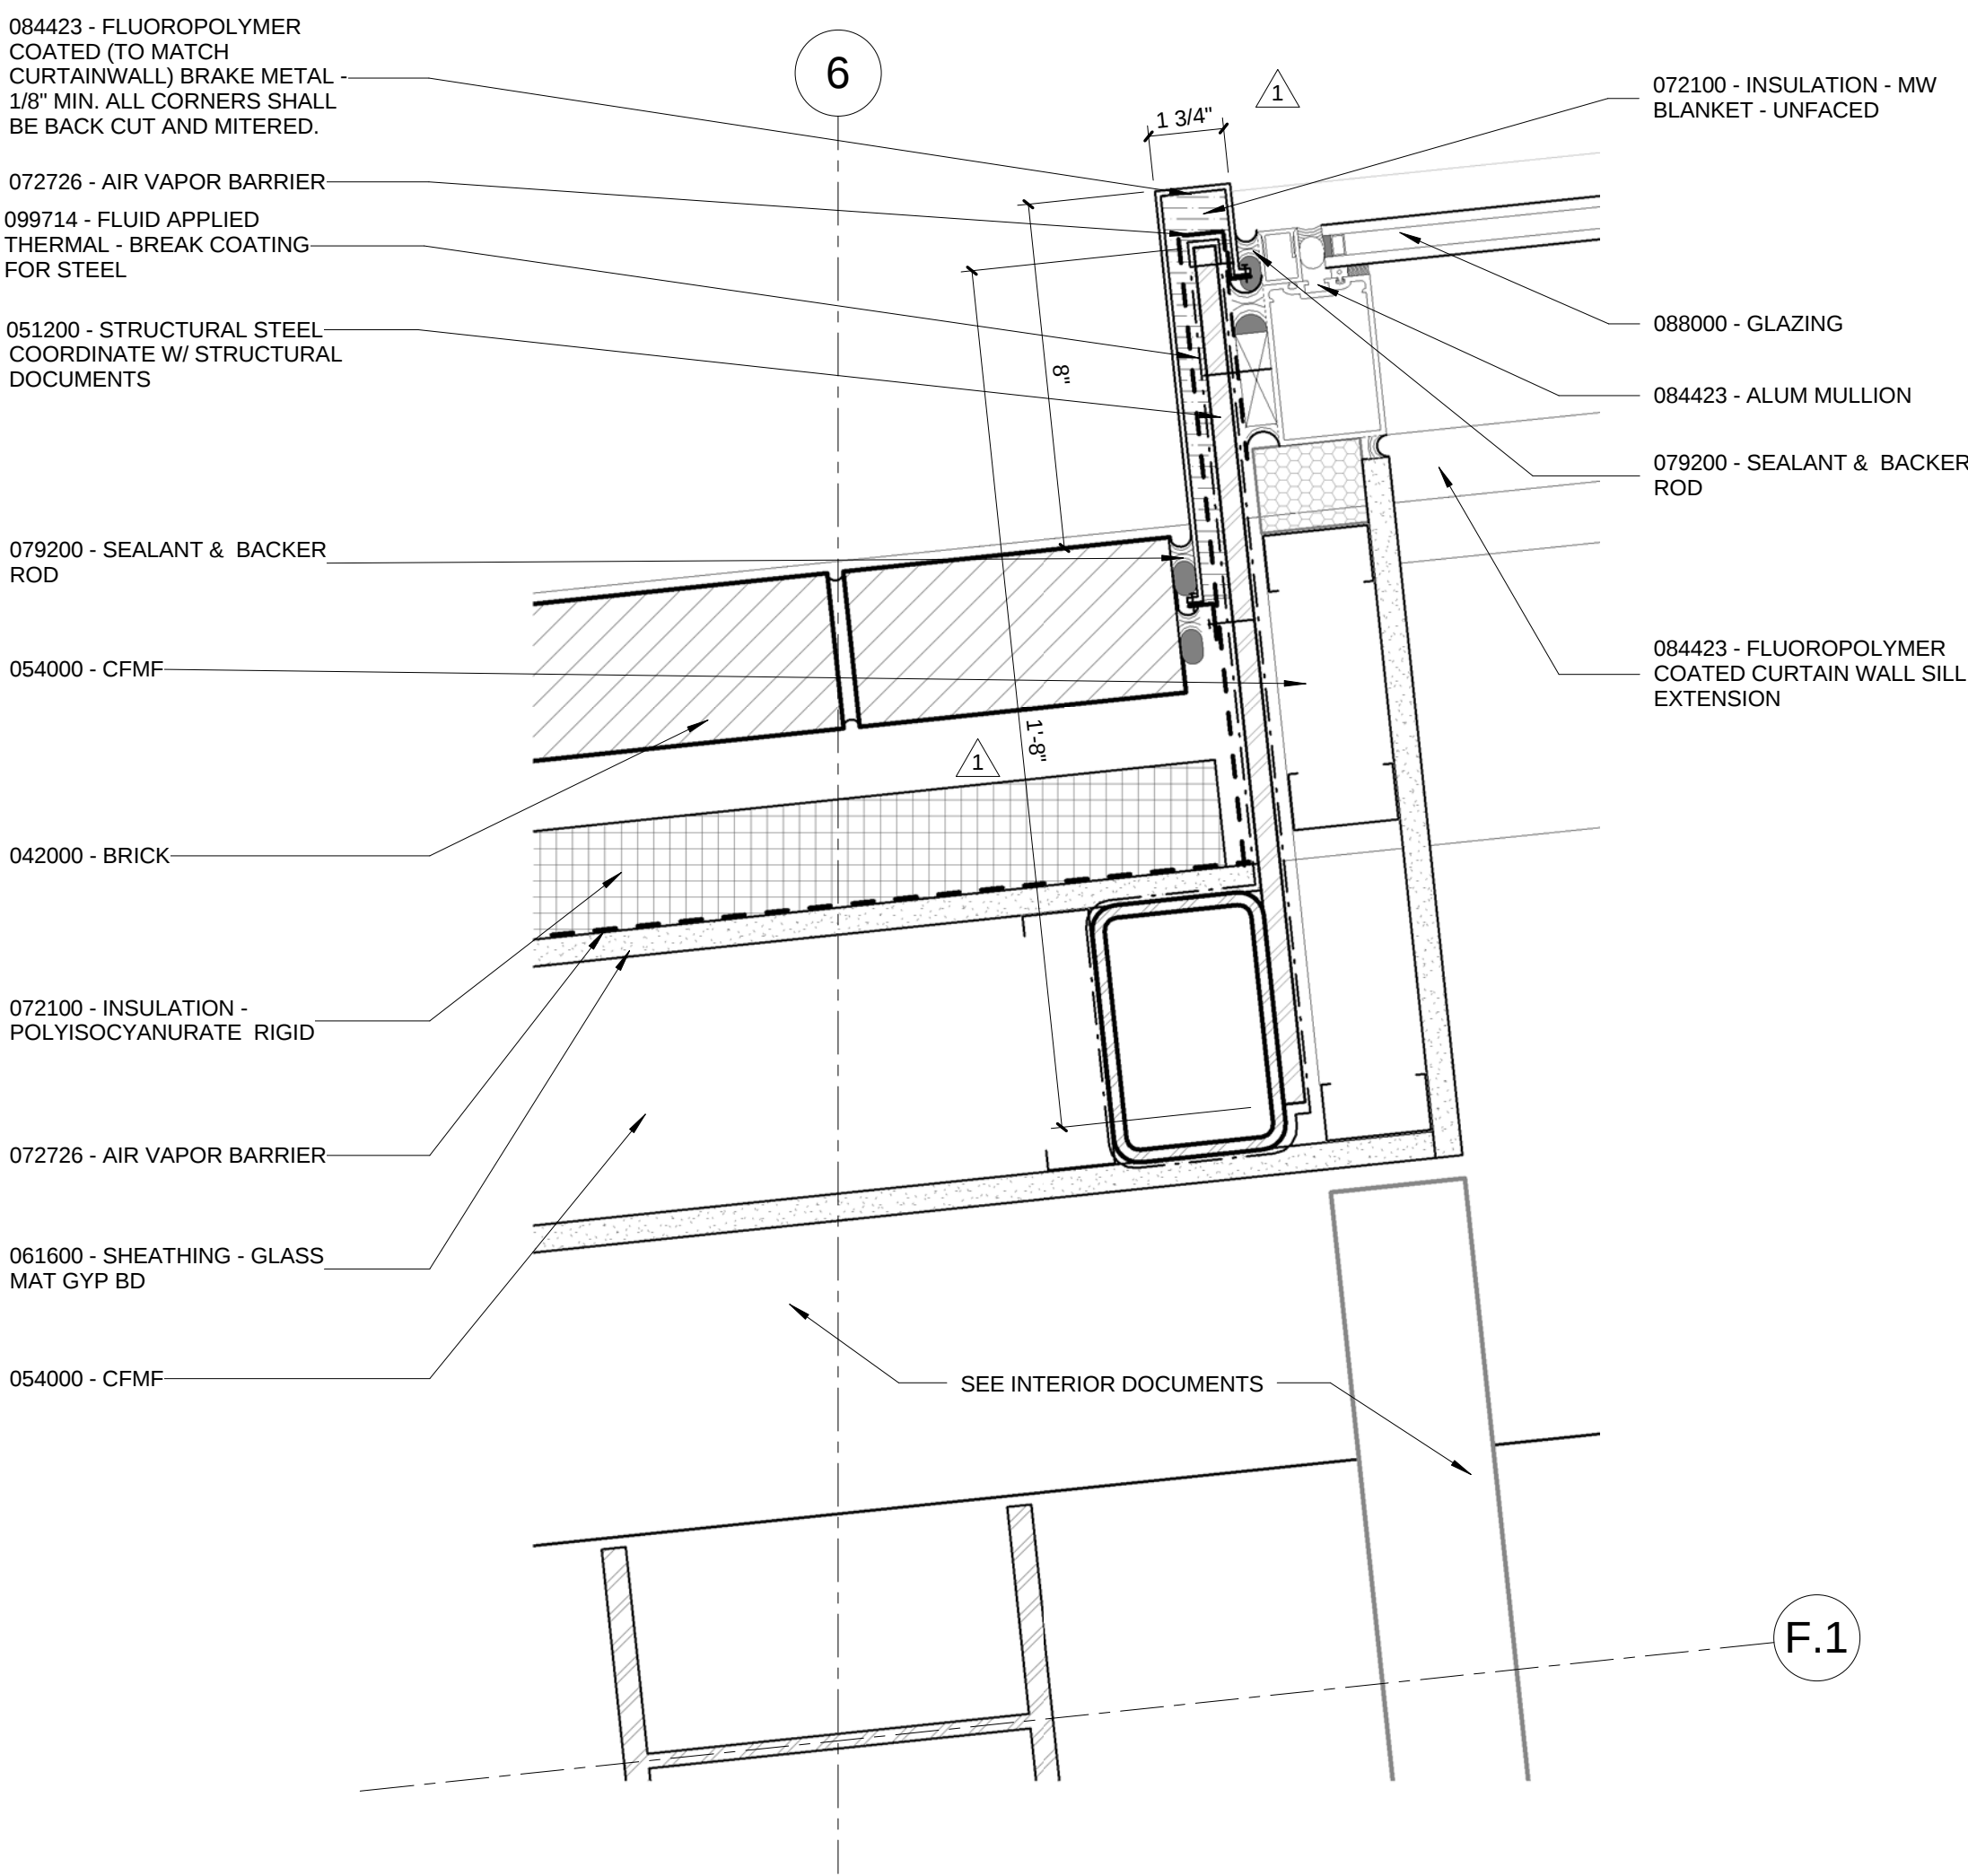

1 PLAN DETAIL - NORTH PROJECTED CURTAINWALL
3" = 1'-0"

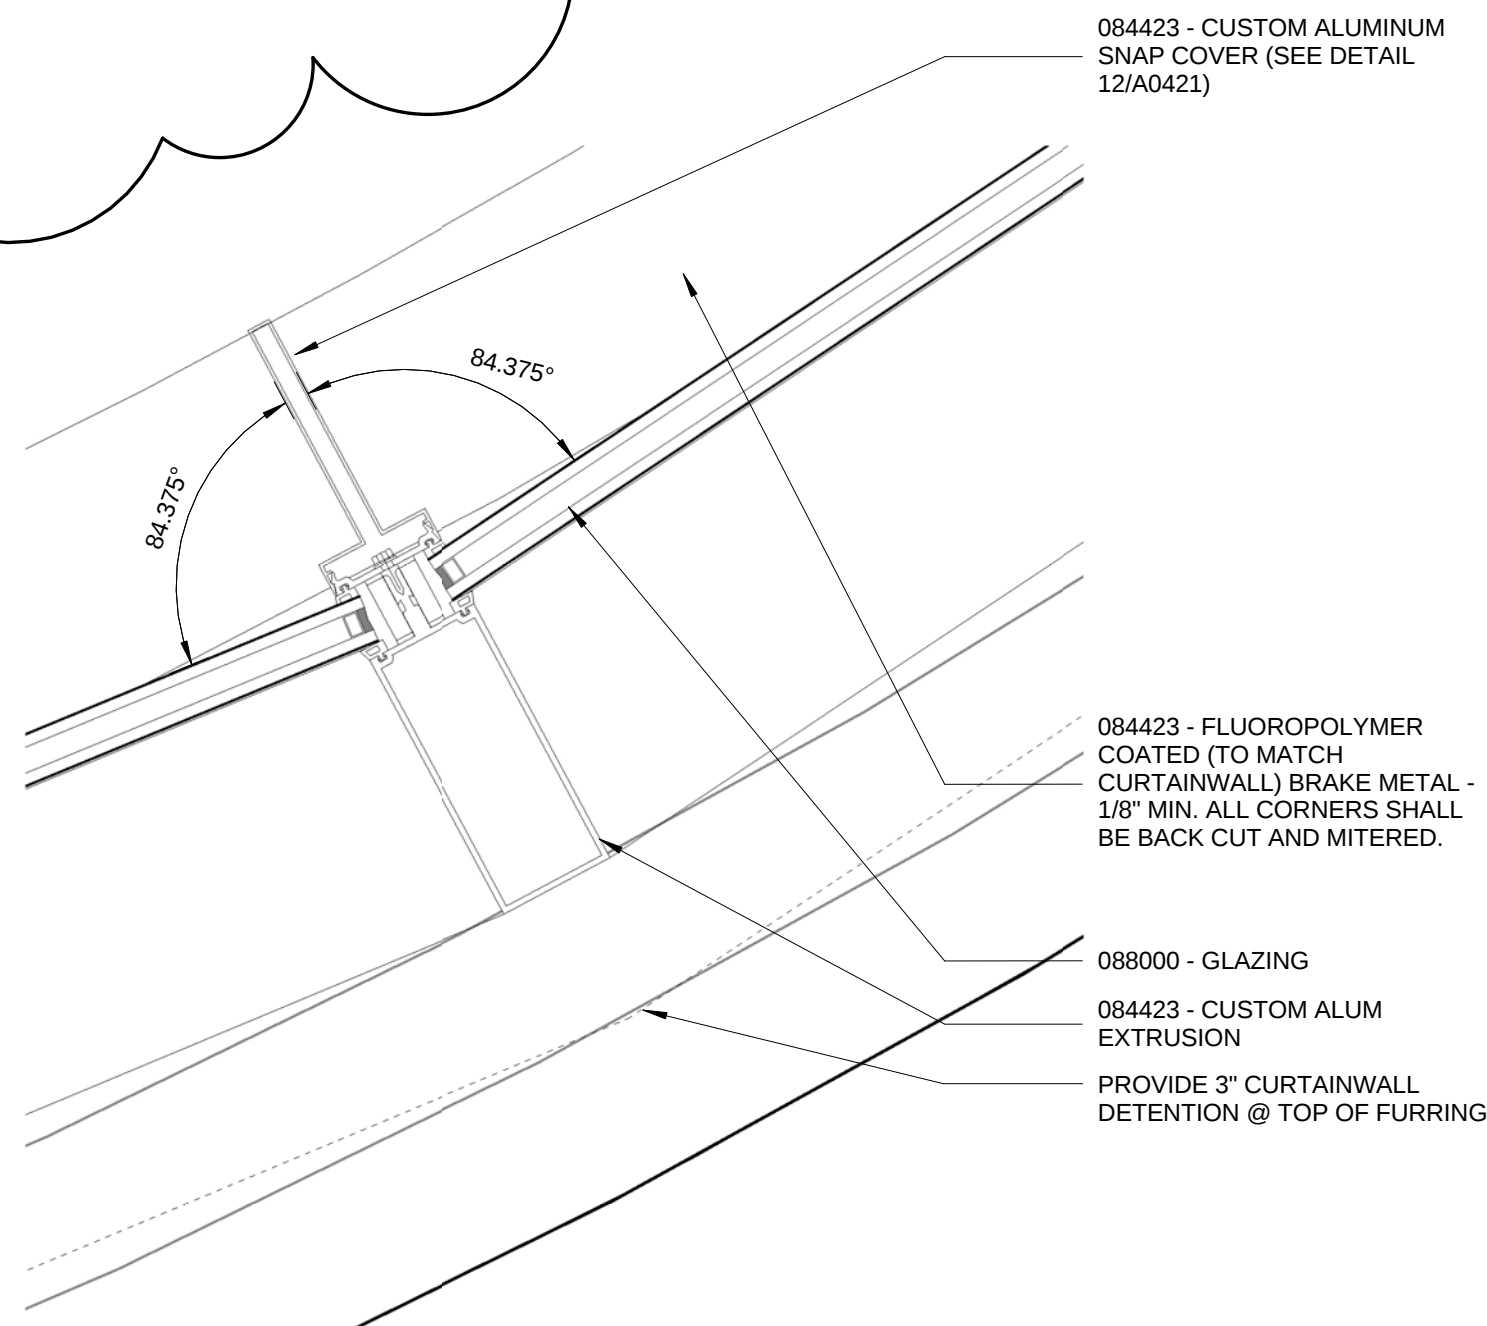

2 PLAN DETAIL - CUSTOM MULLION @ CURVED CURTAINWALL
3" = 1'-0"

3 PLAN DETAIL - GREEN ROOF & SOUTH PAVER ROOF
1/8" = 1'-0"

NOTE:

1. PAVER ROOF DECK: DRAINS TO BE SET 1" BELOW THE TOP OF SLAB. CONCRETE SLAB TO BE 4-WAY SLOPED TO DRAINS, 1/4" PER FOOT (SEE STRUCTURAL DOCUMENTS)
2. GREEN ROOF DECK: DRAINS TO BE INSTALLED FLUSH WITH CONC. DECK. CONCRETE SLAB 2-WAY SLOPE TO DRAINS
3. PAVERS NOT SHOWN FOR CLARITY (SEE LANDSCAPE DOCUMENTS)