



PARIC CORPORATION
77 Westport Plaza Suite 250
St. Louis, MO 63146
TEL: 636-561-9500
FAX: 636-561-9501

REQUEST FOR INFORMATION	DATE: June 20, 2016	NO.: RFI-176
--------------------------------	----------------------------	---------------------

To: Cannon Design

Attn: Kelvin Patel

From: Paric Corporation

Requested By: Joe Voypick

Project Name: 15051-Webster University Interdisciplinary Science Building	Project No.: 15051
---	--------------------

Subject: Plumbing Stacks South of B-line, Levels 02, 03, and 04

Response Required By: June 27, 2016

Drawing / Spec Reference:

Information Requested:

Level 02

In Room 272A Chem Stock, there are two 3" plumbing sanitary stacks in the far West of the room. The plans show the stacks offsetting to the West as they rise up through the building. There is a steel element under the Level 01 slab which forces the plumbing stacks out to the indicated dimension (see attached) through the Level 01 slab. In the Level 02 space, there appears to be a type of shaft stud partition along the West wall of 272A. If the plumbing pipes are to offset to the West, tight to the West wall, they would be overlapping this stud partition as they travel up the building, and miss the steel elements in the Level 02 ceiling.

Please verify that it is acceptable to have the plumbing pipes overlapping this partition, or if the plumbing stacks should run straight up and down through the building at the indicated dimensions.

Level 03

Room 372C – Two 3" plumbing sanitary stacks are exposed in the room, and conflict with shelving units. Shelves would have to shift 5 inches East to miss the plumbing stacks.

Room 372B – Two 3" plumbing storm stacks are exposed in the room. The column enclosure would have to be extended North, with the finished drywall at the dimension noted on the attached screenshot.

Level 04

Room 472 – 3" plumbing vent stack is exposed in the room. It is a far distance from any adjacent corner. Please confirm this exposed pipe is acceptable. There is also an exposed storm stack. The finished wall of the column enclosure would need to shift 6 inches North to the dimension indicated.

Answered By: _____

Date: _____



Response:

.

ARCHITECT'S RESPONSE:

This information is provided as an interpretation of the Contract Documents for implementation. It is not an authorization for change to the Contract Sum or Contract Time. If this information results in a claim for a change to the Contract, the Contractor shall notify the [Construction Manager][Architect] of a change through the change process.

Cc: Kathy Bathe, Paric Corporation

The two 3 inch risers on the west wall have been shifted to the south, to run within the furred out space around the column.

.

The Architect is addressing the furred out spaces along the east wall

.


Refer to notes on the attached sketches.

.

This will be addressed in an up coming ASI.

Answered By: Mike Whitworth - WES

Date: June 26, 2016

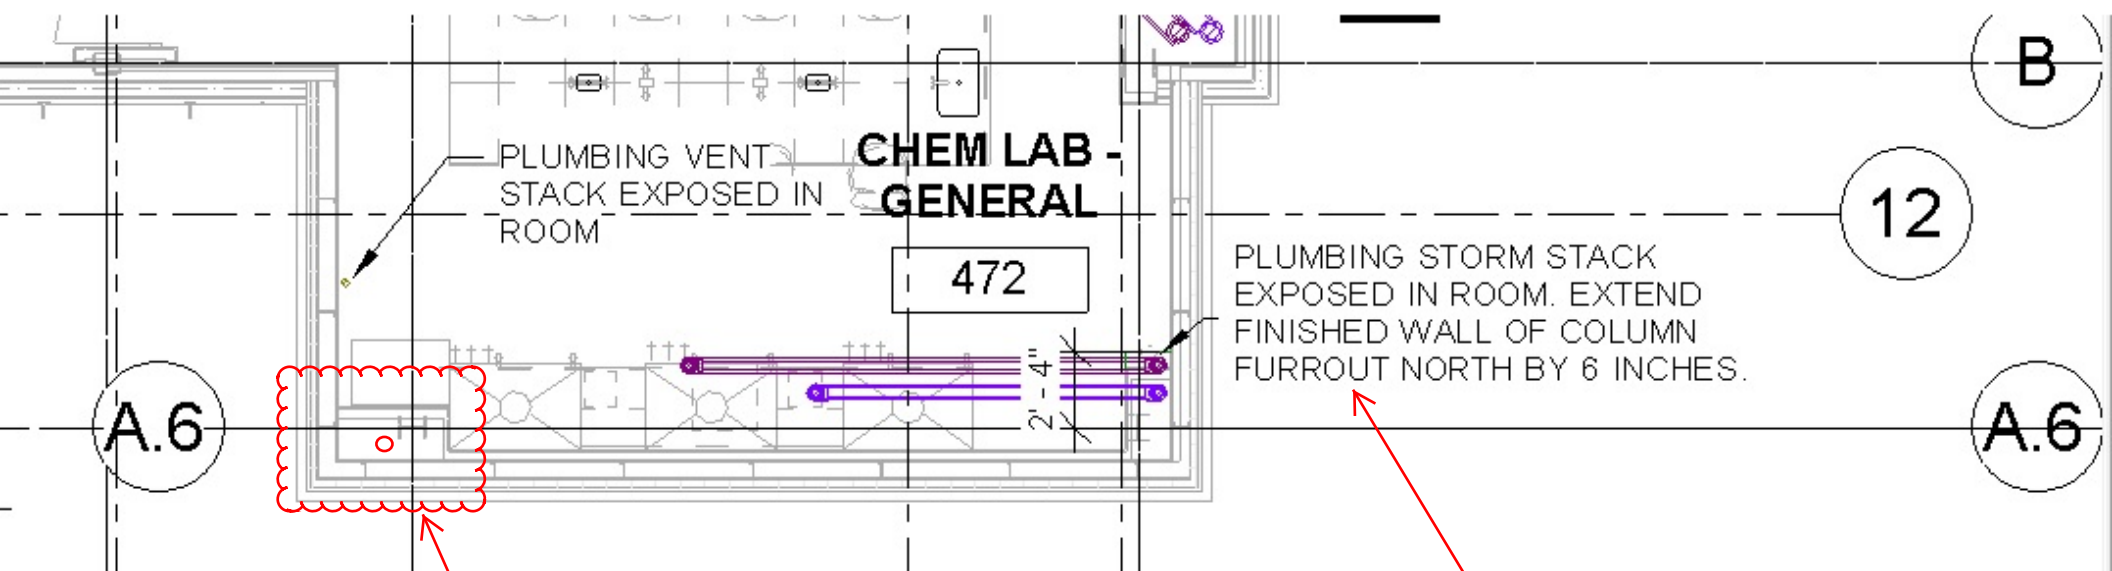

Plumbing risers will be shifted to extend within the furred out space around the column

The Architect is addressing this

EXPOSED VENT
STACK IN LEVEL 04
ROOM 472

LEVEL 04
130' - 8"



COL.
7.1

2' - 0 1/2"

EXPOSED STACKS IN LEVEL
03, ROOM 372C, CONFLICTING
WITH SHELVING

LEVEL 03
115' - 4"



OFFSET TO OVERLAP
PARTITION ABOVE CEILING

EXPOSED STACKS IN
LEVEL 02, ROOM 272A

STACKS COMING UP
0' - 11 7/8"
THROUGH LEVEL 02 SLAB

LEVEL 02
100' - 0"



OFFSET STACKS TO MISS
STEEL SUPPORTING
LEVEL 02 SLAB

7

8

