



PARIC CORPORATION
77 Westport Plaza Suite 250
St. Louis, MO 63146
TEL: 636-561-9500
FAX: 636-561-9501

REQUEST FOR INFORMATION	DATE: July 22, 2016	NO.: RFI-214
--------------------------------	----------------------------	---------------------

To: Cannon Design

Attn: Kelvin Patel

From: Paric Corporation

Requested By: Joe Voypick

Project Name: 15051-Webster University Interdisciplinary Science Building	Project No.: 15051
---	--------------------

Subject: Fall Protection Design

Response Required By: July 29, 2016

Drawing / Spec Reference:

Information Requested:

Probel originally submitted their drawings based on the architectural layout, and used that layout to indicate which two anchors they wanted/needed to relocate so that they could take responsibility of the fall protection system. Since this would require relocating the 12x6 tubes the anchors are attached to; Atlas feels the design team should review and approve the change. If this is an acceptable change, then Atlas expects Probel to re-issue drawings for approval based on the structural layout (per RFI 188), adding the (3) anchors and the +/-25' of cable.

Response:


Not in KWA's scope of work. Specification Section 110140, paragraph 1.7 A, fall protection design shall be delegated.


ARCHITECT'S RESPONSE:

This information is provided as an interpretation of the Contract Documents for implementation. It is not an authorization for change to the Contract Sum or Contract Time. If this information results in a claim for a change to the Contract, the Contractor shall notify the [Construction Manager][Architect] of a change through the change process.



Answered By: _____

Date: 08/03/16 _____

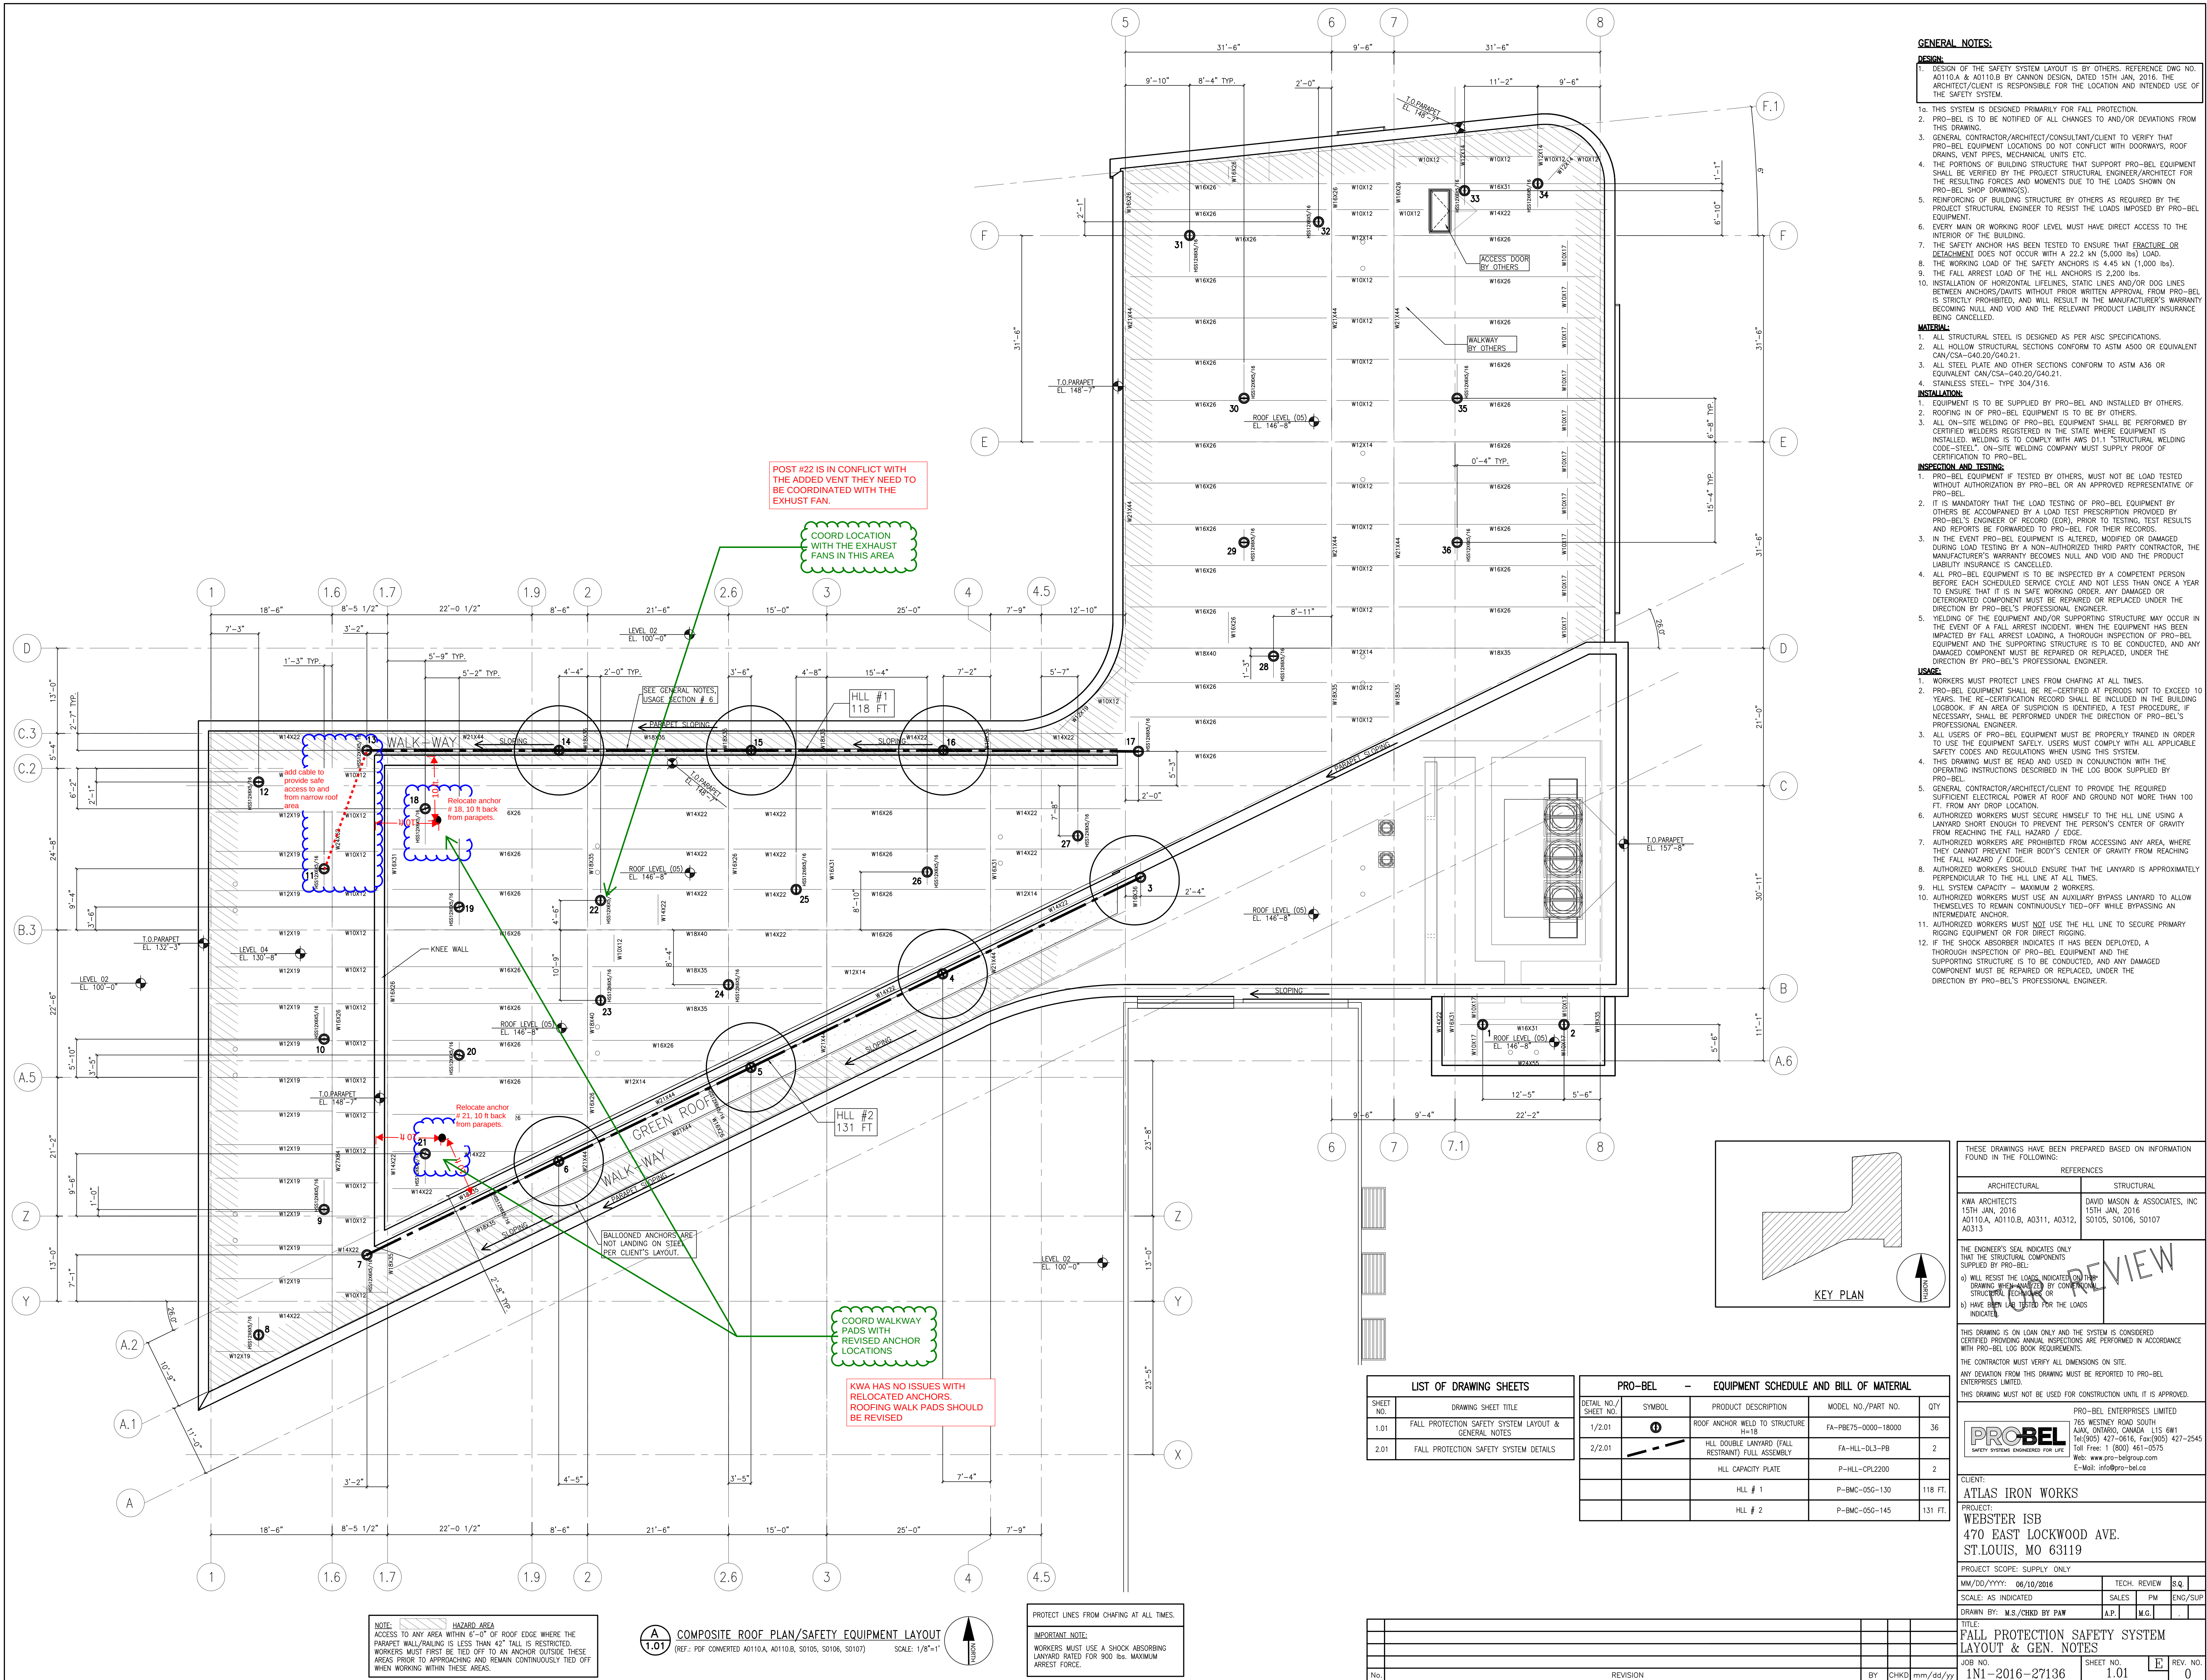

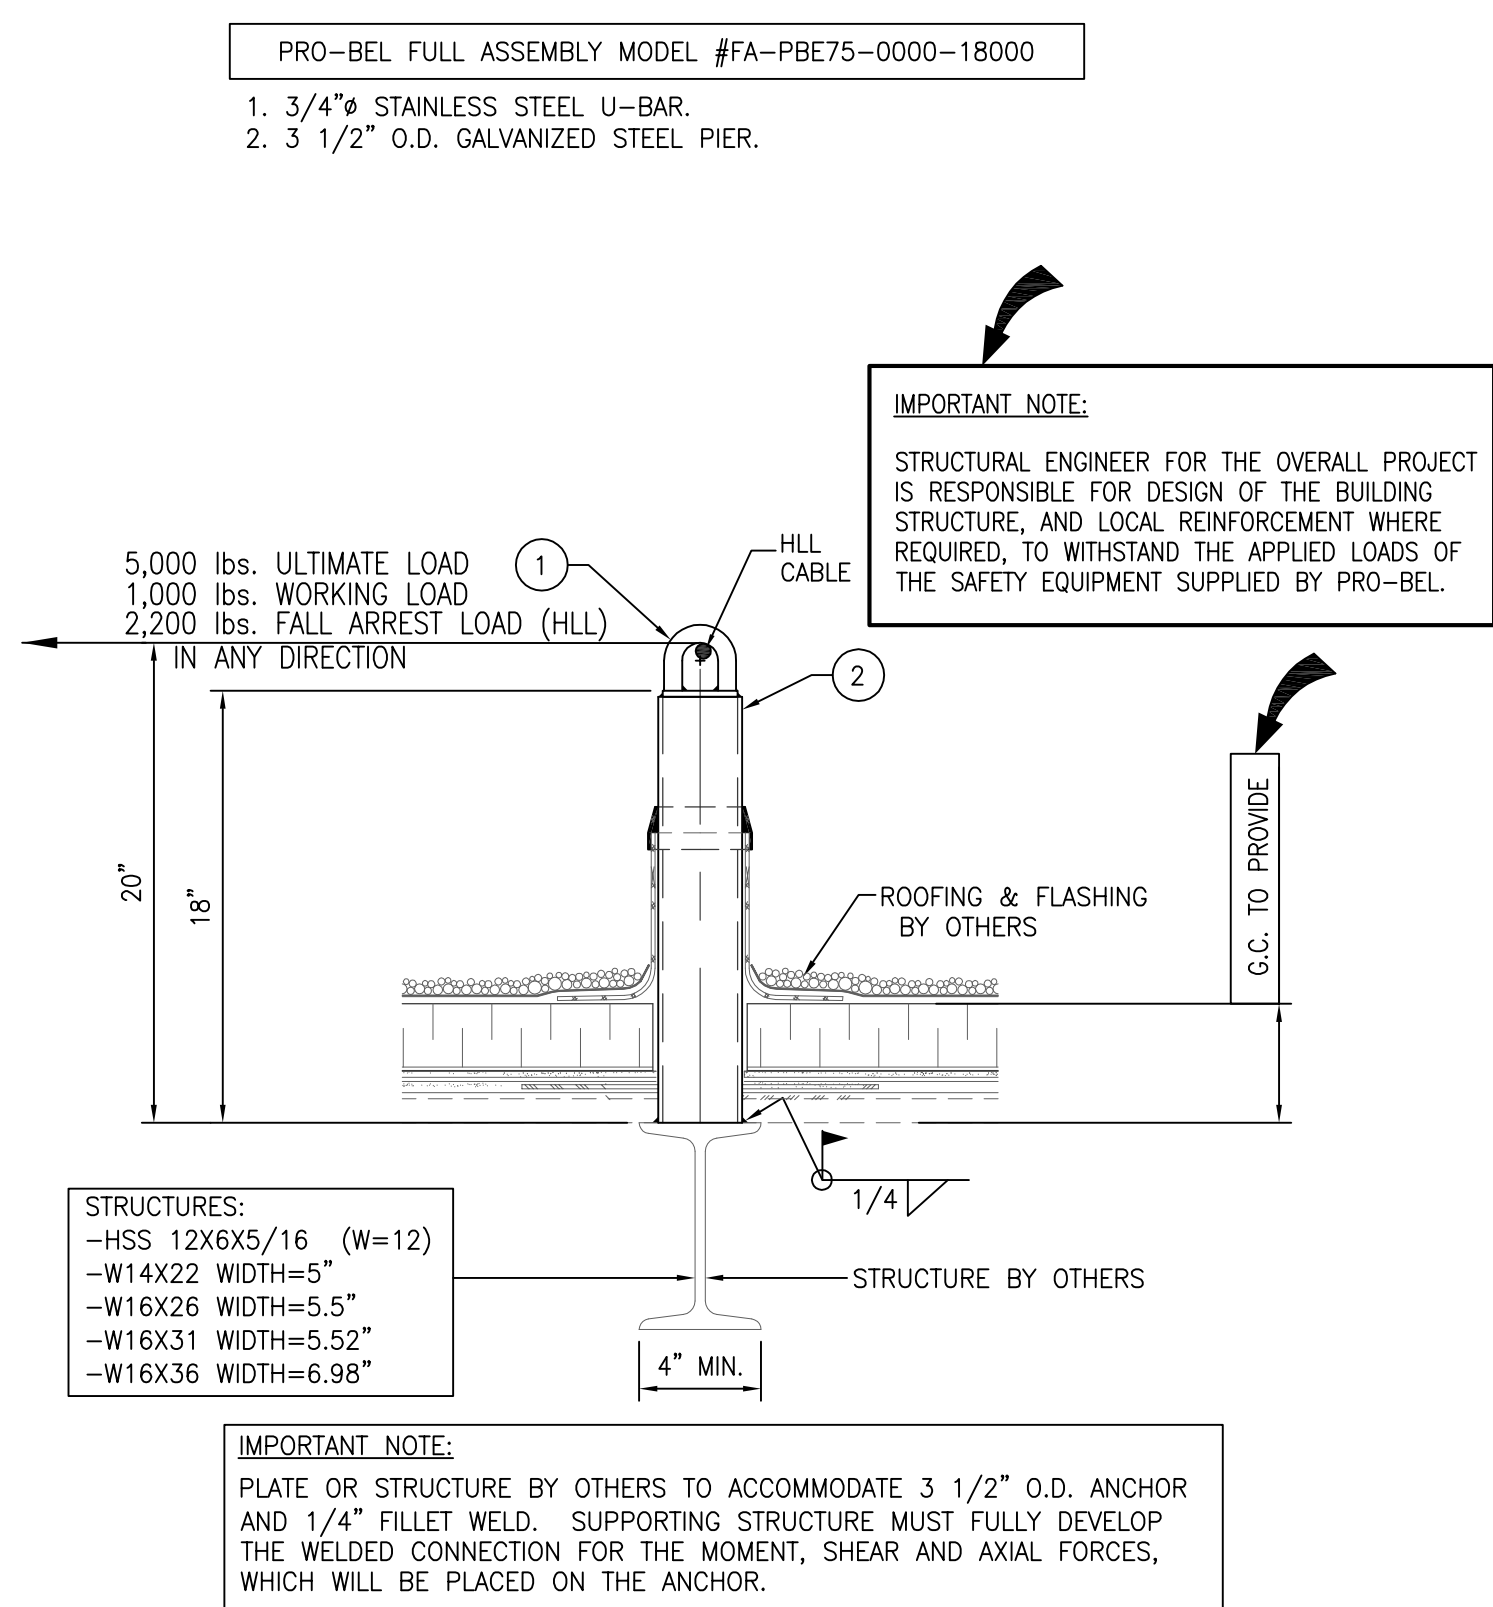

1
2.01
ROOF ANCHOR WELDED TO STRUCTURE
(REF.:)
SCALE: 1 1/2"=1'-0"

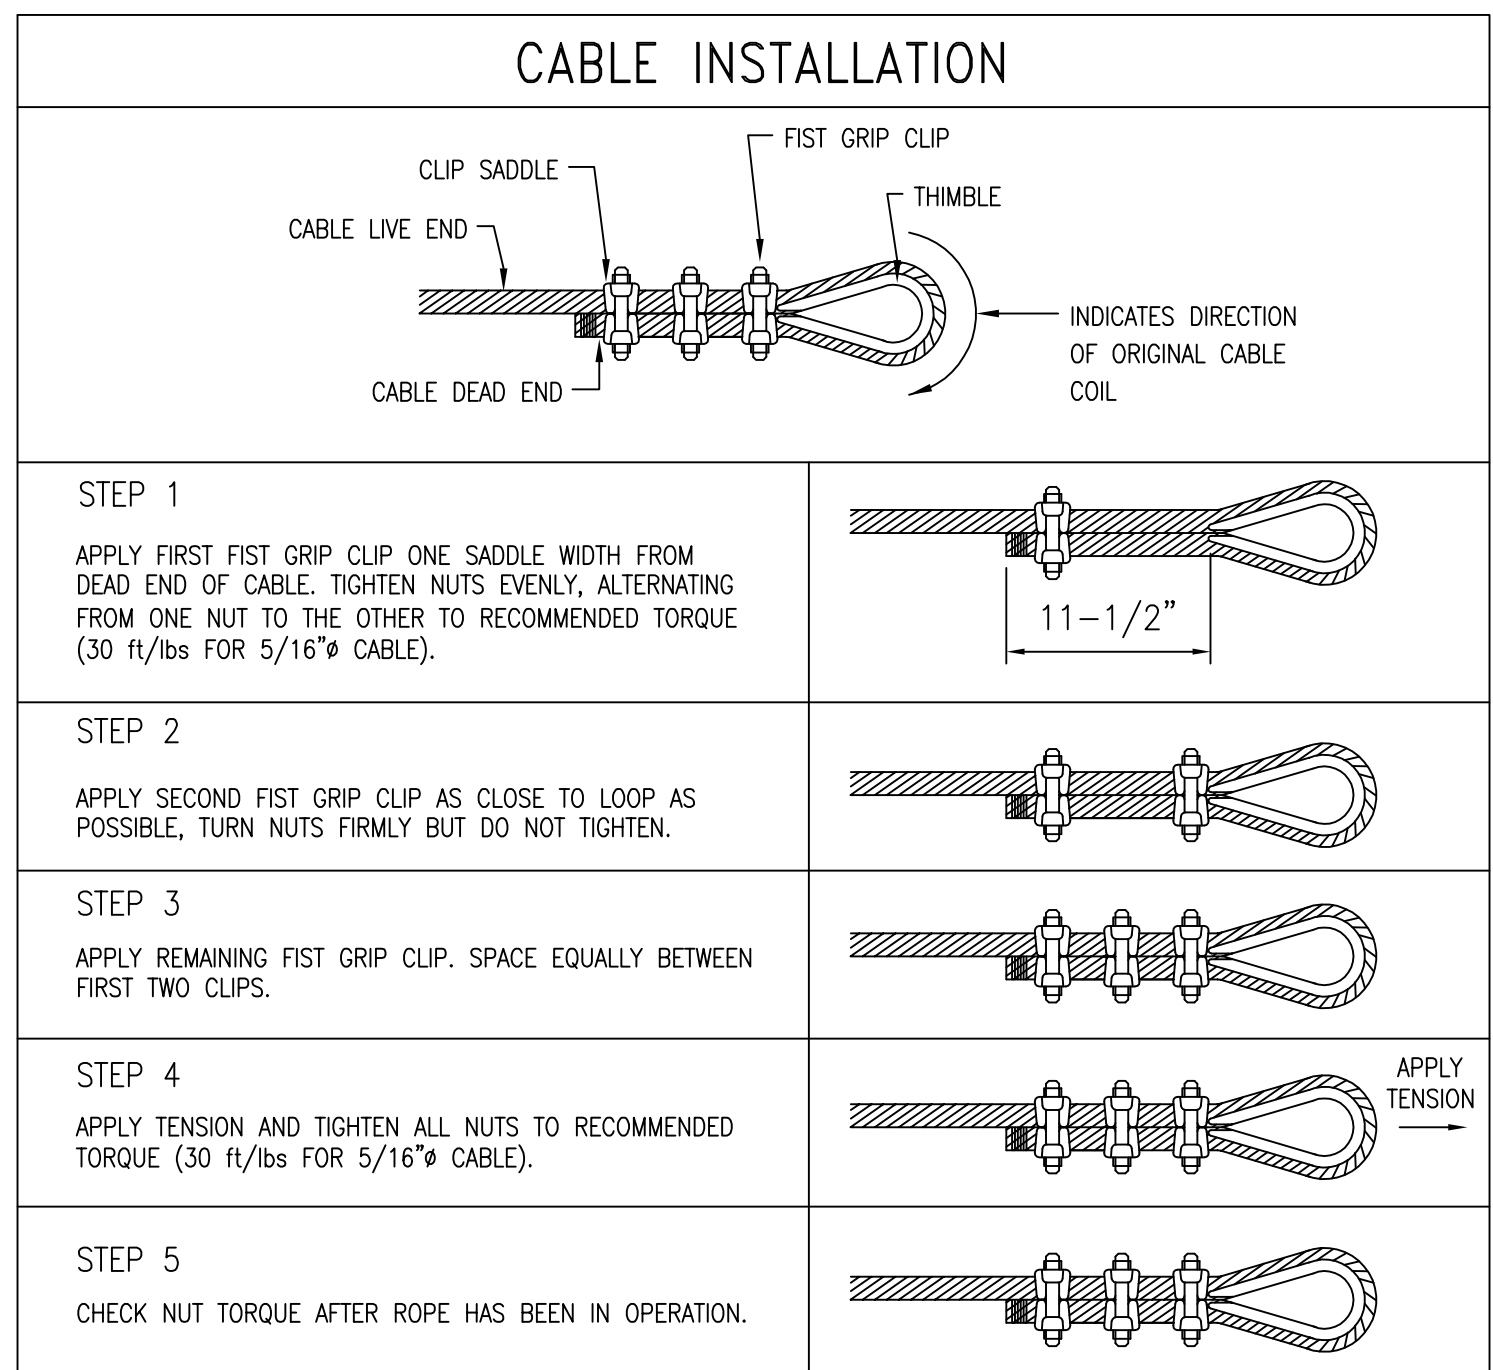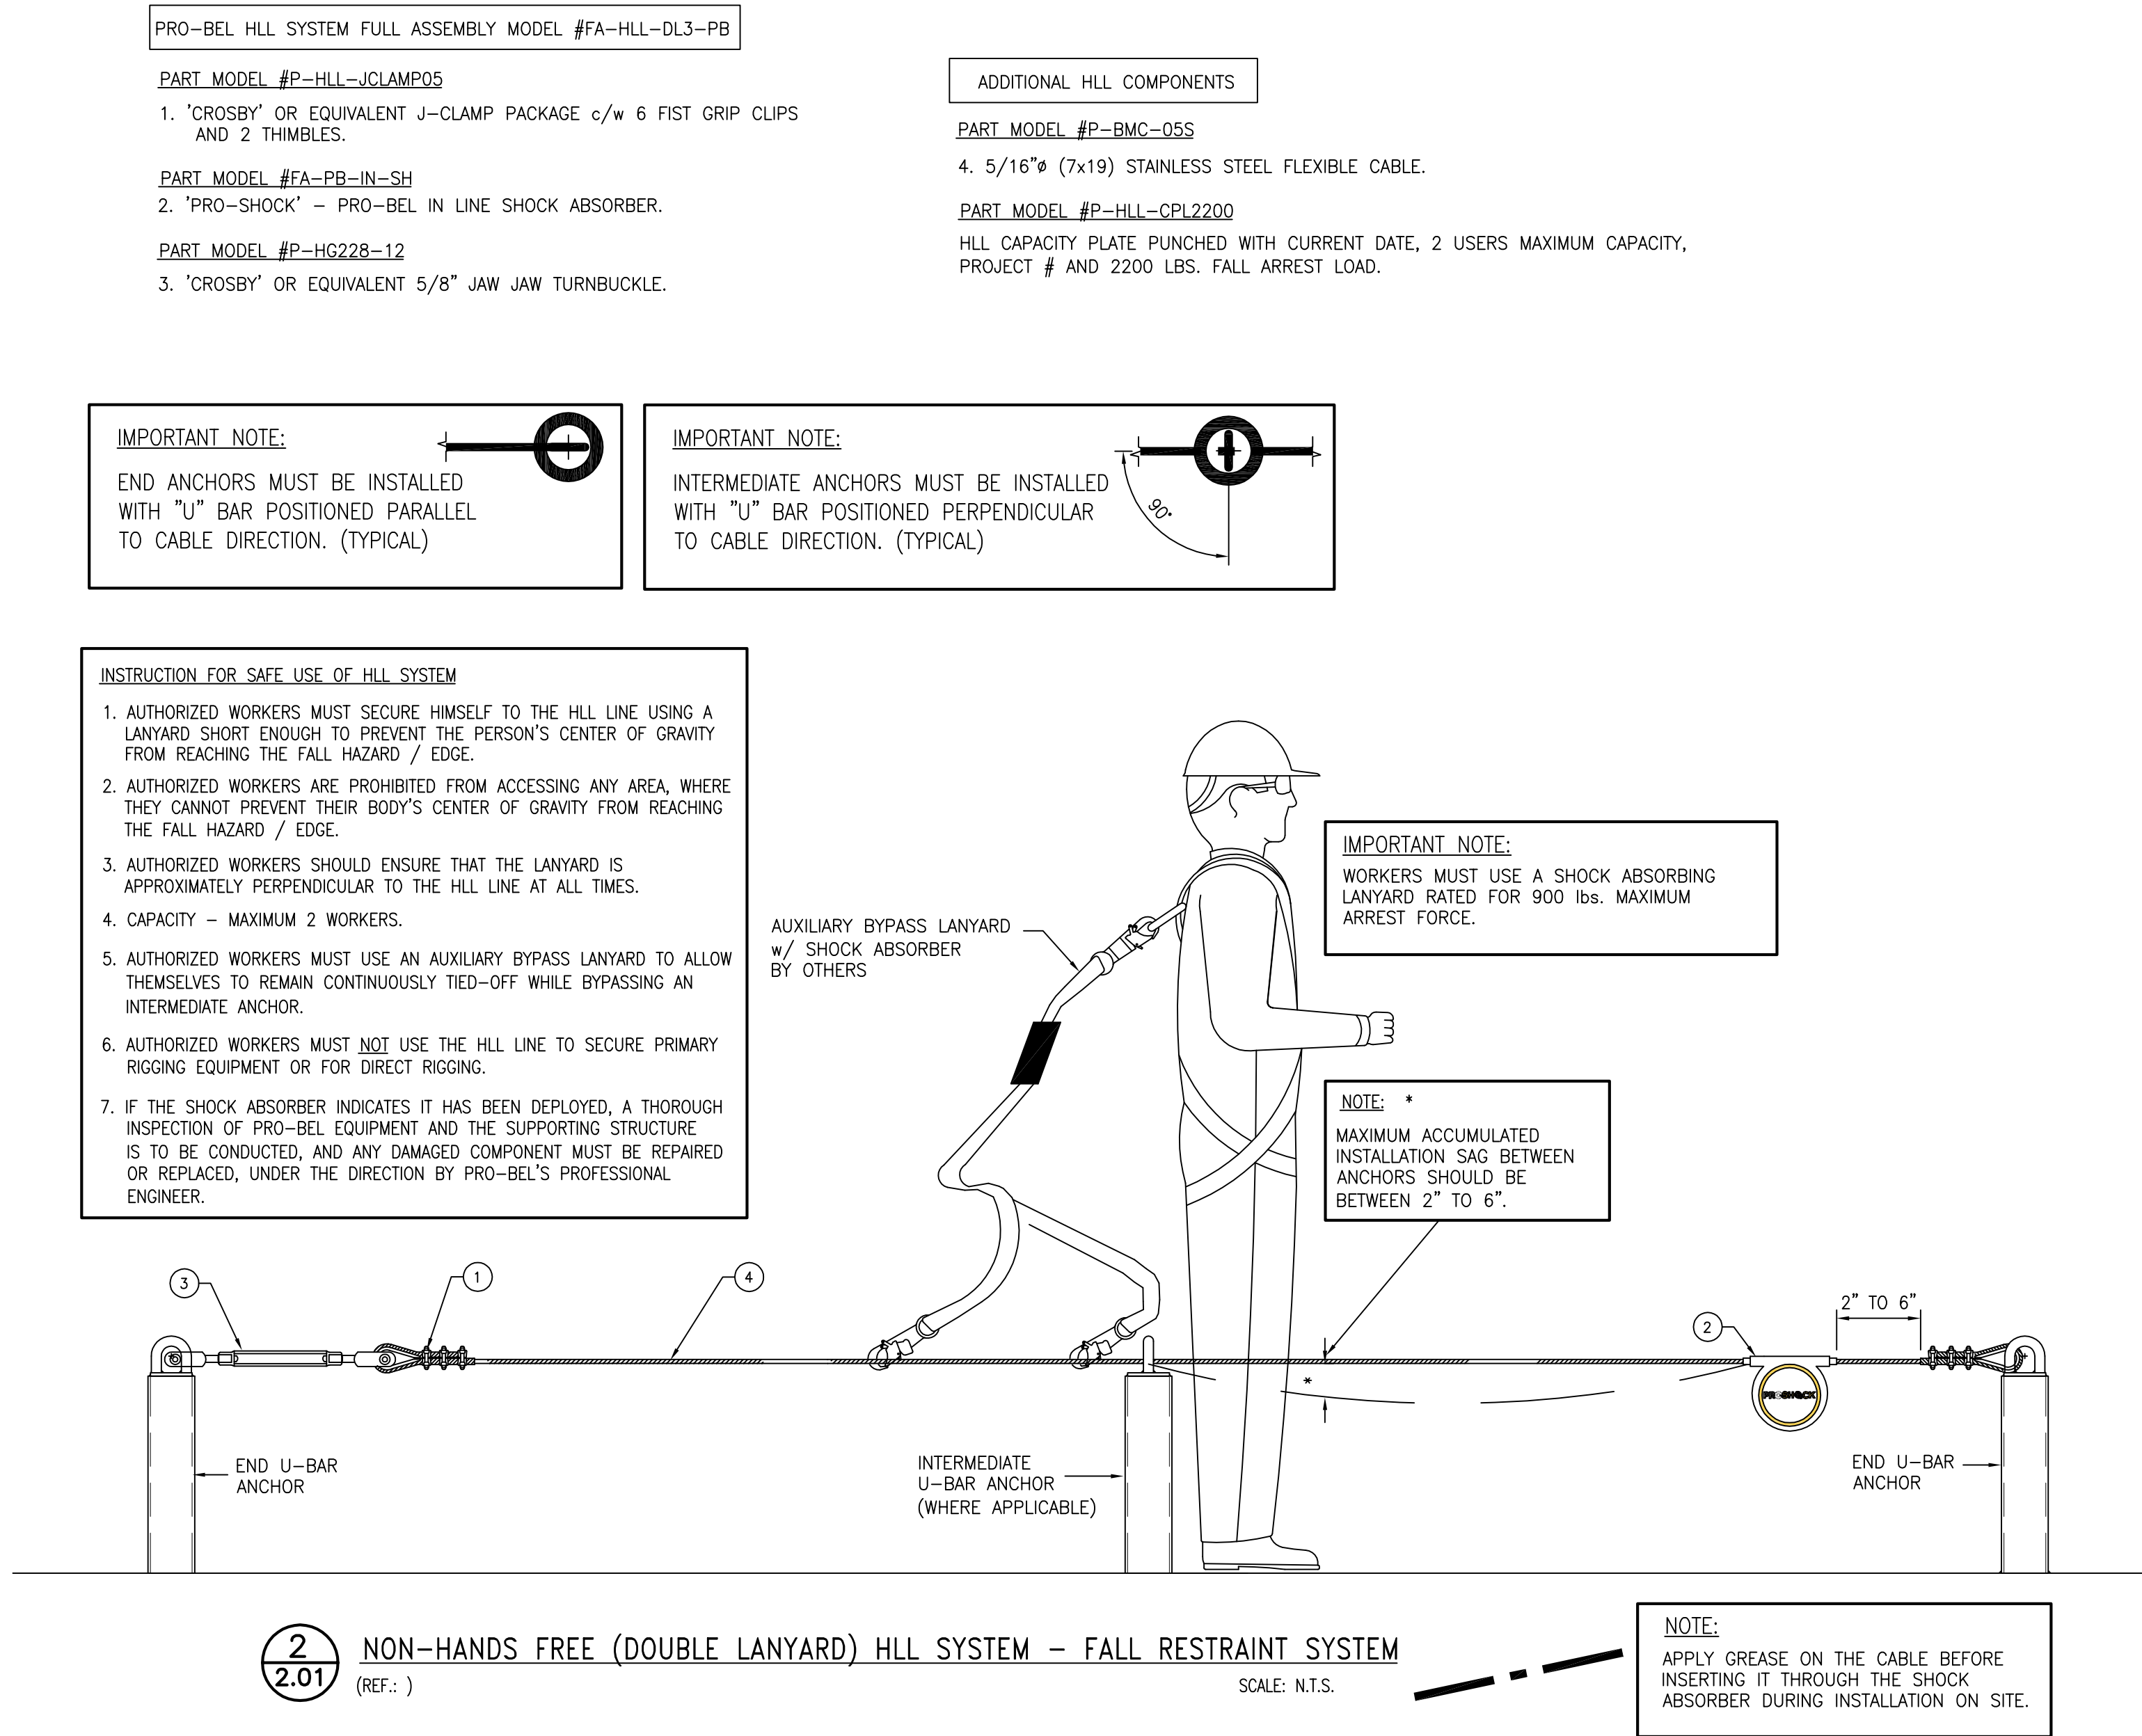

GENERAL NOTES - SEE SHEET 1.01

THE ENGINEER'S SEAL INDICATES ONLY THAT THE STRUCTURAL COMPONENTS SUPPLIED BY PRO-BEL.

a) WILL RESIST THE LOADS INDICATED ON THIS DRAWING WHEN INSTALLED BY CONVENTIONAL STRUCTURAL TECHNIQUES OR

b) HAVE BEEN TESTED FOR THE LOADS INDICATED.

THIS DRAWING IS ON LOAN ONLY AND THE SYSTEM IS CONSIDERED CERTIFIED PROVIDING ANNUAL INSPECTIONS ARE PERFORMED IN ACCORDANCE WITH PRO-BEL LOG BOOK REQUIREMENTS.

THE CONTRACTOR MUST VERIFY ALL DIMENSIONS ON SITE. ANY DEVIATION FROM THIS DRAWING MUST BE REPORTED TO PRO-BEL ENTERPRISES LIMITED.

THIS DRAWING MUST NOT BE USED FOR CONSTRUCTION UNTIL IT IS APPROVED.

PRO-BEL ENTERPRISES LIMITED
765 WESTNEY ROAD SOUTH
KANK, ONTARIO, CANADA L1S 6W1
Tel:(905) 427-0616, Fax:(905) 427-2545
Toll Free: 1 (800) 461-0375
Web: www.pro-belgroup.com
E-Mail: info@pro-bel.co

CLIENT:
ATLAS IRON WORKS

PROJECT:
WEBSTER ISB
470 EAST LOCKWOOD AVE.
ST. LOUIS, MO 63119

PROJECT SCOPE: SUPPLY ONLY

MM/DD/YYYY: 06/10/2016

SCALE: AS INDICATED

DRAWN BY: M.S./CHKD BY: P.M.

TECH. REVIEW
SALES
PM
ENG/SUP

A.P.
M.G.

TITLE:
FALL PROTECTION SAFETY SYSTEM
DETAILS

JOB NO.
1N1-2016-27136

SHEET NO.
2.01

REV. NO.
0