



PARIC CORPORATION
77 Westport Plaza Suite 250
St. Louis, MO 63146
TEL: 636-561-9500
FAX: 636-561-9501

REQUEST FOR INFORMATION **DATE:** August 19, 2016 **NO.:** RFI-244

To: Cannon Design

Attn: Kelvin Patel

From: Paric Corporation

Requested By: Joe Voypick

Project Name: 15051-Webster University Interdisciplinary Science Building Project No.: 15051

Subject: Level 3 Tray Located in Drywall

Response Required By: August 26, 2016

Drawing / Spec Reference:

Information Requested:

The portion of level 3 cable tray circled on the attached copy of sheet T0103.B is run above a gypsum board ceiling. Normally it is not acceptable to run tray above an inaccessible ceiling

Suggestion: We are thinking we could delete that portion of tray and utilize J - Hooks above the offices with lay in ceilings. Is this acceptable.

Response:


Yes, the use of j-hooks in the circled area indicated is acceptable.

ARCHITECT'S RESPONSE:

This information is provided as an interpretation of the Contract Documents for implementation. It is not an authorization for change to the Contract Sum or Contract Time. If this information results in a claim for a change to the Contract, the Contractor shall notify the [Construction Manager][Architect] of a change through the change process.

Answered By: Tom Becker, Faith Group

Date: 8/22/16

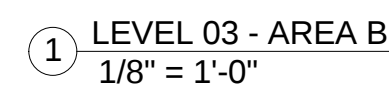

THIS SHEET ONLY

- THIS SHEET ONLY

- © Cannon Design 2015