



PARIC CORPORATION
77 Westport Plaza Suite 250
St. Louis, MO 63146
TEL: 636-561-9500
FAX: 636-561-9501

REQUEST FOR INFORMATION **DATE:** August 25, 2016 **NO.:** RFI-254

To: Cannon Design

Attn: Kelvin Patel

From: Paric Corporation

Requested By: Devin Gates

Project Name: 15051-Webster University Interdisciplinary Science Building

Project No.: 15051

Subject: Dimensions for fixed furniture stub ups

Response Required By: September 01, 2016

Drawing / Spec Reference:

Information Requested:


Please provide dimensions for conduits that stub up for fixed furniture from below for the following rooms;

Dry skills lab/Cohort classroom 135
Chem lab organic 480
Chem lab general 472

Please confirm if the intent is to have a J box or a stub up at each location.

Response:

The stub up can be anywhere in the central service cavity of fixed casework.

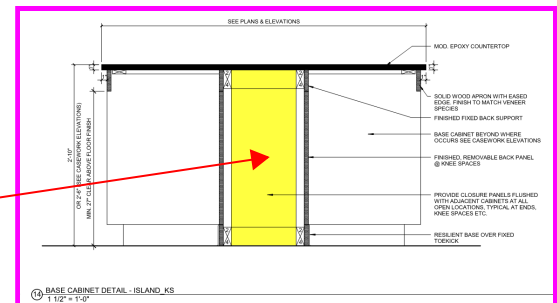

ARCHITECT'S RESPONSE:

This information is provided as an interpretation of the Contract Documents for implementation. It is not an authorization for change to the Contract Sum or Contract Time. If this information results in a claim for a change to the Contract, the Contractor shall notify the [Construction Manager][Architect] of a change through the change process.

Answered By: Kelvin Patel

Date: 08/31/2016