



PARIC CORPORATION
77 Westport Plaza Suite 250
St. Louis, MO 63146
TEL: 636-561-9500
FAX: 636-561-9501

REQUEST FOR INFORMATION DATE: September 12, 2016 NO.: RFI-276

To: Cannon Design

Attn: Kelvin Patel

From: Paric Corporation

Requested By: Joe Voypick

Project Name: 15051-Webster University Interdisciplinary Science Building Project No.: 15051

Subject: Guardrail Splice Detail

Response Required By: September 19, 2016

Drawing / Spec Reference:

Information Requested:

Verify guardrail splice detail acceptable or provide new detail.

Response:

This is not acceptable. Exposed bolts are not consistent with the design intent. Provide splice similar to details 3 and 4 on A0508.E (issued with ASI003)


.

ARCHITECT'S RESPONSE:

This information is provided as an interpretation of the Contract Documents for implementation. It is not an authorization for change to the Contract Sum or Contract Time. If this information results in a claim for a change to the Contract, the Contractor shall notify the [Construction Manager][Architect] of a change through the change process.

Answered By: Lynn Grossman

Date: 09.20.16

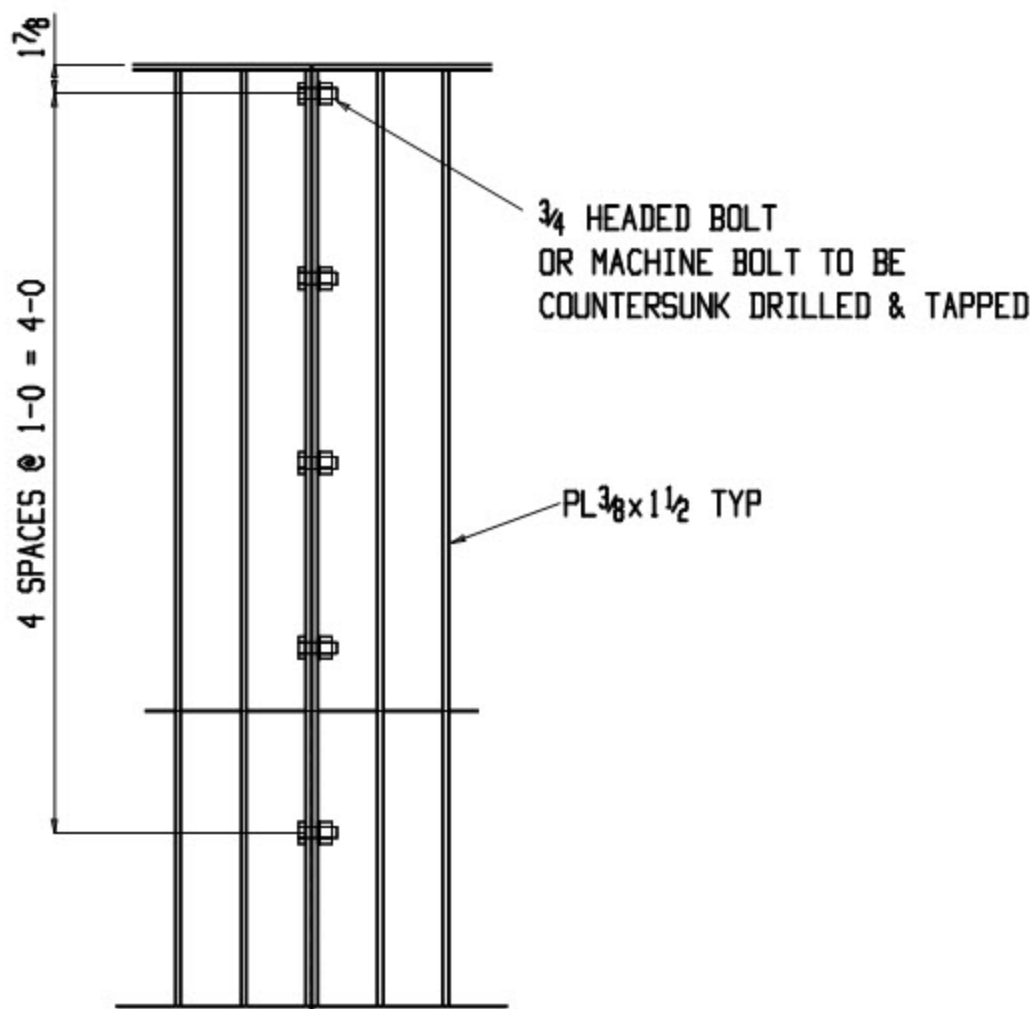

GUARDRAIL SPLICE DETAIL