



PARIC CORPORATION
77 Westport Plaza Suite 250
St. Louis, MO 63146
TEL: 636-561-9500
FAX: 636-561-9501

REQUEST FOR INFORMATION DATE: September 28, 2016 NO.: RFI-305

To: Cannon Design

Attn: Kelvin Patel

From: Paric Corporation

Requested By: Devin Gates

Project Name: 15051-Webster University Interdisciplinary Science Building Project No.: 15051

Subject: Preaction panel room dimensions

Response Required By: October 05, 2016

Drawing / Spec Reference:

Information Requested:

Currently the small room south of the Models/Assessment Storage/Research 137 used to hold the preaction cabinet is only 4'-11" deep (north to south) from the corner of the concrete walls. The cut sheets for the FireFlex cabinet gives a cabinet and dimensional clearances of 6'-3 1/2" from corner to edge of clearance. The fire protection contractor requests 3" additional for some variance for a total of 6'-6" from the corner to inside face of the north wall. Please see the attached image for reference.

Suggestion: Please advise on whether or not the room layout should be adjusted.

Response:

Revise Preaction system room size per attached sketch to accommodate the preaction cabinet.

ARCHITECT'S RESPONSE:


This information is provided as an interpretation of the Contract Documents for implementation. It is not an authorization for change to the Contract Sum or Contract Time. If this information results in a claim for a change to the Contract, the Contractor shall notify the [Construction Manager][Architect] of a change through the change process.

Answered By: Kelvin Patel

Date: 10/13/2016


137

APC-1
9'-0"

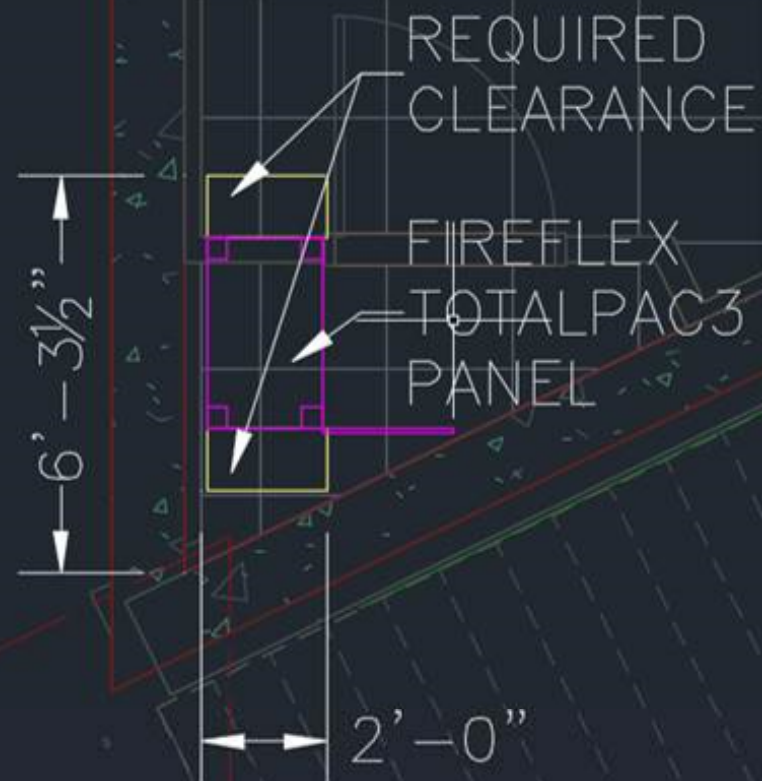

A.2

2-TANK GAS CABINET FOR 2 OXYGEN TANKS W/ TANK RESTRAINTS (CFCI)
3-TANK GAS CABINET FOR NITROGEN, NITROUS OXIDE, AND CO2 - W/ SCAVENGING SENSOR FOR STRAY GASES W/ TANK RESTRAINTS (CFCI)

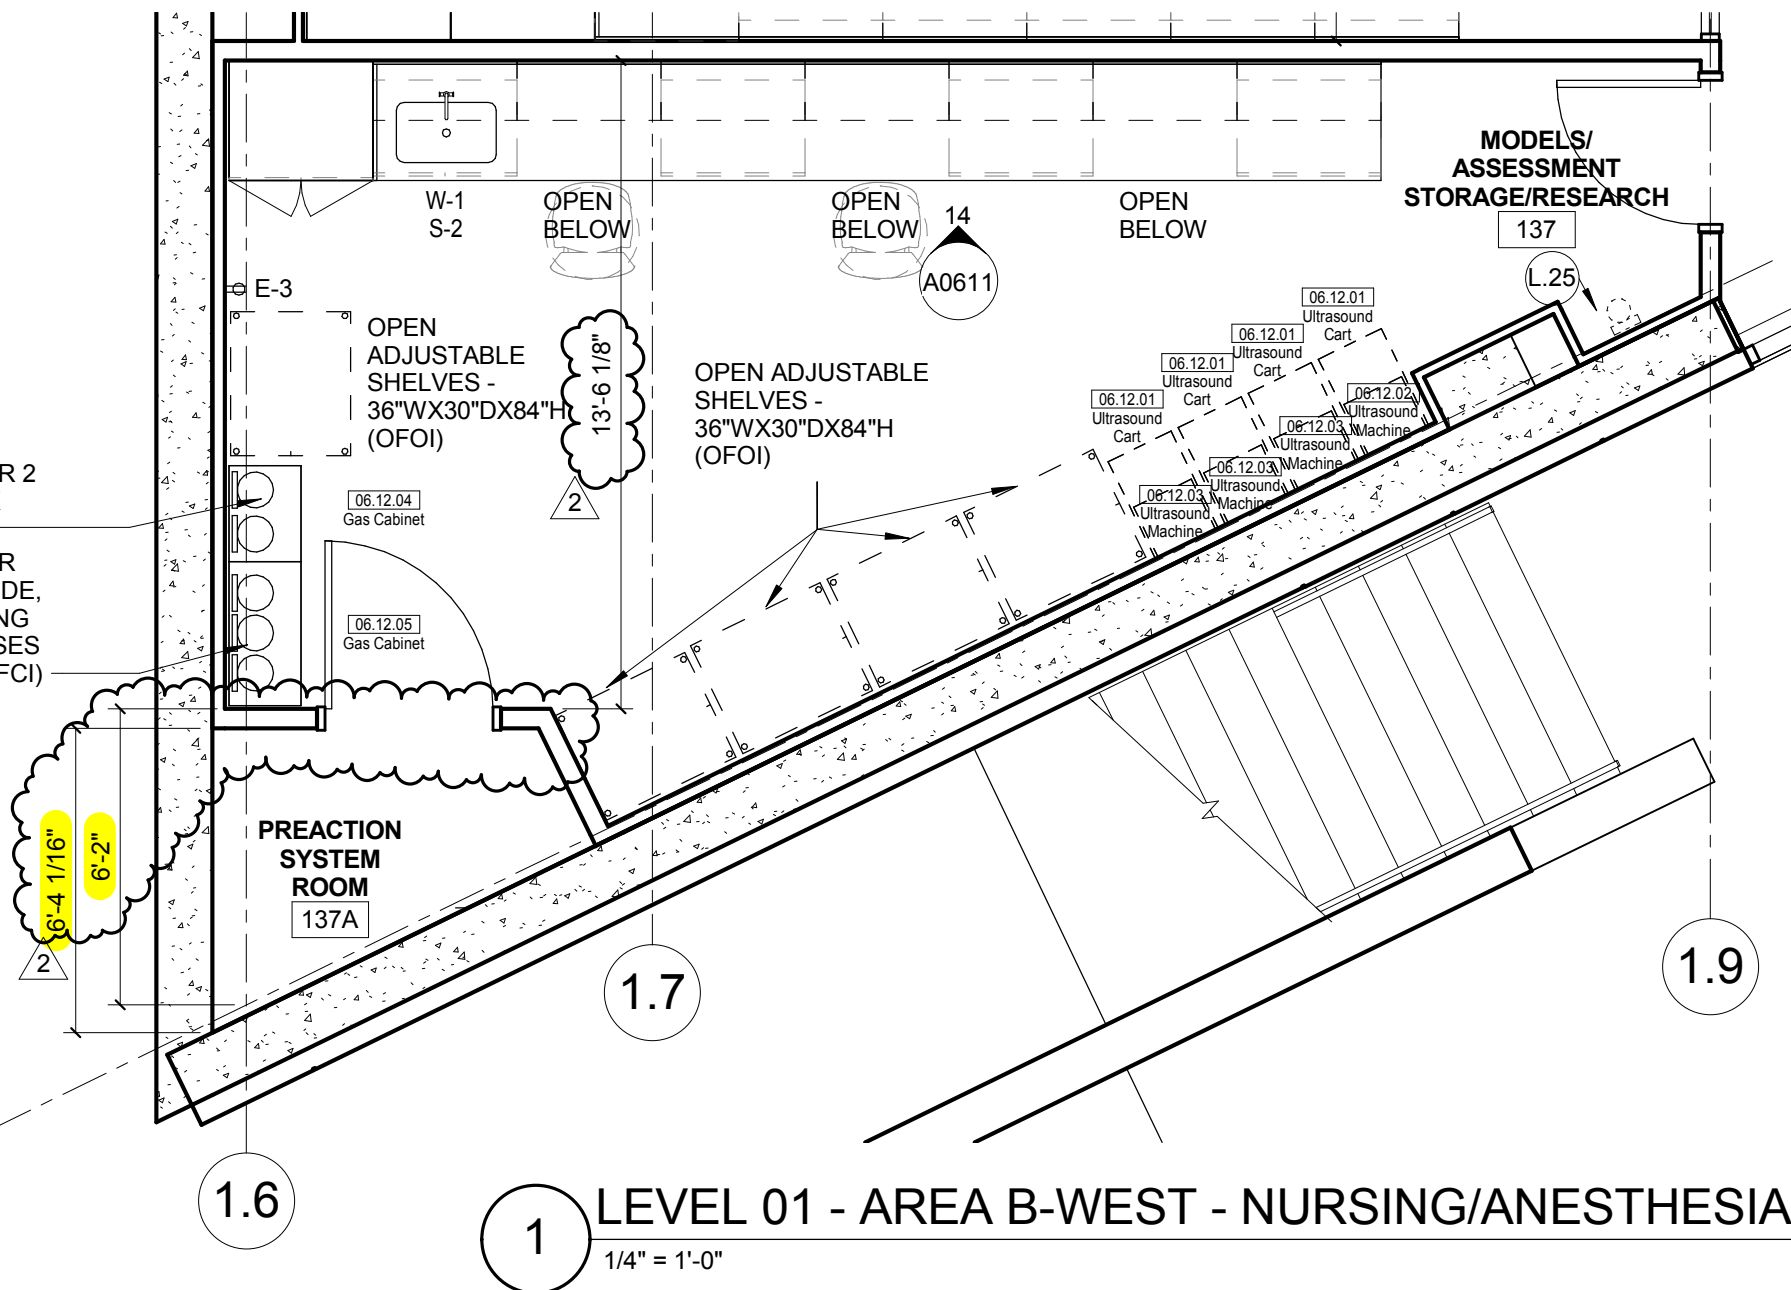

A

1.6

1

LEVEL 01 - AREA B-WEST - NURSING/ANESTHESIA

1/4" = 1'-0"

REVISED PREACTION SYSTEM ROOM SIZE