



PARIC CORPORATION
77 Westport Plaza Suite 250
St. Louis, MO 63146
TEL: 636-561-9500
FAX: 636-561-9501

REQUEST FOR INFORMATION **DATE:** October 18, 2016 **NO.:** RFI-328

To: Cannon Design

Attn: Kelvin Patel

From: Paric Corporation

Requested By: Devin Gates

Project Name: 15051-Webster University Interdisciplinary Science Building

Project No.: 15051

Subject: Additional information for Overhead Service Carrier framing

Response Required By: October 25, 2016

Drawing / Spec Reference:

Information Requested:

Note L.21 in the architectural Lab keyed note legend states "SEE CEILING PLAN FOR CEILING MOUNTED UNISTRUT SYSTEM SUPPORTED BY STRUCTURE ABOVE"

C.20 on A0702.A calls for unistrut mounted to ceiling with steel angle hangers and kickers above for support. This is shown in rooms 284 and 276. To have these struts manufactured we need additional information.


The strut fabricator requests additional information on the Overhead Service Carrier framing including length of unistrut.

Response:

This is a standard Unistrut system.
Please have fabricator submit a system proposal for review.
See sheet A0203 for length of unistruts.
GC to coordinate with sprinklers & lights.

ARCHITECT'S RESPONSE:

This information is provided as an interpretation of the Contract Documents for implementation. It is not an authorization for change to the Contract Sum or Contract Time. If this information results in a claim for a change to the Contract, the Contractor shall notify the [Construction Manager][Architect] of a change through the change process.

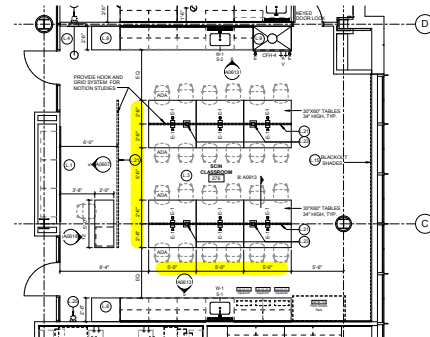

Answered By: Kelvin Patel

Date: 10/26/2016