



PARIC CORPORATION
77 Westport Plaza Suite 250
St. Louis, MO 63146
TEL: 636-561-9500
FAX: 636-561-9501

REQUEST FOR INFORMATION **DATE:** November 10, 2016 **NO.:** RFI-346

To: Cannon Design

Attn: Kelvin Patel

From: Paric Corporation

Requested By: Devin Gates

Project Name: 15051-Webster University Interdisciplinary Science Building

Project No.: 15051

Subject: Additional detail for wire mold in room 283

Response Required By: November 17, 2016

Drawing / Spec Reference:

Information Requested:


We are looking for additional details on the following questions;

1. How should the mullion mounted wire mold on the west wall in rm 283 be fed? Is the intent for the wire mold to extend to the column?
2. If the intent is to feed the wire mold via the columns what is the design intent for making the transition from the column to the wire mold?
3. The plans show the wire mold stopping between 2 mullions unsupported. Please confirm this is the intent or if the wire mold should stop at the next mullion for additional support.

To maintain schedule please address prior to 11/18/16.

Response:

There is a knee wall 'L2' behind the curtainwall spandrel. The intent is attach the wire mold to this wall and feed it through this wall.

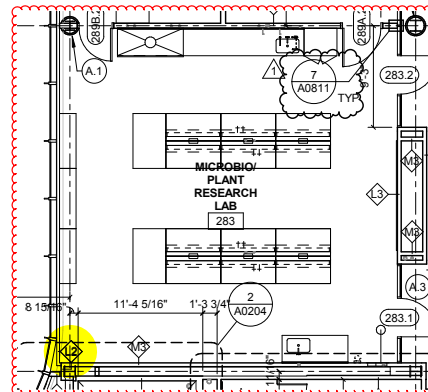

ARCHITECT'S RESPONSE:

This information is provided as an interpretation of the Contract Documents for implementation. It is not an authorization for change to the Contract Sum or Contract Time. If this information results in a claim for a change to the Contract, the Contractor shall notify the [Construction Manager][Architect] of a change through the change process.

Answered By: Kelvin Patel

Date: 11/11/2016