



PARIC CORPORATION
77 Westport Plaza Suite 250
St. Louis, MO 63146
TEL: 636-561-9500
FAX: 636-561-9501

REQUEST FOR INFORMATION **DATE:** December 01, 2016 **NO.:** RFI-366

To: Cannon Design

Attn: Kelvin Patel

From: Paric Corporation

Requested By: Devin Gates

Project Name: 15051-Webster University Interdisciplinary Science Building

Project No.: 15051

Subject: Electrical boxes shown in J1 type wall

Response Required By: December 08, 2016

Drawing / Spec Reference:


Information Requested:

E0101.B and T0101.B show boxes placed along the east wall of room 144. A0101.B calls for a J1 partition along this wall which consists of 7/8" hat channel. This wall would need to be at least 3 5/8" studes to install the boxes as shown.

Suggestion: Please advise if wall is to be furred out.

Response:

**CHANGE 'J1' PARTITION TO PARTITION TYPE 'L2'
(SIMILAR TO ROOM 154) TO ACCOMMODATE BOXES.**

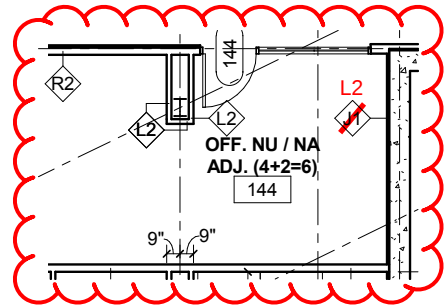

ARCHITECT'S RESPONSE:

This information is provided as an interpretation of the Contract Documents for implementation. It is not an authorization for change to the Contract Sum or Contract Time. If this information results in a claim for a change to the Contract, the Contractor shall notify the [Construction Manager][Architect] of a change through the change process.

Answered By: Kelvin Patel

Date: 12/05/2016