



PARIC CORPORATION
77 Westport Plaza Suite 250
St. Louis, MO 63146
TEL: 636-561-9500
FAX: 636-561-9501

REQUEST FOR INFORMATION **DATE:** December 06, 2016 **NO.:** RFI-371

To: Cannon Design

Attn: Kelvin Patel

From: Paric Corporation

Requested By: Joe Voypick

Project Name: 15051-Webster University Interdisciplinary Science Building Project No.: 15051

Subject: A/V layout in Room 131 and 353

Response Required By: December 13, 2016

Drawing / Spec Reference:

Information Requested:

As discussed please provide dimensions for cameras, TV, and projector for room 131 and projector in room 353.
(attach sketches below)

Response:



ARCHITECT'S RESPONSE:

This information is provided as an interpretation of the Contract Documents for implementation. It is not an authorization for change to the Contract Sum or Contract Time. If this information results in a claim for a change to the Contract, the Contractor shall notify the [Construction Manager][Architect] of a change through the change process.

Answered By: Kelvin Patel

Date: 12/09/2016

does this go in
center of column?

YES

LOCATE TV & PROJECTOR
TO THIS CENTERLINE

dimension to
center of TV?


dimension to
center of projector?

dimensions to
camera?

CTI TO ADVISE &
PROVIDE REQUIRED
DISTANCE OF CAMERA
FROM PROJECTOR



HEALTH
ASSESSMENT
LAB

131

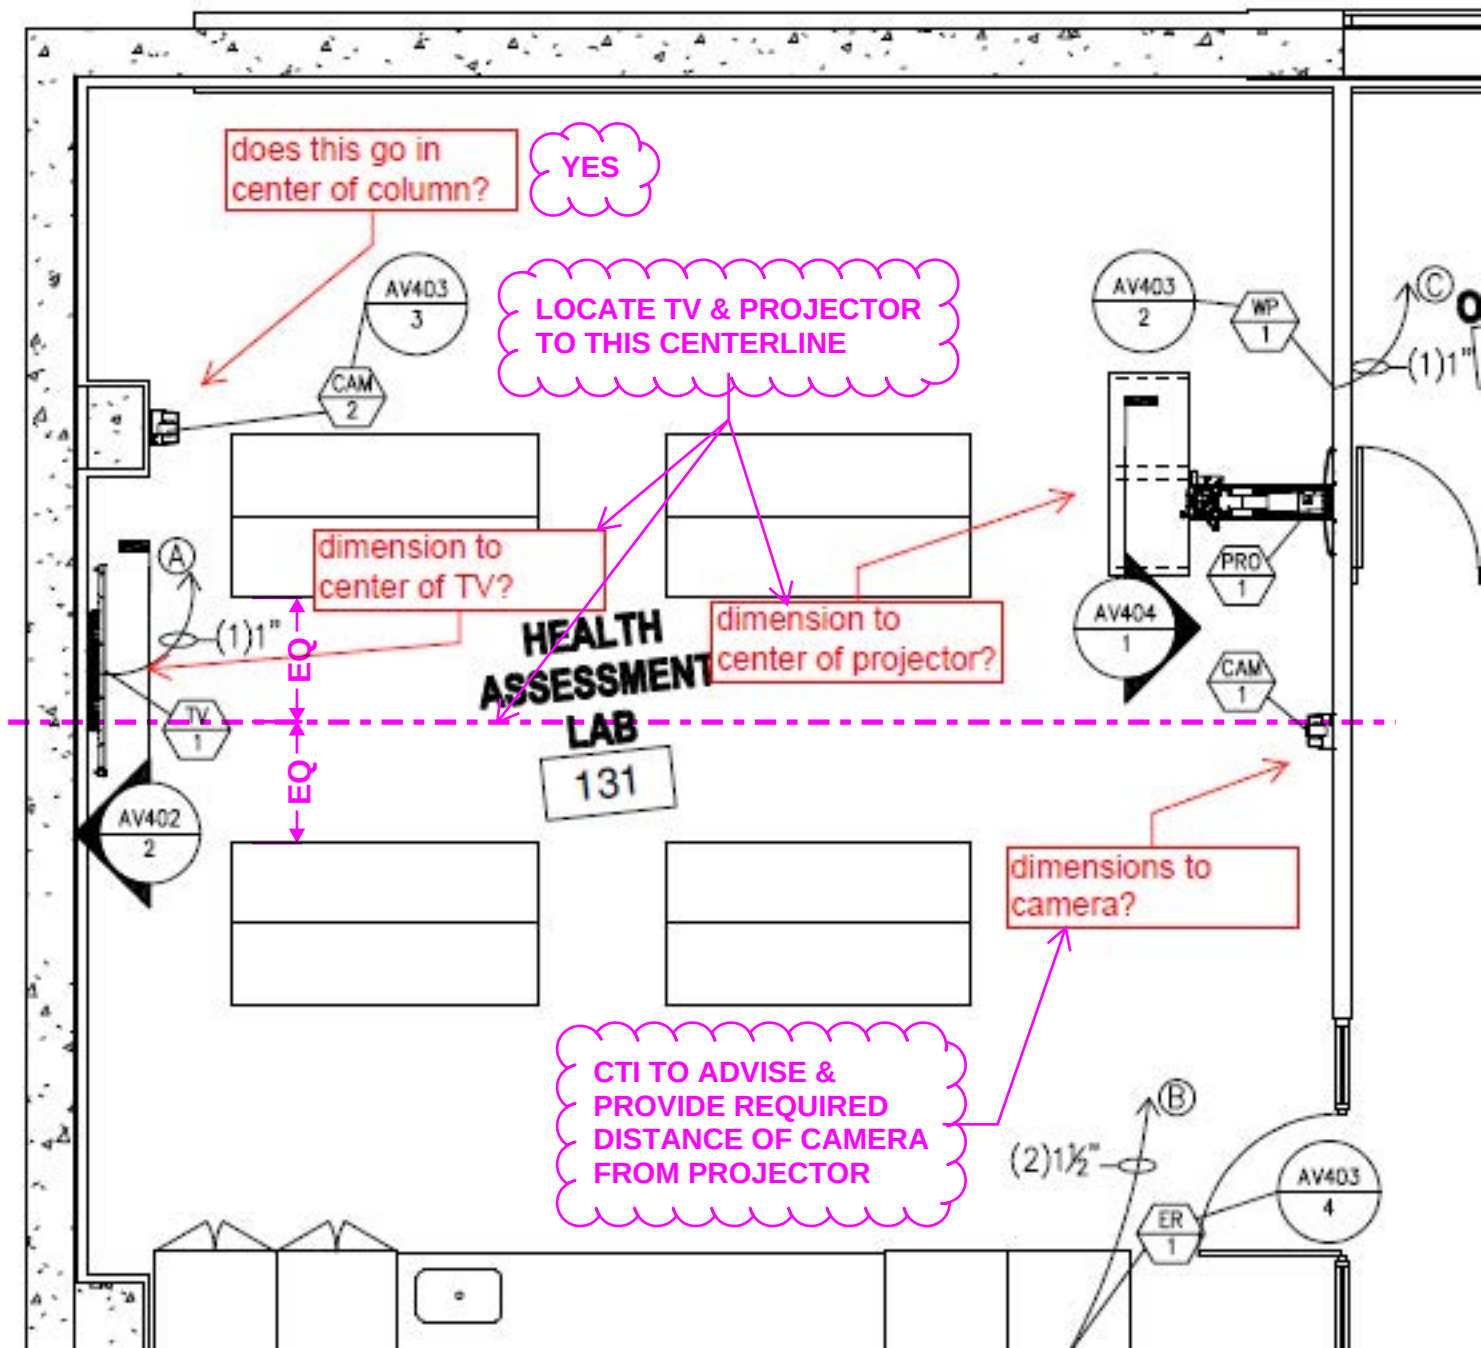

**QUAN. LAB /
INTERVIEW
LAB**

353

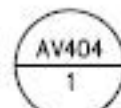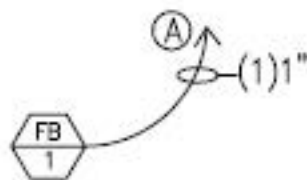

dimensions to
projector?

LOCATE TO
CENTER OF WALL

EQ

EQ