



PARIC CORPORATION
77 Westport Plaza Suite 250
St. Louis, MO 63146
TEL: 636-561-9500
FAX: 636-561-9501

REQUEST FOR INFORMATION	DATE: January 20, 2017	NO.: RFI-421
--------------------------------	-------------------------------	---------------------

To: Cannon Design

Attn: Kelvin Patel

From: Paric Corporation

Requested By: Devin Gates

Project Name: 15051-Webster University Interdisciplinary Science Building	Project No.: 15051
---	--------------------

Subject: Caulk joints at south vestibule

Response Required By: January 27, 2017

Drawing / Spec Reference:

Information Requested:

See attached sketch. The South vestibule at the 2nd level has 1/2" caulk joints on the North (interior) wall and 1 1/2" on the South (exterior) wall. These sills need to be at the same elevations for proper installation.

Suggestion: Please advise. The joint size can be adjusted per the curtainwall contractor but needs to be the same.

Response:

Maintain the 1/2" caulk joint on both sides of the door. Break metal will separate the 1/2" and 1 1/2" joint size. See detail 10/A0421 (see below)

ARCHITECT'S RESPONSE:

This information is provided as an interpretation of the Contract Documents for implementation. It is not an authorization for change to the Contract Sum or Contract Time. If this information results in a claim for a change to the Contract, the Contractor shall notify the [Construction Manager][Architect] of a change through the change process.

Answered By: _____

01/23/17
Date: _____

NGG LTD

NGG LTD, INCORPORATED
1850 Craigshire Road Suite 202
St. Louis, Missouri 63148
Tel 314-336-2516
Fax 314-336-2521

Professional Seal

Sub. No.	Rev. No.	Date	Drawn By	Submittal/Revision Description
1	1	11/19/16	TY	1ST SUBMISSION
2	1	10/19/16	TY	2ND SUBMISSION
3	2	11/19/16	TY	3RD SUBMISSION

Proprietary Notice

This drawing sheet and contents herein are property of NGG. Use of this drawing, contents or design concepts for purposes other than estimating, drawing preparation and/or manufacturing for NGG shall be cause for legal recourse by NGG.

Project Name

WEBSTER UNIVERSITY

Location

St. Louis, Missouri

Architect

CANNON DESIGN

Location

St. Louis, Missouri

Contractor

PARC

Location

St. Louis, Missouri

Owner

WEBSTER UNIVERSITY

Location

St. Louis, Missouri

Drawn Date

08/10/16

Scale

AS NOTED

NGG Project No.

Drawing Title


EMBED TITLE SHEET

Drawn By

TY

Sheet No.

204

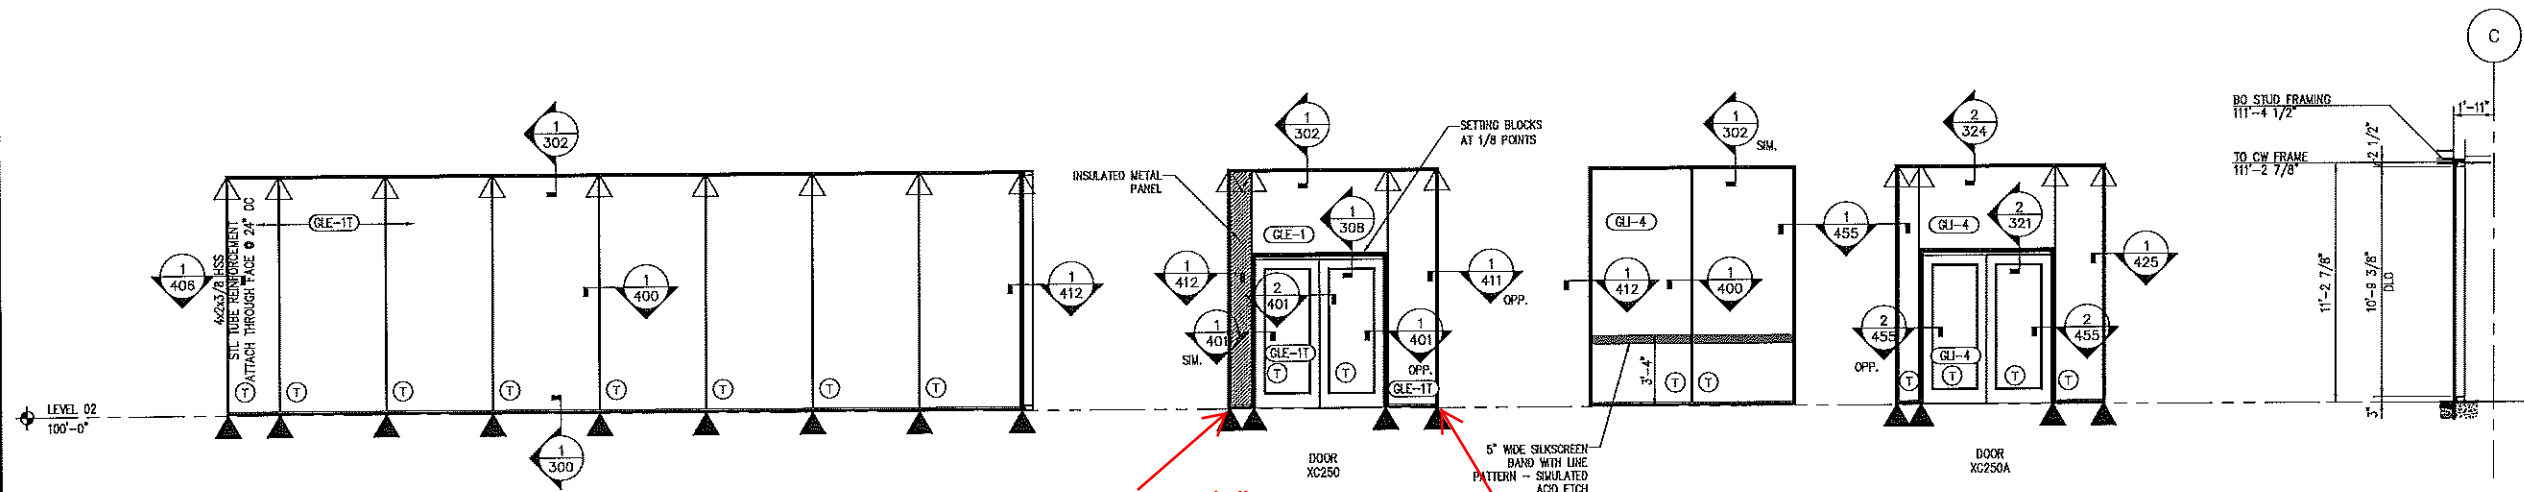

WE HAVE A 1/2"
JOINT HERE

WE HAVE A 1 1/2"
JOINT HERE.

THE SILLS WILL NOT LINE UP FROM ONE WALL TO THE OTHER. WE NEED TO KNOW HOW TO PROCEED


1 SOUTH ELEVATION
Scale: 3/4"=1'-0"
COLOR: PEWTER

2 WEST ELEVATION
Scale: 3/4"=1'-0"
COLOR: PEWTER

3 INTERIOR VESTIBULE
Scale: 3/4"=1'-0"
COLOR: PEWTER

4 INTERIOR VESTIBULE
Scale: 3/4"=1'-0"
COLOR: PEWTER

5 SECTION
Scale: 3/4"=1'-0"

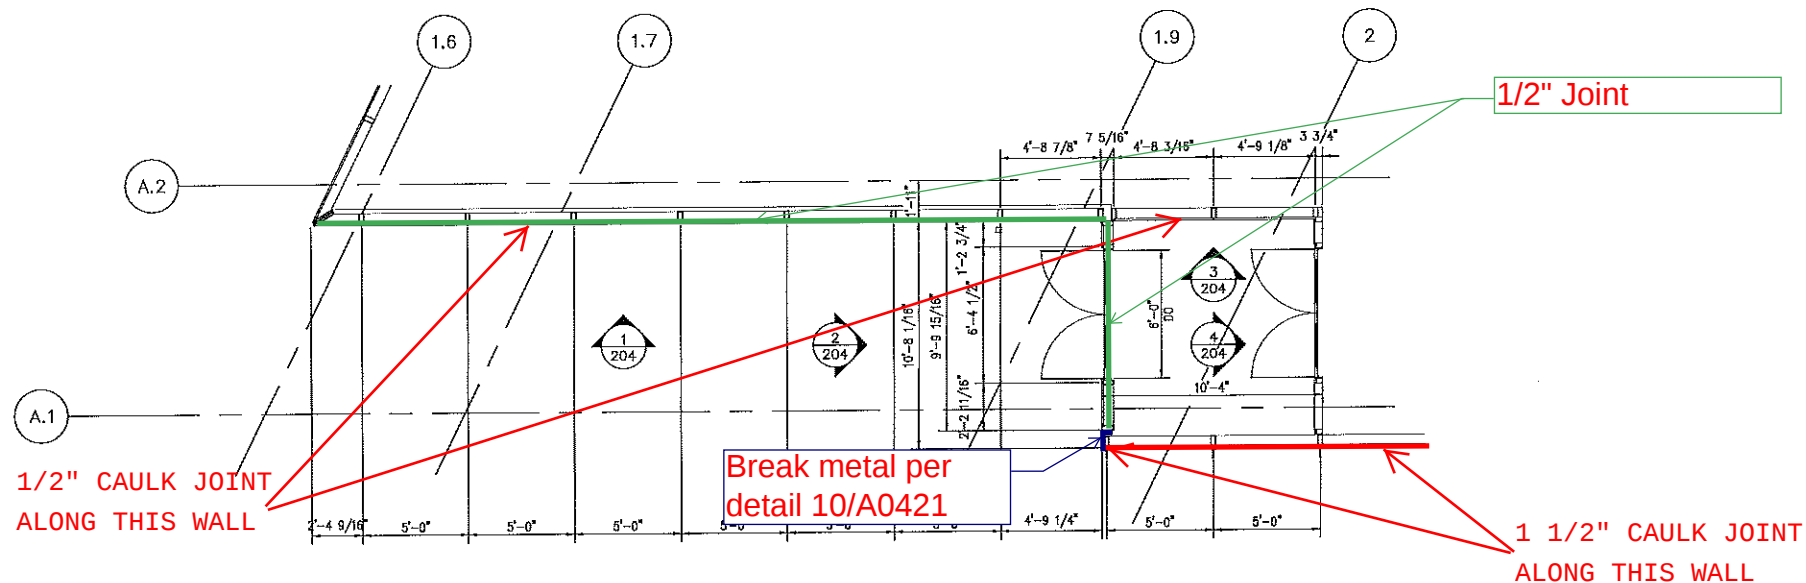

1/2" CAULK JOINT
ALONG THIS WALL

Break metal per
detail 10/A0421

1 1/2" CAULK JOINT
ALONG THIS WALL

3 PLAN
Scale: 3/4"=1'-0"