



PARIC CORPORATION
77 Westport Plaza Suite 250
St. Louis, MO 63146
TEL: 636-561-9500
FAX: 636-561-9501

REQUEST FOR INFORMATION DATE: January 26, 2017 NO.: RFI-427

To: Cannon Design

Attn: Kelvin Patel

From: Paric Corporation

Requested By: Joe Voypick

Project Name: 15051-Webster University Interdisciplinary Science Building Project No.: 15051

Subject: East retaining wall elevation

Response Required By: February 02, 2017

Drawing / Spec Reference:

Information Requested:

E4/RSE002 has a note that states "T/Wall = 550.5' per A0101.A T/Wall to be 6" above grade" at the north end. Please advise if the entire wall is to raise 6" accordingly or if the other elevations remain as submitted. There are not additional elevations on A0101.A nor are detailed elevations on the site grading plan.

Response:


Per A0505, the top of the wall is 549.83 at the north end.
See attached sketch.

ARCHITECT'S RESPONSE:

This information is provided as an interpretation of the Contract Documents for implementation. It is not an authorization for change to the Contract Sum or Contract Time. If this information results in a claim for a change to the Contract, the Contractor shall notify the [Construction Manager][Architect] of a change through the change process.

Answered By: Kelvin Patel

Date: 02/03/2017

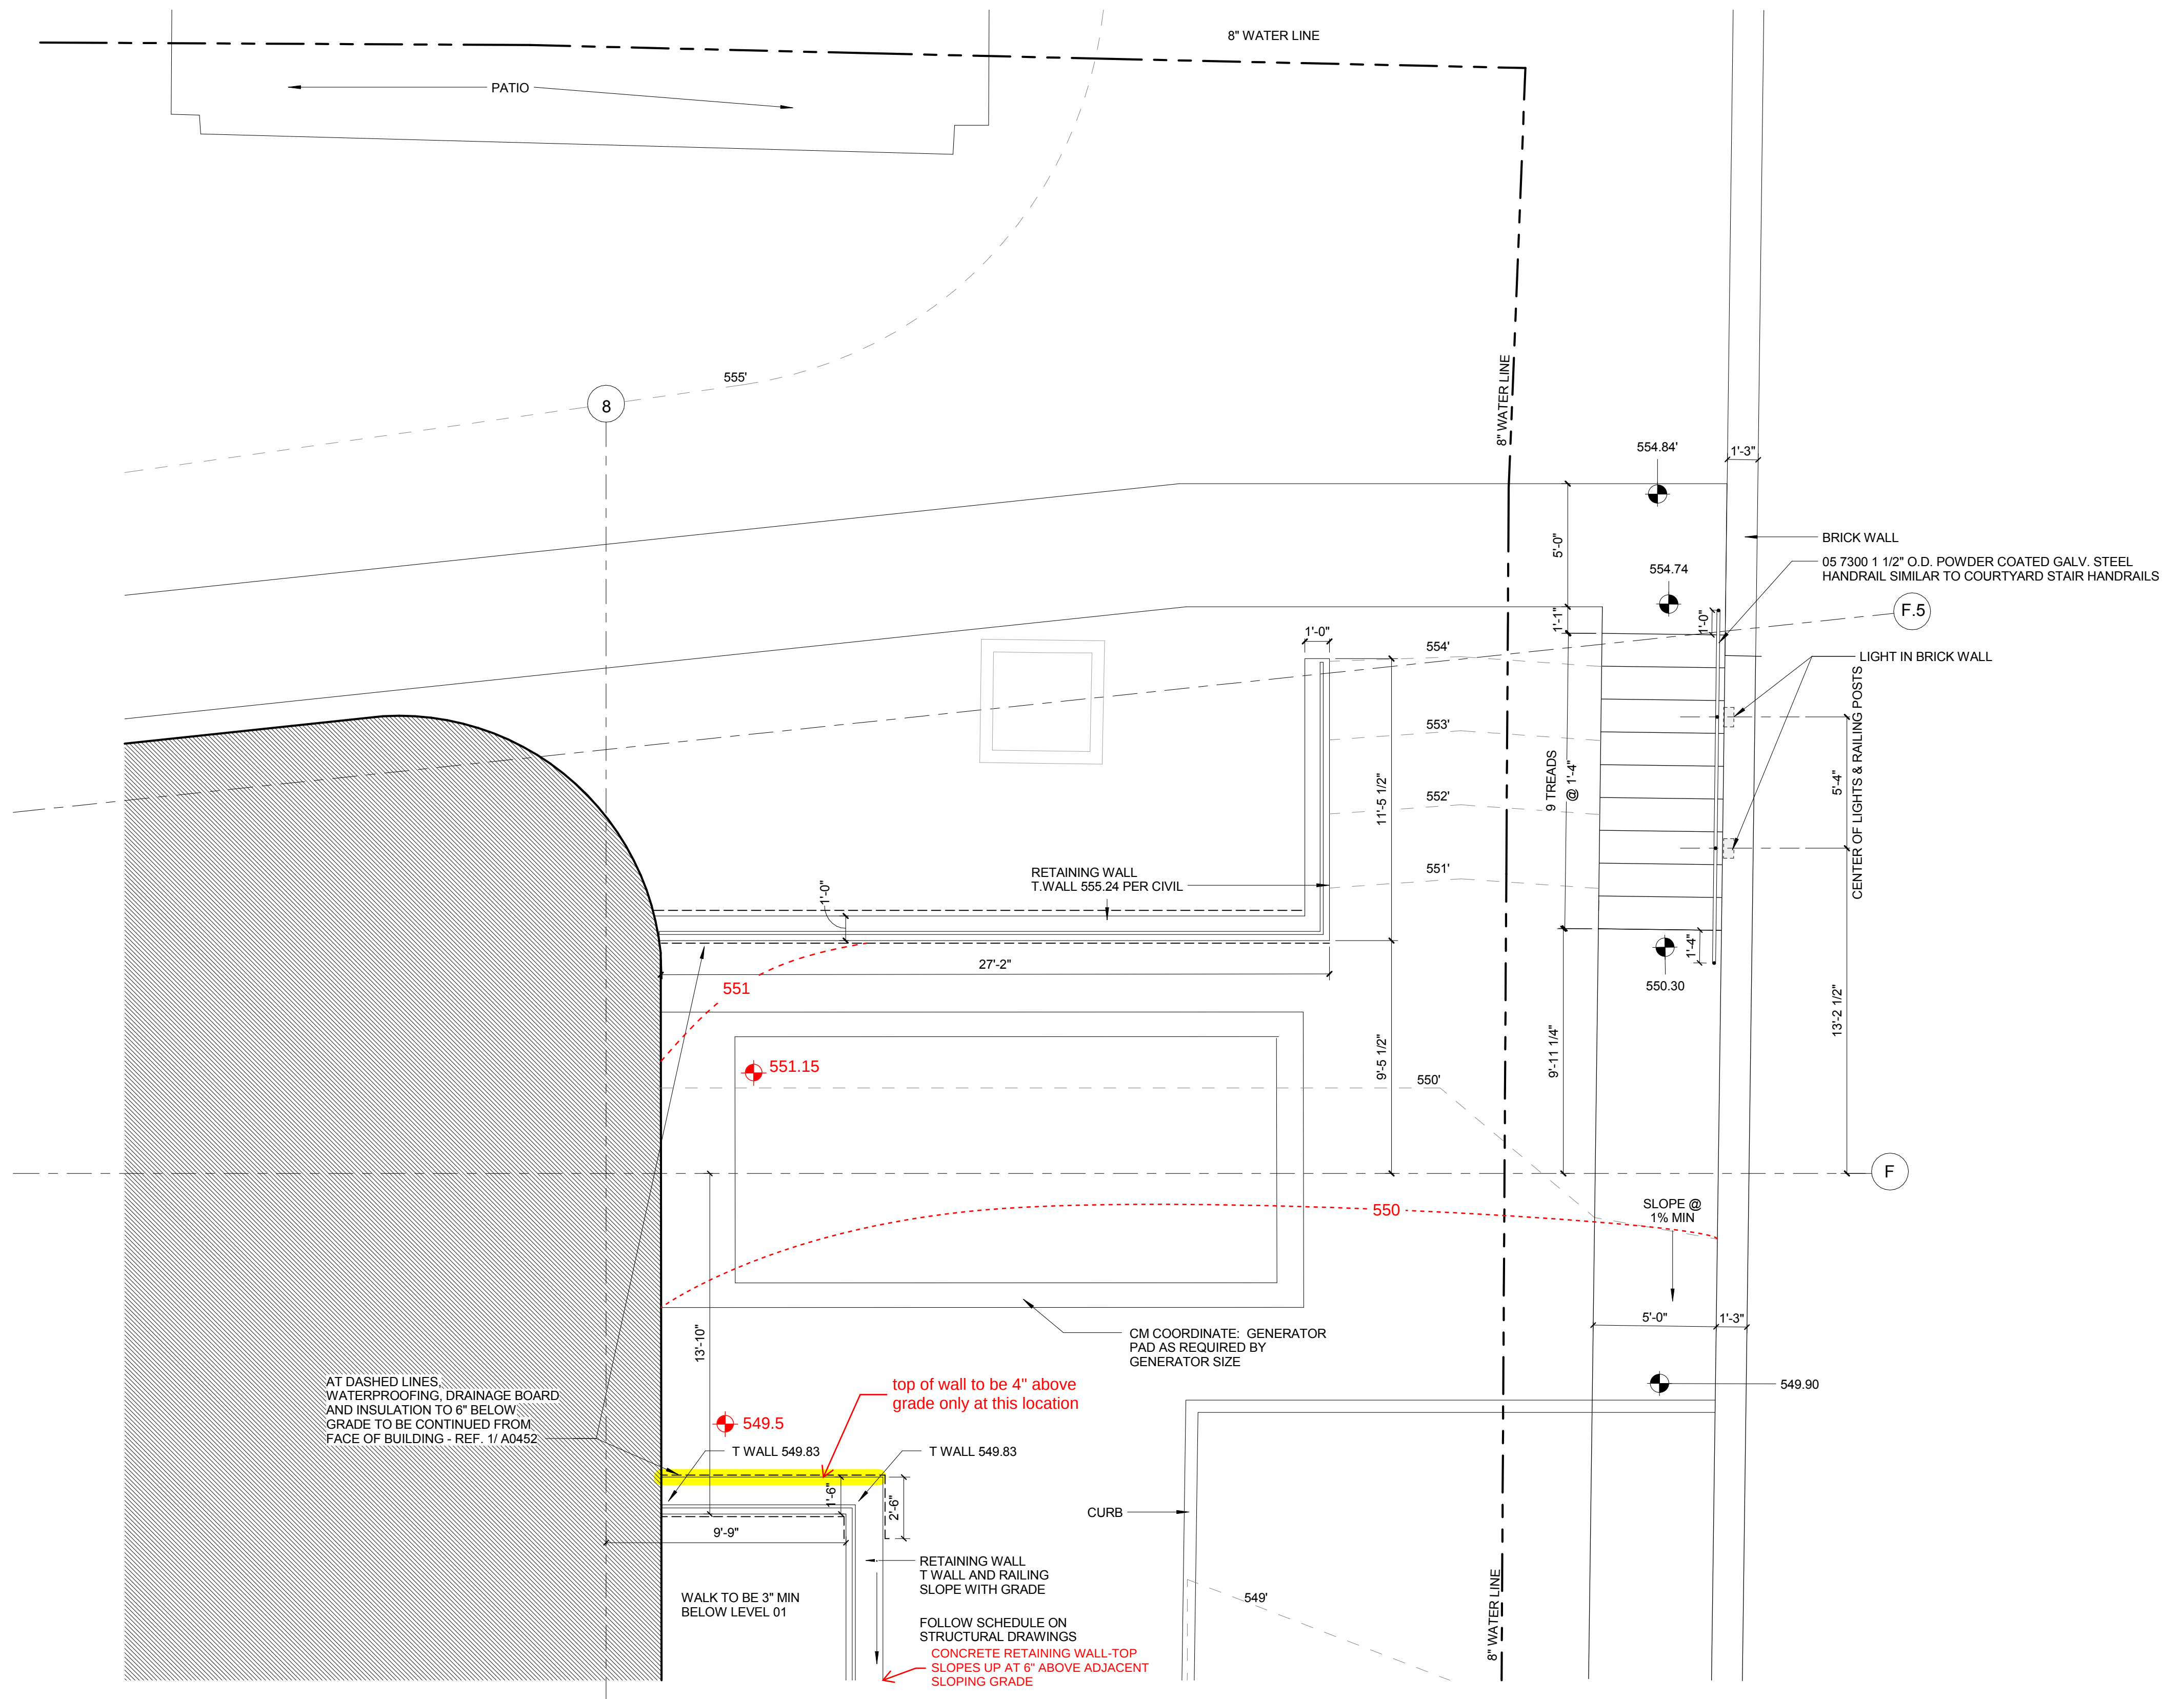

3 EAST PROPERTY LINE BRICK WALL PLAN
1/4" = 1'-0"

A0505