



PARIC CORPORATION
77 Westport Plaza Suite 250
St. Louis, MO 63146
TEL: 636-561-9500
FAX: 636-561-9501

REQUEST FOR INFORMATION **DATE:** February 21, 2017 **NO.:** RFI-451

To: Cannon Design

Attn: Kelvin Patel

From: Paric Corporation

Requested By: Joe Voypick

Project Name: 15051-Webster University Interdisciplinary Science Building Project No.: 15051

Subject: Beam Conflict With Shades

Response Required By: February 28, 2017

Drawing / Spec Reference:

Information Requested:

The roller shades cannot be installed per design due to exposed steel in the commons rooms (354/356) as well as in offices 313, 315, 317, and 319.

See attached photos. I recommend a field walk after the upcoming OAC meeting.

Response:


REFER TO RFI-447 RESPONSE.

ARCHITECT'S RESPONSE:

This information is provided as an interpretation of the Contract Documents for implementation. It is not an authorization for change to the Contract Sum or Contract Time. If this information results in a claim for a change to the Contract, the Contractor shall notify the [Construction Manager][Architect] of a change through the change process.

Answered By: Kelvin Patel

Date: 03/06/2017

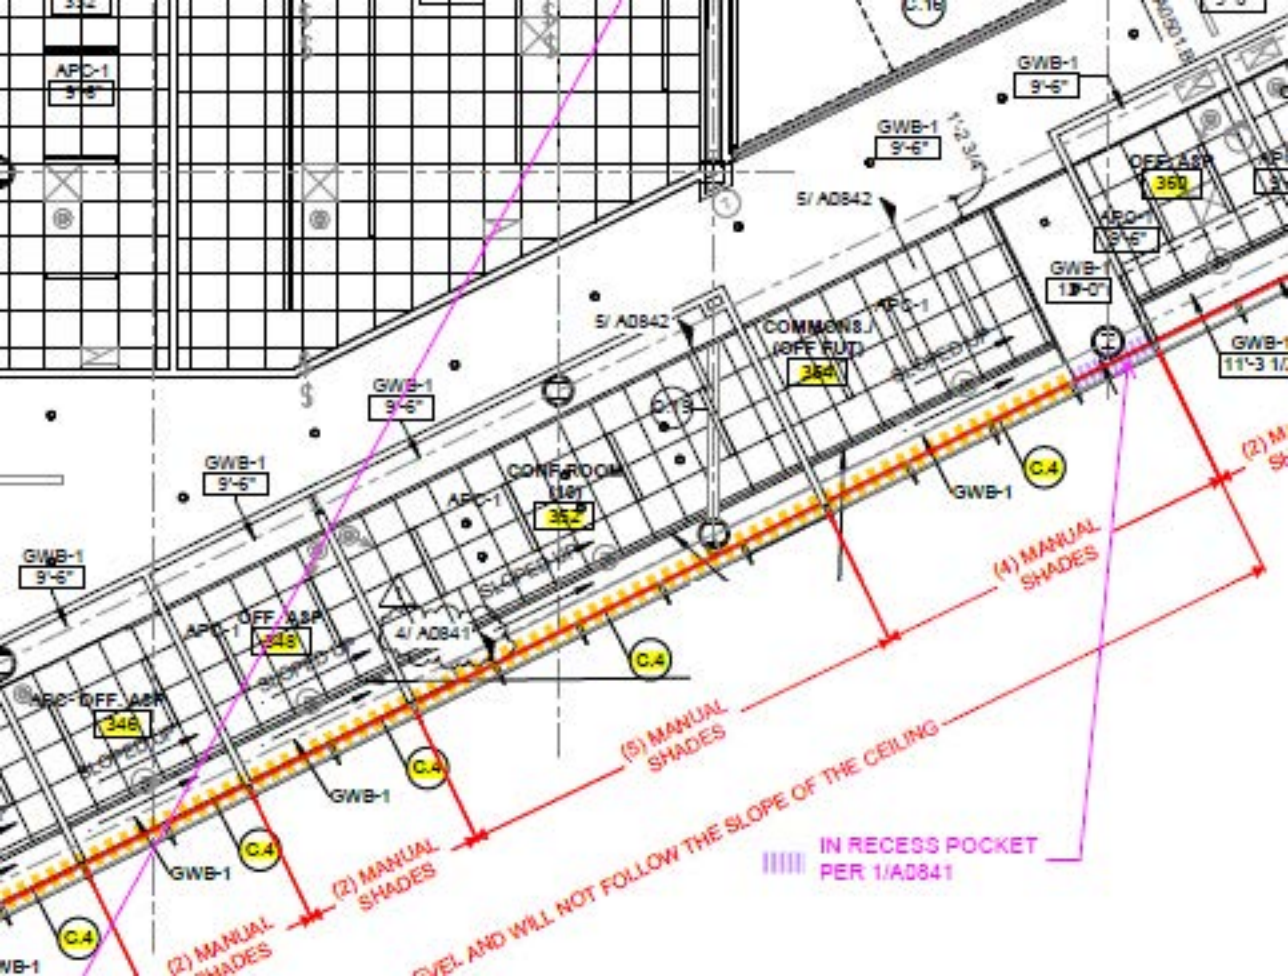

SHADES ARE SUPPLIED
AND MOUNTED TO STEEL
ANGLE SPANNING
ACROSS ROOM.

THESE SHADES WILL BE INSTALLED LEVEL AND WILL NOT FOLLOW THE SLOPE OF THE CEILING

