



PARIC CORPORATION
77 Westport Plaza Suite 250
St. Louis, MO 63146
TEL: 636-561-9500
FAX: 636-561-9501

REQUEST FOR INFORMATION	DATE: February 21, 2017	NO.: RFI-453
--------------------------------	--------------------------------	---------------------

To: Cannon Design

Attn: Kelvin Patel

From: Paric Corporation

Requested By: Devin Gates

Project Name:	15051-Webster University Interdisciplinary Science Building	Project No.: 15051
---------------	---	--------------------

Subject: Brick ledge at northwest corner

Response Required By: February 28, 2017

Drawing / Spec Reference:

Information Requested:

There is no brick ledge shown for the masonry at the northwest corner of the building. This masonry is approximately 2 feet wide by 9' tall.

Please advise how to support the masonry at this location.

Response: SEE ATTACHED DETAIL FOR CORBEL TO SUPPORT THE BRICK.

KWA - WATERPROOF THE NEW CORBEL PER SPEC SECTION 071326. ALL SIDES OF SHEET WATERPROOFING SHALL EXTEND A MIN. OF 6" ON TO FACE OF FOUNDATION WALL AND LAP SHEET WATERPROOFING MIN OF 6". INSTALLATION SHALL MEET MANUFACTURER'S REQUIREMENTS.

ARCHITECT'S RESPONSE:

This information is provided as an interpretation of the Contract Documents for implementation. It is not an authorization for change to the Contract Sum or Contract Time. If this information results in a claim for a change to the Contract, the Contractor shall notify the [Construction Manager][Architect] of a change through the change process.

KATHY WILLIAMS / KWA

JILL WALKER / DMA

02.23.2017

02.22.2017

Answered By: _____

Date: _____



2-#4 HORIZ W/4"
HOOKS EACH END.
PROVIDE 2" CLR
COVER AT ENDS.

CONCRETE
CORBEL FOR
LENGTH OF BRICK

STRIP WATERSTOP

Level 02
100' - 0"

1'-4"
0'-8"
0'-4"

FIBER PANEL SYSTEM
SEE ARCH. DWGS.

SEE APPLICABLE
SECTION CUT BELOW
FOR REINF.

COORD W/ARCH FOR
WATERPROOFING
SYSTEM OVER CORBEL

1' - 2" 7 1/2"

3-#4 BENT BARS WITH 6"
EMBED HILTI HIT-HY 200.
PROVIDE 5"+/- COVER AT
ENDS, 2" CLR COVER TOP
AND SIDE, AND 3" COVER
ON BOTTOM.

15 FRAMING SECTION
3/4" = 1'-0"

KWA- WATERPROOF THE NEW CORBEL PER SPEC
SECTION 071326. ALL SIDES OF SHEET WATERPROOFING
SHALL EXTEND A MIN. OF 6" ON TO FACE OF FOUNDATION
WALL AND LAP SHEET WATERPROOFING MIN OF 6".
INSTALLTION SHALL MEET MANUFACTRUE'S REQUMENTS.



PARIC CORPORATION
77 Westport Plaza Suite 250
St. Louis, MO 63146
TEL: 636-561-9500
FAX: 636-561-9501

REQUEST FOR INFORMATION DATE: September 20, 2016 NO.: RFI-290

To: Cannon Design

Attn: Kelvin Patel

From: Paric Corporation

Requested By: Devin Gates

Project Name: 15051-Webster University Interdisciplinary Science Building Project No.: 15051

Subject: Confirm brick ledge dimension

Response Required By: September 27, 2016

Drawing / Spec Reference:

Information Requested:

Please confirm the brick ledge shown on the west view of A0311 is to begin 8' 11" west of F line (see attached sketch)

Response:


Brick ledge should be 9'-0" west of column line F.

ARCHITECT'S RESPONSE:

This information is provided as an interpretation of the Contract Documents for implementation. It is not an authorization for change to the Contract Sum or Contract Time. If this information results in a claim for a change to the Contract, the Contractor shall notify the [Construction Manager][Architect] of a change through the change process.

Answered By: _____

Date: 9/21/16

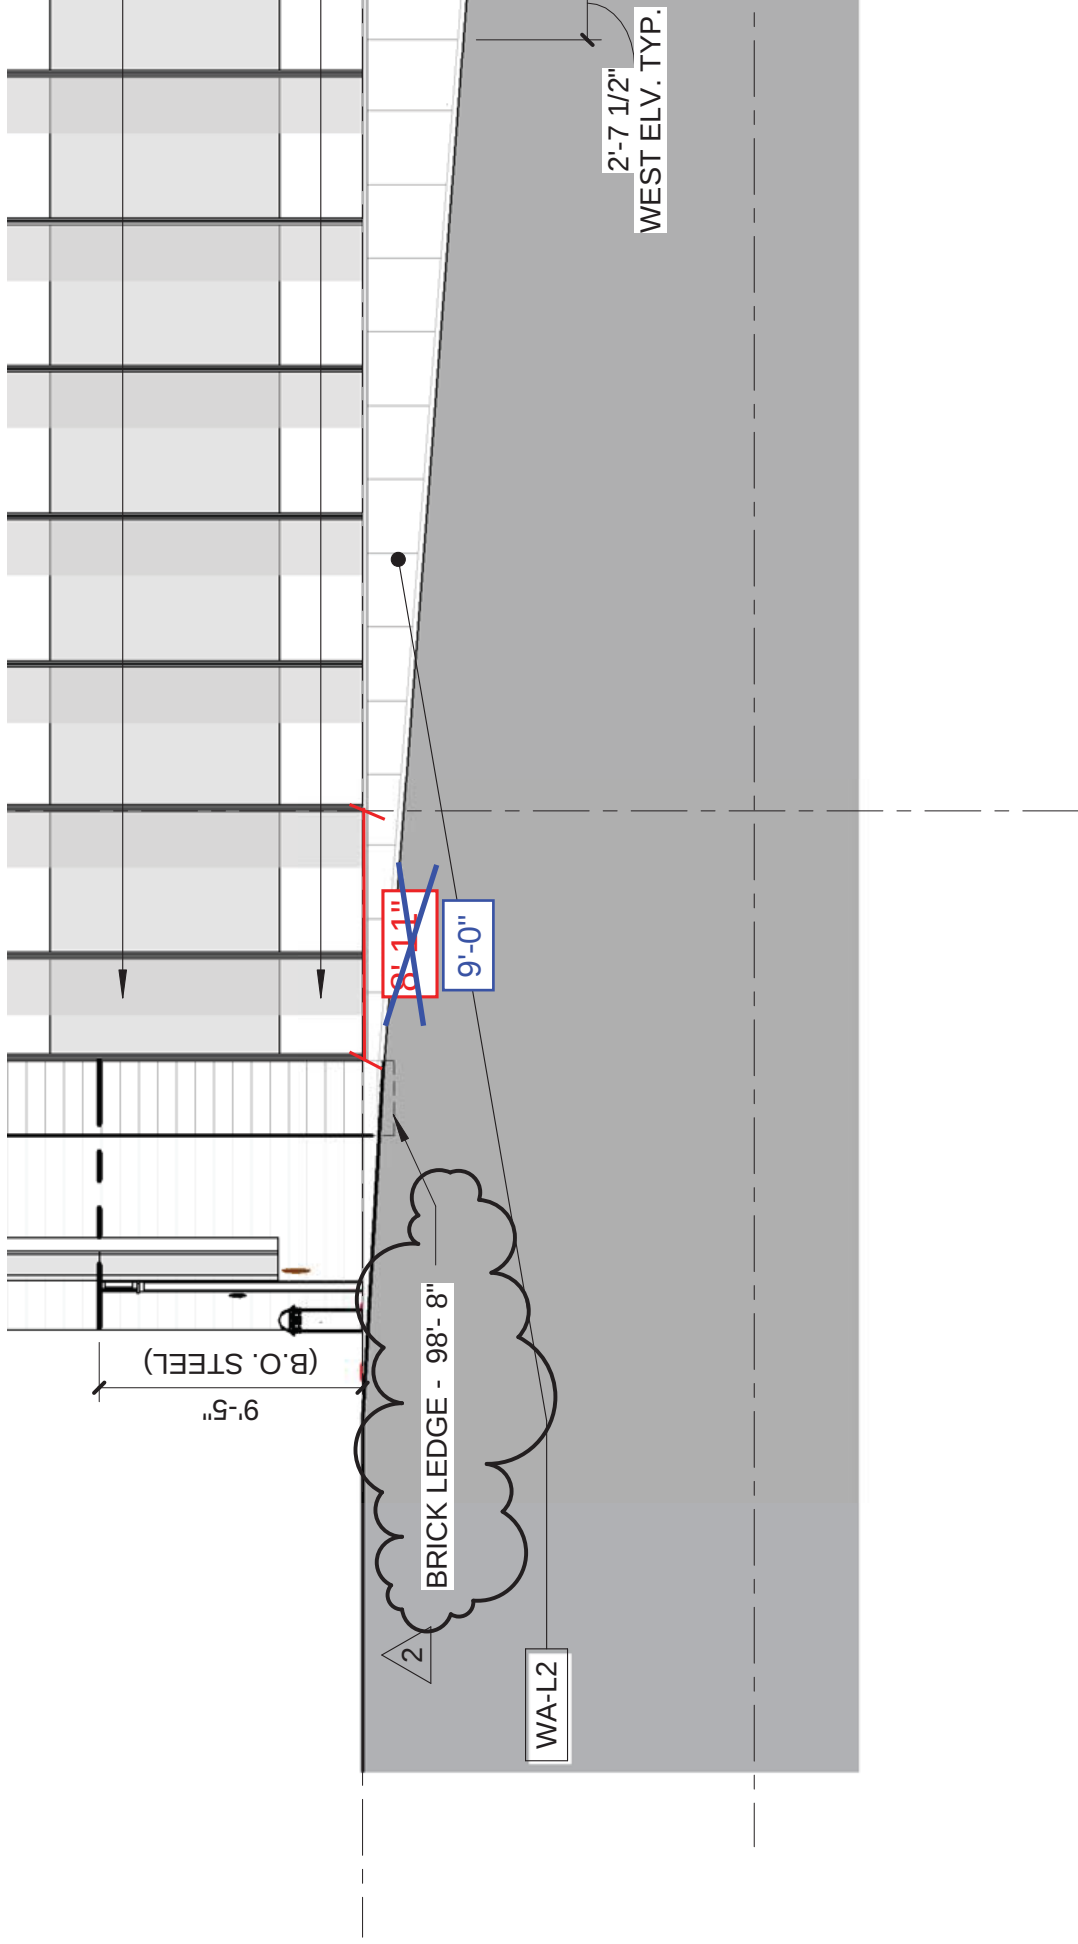

WEST ELEVATION

1
1/8" = 1'-0"