



PARIC CORPORATION
77 Westport Plaza Suite 250
St. Louis, MO 63146
TEL: 636-561-9500
FAX: 636-561-9501

REQUEST FOR INFORMATION	DATE: February 27, 2017	NO.: RFI-464
--------------------------------	--------------------------------	---------------------

To: Cannon Design

Attn: Kelvin Patel

From: Paric Corporation

Requested By: Devin Gates

Project Name:	15051-Webster University Interdisciplinary Science Building	Project No.: 15051
---------------	---	--------------------

Subject: Linear Slot Diffusers in Lecture Hall Ceiling

Response Required By: March 06, 2017

Drawing / Spec Reference:

Information Requested:

Based on detail 11 in A0841 in the Lecture Hall, there is a 4" opening for the BOD linear slot diffusers to be installed. The BOD linear slot diffuser plus plaster frame for drywall mount, will need an opening size of 6" to install. Can the ceiling detail be made to accommodate the needs of the slot diffuser?

Suggestion: Changing the ceiling detail will allow for install of the specified linear slot diffusers.
Impact: If the detail cannot change, diffusers will need to be resized and reordered at additional cost and schedule impact of 3-4 week standard lead time after selection and approval.

Response:


Provide framing to fit around diffusers. Maintain 9 1/4" overall dimension for gyp board. Attached is suggestion

ARCHITECT'S RESPONSE:

This information is provided as an interpretation of the Contract Documents for implementation. It is not an authorization for change to the Contract Sum or Contract Time. If this information results in a claim for a change to the Contract, the Contractor shall notify the [Construction Manager][Architect] of a change through the change process.

Answered By: Lynn Grossman

Date: 03.06.17

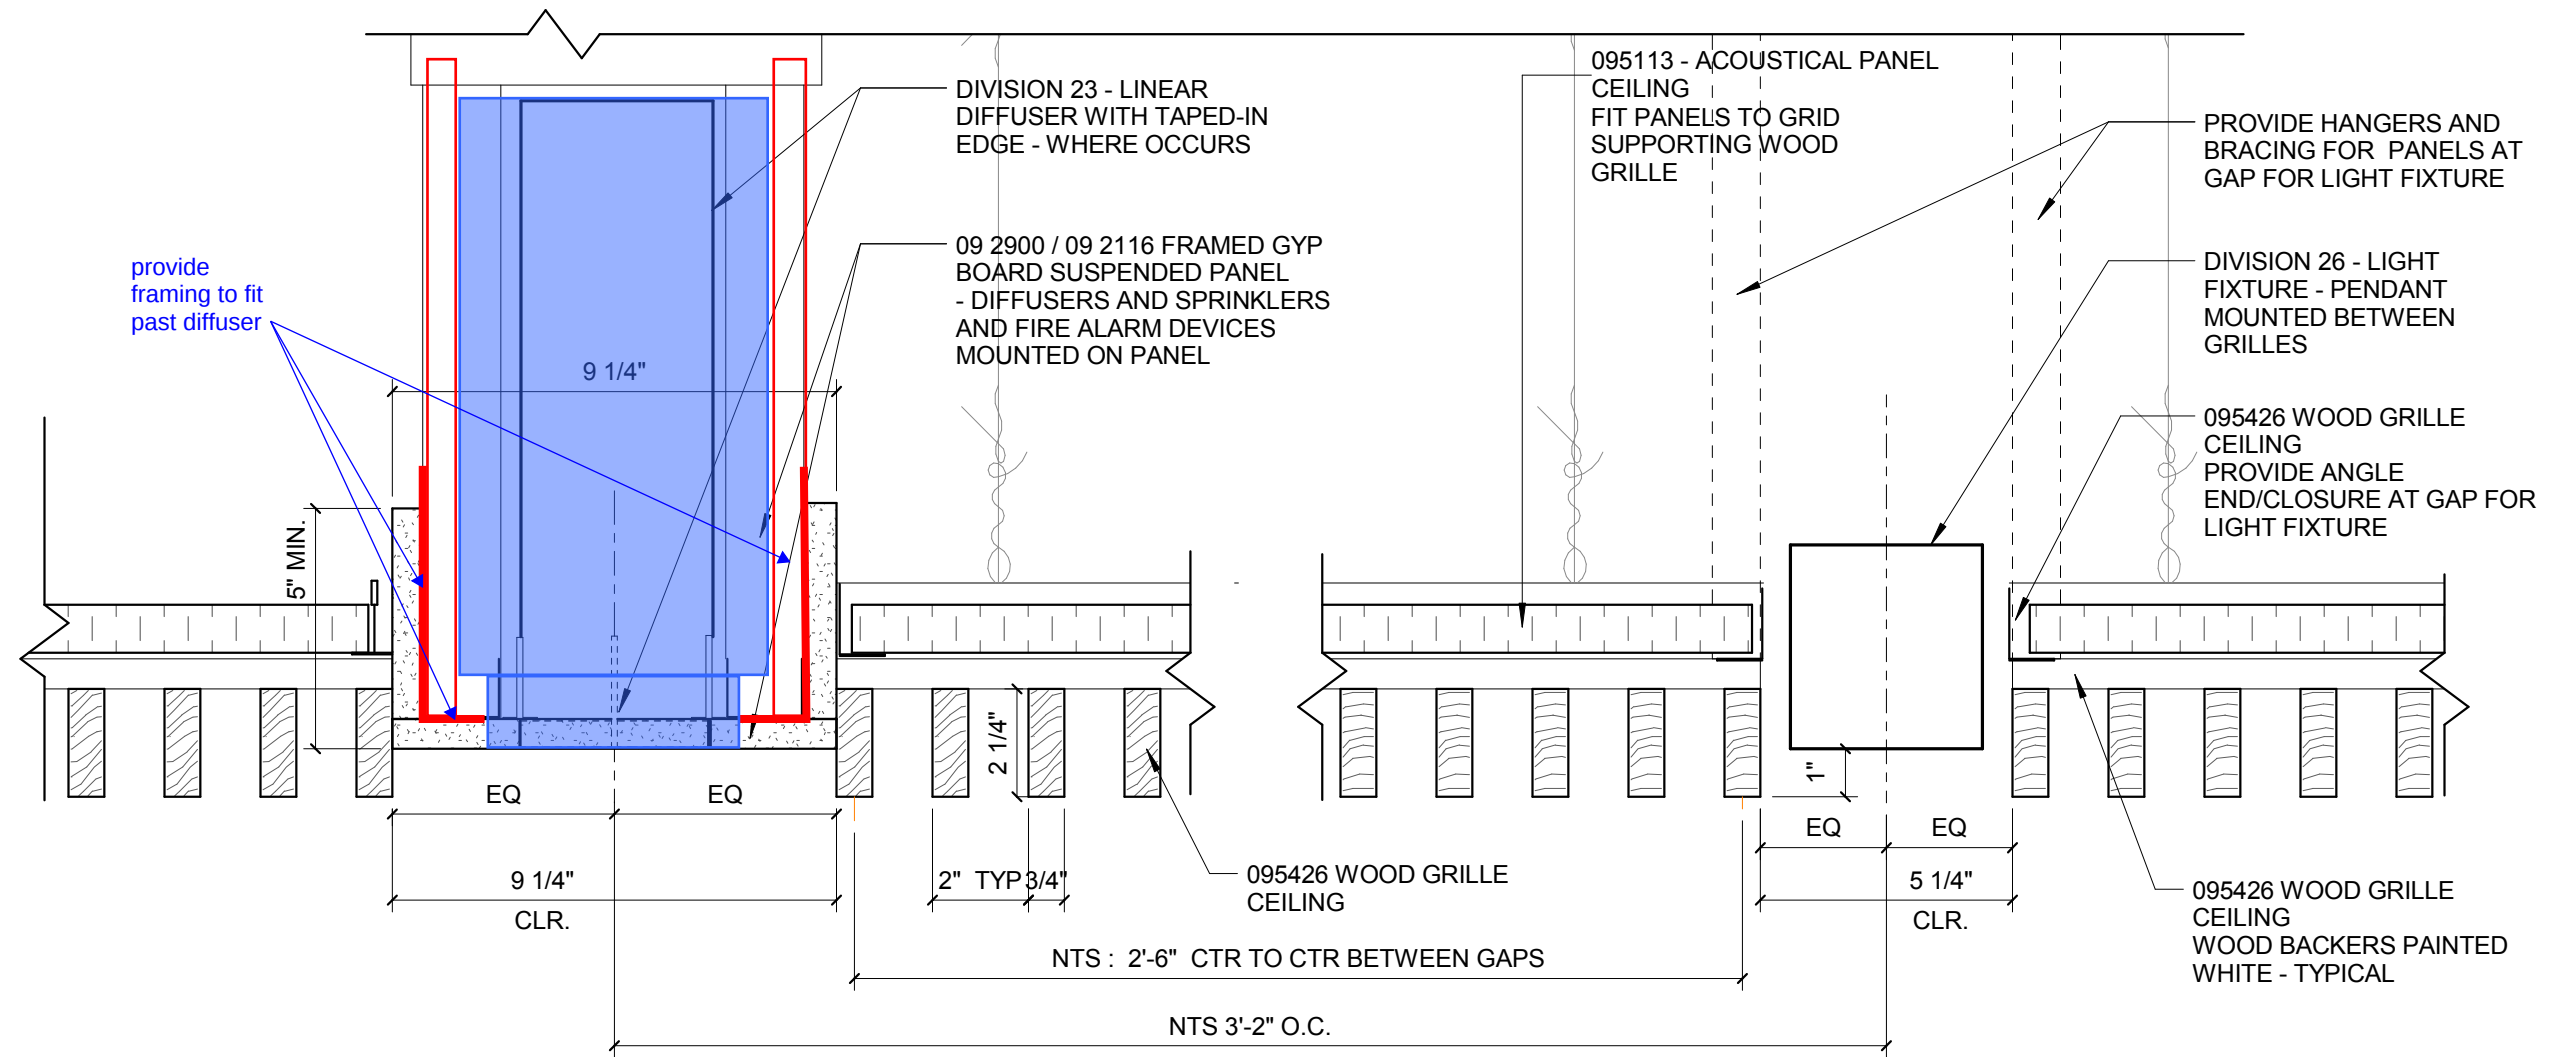

9 WOOD GRILLE CEILING DETAIL
3" = 1'-0"