

REQUEST FOR INFORMATION **DATE:** February 27, 2017 **NO.:** RFI-466

To: Cannon Design

Attn: Kelvin Patel

From: Paric Corporation

Requested By: Joe Voypick

Project Name: 15051-Webster University Interdisciplinary Science Building

Project No.: 15051

Subject: Casework layout at north wall of room 491

Response Required By: March 06, 2017

Drawing / Spec Reference:

Information Requested:


Please provide a dimension based off a grid line for the casework along the north wall of 491 so that lighting rough in can be installed.

Response:

See markups for dimensions

ARCHITECT'S RESPONSE:

This information is provided as an interpretation of the Contract Documents for implementation of the Contract Sum or Contract Time. If this information results in a claim for a change to the Contract, the Contractor shall notify the Architect of a change through the change process.

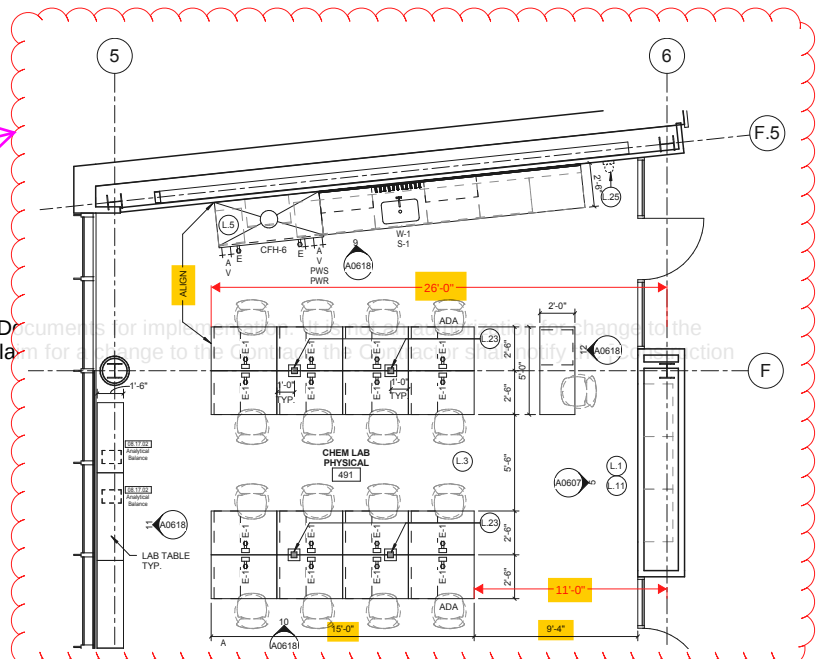

Answered By: Kelvin Patel

Date: 03/01/2017