



PARIC CORPORATION
77 Westport Plaza Suite 250
St. Louis, MO 63146
TEL: 636-561-9500
FAX: 636-561-9501

REQUEST FOR INFORMATION DATE: March 06, 2017 **NO.:** RFI-470

To: Cannon Design

Attn: Kelvin Patel

From: Paric Corporation

Requested By: Joe Voypick

Project Name: 15051-Webster University Interdisciplinary Science Building Project No.: 15051

Subject: Light Fixture & CUH Conflict Vestibule C250A

Response Required By: March 13, 2017

Drawing / Spec Reference:

Information Requested:

In Vestibule C250A there is a conflict between lighting and CUH-201. There is not sufficient space to install CUH-201 with the current light fixture. CUH-201 is 47.6" x 35".

Can the light fixture be shifted to the southwest or modified to accomodate CUH-201 install?

Response:


Yes, the light fixture can shift. We estimate the light fixture would not need to shift more than 5" to the southwest in order for everything to fit. Please advise if this will cause additional conflicts. The contractor shall ensure the CUH is mounted in such a way as to minimize how much the light fixture needs to shift.

ARCHITECT'S RESPONSE:

This information is provided as an interpretation of the Contract Documents for implementation. It is not an authorization for change to the Contract Sum or Contract Time. If this information results in a claim for a change to the Contract, the Contractor shall notify the [Construction Manager][Architect] of a change through the change process.

Answered By: Mark de la Fuente, WTA

Date: 3/10/17

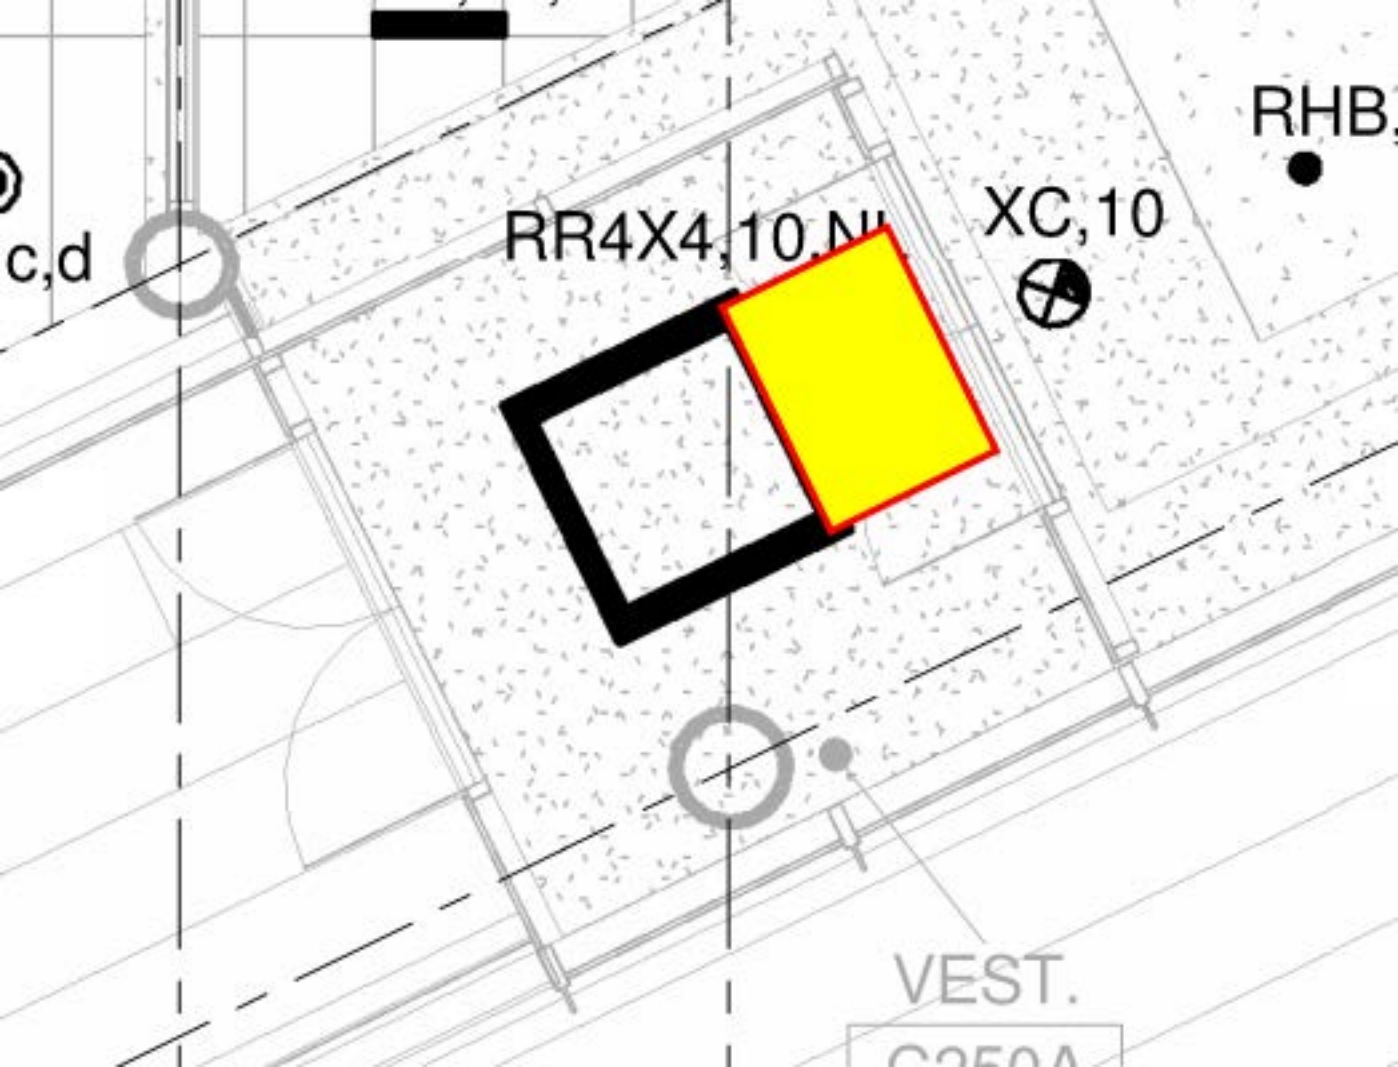

c,d

RR4X4,10.N

XC,10

RHB.

VEST.

C250A