



PARIC CORPORATION
77 Westport Plaza Suite 250
St. Louis, MO 63146
TEL: 636-561-9500
FAX: 636-561-9501

REQUEST FOR INFORMATION **DATE:** March 27, 2017 **NO.:** RFI-495

To: Cannon Design

Attn: Kelvin Patel

From: Paric Corporation

Requested By: Devin Gates

Project Name: 15051-Webster University Interdisciplinary Science Building Project No.: 15051

Subject: Barrier free eyewash conflicts

Response Required By: April 03, 2017

Drawing / Spec Reference:

Information Requested:


As noted on the returned shop drawings, the eyewashes have been updated to the barrier free ADA eyewash and placed in the drawings. There are 3 instances of conflicts where the eyewash extends past the edge of the sink. Please advise. Images handled.

Response: Option-1: Move the eyewash closer to the faucet provided its within the manufacturer's spacing recommendation.

Option-2: If the above approach still results in eyewash extending past the sink edge, then move the faucet & eyewash such that they are located equidistant from sink edges.


ARCHITECT'S RESPONSE:

This information is provided as an interpretation of the Contract Documents for implementation. It is not an authorization for change to the Contract Sum or Contract Time. If this information results in a claim for a change to the Contract, the Contractor shall notify the [Construction Manager][Architect] of a change through the change process.


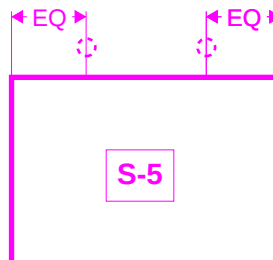


Answered By: Kelvin Patel

Date: 03/29/2017


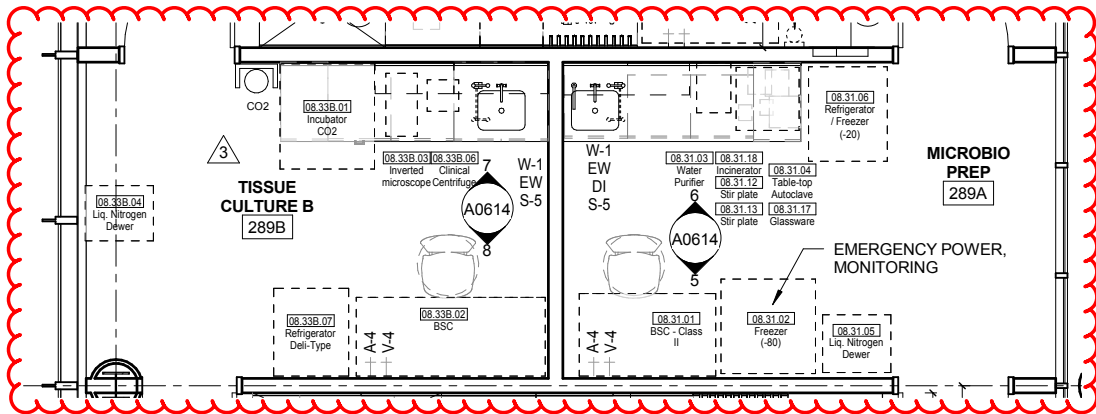


S-5 sink with EW are only in two rooms 289A and 289B. There are three locations submitted, provide room numbers for sink locations submitted in RFI for confirmation.

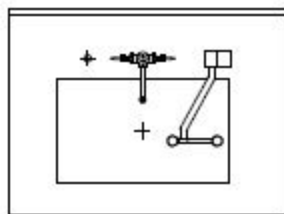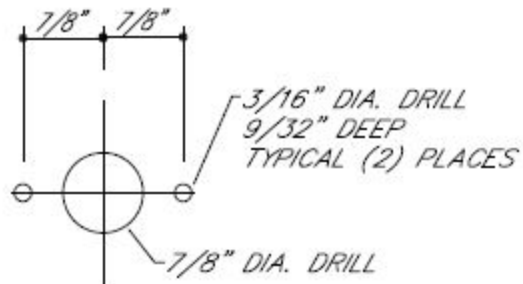



S-2 SINK

NOTE: EYEWASH LOCATION @ S-5
SINK MISSES SINK PLEASE ADVISE

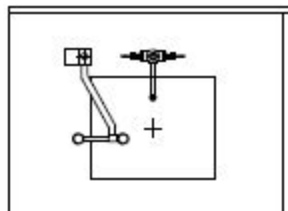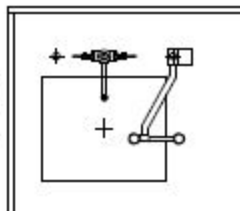



S-5 SINK

DRILL DETAIL "A"
(NOT TO SCALE)

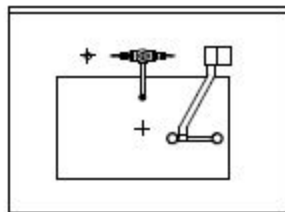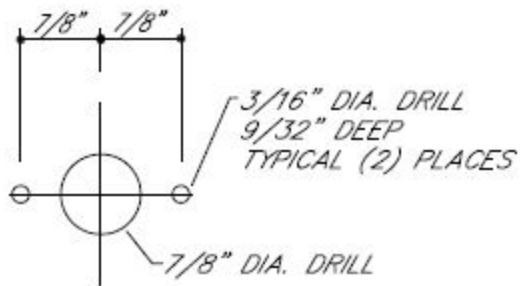



S-2 SINK

NOTE: EYEWASH LOCATION @ S-5
SINK MISSES SINK PLEASE ADVISE

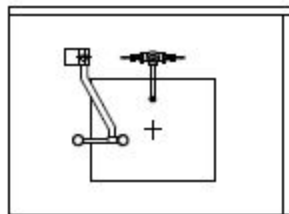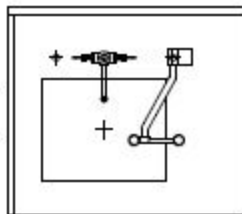

S-5 SINK



DRILL DETAIL "A"
(NOT TO SCALE)

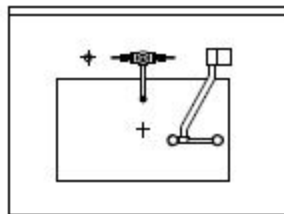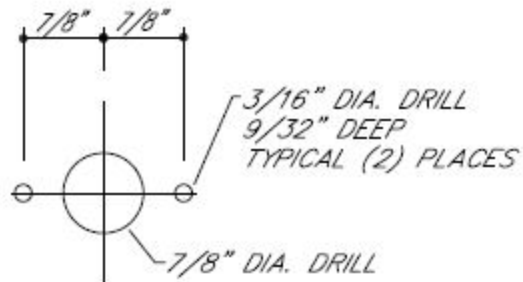

S-2 SINK

NOTE: EYEWASH LOCATION @ S-5
SINK MISSES SINK PLEASE ADVISE

DRILL DETAIL "A"
(NOT TO SCALE)

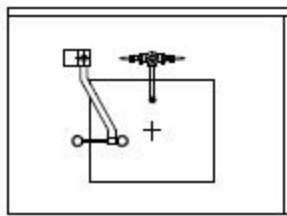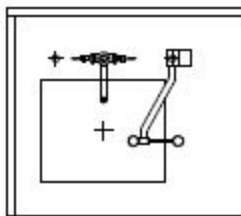

S-5 SINK