



PARIC CORPORATION
77 Westport Plaza Suite 250
St. Louis, MO 63146
TEL: 636-561-9500
FAX: 636-561-9501

REQUEST FOR INFORMATION	DATE: March 30, 2017	NO.: RFI-502
--------------------------------	-----------------------------	---------------------

To: Cannon Design

Attn: Kelvin Patel

From: Paric Corporation

Requested By: Devin Gates

Project Name: 15051-Webster University Interdisciplinary Science Building	Project No.: 15051
---	--------------------

Subject: Mechanical access doors needed in drywall ceilings

Response Required By: April 06, 2017

Drawing / Spec Reference:

Information Requested:

The attached shows locations where access doors are needed in drywall ceilings to access VAVs, shutoff valves, duct access doors and combination fire/smoke damper actuators. Locations and dimensions shown are strategic in gaining optimal access to all of the components mentioned above. These doors will be 22"x22" openings. Access doors are attached as well and have been submitted for approval.

Access door in Vestibule C153 for access to CUH-101 control valves.


Response:	1. Coordinate access door locations with Architect, actual installed equipment locations, and access requirements. 2. Coordinate color with Architect. Do not paint access doors shut. Spray paint should be used in lieu of 3/4" NAP roller. 3. Contractor proposed access door location on sheet A0702.A in Men's Rm 279 appears to conflict with air device. 4. Access doors were not attached to RFI, and, therefore, were not reviewed. 5. Locations of equipment requiring access doors was not submitted with RFI for comparison.
------------------	---

ARCHITECT'S RESPONSE:

This information is provided as an interpretation of the Contract Documents for implementation. It is not an authorization for change to the Contract Sum or Contract Time. If this information results in a claim for a change to the Contract, the Contractor shall notify the [Construction Manager][Architect] of a change through the change process.

Answered By: Mike Nolte, WTA

Date: 4/5/17

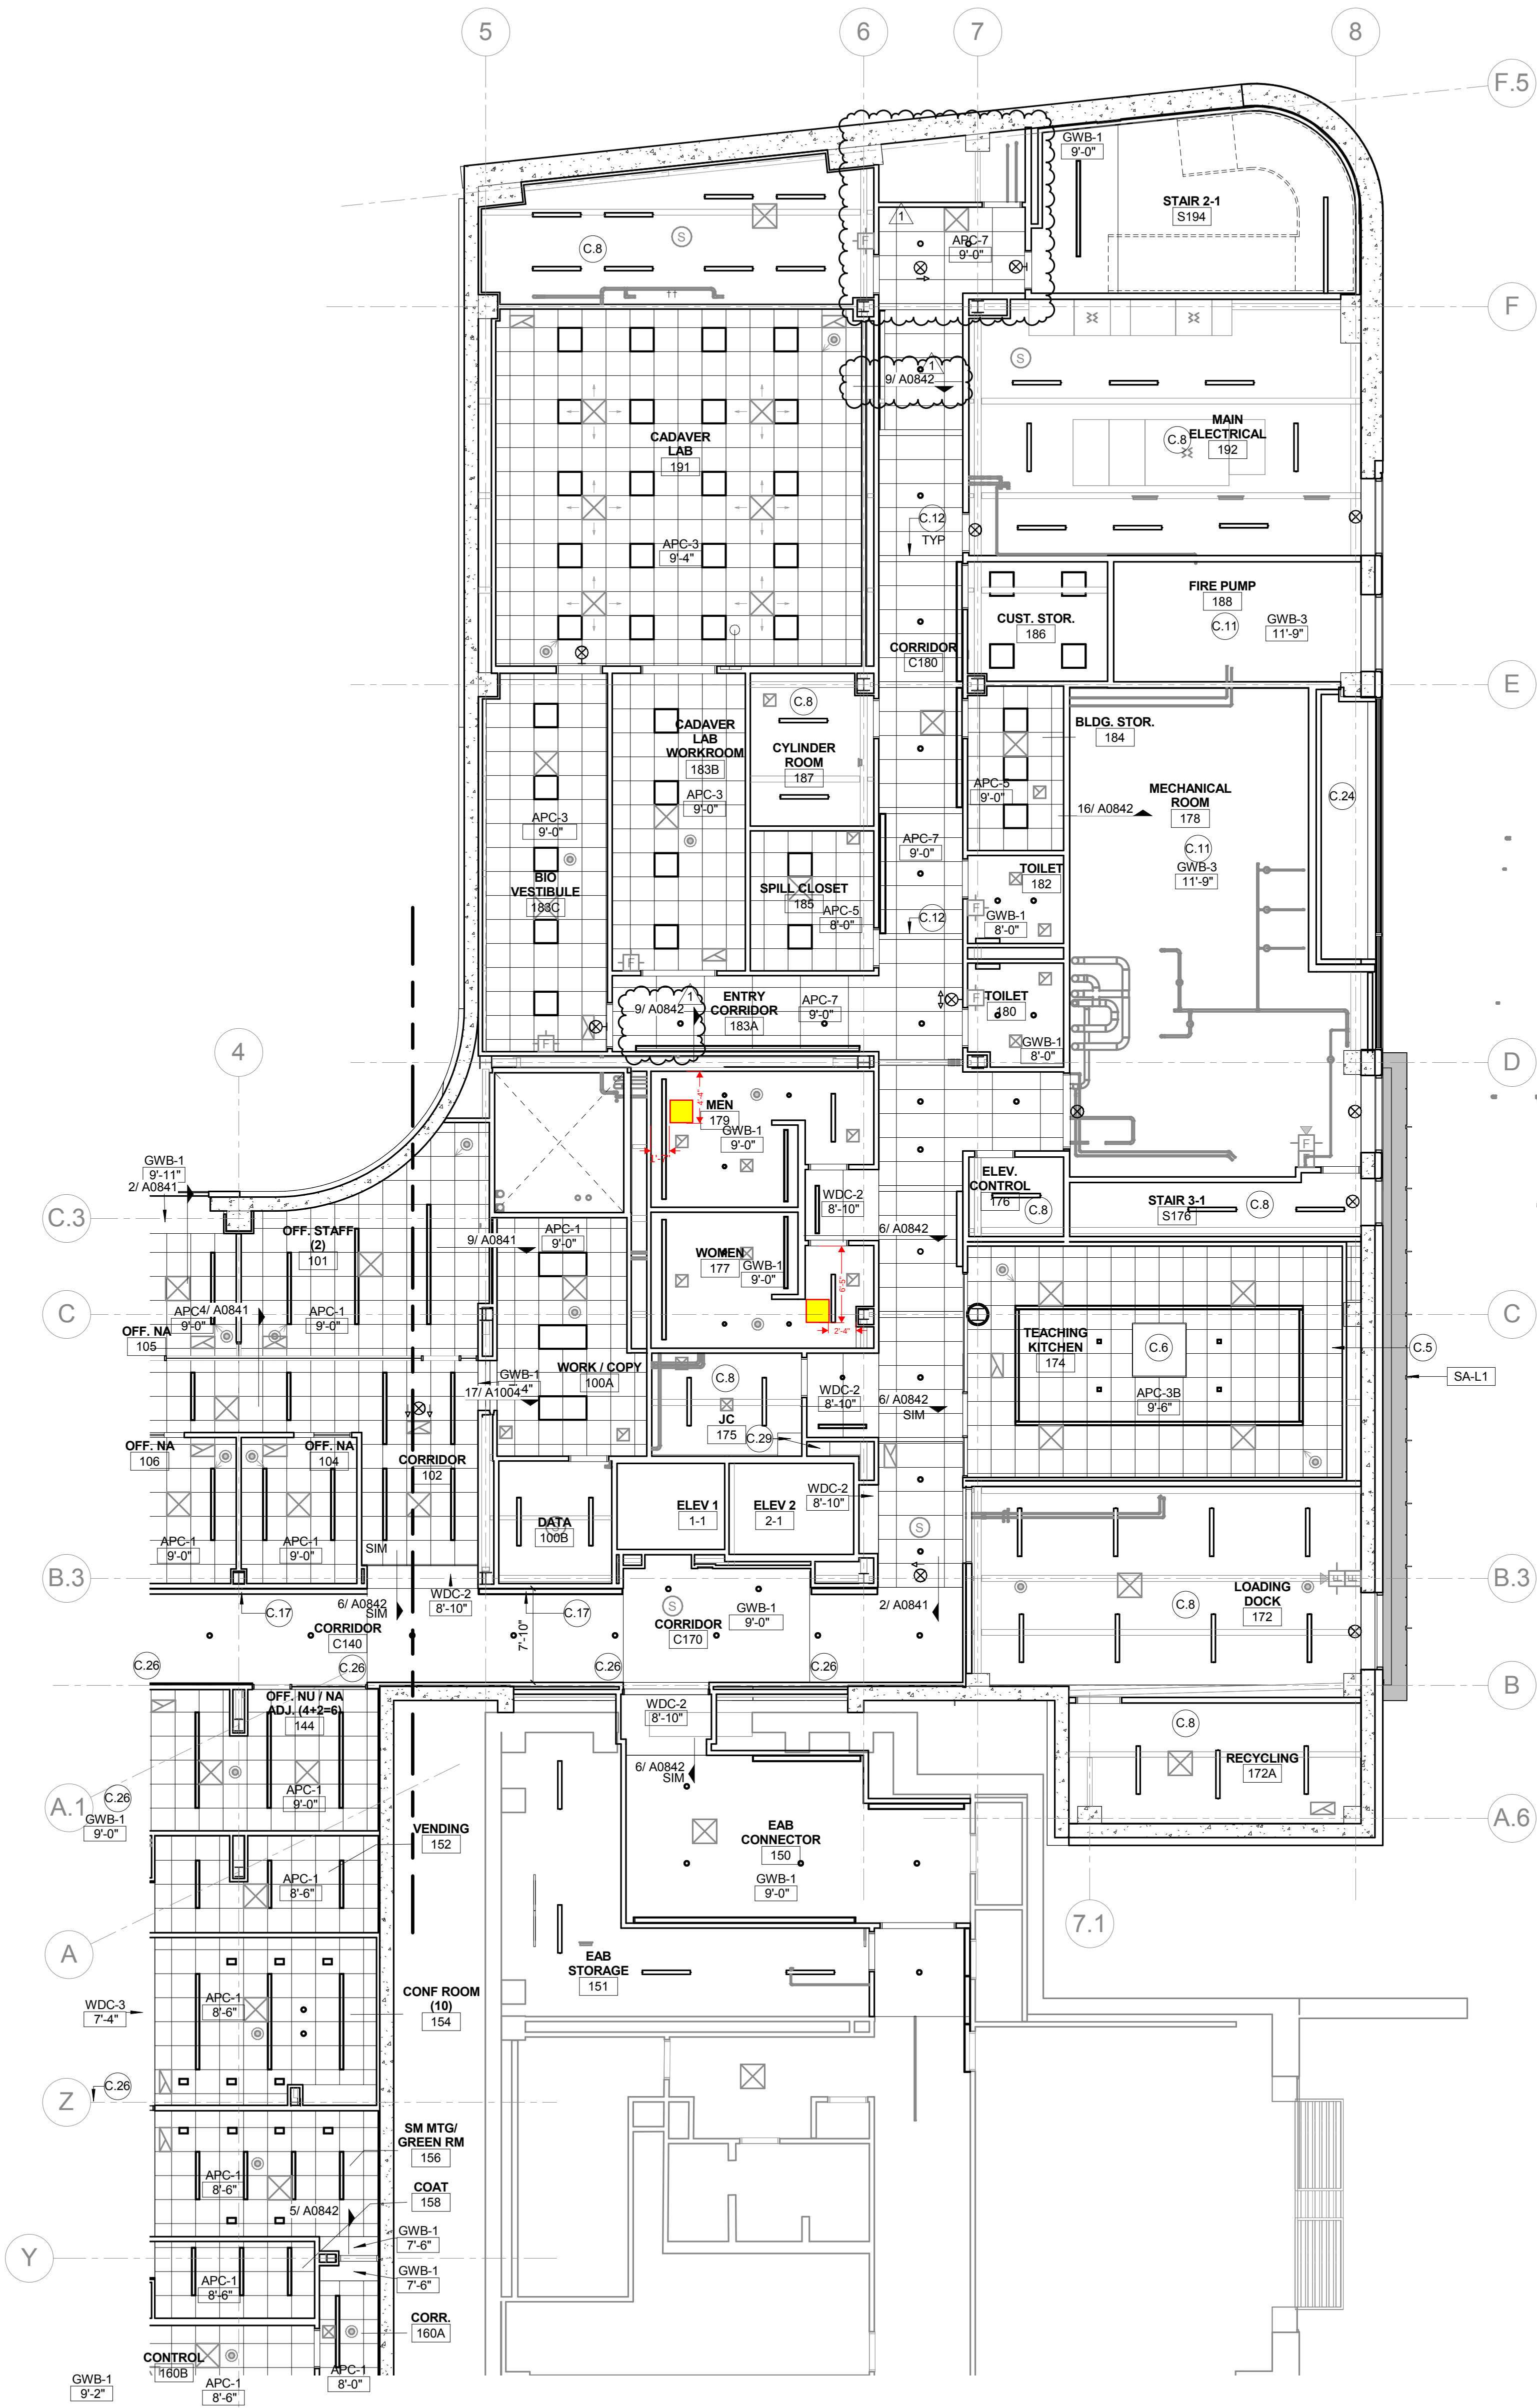

1 LEVEL 01 REFLECTED CEILING PLAN - AREA A
1/8" = 1'-0"

KEYED NOTE LEGEND - REFLECTED CEILING PLAN

- C.1 122413 TYPE 1 SHADES: MOTORIZED ROLLER SHADES IN CONTINUOUS RECESSED POCKET (OFCI)
- C.2 122413 TYPE 2 SHADES MOTORIZED DOUBLE ROLLER SHADES: SURFACE MOUNTED W/ CUSTOM COLOR FASCIA
- C.3 122413 TYPE 3 SHADES: MANUAL SHADES IN RECESSED POCKET
- C.4 122413 TYPE 4 SHADES: MULLION MOUNTED SHADE IN CONTINUOUS POCKET
- C.5 CEILING MOUNTING SUSPENSION FOR LCD SCREEN- PROVIDE STEEL SUPPORT ABOVE CEILING
- C.6 EXHAUST HOOD LOCATION - REFER TO FOOD SERVICE DRAWINGS
- C.7 FUME HOOD LOCATION - HOOD ENCLOSURE EXTENDS 6" ABOVE CEILING
- C.8 EXPOSED STRUCTURE
- C.9 083333 SIDE COILING DOOR TRACK
- C.10 ACOUSTICAL PANEL CEILING ABOVE WOOD GRILLE CEILING. 1" THICK
- C.11 ACOUSTICAL ISOLATION CEILING: 2 LAYERS 1/2" GYP BOARD CEILING ON SUSPENDED METAL FRAMING SUSPENSION SYSTEM TO BE ACOUSTICALLY ISOLATED FROM STRUCTURE BY SPRING/NEOPRENE ISOLATION HANGER - KINETIC NOISE CONTROL MODEL MUTA HANGERS PROVIDE CONTINUOUS LAYERS OF 3/5" FIBERGLASS ACOUSTIC BATTES. REFER TO DETAIL 16 SHEET A0842
- C.12 6" PANEL WHERE SHOWN @ 10'-6" O.C. MATCH CEILING TYPE
- C.13 RECESSED DRAPEY TRACK AND CURTAINS
- C.15 122413 TYPE 5 MOTORIZED DOUBLE ROLLER SHADE IN RECESSED POCKET.
- C.16 WOOD CEILING AT BOTTOM OF STAIRS - REFER TO STAIR 1 DRAWINGS AND DETAILS SHEET A0842
- C.17 CONTINUOUS COVE TYPE LIGHTING FIXTURE TAPED INTO GYP BOARD CEILING. REFER TO ELECTRICAL LIGHTING DRAWINGS AND TO DETAIL AT WALL SHEET A0842
- C.18 CEILING IN COLD ROOM BY COLD ROOM MFG
- C.19 G57500 MET ALUM. BEAM ENCLOSURE
- C.20 UNISTRUT MOUNTED TO CEILING W/ STEEL ANGLE HANGERS AND KICKERS ABOVE FOR SUPPORT
- C.21 STAINLESS STEEL STEAM CAPTURE HOOD ABOVE AUTOCLAVE
- C.22 REFER TO DETAIL 6/A0452
- C.23 122413 TYPE 6 SHADES: MANUAL SHADES IN RECESSED POCKET AT INTERIOR GLAZING: POCKET CONTINUOUS ACROSS OPENING
- C.24 INSULATED SOFFIT - SIMILAR TO WA-14 ON SHEET A0400
- C.25 CEILING MOUNTED SURGICAL LIGHT - SEE EQUIPMENT LIST (OFCI) - PROVIDE STRUCTURAL STEEL SUPPORT TO DECK - 4 - 2X2X 1/4" STEEL ANGLE HANGER WITH 4 - ANGLE KICKERS 2 X 2 X 1/4" AND MOUNTING PLATE PER MANUFACTURER. SEE DETAIL 01/A0914
- C.26 CONTROL JOINT LOCATION
- C.27 ABOVE CEILING WHERE INDICATED WITH DASHED LINE: PROVIDE 2 HOUR RATED HORIZONTAL GYP BOARD ENCLOSURE AROUND DUCTS SERVING FLOOR GRILLES ON LEVEL ABOVE. REFER TO DETAIL SHEET A1002
- C.28 ABOVE CEILING WHERE INDICATED WITH DASHED LINE: PROVIDE 2 HOUR RATED HORIZONTAL GYP BOARD ENCLOSURE AROUND STANDPIPE RUN. REFER TO DETAIL SHEET A1002
- C.29 PROVIDE 2 HOUR RATED HORIZONTAL GYP BOARD ENCLOSURE AT BOTTOM OF SHAFT. REFER TO DETAIL SHEET A1002
- C.30 122413 TYPE 7 SHADES MOTORIZED DOUBLE ROLLER SHADES: SURFACE MOUNTED W/ CUSTOM COLOR FASCIA
- C.31 122413 TYPE 8 MOTORIZED DOUBLE ROLLER SHADE IN RECESSED POCKET.
- C.32 SPECIAL ACOUSTICAL SEPARATION CEILING: APPLY KINETICS NOISE CONTROL QUIET TILE CAC-51 TO TOP SIDE OF ACOUSTICAL PANELS. ISOLATE CEILING TILE FROM STRUCTURE ABOVE WITH KNC AF HANGERS. - LEAVE 3/4" GAP ALL SIDES
- C.33 REVEAL TRIM AROUND DIAGONAL BRACE PENETRATION THROUGH CEILING
- C.34 LABORATORY OVERHEAD SERVICE CARRIER - REFER TO ENLARGED FLOOR PLANS
- C.35 EMERGENCY SAFETY SHOWER - PIPING TO HEAD ABOVE CEILING
- C.36 122413 TYPE 3 SHADES: MANUAL SHADES - STEPPED WITH SLOPE IN CONT. SLOPED OPENING

CEILING LEGEND


- APC-1 2' x 2' - ARMSTRONG OPTIMA TEGULAR 1" THICK, NRC - 90, IN 9/16" GRID
- APC-2 2' x 2' - ARMSTRONG ULTIMA TEGULAR 1" THICK, NRC - 90, IN 9/16" GRID
- APC-3A 2' x 2' - ARMSTRONG ULTIMA HEALTH ZONE IN 9/16" GRID
- APC-3B 2' x 2' - ARMSTRONG ULTIMA HEALTH ZONE TEGULAR 9/16" GRID
- APC-4 NOT USED
- APC-5 2' x 2' - ARMSTRONG FINE FISSURED IN 15/16" GRID
- APC-6 088310 ACOUSTICAL PLASTER: BASWAPHON (40 MM) OVER 1 1/2" INSULATION OVER GYP. BOARD
- APC-7 2' x 4' - ARMSTRONG ULTIMA TEGULAR IN 9/16" SILHOUETTE XL GRID W/ 6" PANEL INSERTS AS SHOWN
- APC-8 2' x 6' ARMSTRONG OPTIMA TEGULAR - 1" THICK, NRC - 90, IN 9/16" SILHOUETTE XL 1/8" GRID MATCH APC-7 - EXCEPT, REF. 085113- SPECIAL ACOUSTIC TREATMENT: APPLY SPECIAL ACOUSTIC MATERIAL TO TOP SIDE OF PANELS AND PROVIDE ISOLATORS FOR CEILING HANGERS:

- WDC-1 09 5426 WOOD GRILLE CEILING W/ 3/4" x 2 1/4" MEMBERS - 6 PER FOOT - NINEWOOD GRILL 1400 W/ 1" THICK ARMSTRONG OPTIMA PANELS FIT TO GRID SUPPORT ABOVE
- WDC-2 06 4216 FLUSH WOOD PANEL SOFFIT - MATCH WVP-1
- WDC-3 06 4216 OPAQUE WOOD PANEL TO MATCH WOOD ACOUST WALL PANEL

- GWB-1 PAINTED GYP. BOARD
- GWB-2 GYP. BOARD W/ COATING TO MATCH ADJACENT ACOUST. PLASTER

CONFORMED SET 01 JUL 2016

1	ADDENDUM 3-2	15 APR 2016
-	ISSUED FOR CONSTRUCTION (BP3)	15 MAR 2016
No.	Description	Date

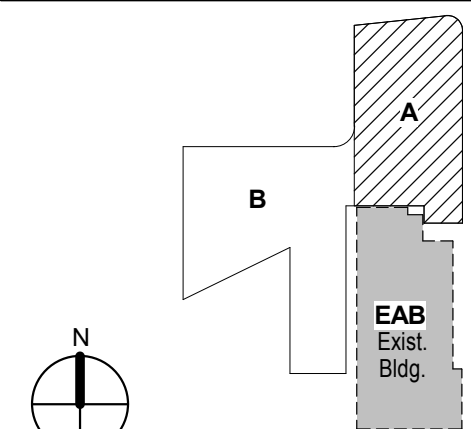

KEY PLAN

Drawing Title:

LEVEL 01 REFLECTED
CEILING PLAN AREA A

Project No.: 04561.01 Checked by:

A0701.A

KEYED NOTE LEGEND - REFLECTED CEILING PLAN


- C.1 122413 TYPE 1 SHADES: MOTORIZED ROLLER SHADES IN CONTINUOUS RECESSED POCKET (OFCI)
- C.2 122413 TYPE 2 SHADES: MOTORIZED DOUBLE ROLLER SHADES: SURFACE MOUNTED W/ CUSTOM COLOR FASCIA
- C.3 122413 TYPE 3 SHADES: MANUAL SHADES IN RECESSED POCKET
- C.4 122413 TYPE 4 SHADES: MULLION MOUNTED SHADE IN CONTINUOUS POCKET
- C.5 CEILING MOUNTING SUSPENSION FOR LCD SCREEN- PROVIDE STEEL SUPPORT ABOVE CEILING
- C.6 EXHAUST HOOD LOCATION - REFER TO FOOD SERVICE DRAWINGS
- C.7 FUME HOOD LOCATION - HOOD ENCLOSURE EXTENDS 6" ABOVE CEILING
- C.8 EXPOSED STRUCTURE
- C.9 083333 SIDE COILING DOOR TRACK
- C.10 ACOUSTICAL PANEL CEILING ABOVE WOOD GRILLE CEILING. 1" THICK ARMSTRONG OPTIMA PANELS FIT TO GRID FOR WOOD GRILLE CEILING
- C.11 ACOUSTICAL ISOLATION CEILING: 2 LAYERS 1/2" GYP BOARD CEILING ON SUSPENDED METAL FRAMING SUSPENSION SYSTEM TO BE ACOUSTICALLY ISOLATED FROM STRUCTURE BY SPRING/NEOPRENE ISOLATION HANGER - KINETIC NOISE CONTROL MODEL. MUTA HANGERS: PROVIDE CONTINUOUS LAYERS OF 3.5" FIBERGLASS ACOUSTIC BATT'S. REFER TO DETAIL 16 SHEET A0842
- C.12 6" PANEL WHERE SHOWN @ 10'-6" O.C. MATCH CEILING TYPE
- C.13 RECESSED DRAPEY TRACK AND CURTAINS - OFCI - PROVIDE BLOCKING
- C.15 122413 TYPE 5 MOTORIZED DOUBLE ROLLER SHADE IN RECESSED POCKET
- C.16 WOOD CEILING AT BOTTOM OF STAIRS - REFER TO STAIR 1 DRAWINGS AND DETAILS SHEET A0501
- C.17 CONTINUOUS COVE TYPE LIGHTING FIXTURE TAPED INTO GYP BOARD CEILING. REFER TO ELECTRICAL LIGHTING DRAWINGS AND TO DETAIL AT WALL SHEET A0842
- C.18 CEILING IN COLD ROOM BY COLD ROOM MFG
- C.19 G57500 MET ALUM. BEAM ENCLOSURE
- C.20 UNISTRUT MOUNTED TO CEILING W/ STEEL ANGLE HANGERS AND KICKERS ABOVE FOR SUPPORT
- C.21 STAINLESS STEEL STEAM CAPTURE HOOD ABOVE AUTOCLAVE
- C.22 REFER TO DETAIL 6/A0452
- C.23 122413 TYPE 6 SHADES: MANUAL SHADES IN RECESSED POCKET AT INTERIOR GLAZING. POCKET CONTINUOUS ACROSS OPENING
- C.24 INSULATED SOFFIT - SIMILAR TO WA-L4 ON SHEET A0400
- C.25 CEILING MOUNTED SURGICAL LIGHT - SEE EQUIPMENT LIST (OFCI) - PROVIDE STRUCTURAL STEEL SUPPORT TO DECK - 4 - 2X2X 1/4" STEEL ANGLE HANGER WITH 4 - ANGLE KICKERS 2 X 2 X 1/4". AND MOUNTING PLATE PER MANUFACTURER. SEE DETAIL 01/A0914.
- C.26 CONTROL JOINT LOCATION
- C.27 ABOVE CEILING WHERE INDICATED WITH DASHED LINE: PROVIDE 2 HOUR RATED HORIZONTAL GYP BOARD ENCLOSURE AROUND DUCTS SERVING FLOOR GRILLES ON LEVEL ABOVE. REFER TO DETAIL SHEET A1002
- C.28 ABOVE CEILING WHERE INDICATED WITH DASHED LINE: PROVIDE 2 HOUR RATED HORIZONTAL GYP BOARD ENCLOSURE AROUND STANDPIPE RUN. REFER TO DETAIL SHEET A1002
- C.29 PROVIDE 2 HOUR RATED HORIZONTAL GYP BOARD ENCLOSURE AT BOTTOM OF SHAFT. REFER TO DETAIL SHEET A1002
- C.30 122413 TYPE 7 SHADES: MOTORIZED DOUBLE ROLLER SHADES: SURFACE MOUNTED W/ CUSTOM COLOR FASCIA
- C.31 122413 TYPE 8 MOTORIZED DOUBLE ROLLER SHADE IN RECESSED POCKET. SPECIAL ACOUSTICAL SEPARATION CEILING: APPLY KINETICS NOISE CONTROL QUIET TILE CAC-51 TO TOP SIDE OF ACOUSTICAL PANELS. ISOLATE CEILING TILE FROM STRUCTURE ABOVE WITH KNC AF HANGERS.
- C.33 REVEAL TRIM AROUND DIAGONAL BRACE PENETRATION THROUGH CEILING - LEAVE 3/4" GAP ALL SIDES
- C.34 LABORATORY OVERHEAD SERVICE CARRIER - REFER TO ENLARGED FLOOR PLANS
- C.35 EMERGENCY SAFETY SHOWER - PIPING TO HEAD ABOVE CEILING
- C.36 122413 TYPE 3 SHADES: MANUAL SHADES - STEPPED WITH SLOPE IN CONT. SLOPED OPENING

CEILING LEGEND

- APC-1 2' x 2' - ARMSTRONG OPTIMA REGULAR 1" THICK IN 9/16" GRID
- APC-2 2' x 4' - ARMSTRONG ULTIMA REGULAR IN 9/16" SILHOUETTE XL 1/8" GRID
- APC-3A 2' x 2' - ARMSTRONG ULTIMA HEALTH ZONE IN 9/16" GRID
- APC-3B 2' x 2' - ARMSTRONG ULTIMA HEALTH ZONE REGULAR 9/16" GRID
- APC-4 NOT USED
- APC-5 2' x 2' - ARMSTRONG FINE FISSURED IN 15/16" GRID
- APC-6 089310 ACOUSTICAL PLASTER: BASWAPHON (40 MM) OVER 1 1/2" INSULATION OVER GYP. BOARD
- APC-7 2' x 4' - ARMSTRONG ULTIMA REGULAR IN 9/16" SILHOUETTE XL GRID W/ 6" PANEL INSERTS AS SHOWN
- APC-8 2' x 6' ARMSTRONG OPTIMA REGULAR - 1" THICK, NRC - .90. IN 9/16" SILHOUETTE XL 1/8" GRID
- APC-9 MATCH APC-7 - EXCEPT: REF. 089113- SPECIAL ACOUSTIC TREATMENT: APPLY SPECIAL ACOUSTIC MATERIAL TO TOP SIDE OF PANELS AND PROVIDE ISOLATORS FOR CEILING HANGERS.

- WDC-1 09 5426 WOOD GRILLE CEILING W/ 3/4" x 2 1/4" MEMBERS - 6 PER FOOT - NINEWOOD GRILL
- WDC-2 06 4216 FLUSH WOOD PANEL SOFFIT - MATCH WVP-1
- WDC-3 06 4216 OPAQUE WOOD PANEL TO MATCH WOOD ACOUST WALL PANEL

- GWB-1 PAINTED GYP. BOARD
- GWB-2 GYP. BOARD W/ COATING TO MATCH ADJACENT ACOUST. PLASTER

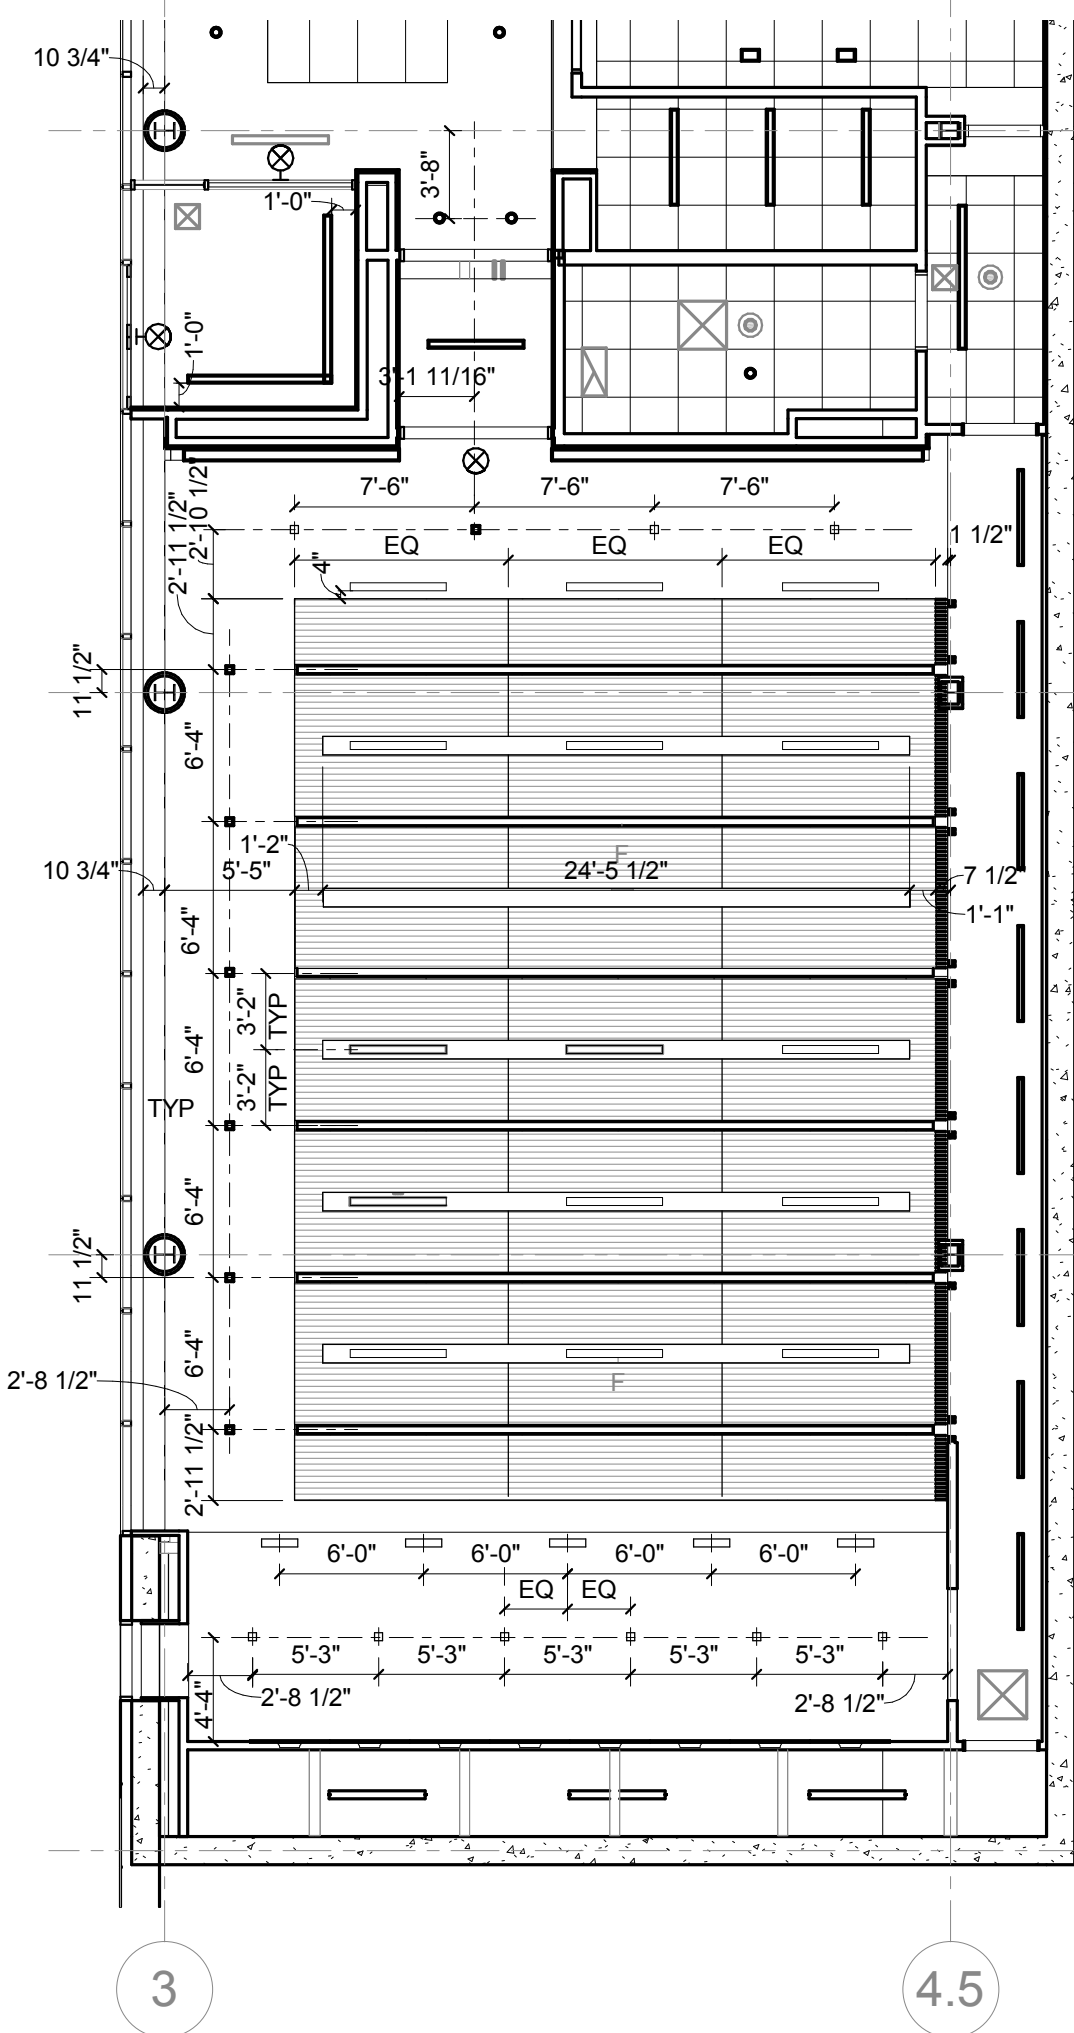

2 LECTURE HALL RCP - DIMENSIONS

1/8" = 1'-0"



1 LEVEL 01 REFLECTED CEILING PLAN - AREA B

1/8" = 1'-0"



KEY PLAN


LEVEL 01 REFLECTED
CEILING PLAN AREA B

Project No.: 04561.01 Checked by:

A0701.B

CONFORMED SET 01 JUL 2016

1	ADDENDUM 3-2	15 APR 2016
1	ISSUED FOR CONSTRUCTION (BP3)	15 MAR 2016
No.	Description	Date

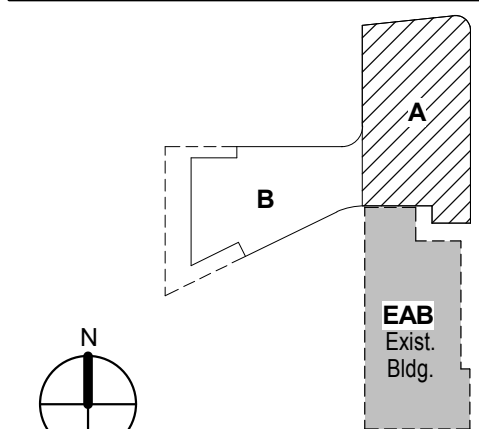


KEY PLAN

LEVEL 02 REFLECTED
CEILING PLAN AREA A

Project No.: 04561.01 Checked by:

A0702.A

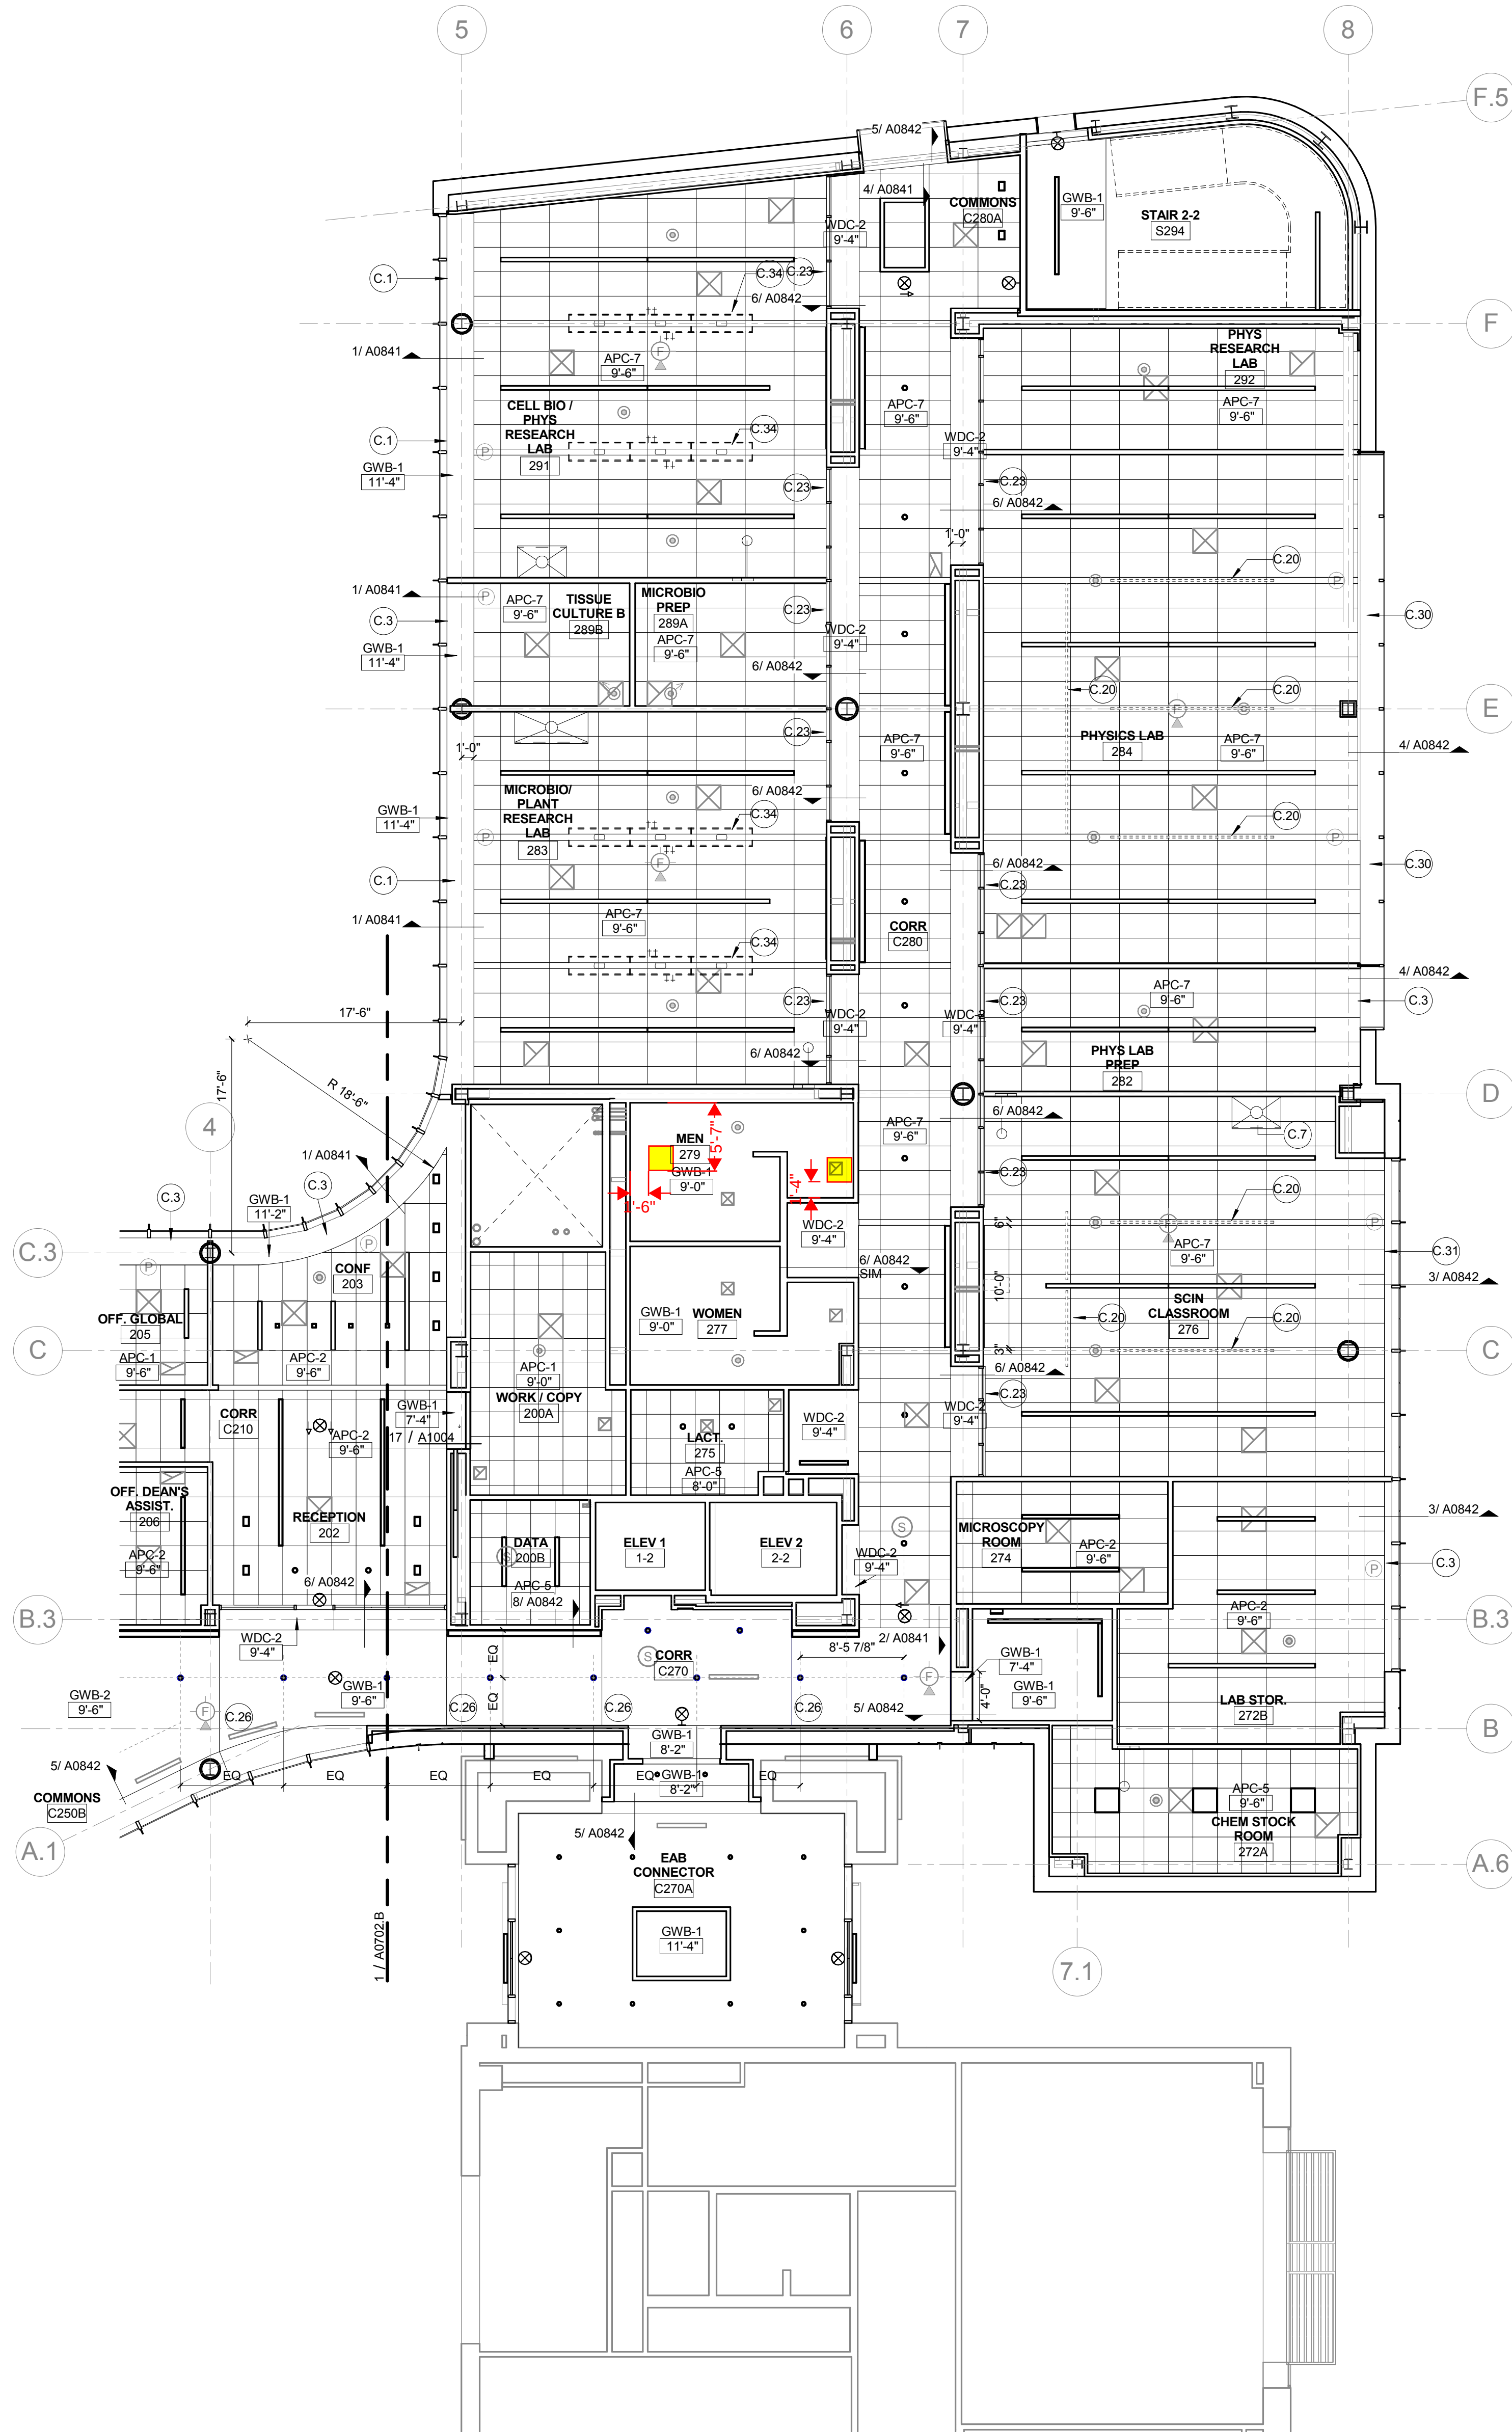


1 LEVEL 02 REFLECTED CEILING PLAN - AREA A
1/8" = 1'-0"

KEYED NOTE LEGEND - REFLECTED CEILING PLAN

- C.1 122413 TYPE 1 SHADES: MOTORIZED ROLLER SHADES IN CONTINUOUS RECESSED POCKET (SPCI)
- C.2 122413 TYPE 2 SHADES MOTORIZED DOUBLE ROLLER SHADES: SURFACE MOUNTED W/ CUSTOM COLOR FASCIA
- C.3 122413 TYPE 3 SHADES: MANUAL SHADES IN RECESSED POCKET
- C.4 122413 TYPE 4 SHADES: MULLION MOUNTED SHADE IN CONTINUOUS POCKET
- C.5 CEILING MOUNTING SUSPENSION FOR LCD SCREEN- PROVIDE STEEL SUPPORT ABOVE CEILING
- C.6 EXHAUST HOOD LOCATION - REFER TO FOOD SERVICE DRAWINGS
- C.7 FUME HOOD LOCATION - HOOD ENCLOSURE EXTENDS 6" ABOVE CEILING
- C.8 EXPOSED STRUCTURE
- C.9 083333 SIDE COILING DOOR TRACK
- C.10 ACOUSTICAL PANEL CEILING ABOVE WOOD GRILLE CEILING. 1" THICK
- C.11 ACOUSTICAL ISOLATION CEILING: 2 LAYERS 1/2" GYP BOARD CEILING ON SUSPENDED METAL FRAMING SUSPENSION SYSTEM TO BE ACOUSTICALLY ISOLATED FROM STRUCTURE BY SPRING/NEOPRENE ISOLATION HANGER - KINETIC NOISE CONTROL MODEL MUTA HANGERS. PROVIDE CONTINUOUS LAYERS OF 3/8" FIBERGLASS ACOUSTIC BATTES. REFER TO DETAIL 16 SHEET A0842
- C.12 6" PANEL WHERE SHOWN @ 10'-6" O.C. MATCH CEILING TYPE
- C.13 RECESSED DRAPEY TRACK AND CURTAINS
- C.15 122413 TYPE 5 MOTORIZED DOUBLE ROLLER SHADE IN RECESSED POCKET.
- C.16 WOOD CEILING AT BOTTOM OF STAIRS - REFER TO STAIR 1 DRAWINGS AND DETAIL SHEET A0842
- C.17 CONTINUOUS COVE TYPE LIGHTING FIXTURE TAPERED W/ GYP BOARD CEILING. REFER TO ELECTRICAL LIGHTING DRAWINGS AND TO DETAIL AT WALL SHEET A0842
- C.18 CEILING IN COLD ROOM BY COLD ROOM MFG
- C.19 G57500 MET ALUM. BEAM ENCLOSURE
- C.20 UNISTRUT MOUNTED TO CEILING W/ STEEL ANGLE HANGERS AND KICKERS ABOVE FOR SUPPORT
- C.21 STAINLESS STEEL STEAM CAPTURE HOOD ABOVE AUTOCLAVE
- C.22 REFER TO DETAIL 6/A0452
- C.23 122413 TYPE 6 SHADES: MANUAL SHADES IN RECESSED POCKET AT INTERIOR GLAZING. POCKET CONTINUOUS ACROSS OPENING
- C.24 INSULATED SOFFIT - SIMILAR TO WA-L4 ON SHEET A0400
- C.25 CEILING MOUNTED SURGICAL LIGHT - SEE EQUIPMENT LIST (OFCL) - PROVIDE STRUCTURAL STEEL SUPPORT TO DECK - 4 - 2X2X 1/4" STEEL ANGLE HANGER WITH 4 - ANGLE KICKERS 2 X 2 X 1/4". AND MOUNTING PLATE PER MANUFACTURER. SEE DETAIL 01/A0814.
- C.26 CONTROL JOINT LOCATION
- C.27 ABOVE CEILING WHERE INDICATED WITH DASHED LINE: PROVIDE 2 HOUR RATED HORIZONTAL GYP BOARD ENCLOSURE AROUND DUCTS SERVING FLOOR GRILLES ON LEVEL ABOVE. REFER TO DETAIL SHEET A1002
- C.28 ABOVE CEILING WHERE INDICATED WITH DASHED LINE: PROVIDE 2 HOUR RATED HORIZONTAL GYP BOARD ENCLOSURE AROUND STANDPIPE RUN. REFER TO DETAIL SHEET A1002
- C.29 PROVIDE 2 HOUR RATED HORIZONTAL GYP BOARD ENCLOSURE AT BOTTOM OF SHAFT. REFER TO DETAIL SHEET A1002
- C.30 122413 TYPE 7 SHADES MOTORIZED DOUBLE ROLLER SHADES: SURFACE MOUNTED W/ CUSTOM COLOR FASCIA
- C.31 122413 TYPE 8 MOTORIZED DOUBLE ROLLER SHADE IN RECESSED POCKET. SPECIAL ACOUSTICAL SEPARATION CEILING: APPLY KINETICS NOISE CONTROL QUIET TILE CAC-51 TO TOP SIDE OF ACOUSTICAL PANELS. ISOLATE CEILING TILE FROM STRUCTURE ABOVE WITH KNC AF HANGERS. REVEAL TRIM AROUND DIAGONAL BRACE PENETRATION THROUGH CEILING - LEAVE 3/4" GAP ALL SIDES
- C.34 LABORATORY OVERHEAD SERVICE CARRIER - REFER TO ENLARGED FLOOR PLANS
- C.35 EMERGENCY SAFETY SHOWER - PIPING TO HEAD ABOVE CEILING
- C.36 122413 TYPE 3 SHADES: MANUAL SHADES - STEPPED WITH SLOPE IN CONT. SLOPED OPENING

CEILING LEGEND

- WDC-1 09 5426 WOOD GRILLE CEILING W/ 3/4" X 2 1/4" MEMBERS - 6 PER FOOT - NINEWOOD GRILL 1400 W/ 1" THICK ARMSTRONG OPTIMA PANELS FIT TO GRID SUPPORT ABOVE
- WDC-2 06 4216 FLUSH WOOD PANEL SOFFIT - MATCH WVP-1
- WDC-3 06 4216 OPAQUE WOOD PANEL TO MATCH WOOD ACOUST WALL PANEL
- GWB-1 PAINTED GYP. BOARD
- GWB-2 GYP. BOARD W/ COATING TO MATCH ADJACENT ACOUST. PLASTER

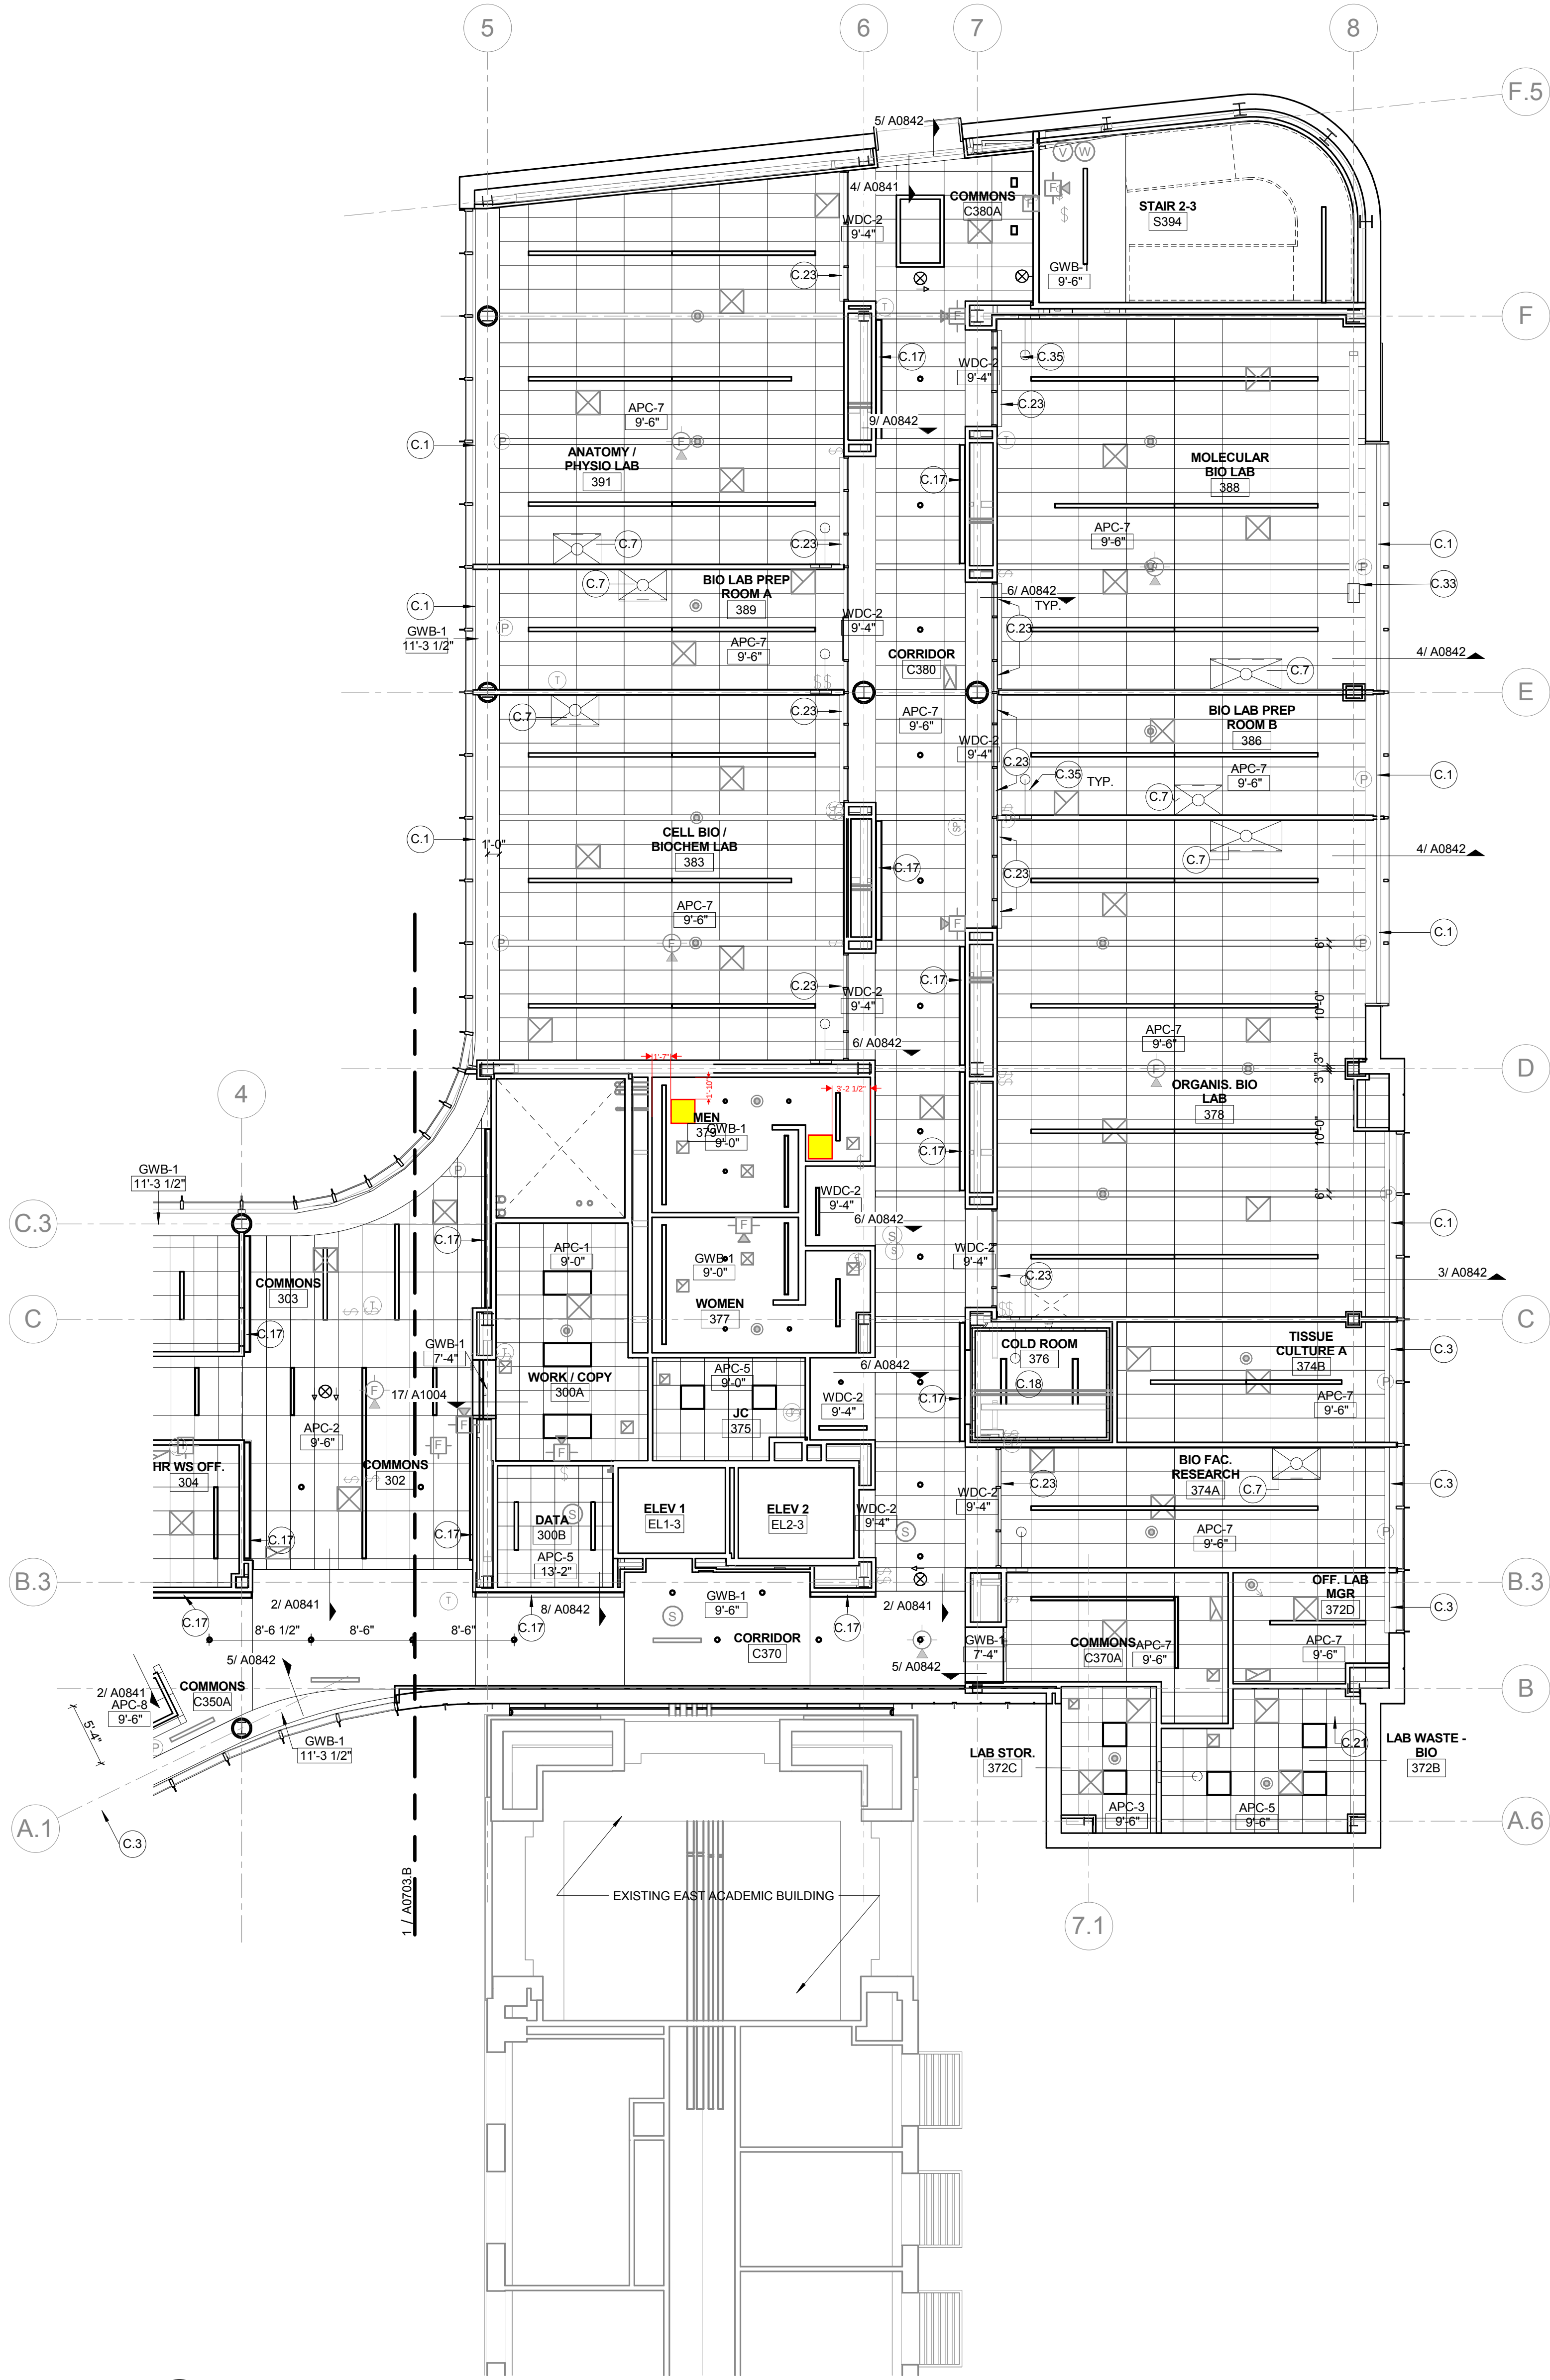

1 LEVEL 03 REFLECTED CEILING PLAN - AREA A
1/8" = 1'-0"

KEYED NOTE LEGEND - REFLECTED CEILING PLAN

- C.1 122413 TYPE 1 SHADES: MOTORIZED ROLLER SHADES IN CONTINUOUS RECESSED POCKET (OFCI)
- C.2 122413 TYPE 2 SHADES: MOTORIZED DOUBLE ROLLER SHADES: SURFACE MOUNTED W/ CUSTOM COLOR FASCIA
- C.3 122413 TYPE 3 SHADES: MANUAL SHADES IN RECESSED POCKET
- C.4 122413 TYPE 4 SHADES: MULLION MOUNTED SHADE IN CONTINUOUS POCKET
- C.5 CEILING MOUNTING SUSPENSION FOR LCD SCREEN- PROVIDE STEEL SUPPORT ABOVE CEILING
- C.6 EXHAUST HOOD LOCATION - REFER TO FOOD SERVICE DRAWINGS
- C.7 FUME HOOD LOCATION - HOOD ENCLOSURE EXTENDS 6" ABOVE CEILING
- C.8 EXPOSED STRUCTURE
- C.9 083333 SIDE COILING DOOR TRACK
- C.10 ACOUSTICAL PANEL CEILING ABOVE WOOD GRILLE CEILING. 1" THICK
- C.11 ACOUSTICAL ISOLATION CEILING: 2 LAYERS 1/2" GYP BOARD CEILING ON SUSPENDED METAL FRAMING SUSPENSION SYSTEM TO BE ACOUSTICALLY ISOLATED FROM STRUCTURE BY SPRING/NEOPRENE ISOLATION HANGER - KINETIC NOISE CONTROL MODEL. MUTA HANGERS: PROVIDE CONTINUOUS LAYERS OF 3/8" FIBERGLASS ACOUSTIC BATTES. REFER TO DETAIL 01A0914
- C.12 6" PANEL WHERE SHOWN @ 10'-6" O.C. MATCH CEILING TYPE
- C.13 RECESSED DRAPEY TRACK AND CURTAINS
- C.15 122413 TYPE 5 MOTORIZED DOUBLE ROLLER SHADE IN RECESSED POCKET.
- C.16 WOOD CEILING AT BOTTOM OF STAIRS - REFER TO STAIR 1 DRAWINGS AND DETAILS SHEET A042
- C.17 CONTINUOUS COVE TYPE LIGHTING FIXTURE TAPED INTO GYP BOARD CEILING. REFER TO ELECTRICAL LIGHTING DRAWINGS AND TO DETAIL AT WALL SHEET A042
- C.18 CEILING IN COLD ROOM BY COLD ROOM MFG
- C.19 G57500 MET ALUM. BEAM ENCLOSURE
- C.20 UNISTRUT MOUNTED TO CEILING W/ STEEL ANGLE HANGERS AND KICKERS ABOVE FOR SUPPORT
- C.21 STAINLESS STEEL STEAM CAPTURE HOOD ABOVE AUTOCLAVE
- C.22 REFER TO DETAIL 6/A0452
- C.23 122413 TYPE 6 SHADES: MANUAL SHADES IN RECESSED POCKET AT INTERIOR GLAZING. POCKET CONTINUOUS ACROSS OPENING
- C.24 INSULATED SOFFIT - SIMILAR TO WA-14 ON SHEET A0400
- C.25 CEILING MOUNTED SURGICAL LIGHT - SEE EQUIPMENT LIST (OFCI) - PROVIDE STRUCTURAL STEEL SUPPORT TO DECK - 4 - 2X2X 1/4" STEEL ANGLE HANGER WITH 4 - ANGLE KICKERS 2 X 2 X 1/4". AND MOUNTING PLATE PER MANUFACTURER. SEE DETAIL 01A0914.
- C.26 CONTROL JOINT LOCATION
- C.27 ABOVE CEILING WHERE INDICATED WITH DASHED LINE: PROVIDE 2 HOUR RATED HORIZONTAL GYP BOARD ENCLOSURE AROUND DUCTS SERVING FLOOR GRILLES ON LEVEL ABOVE. REFER TO DETAIL SHEET A1002
- C.28 ABOVE CEILING WHERE INDICATED WITH DASHED LINE: PROVIDE 2 HOUR RATED HORIZONTAL GYP BOARD ENCLOSURE AROUND STANDPIPE RUN. REFER TO DETAIL SHEET A1002
- C.29 PROVIDE 2 HOUR RATED HORIZONTAL GYP BOARD ENCLOSURE AT BOTTOM OF SHAFT. REFER TO DETAIL SHEET A1002
- C.30 122413 TYPE 7 SHADES: MOTORIZED DOUBLE ROLLER SHADES: SURFACE MOUNTED W/ CUSTOM COLOR FASCIA
- C.31 122413 TYPE 8 MOTORIZED DOUBLE ROLLER SHADE IN RECESSED POCKET.
- C.32 SPECIAL ACOUSTICAL SEPARATION CEILING: APPLY KINETICS NOISE CONTROL QUIET TILE CAC-51 TO TOP SIDE OF ACOUSTICAL PANELS. ISOLATE CEILING TILE FROM STRUCTURE ABOVE WITH KNC AF HANGERS. - LEAVE 3/4" GAP ALL SIDES
- C.33 REVEAL TRIM AROUND DIAGONAL BRACE PENETRATION THROUGH CEILING
- C.34 LABORATORY OVERHEAD SERVICE CARRIER - REFER TO ENLARGED FLOOR PLANS
- C.35 EMERGENCY SAFETY SHOWER - PIPING TO HEAD ABOVE CEILING
- C.36 122413 TYPE 3 SHADES: MANUAL SHADES - STEPPED WITH SLOPE IN CONT. SLOPED OPENING

CEILING LEGEND


- APC-1 2' x 2' - ARMSTRONG OPTIMA REGULAR 1" THICK IN 916" GRID
- APC-2 2' x 4' - ARMSTRONG ULTIMA REGULAR IN 916" SILHOUETTE XL 1/8" GRID
- APC-3B 2' x 2' - ARMSTRONG ULTIMA HEALTH ZONE REGULAR 916" GRID
- APC-4 NOT USED
- APC-5 2' x 2' - ARMSTRONG FINE FISSURED IN 1516" GRID
- APC-6 08310 ACOUSTICAL PLASTER: BASWAPHON (40 MM) OVER 1 1/2" INSULATION OVER GYP. BOARD
- APC-7 2' x 4' - ARMSTRONG ULTIMA REGULAR IN 916" SILHOUETTE XL GRID W/ 6" PANEL INSERTS AS SHOWN
- APC-8 2' x 8' - ARMSTRONG OPTIMA REGULAR - 1" THICK, NRC .90, IN 916" SILHOUETTE XL 1/8" GRID
- APC-9 MATCH APC-7 - EXCEPT REF. 085113- SPECIAL ACOUSTIC TREATMENT: APPLY SPECIAL ACOUSTIC MATERIAL TO TOP SIDE OF PANELS AND PROVIDE ISOLATORS FOR CEILING HANGERS

- WDC-1 09 5426 WOOD GRILLE CEILING W/ 3/4" x 2 1/4" MEMBERS - 6 PER FOOT - NINEWOOD GRILL 1400 W/ 1" THICK ARMSTRONG OPTIMA PANELS FIT TO GRID SUPPORT ABOVE
- WDC-2 08 4216 FLUSH WOOD PANEL SOFFIT - MATCH WVP-1
- WDC-3 06 4216 OPAQUE WOOD PANEL TO MATCH WOOD ACOUST WALL PANEL

- GWB-1 PAINTED GYP. BOARD
- GWB-2 GYP. BOARD W/ COATING TO MATCH ADJACENT ACOUST. PLASTER

CONFORMED SET 01 JUL 2016

No.	Description	Date
1	ADDENDUM 3-2	15 APR 2016
2	ISSUED FOR CONSTRUCTION (BP3)	15 MAR 2016

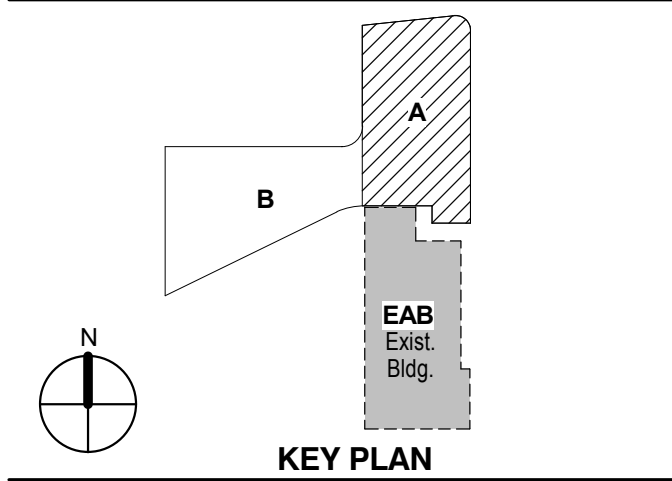

KEY PLAN

LEVEL 03 REFLECTED
CEILING PLAN AREA A

Project No.: 04561.01 Checked by:

A0703.A

C.30 122413 TYPE 7 SHADES MOTORIZED DOUBLE ROLLER SHADES: SURFACE MOUNTED W/ CUSTOM COLOR FASCIA

C.31 122413 TYPE 8 MOTORIZED DOUBLE ROLLER SHADE IN RECESSED POCKET

C.32 SPECIAL ACOUSTICAL SEPARATION CEILING: APPLY KINETICS NOISE CONTROL QUIET TILE CAC 51 TO TOP SIDE OF ACOUSTICAL PANELS;

WDC-1 09 5426 WOOD GRILLE CEILING W/ 3/4" x 2 1/4" MEMBERS - 6 PER FOOT - NINEWOOD GRILLE
1400 W/ 1" THICK ARMSTRONG OPTIMA PANELS FIT TO GRID SUPPORT ABOVE

WDC-2 06 4216 FLUSH WOOD PANEL SOFFIT - MATCH WVP-1

WDC-3 06 4216 OPAQUE WOOD PANEL TO MATCH WOOD ACOUST WALL PANEL

GWB-1 PAINTED GYP. BOARD

GWB-2 GYP. BOARD W/ COATING TO MATCH ADJACENT ACOUST. PLASTER

© Canyon Design 2015.