



PARIC CORPORATION
77 Westport Plaza Suite 250
St. Louis, MO 63146
TEL: 636-561-9500
FAX: 636-561-9501

REQUEST FOR INFORMATION	DATE: May 16, 2017	NO.: RFI-542
--------------------------------	---------------------------	---------------------

To: Cannon Design

Attn: Kelvin Patel

From: Paric Corporation

Requested By: Devin Gates

Project Name: 15051-Webster University Interdisciplinary Science Building	Project No.: 15051
---	--------------------

Subject: Boiler and hot water flue roof penetration detail

Response Required By: May 23, 2017

Drawing / Spec Reference:

Information Requested:

The boiler and hot water flues will penetrate the roof (see attached photo and markup) please provide desired penetration detail.

Response:

Please see attached Carlisle SynTec Field Fabricated Hot Stack detail U-8D. KWA has add notes for stainless steel rain hood must lap metal collar 4" min. Detail must comply with manufactures requirements for 25 year warranty.

ARCHITECT'S RESPONSE:


This information is provided as an interpretation of the Contract Documents for implementation. It is not an authorization for change to the Contract Sum or Contract Time. If this information results in a claim for a change to the Contract, the Contractor shall notify the [Construction Manager][Architect] of a change through the change process.

Answered By: _____

Date: 05/23/17


CAUTION

WHEN A PRE-MOLDED PIPE SEAL IS NOT FEASIBLE, PROJECTS WITH 25 & 30-YEAR WARRANTIES REQUIRE ALL ROUND PIPE PENETRATIONS TO BE DOUBLE WRAPPED WITH TWO LAYERS OF PRESSURE-SENSITIVE ELASTOFORM FLASHING, TERMINATED WITH A STAINLESS STEEL CLAMPING RING & SEALED WITH CONTINUOUS LAP SEALANT (AS SHOWN).

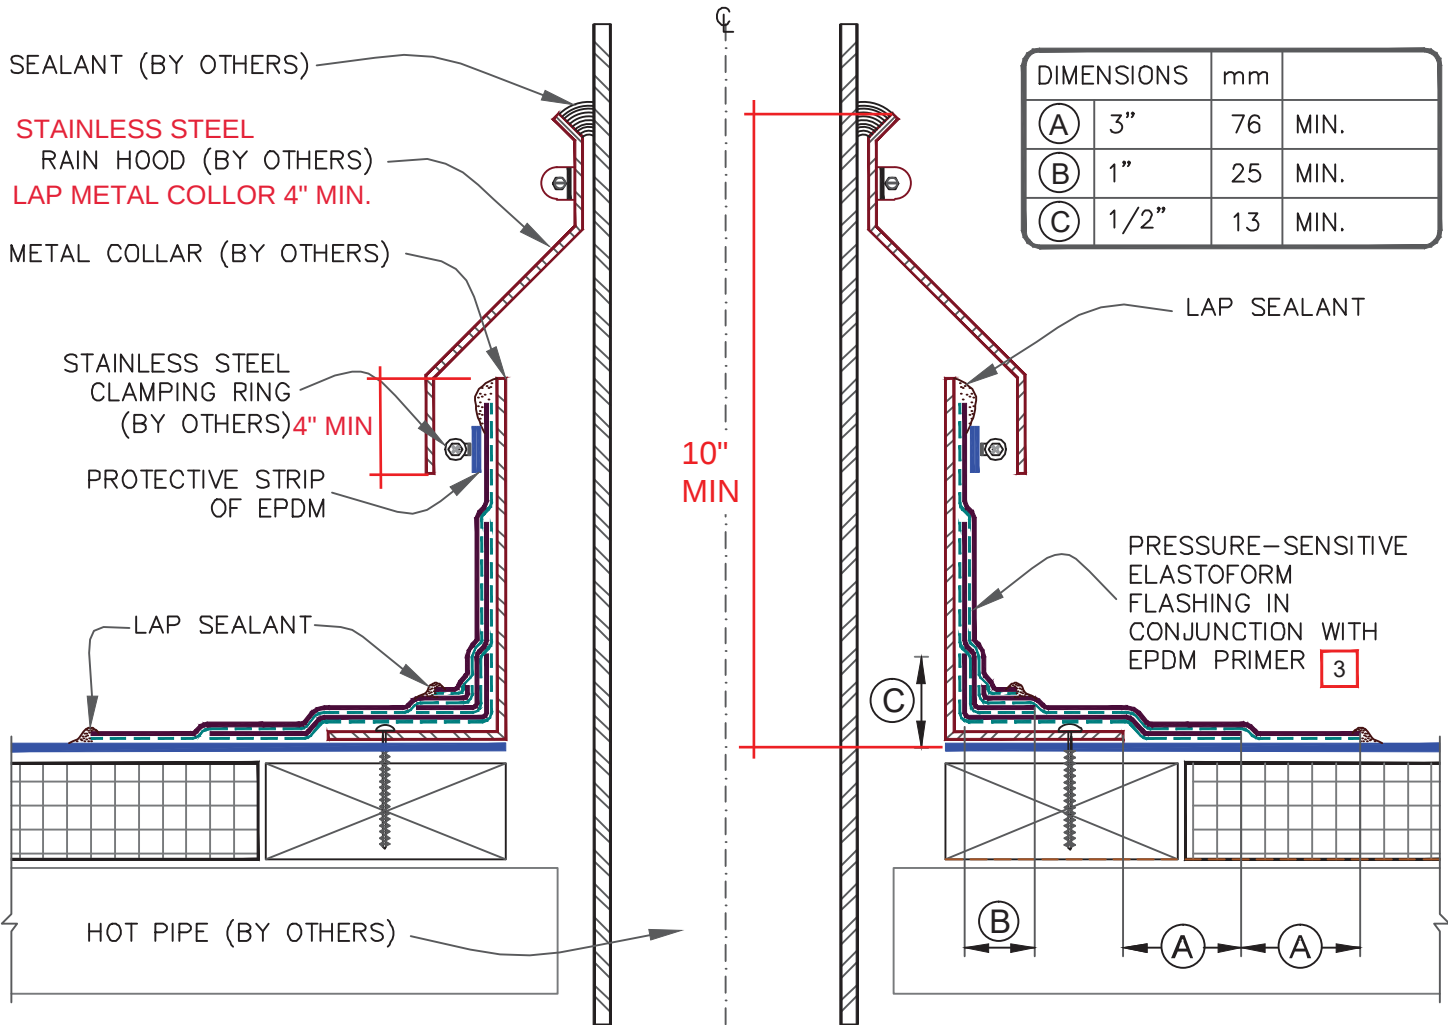

NOTES:

1. REMOVE ALL LEAD AND OTHER FLASHING BEFORE INSTALLING FIELD FABRICATED PIPE SEAL.
2. TEMPERATURE OF METAL COLLAR MUST NOT EXCEED 180°F (82°C).
3. EPDM PRIMER MUST BE APPLIED TO THE MATING SURFACES PRIOR TO APPLYING PRESSURE-SENSITIVE ELASTOFORM FLASHING.
4. IN COLDER TEMPERATURES, A HEAT GUN MUST BE USED WHEN FORMING PRESSURE-SENSITIVE ELASTOFORM FLASHING.

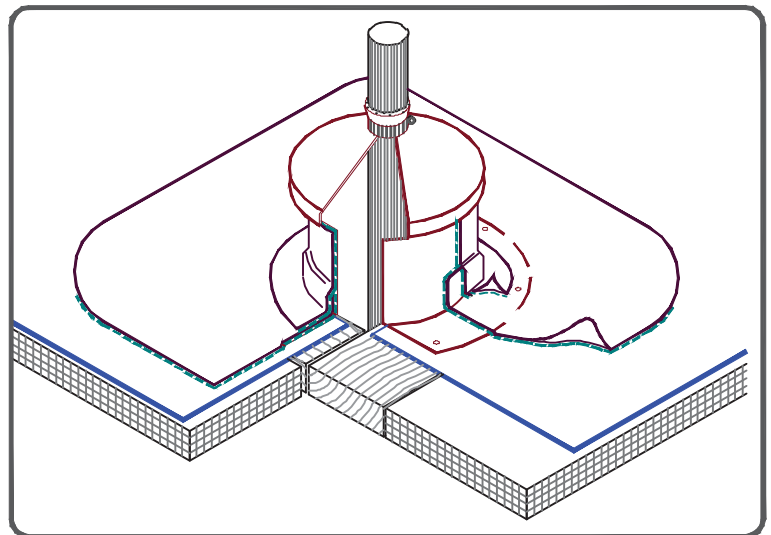

	EPDM
	APPROVED SUBSTRATE
	SEE NOTE(S)

FIELD FABRICATED HOT STACK

For additional information, refer to Specifications



DETAIL NO.

U-8D

THERMOSET UNIVERSAL






0'-2" 1/2" 0'-2"



0'-2" 1/2" 0'-2"



0'-2" 0'-2"

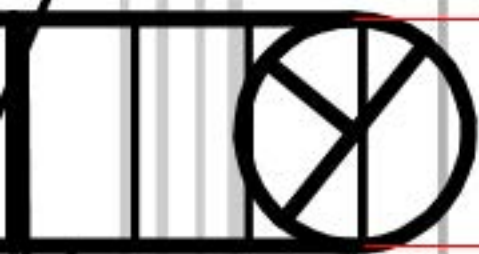

0'-2" 1/2" 0'-2"