



PARIC CORPORATION
77 Westport Plaza Suite 250
St. Louis, MO 63146
TEL: 636-561-9500
FAX: 636-561-9501

REQUEST FOR INFORMATION	DATE: June 22, 2017	NO.: RFI-570
--------------------------------	----------------------------	---------------------

To: Cannon Design

Attn: Kelvin Patel

From: Paric Corporation

Requested By: Ryan Tune

Project Name: 15051-Webster University Interdisciplinary Science Building	Project No.: 15051
---	--------------------

Subject: Lighting Layout at Pavers

Response Required By: June 29, 2017

Drawing / Spec Reference:

Information Requested:

E0001calls for lights in the pavers but does not provide a layout. See attached sketches.

Suggestion: Paric proposes to install the EE lights shown after the first row of full pavers centered in between the mullions to reduce paver cuts. Please advise if this is acceptable.

Response:

The proposed location is acceptable to WTA.

ARCHITECT'S RESPONSE:

This information is provided as an interpretation of the Contract Documents for implementation. It is not an authorization for change to the Contract Sum or Contract Time. If this information results in a claim for a change to the Contract, the Contractor shall notify the [Construction Manager][Architect] of a change through the change process.

Answered By: Mark de la Fuente, WTA

Date: 6/26/17

(6)EE,7,em

(16)EE,7,em

L16 1EH1-7
em

L16 1NH1-2
eg

(7)EE,7,em

TYPE EB
GUARDRAIL
LIGHT

L16 EB,2,eg


L16 1NH1-2
eb,en

(4)EJ,7,ef

(8)EC,2,ej

EF36,7,ec

EF36,7,ef

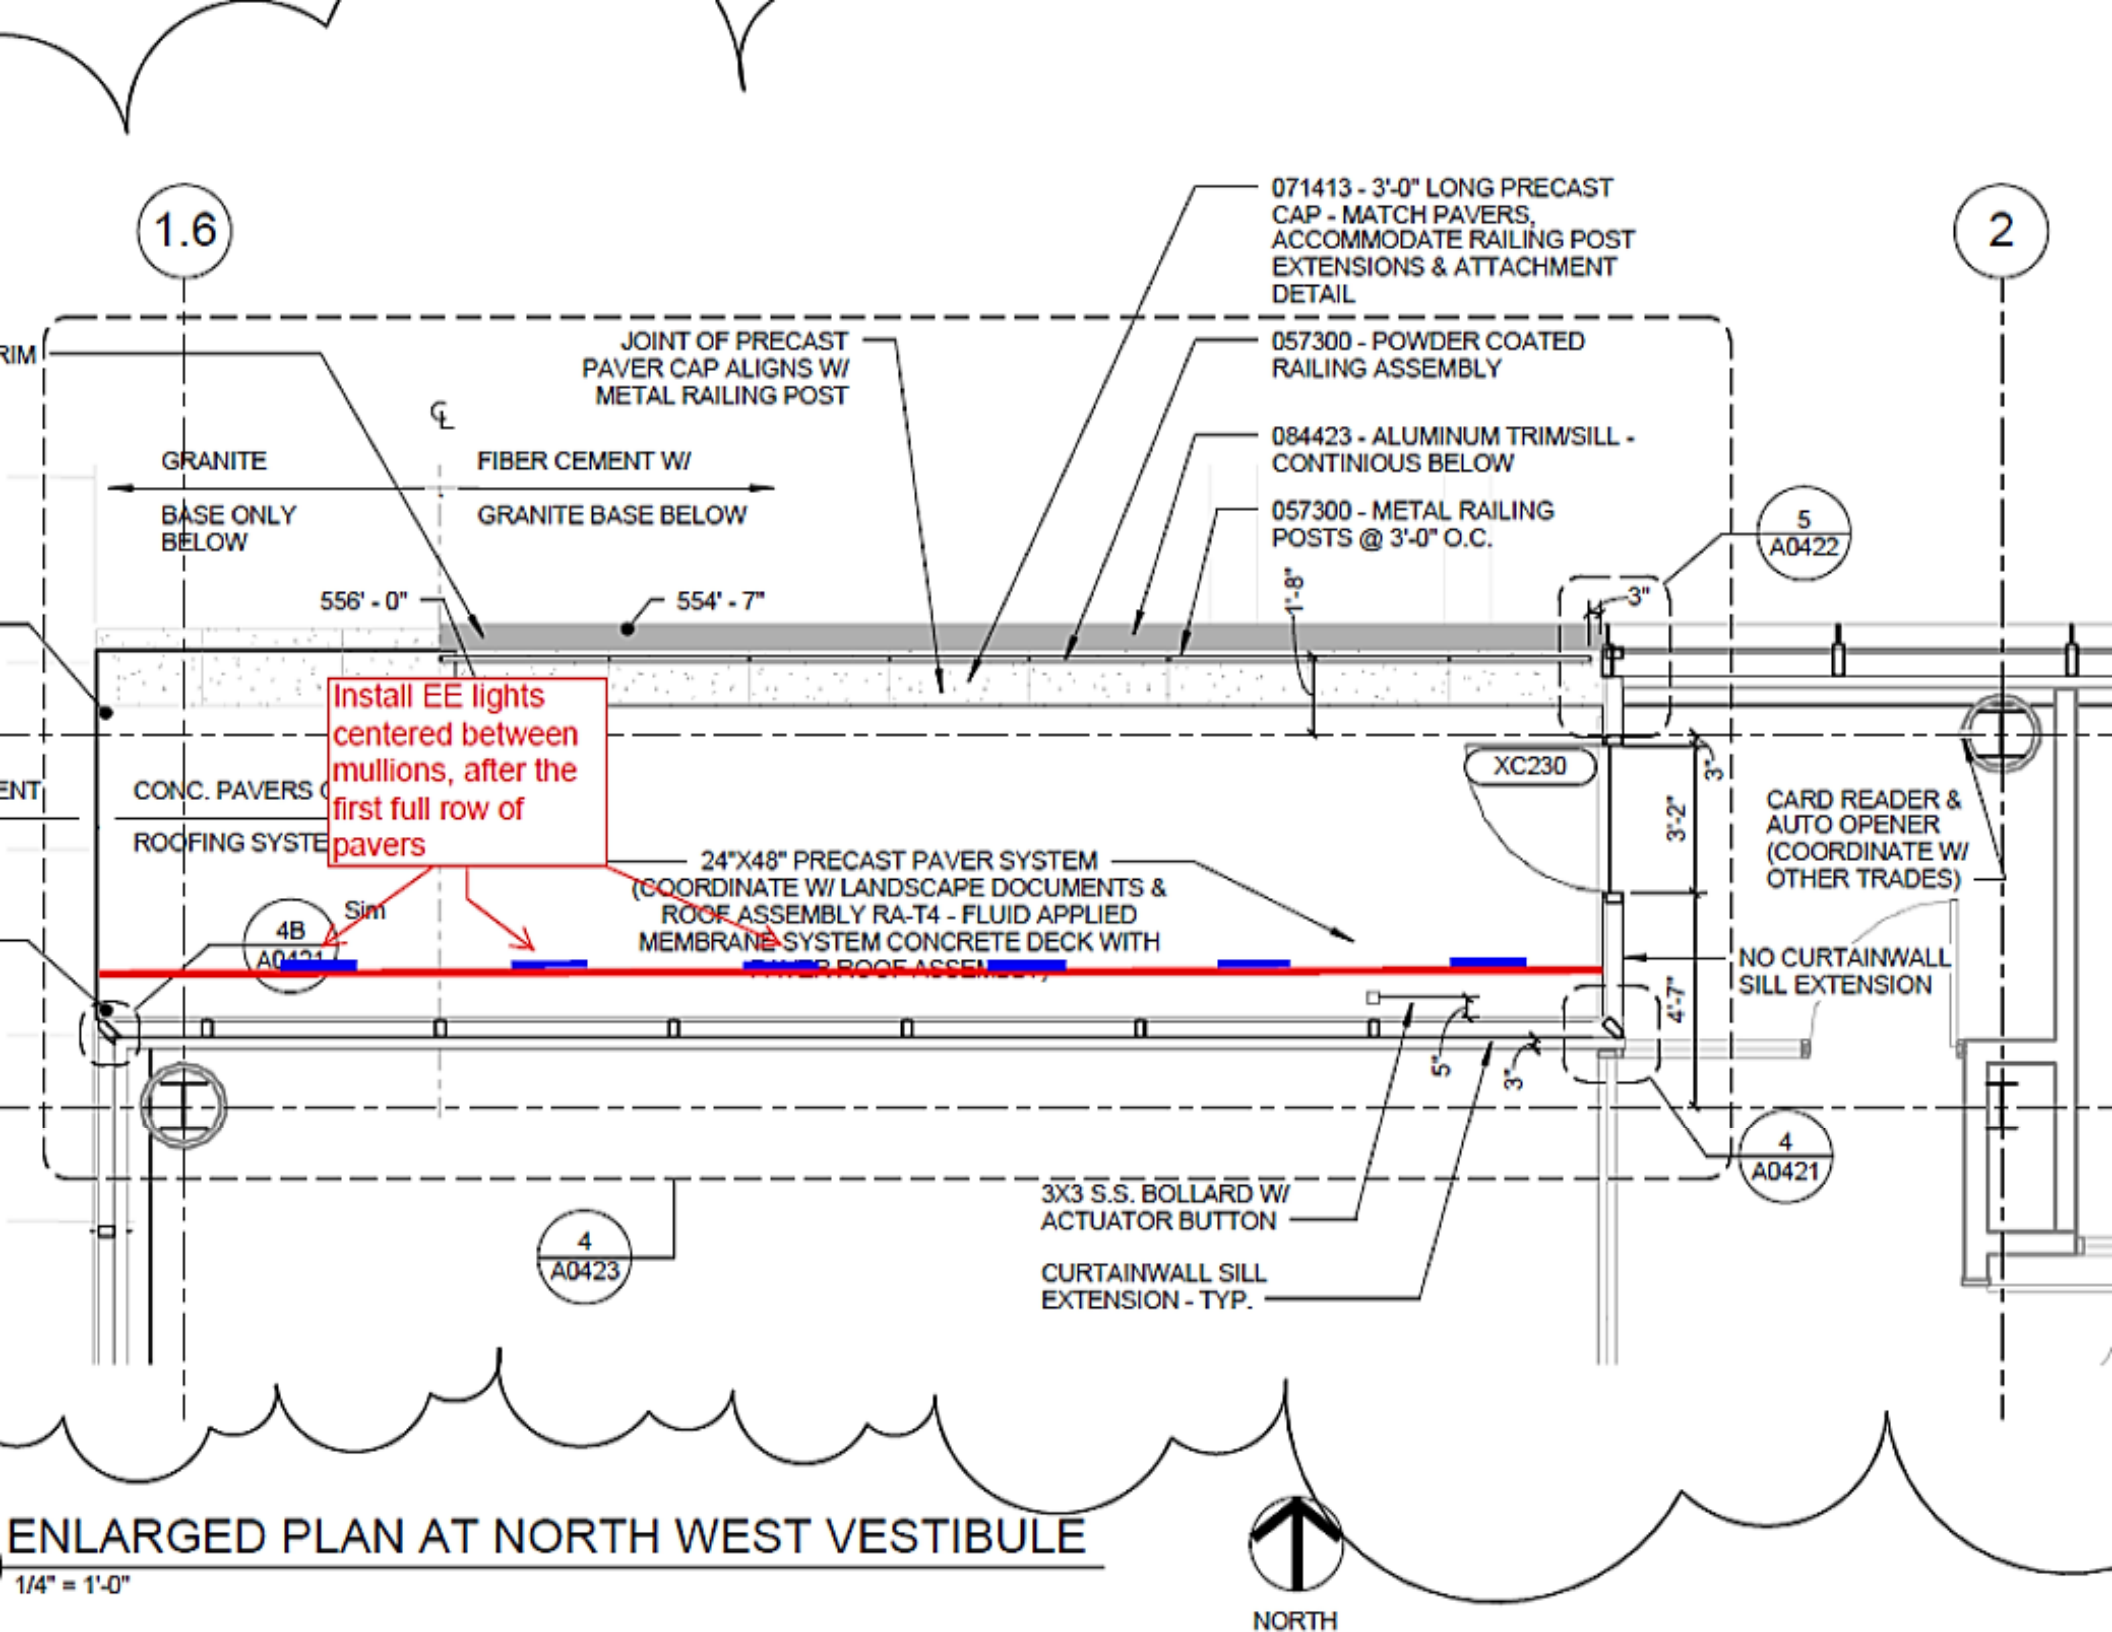


ENLARGED PLAN AT NORTH WEST VESTIBULE

1/4" = 1'-0"



NORTH

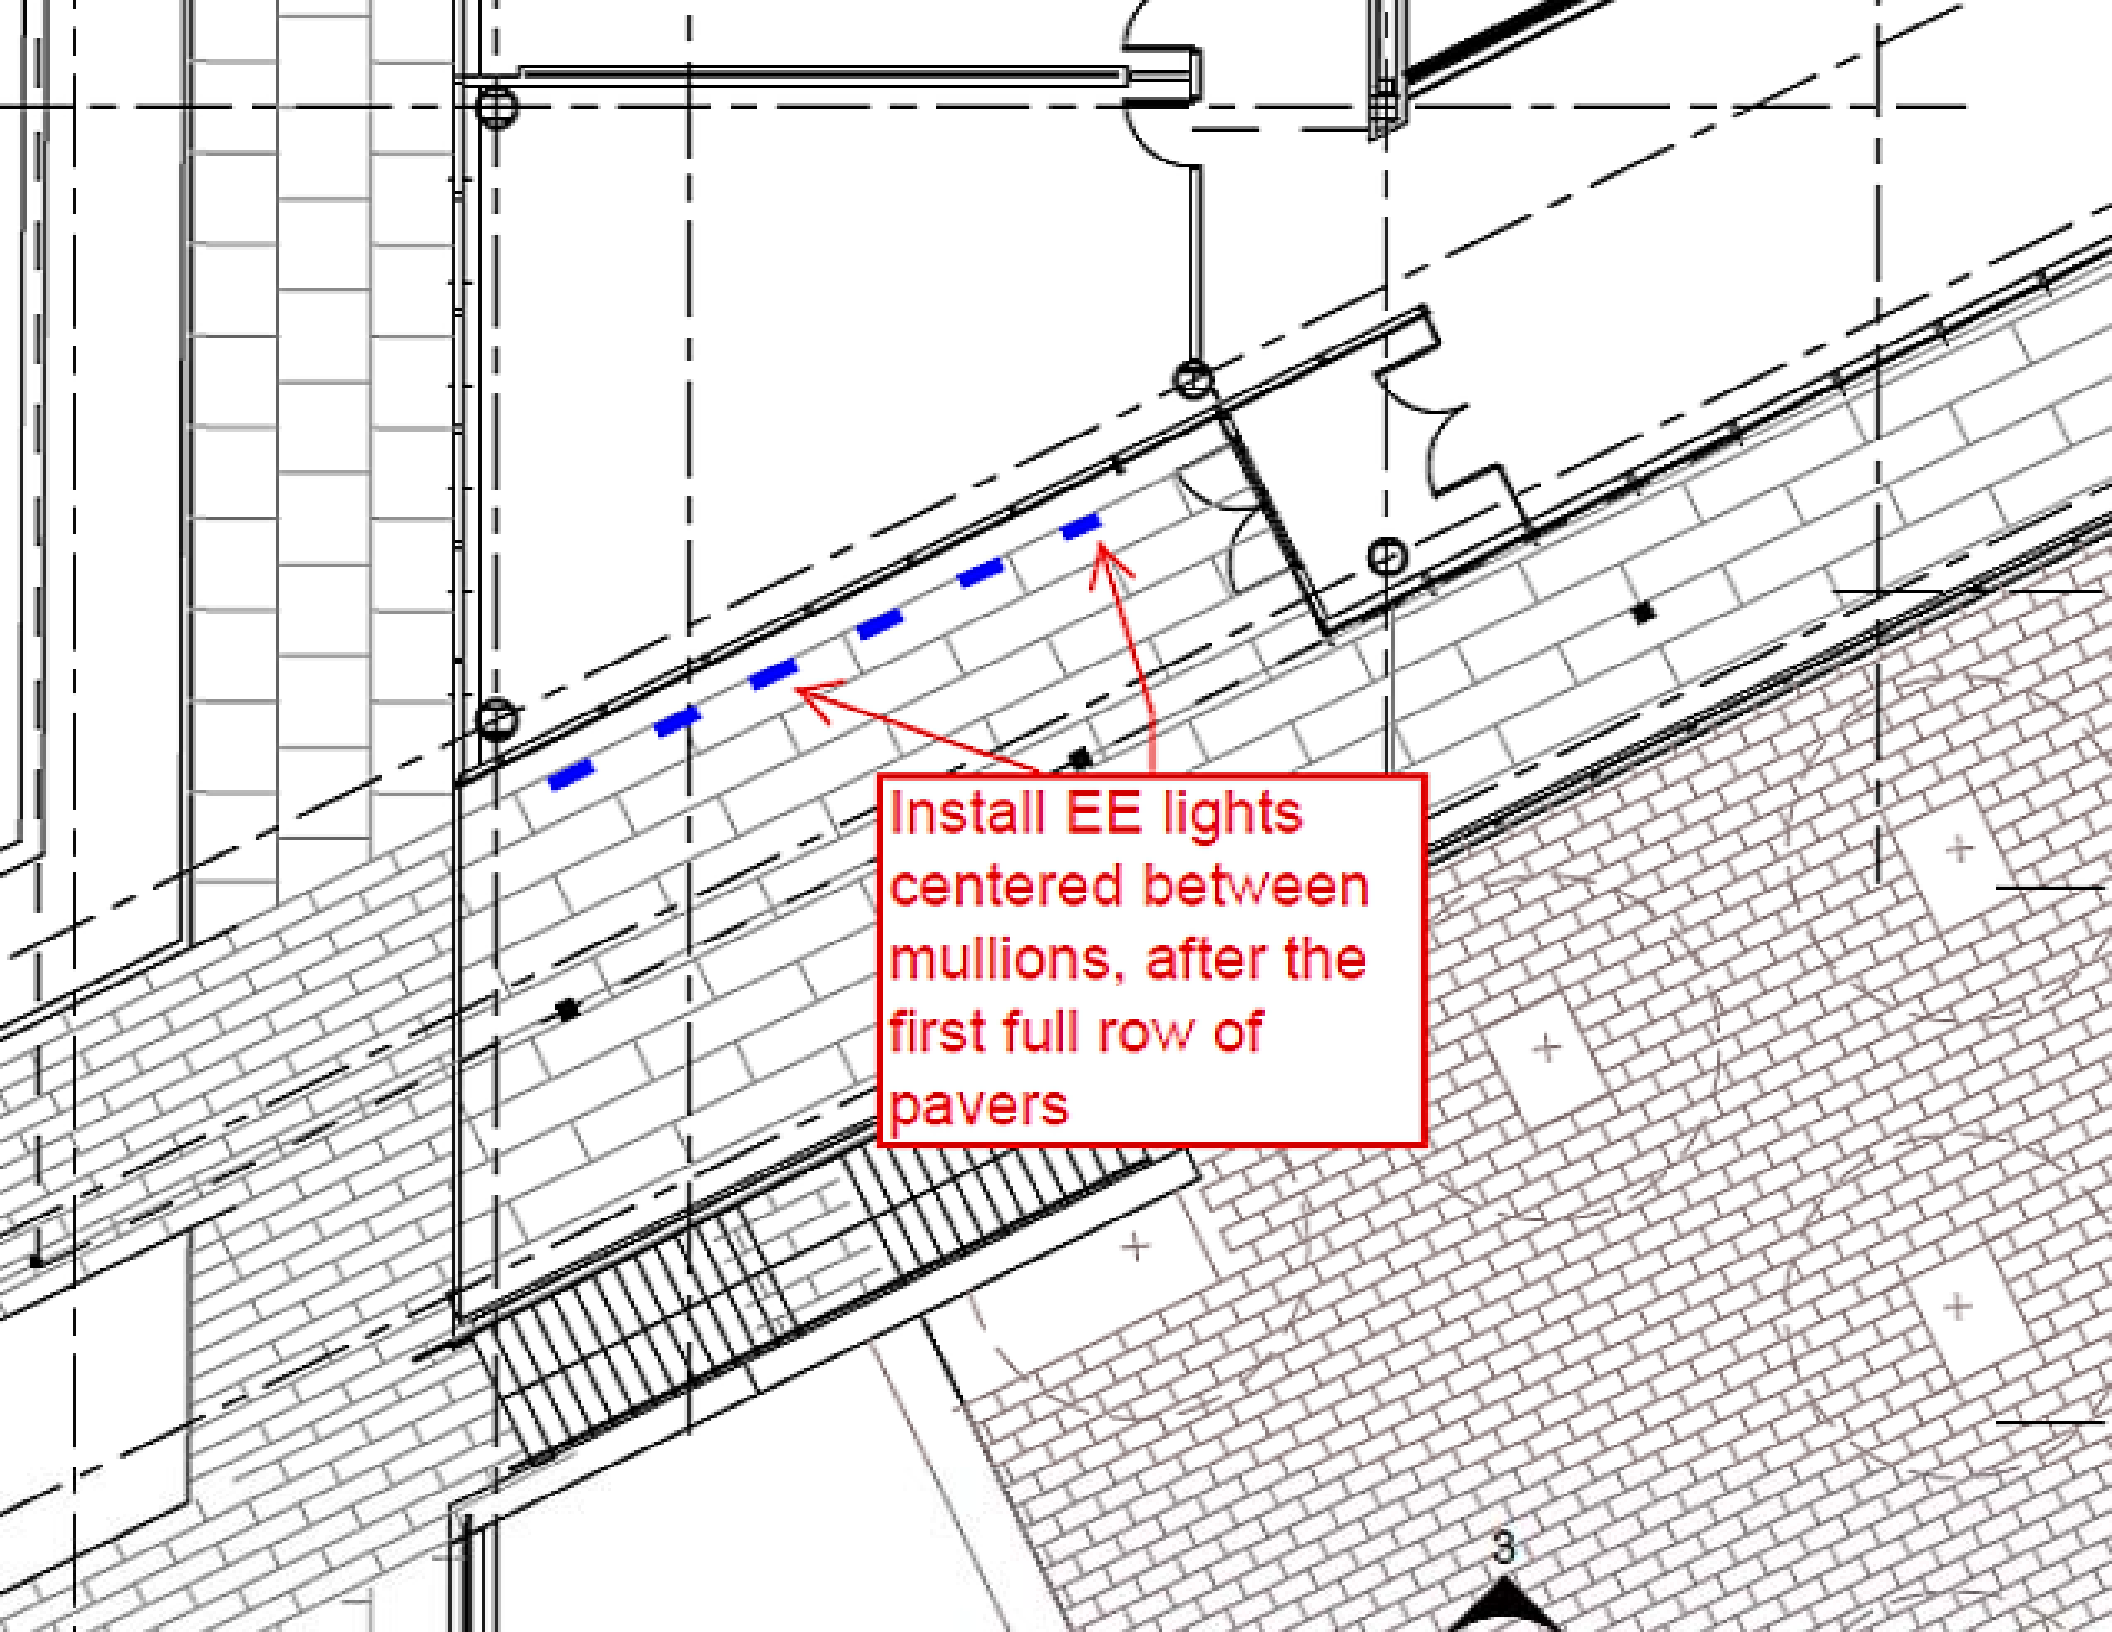

Install EE lights
centered between
mullions, after the
first full row of
pavers