



PARIC CORPORATION
77 Westport Plaza Suite 250
St. Louis, MO 63146
TEL: 636-561-9500
FAX: 636-561-9501

REQUEST FOR INFORMATION DATE: July 03, 2017 NO.: RFI-581

To: Cannon Design

Attn: Kelvin Patel

From: Paric Corporation

Requested By: Ryan Tune

Project Name: 15051-Webster University Interdisciplinary Science Building Project No.: 15051

Subject: Power Requirements in 389A

Response Required By: July 10, 2017

Drawing / Spec Reference:

Information Requested:

Will power be required for the centrifuge in room 389A?

Response:

Per owner directive, provide power for centrifuge in Bio Lab Prep Room A, Room 389, as shown in attached drawing. Connect circuit to existing 30A/2P circuit breaker in panel 3LL1.

ARCHITECT'S RESPONSE:

This information is provided as an interpretation of the Contract Documents for implementation. It is not an authorization for change to the Contract Sum or Contract Time. If this information results in a claim for a change to the Contract, the Contractor shall notify the [Construction Manager][Architect] of a change through the change process.

Mark de la Fuente, WTA

Answered By: _____

07/03/2017

Date: _____



Webster
UNIVERSITY

CANNONDESIGN

William Tao & Associates, Inc
MEP/FP Engineer
55 Manchester Road, Suite 12
St. Louis, MO 63143
314-884-7600

Faith Group
Technology
3101 S. Hanley Rd, Suite 100
St. Louis, MO 63143
314.991.2228

KWA Architects
Architecture
9721 Litzinger Road
St. Louis, MO 63125
314.962.2560

SWT Design
Landscape Architect
7722 Big Bend Blvd.
St. Louis, MO 63111
314.644.5700

A. DO NOT SCALE DRAWINGS. REFER TO ARCHITECTURAL PLANS AND ELEVATIONS FOR LOCATION AND ORIENTATION OF DEVICES. WHERE LOCATIONS ARE NOT INDICATED ON ARCHITECTURAL DRAWINGS, COORDINATE LOCATION AND ORIENTATION OF DEVICES IN FIELD WITH ARCHITECT PRIOR TO ROUGH-IN.

B. ALL DEVICES SHOWN ARE NEW UNLESS NOTED OTHERWISE.

C. ALL DEVICES TO REMAIN ARE INDICATED WITH A THIN SOLID LINE WEIGHT AND SUBSCRIPT "EX".

D. CONTRACTOR SHALL VISIT PRIOR TO BID SUBMITTALS TO DETERMINE SITE CONDITIONS EFFECTING THE EXECUTION OF WORK. FAILURE TO BE ACQUAINTED WITH EXISTING CONDITIONS WILL NOT BE JUSTIFICATION FOR ADDITIONAL SERVICES.

E. PROVIDE FACE PLATES ON ALL 3-BOXES ABANDONED IN FINISHED FLOOR, WALL OR CEILINGS. COORDINATE COLOR AND FINISH WITH ARCHITECT. CONTRACTOR TO VERIFY QUANTITY IN THE FIELD.


F. WHERE EXPOSED CONDUIT IS NOTED, CONTRACTOR SHALL IDENTIFY ROUTING IN FIELD AND OBTAIN ARCHITECT'S APPROVAL OF ROUTING PRIOR TO ROUGH-IN. EXPOSED CONDUIT SHALL BE ROUTED TIGHT TO STRUCTURE.

G. ALL SINGLE PHASE BRANCH CIRCUITS SHOWN SHALL HAVE DEDICATED NEUTRALS TO MEET NEC SECTION 210.4 MULTIPLE WIRE BRANCH CIRCUIT REQUIREMENTS.

H. REFER TO TECHNOLOGY DRAWINGS FOR CONDUIT ROUGH-IN OF DATA, VOICE AND AV.

I. ALL 120V BRANCH CIRCUITS ON THIS SHEET SHALL BE FED FROM PANEL 3NLT UNLESS NOTED OTHERWISE.

E80 PROVIDE PIPE FREEZE PROTECTION OF COLD AND HOT WATER SUPPLY AND RETURN PIPING. REFER TO SHEET M0103.A, M0104.A, AND SECTION THROUGH EAB ATTIC ON SHEET M0303 FOR LENGTH OF PIPES, AND SPECIFICATION SECTION 268500 FOR ADDITIONAL INFORMATION.

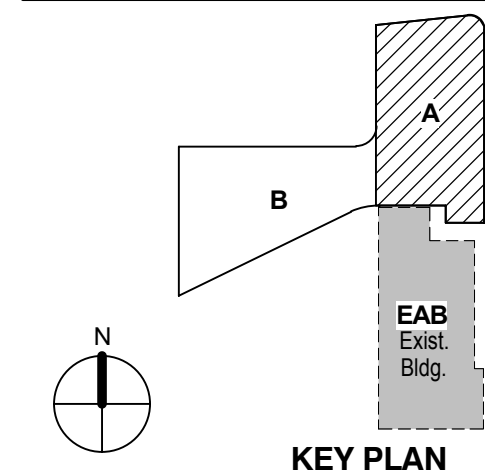

Project No.: 04561.01 Checked by:

E0103.A