



PARIC CORPORATION
77 Westport Plaza Suite 250
St. Louis, MO 63146
TEL: 636-561-9500
FAX: 636-561-9501

REQUEST FOR INFORMATION **DATE:** July 07, 2017 **NO.:** RFI-586

To: Cannon Design

Attn: Kelvin Patel

From: Paric Corporation

Requested By: Devin Gates

Project Name: 15051-Webster University Interdisciplinary Science Building Project No.: 15051

Subject: Mounting Height and location of Steris OR Light Switch

Response Required By: July 14, 2017

Drawing / Spec Reference:

Information Requested:


Please provide the Mounting Heights and locations of the Steris Light Switch... There is a special rough in associated with the Steris OR Light and it is not shown on the plans.

Response:

PER OWNER'S DIRECTION, LOCATE SWITCH AT LOCATION MARKED IN THE SKETCH BELOW AT 48" ABOVE FINISHED FLOOR.

ARCHITECT'S RESPONSE:

This information is provided as an interpretation of the Contract Documents for implementation. It is not an authorization for change to the Contract Sum or Contract Time. If this information results in a claim for a change to the Contract, the Contractor shall notify the [Construction Manager][Architect] of a change through the change process.

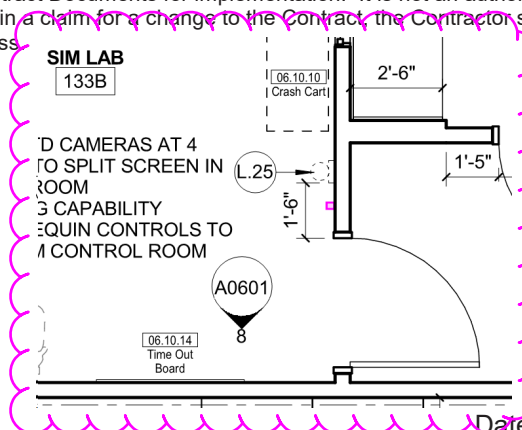

Answered By: Kelvin Patel

Date: 07/07/2017