



PARIC CORPORATION
77 Westport Plaza Suite 250
St. Louis, MO 63146
TEL: 636-561-9500
FAX: 636-561-9501

REQUEST FOR INFORMATION **DATE:** July 20, 2017 **NO.:** RFI-591

To: Cannon Design

Attn: Kelvin Patel

From: Paric Corporation

Requested By: Ryan Tune

Project Name: 15051-Webster University Interdisciplinary Science Building Project No.: 15051

Subject: 1st Floor EAB Connection Confirmation

Response Required By: July 27, 2017

Drawing / Spec Reference:

Information Requested:

Please confirm the following construction at the 1st floor EAB connector:

1. Ceiling will be approx. 8'6" (existing ceiling is 9'6") due to existing ductwork height. **OK.**
2. The two RQ fixtures will be eliminated because there is only 7'6" in length and fixtures require 8'. An additional RH fixture will be added for proper light levels (see attached email). **OK.**
3. The new and existing gypsum partitions in this area will need to be double layered to allow for the base to be flush with the gyp. **OK.**
4. New wood base and casing to match existing will need to be applied at new and existing doorways within the existing EAB corridor extension area. **OK.**

Response:

NOTE, THAT THE FINISH (STAIN COLOR & WOOD GRAIN DIRECTION) FOR DOORS 150 & 151 SHOULD MATCH THE EXISTING EAB DOORS.

CURRENTLY, DOOR 150 HAS WRONG STAIN COLOR. AND DOOR 151 HAS WRONG GRAIN DIRECTION.

ARCHITECT'S RESPONSE:

This information is provided as an interpretation of the Contract Documents for implementation. It is not an authorization for change to the Contract Sum or Contract Time. If this information results in a claim for a change to the Contract, the Contractor shall notify the [Construction Manager][Architect] of a change through the change process.

Answered By: **Kelvin Patel**

Date: **07/20/2017**

EAB
CONNECTOR

150

R2

9'-4"

7'-9 3/8"

150


151

This area

6

7

7.1

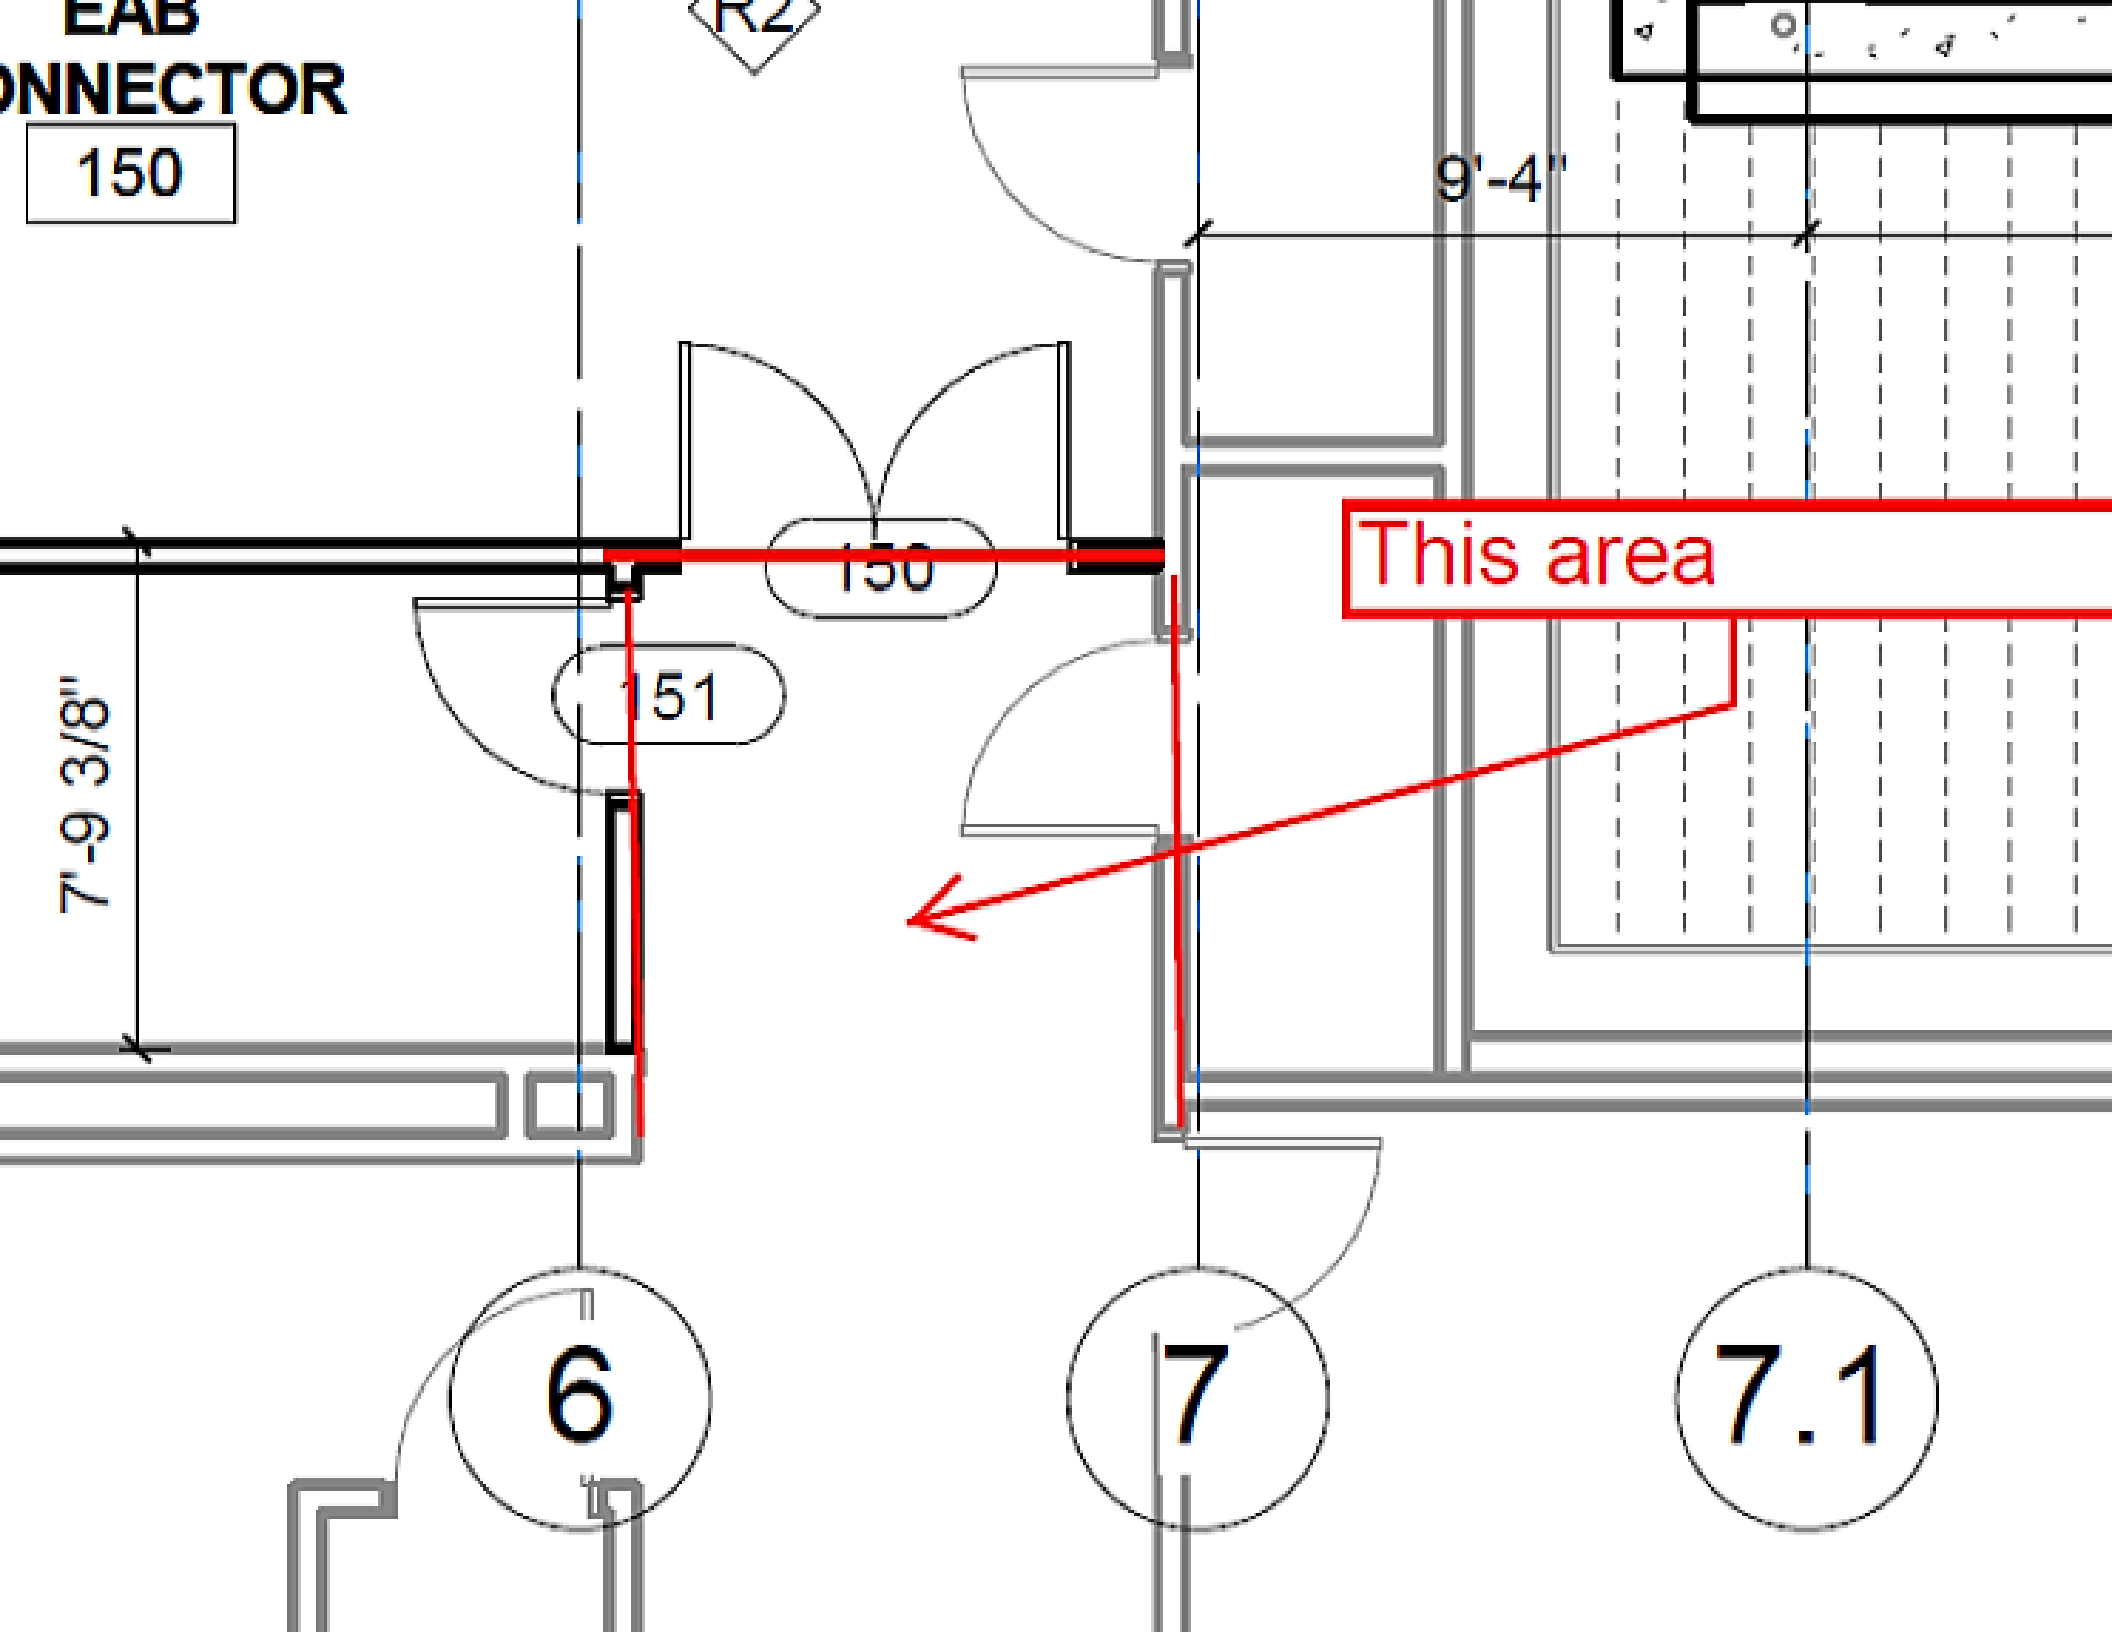







STAIN COLOR
TO MATCH
EXISTING EAB
DOORS.